

AWC Volume SE SC SW W AR IN USGS Quad Cordova B-6

Anadromous Water Catalog Number of Waterway 221-10-10010-2007

Name of Waterway \_\_\_\_\_ USGS name \_\_\_\_\_ Local name \_\_\_\_\_

Addition  Deletion \_\_\_\_\_ Correction \_\_\_\_\_ Backup Information \_\_\_\_\_

For Office Use

Nomination # <u>94 209</u>	<u>JOB</u>	<u>1/14/94</u>
Revision Year: <u>94</u>	Regional Supervisor	Date
Revision to: Atlas _____ Catalog _____	<u>Ed Wicks</u>	<u>1/6/94</u>
Both <input checked="" type="checkbox"/>	<u>Z. Drone</u>	<u>2/9/94</u>
Revision Code: <u>A-2</u>	Drafted	Date

OBSERVATION INFORMATION

Species	Date(s) Observed	Spawning	Rearing	Migration	Anadromous
<u>Coho - juvenile</u>	<u>8-25-93</u>		<u>Est. 100+</u>		<input checked="" type="checkbox"/>
<u>Pink salmon - Adults</u>	<u>8-25-93</u>	<u>2</u>			<input checked="" type="checkbox"/>

**IMPORTANT:** Provide all supporting documentation that this water body is important for the spawning, rearing or migration of anadromous fish, including: number of fish and life stages observed; sampling methods, sampling duration and area sampled; copies of field notes; etc. Attach a copy of a map showing location of mouth and observed upper extent of each species, as well as any other information such as: specific stream reaches observed as spawning or rearing habitat; locations, types, and heights of any barriers; etc.

Comments: A foot survey was conducted from the intertidal zone to the barrier at the upper extent of observed salmon. Both pinks and coho were found up to the barrier. Coho fry were identified visually in the stream then captured by dip net for verification. The barrier at the upper extent of observed salmon is a logjam one meter in height. Stream width is 2 meters at the mouth, one meter at the upper extent. Gradient is 2 percent.

ALASKA DEPT. OF  
 FISH & GAME

Name of Observer (please print) JEFF BARNHART

NOV 03 1993

Date: 10-6-93 Signature: Jeff Barnhart

Address: 333 Raspberry Road

REGION II  
 HABITAT AND RESTORATION  
 DIVISION

Anchorage AK

This certifies that in my best professional judgement and belief the above information is evidence that this waterbody should be included in or deleted from the Catalog of Waters Important for Spawning, Rearing or Migration of Anadromous Fishes per AS 16.05.870.

Signature of Area Biologist: \_\_\_\_\_

Rev. 7/93

221-10-10010

## REAM HABITAT ASSESSMENT 193 - SEGMENTS

STREAM: ~~T+ Cat #10010~~ SEGMENT: 1-01 DATE: 8/25/93 TEAM: DG/JB  
 ANADROMOUS:  n WIDTH (m): 2 - 1 LENGTH (m): \_\_\_\_\_ GPS DATE: 8/25 DIGITIZE: y n  
 WATERBODY: mainstem tributary lake/pond wetland intertidal other: \_\_\_\_\_

FISH					WILDLIFE		
SPECIES	STAGE (A J U)	COUNT	METHOD (E V D)	COMMENTS	SPECIES	COUNT	COMMENTS
Coho	J	3	D	Age 1+			
Coho	J	100+	V				
pink	A	2	V	AT barrier			
Rainbow		2	V	4" long did not capture			
Trenton Cutthroat							

GRADIENT(%): 2 CHANNEL PROFILE: 

CHANNEL PATTERN: single multi braided

STREAM SUBSTRATE: (rank three most predominant types)  
 BEDROCK \_\_\_\_\_ BOULDER \_\_\_\_\_ RUBBLE \_\_\_\_\_ COBBLE 2  
 GRAVEL 1 SAND \_\_\_\_\_ MUD/SILT 3 ORGANICS \_\_\_\_\_ OTHER: \_\_\_\_\_

STREAM COVER TYPE: ORGANIC DEBRIS \_\_\_\_\_ DEAD BRANCHES/TWIGS X LOGS X BOULDERS \_\_\_\_\_  
 CUT BANK X OVERHANGING VEGET. X OTHER: \_\_\_\_\_

STREAM COVER ABUNDANCE: none low medium high

RIPARIAN VEGETATION (three most abundant plants in order of dominance) within 20m of the banks:

OVERSTORY: Spruce Heulock  
 UNDERSTORY: Alder Salix berry Ferns

CANOPY ABOVE STREAM: none low medium high

GROWTH: mature secondary shrubs meadow muskeg intertidal

TOTAL BARRIER? y n BARRIER TO SPECIES: All adults juveniles

TYPE: fall slide beaverdam logjam spring substrate HEIGHT (m): 1 DIST. FROM UPPER EXTENT (m): 0

PHOTO ROLL(s): 5804

VIDEO TAPE(s): \_\_\_\_\_

FRAME	DESCRIPTION	DATE	DESCRIPTION
15	Coho Fry Age 1+		
16	50 meters from beginning of segment, looking upstream (photo blurred)		
17	Same as 16. (Should be covered photo)		
18+19	pink salmon at upper extent.		
	(Numbering is off somewhere)		

Substrate: Bedrock (solid) Boulder >1' Rubble 6-12" Cobble 2-6" Gravel .1-2" Sand <.1"  
 (Please enter comments on the other side)

STREAM HABITAT ASSESSMENT 1993 - STREAMS

STREAM: T1 <sup>cat # 10010</sup> QUAD: Ordova B-6 STAGE: H M L  
 LANDOWNER: Chenega CAC Eyak Tatitlek Pt. Graham English Bay (circle one)  
 DATE(s): 8/25/93 UTM ZONE: 6  
 GPS FILES: B082521F

SKETCH (indicate UTM zones, if not uniform throughout the stream)

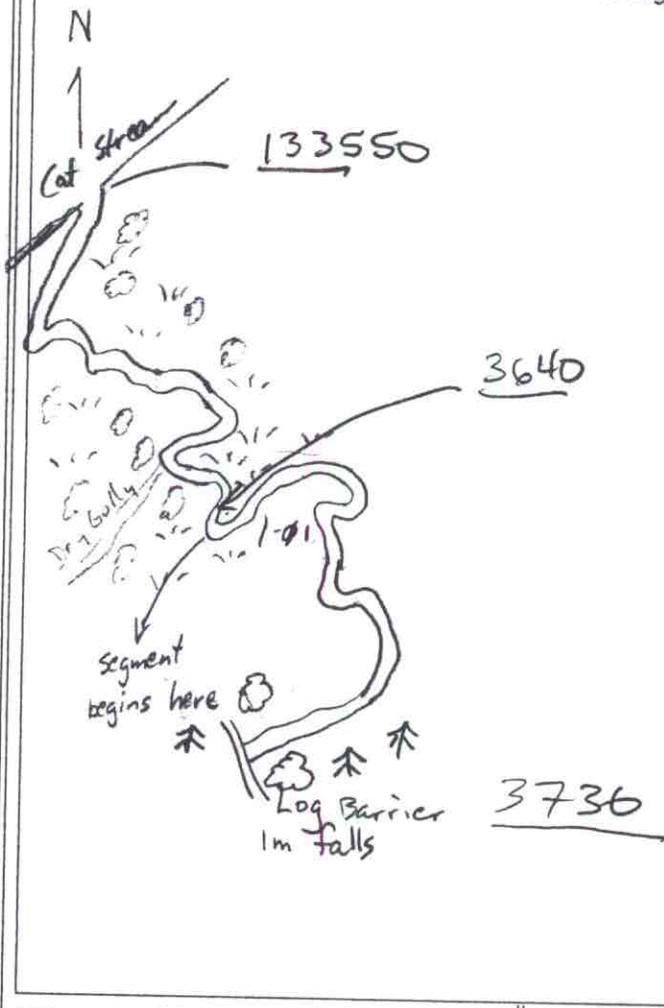


PHOTO ROLL(s):		VIDEO TAPE(s): <u>WG 1</u>	
FRAME	DESCRIPTION	DATE	
		<u>8/25</u>	<u>1-φ1</u>

(Please enter comments on the other side)

AMT 12,000

1900


COR 11A


9-20-72

10010

2007

STATE OF MONTANA  
DEPARTMENT OF LAND AND WATER RESOURCES  
LAND RECORDS DIVISION

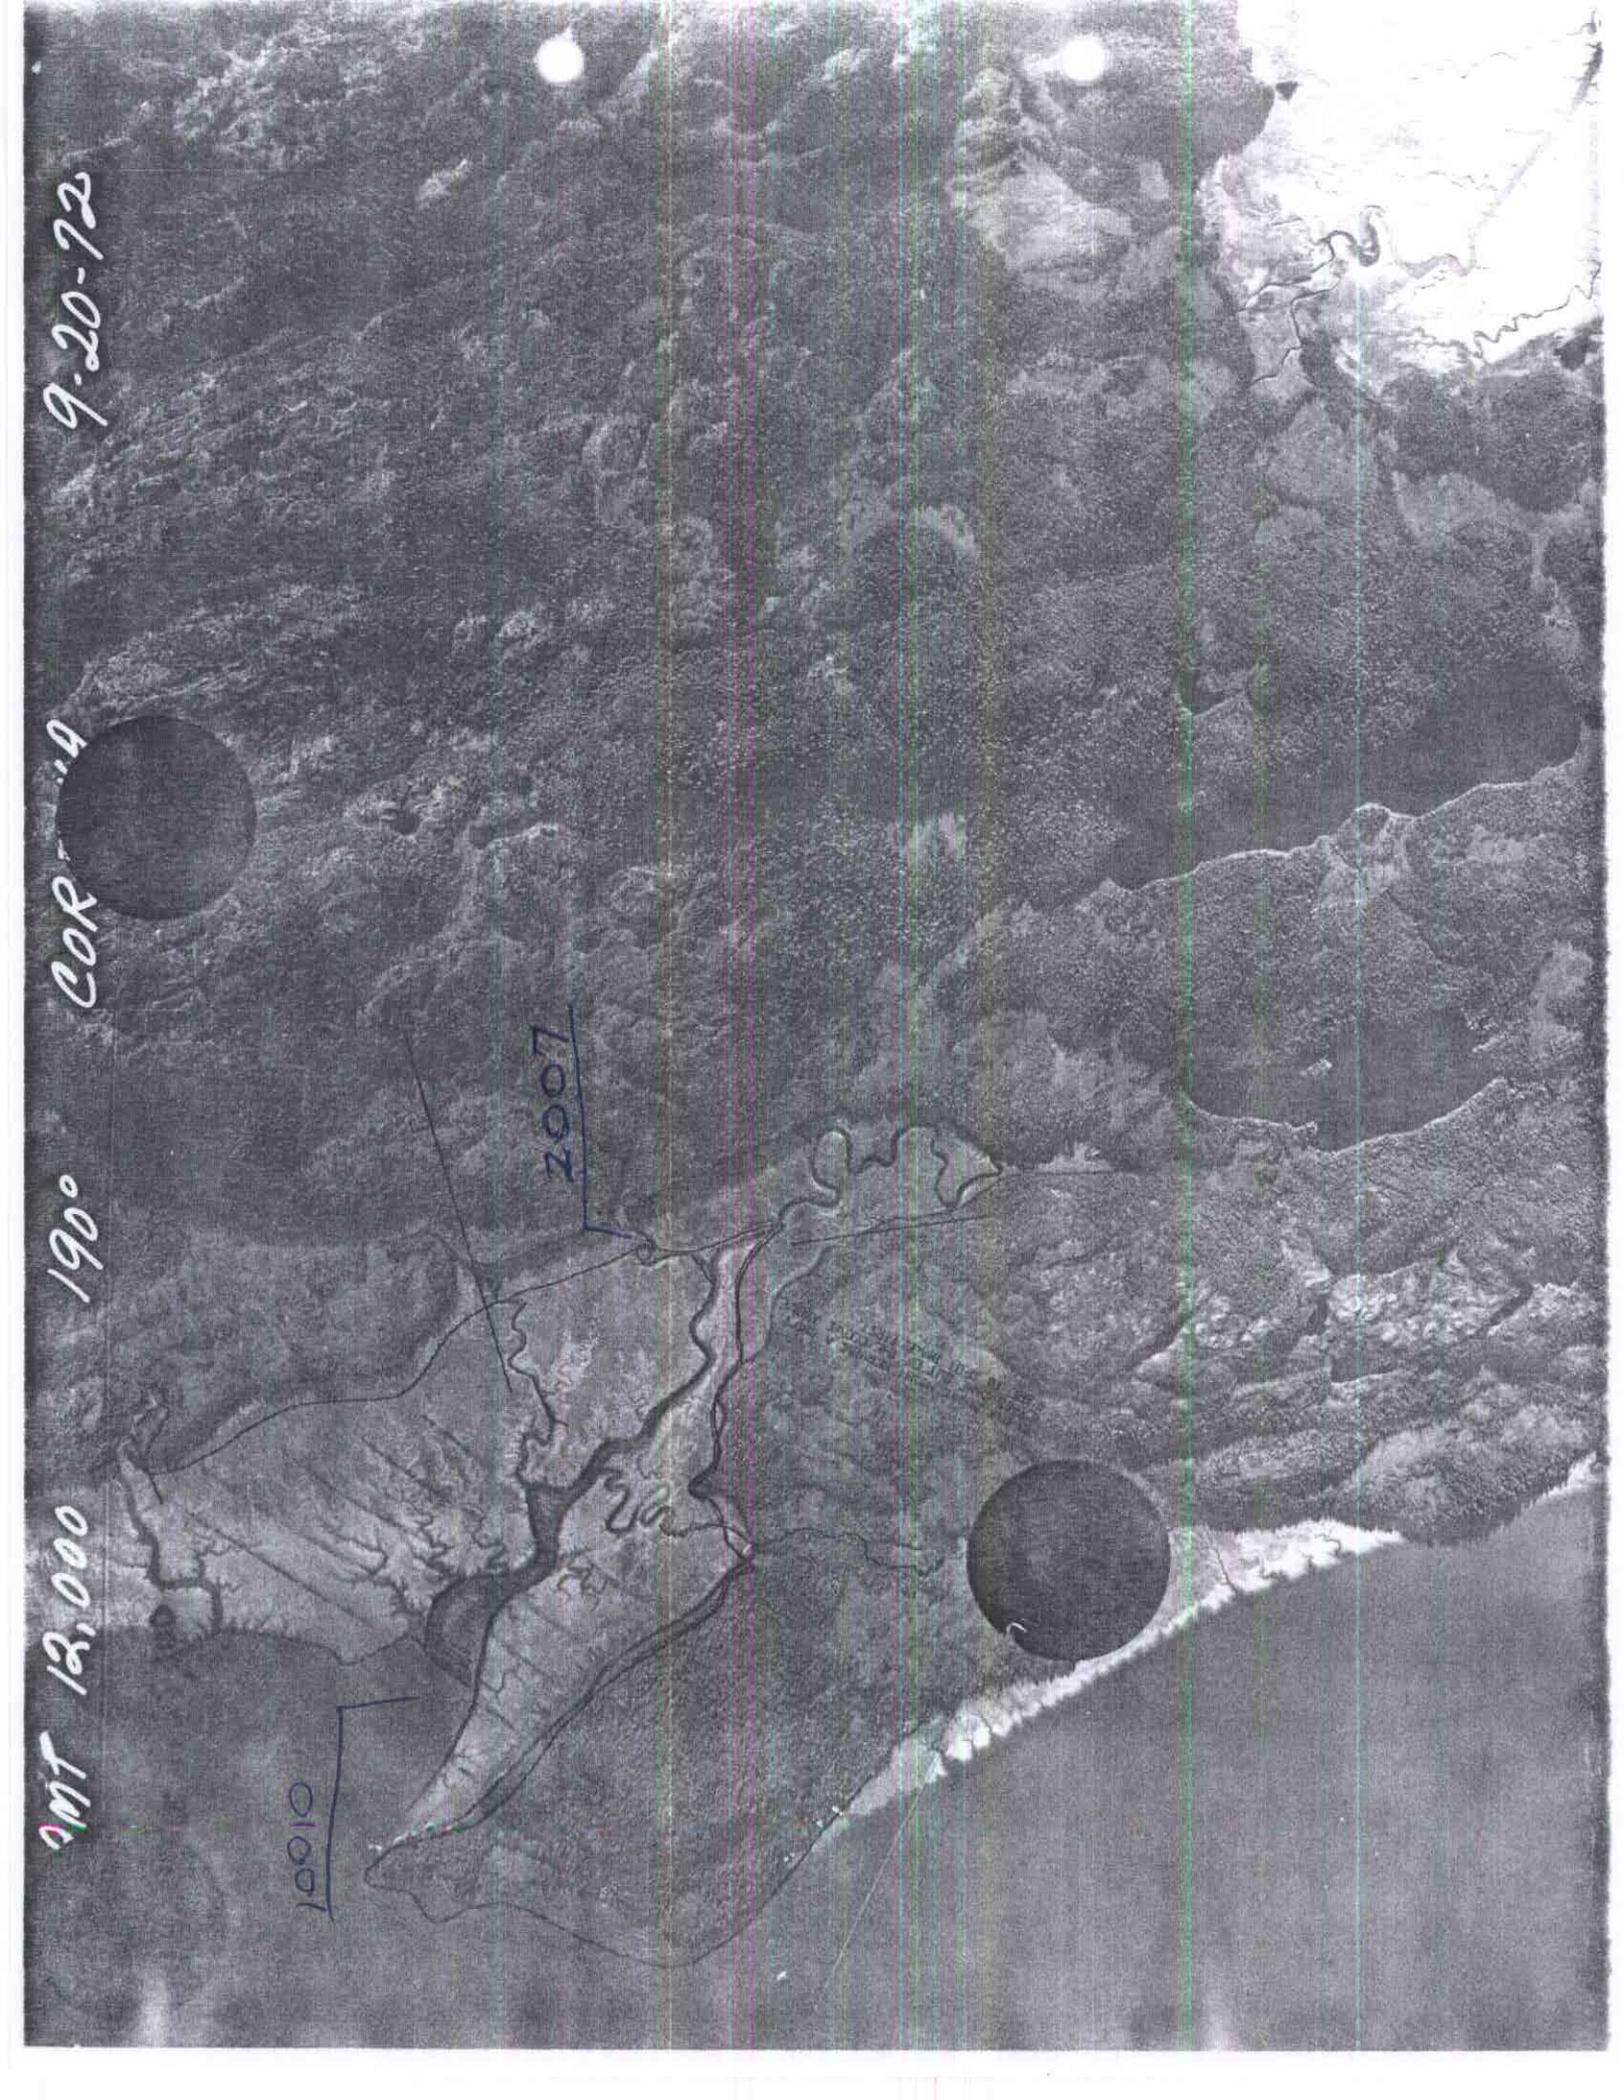

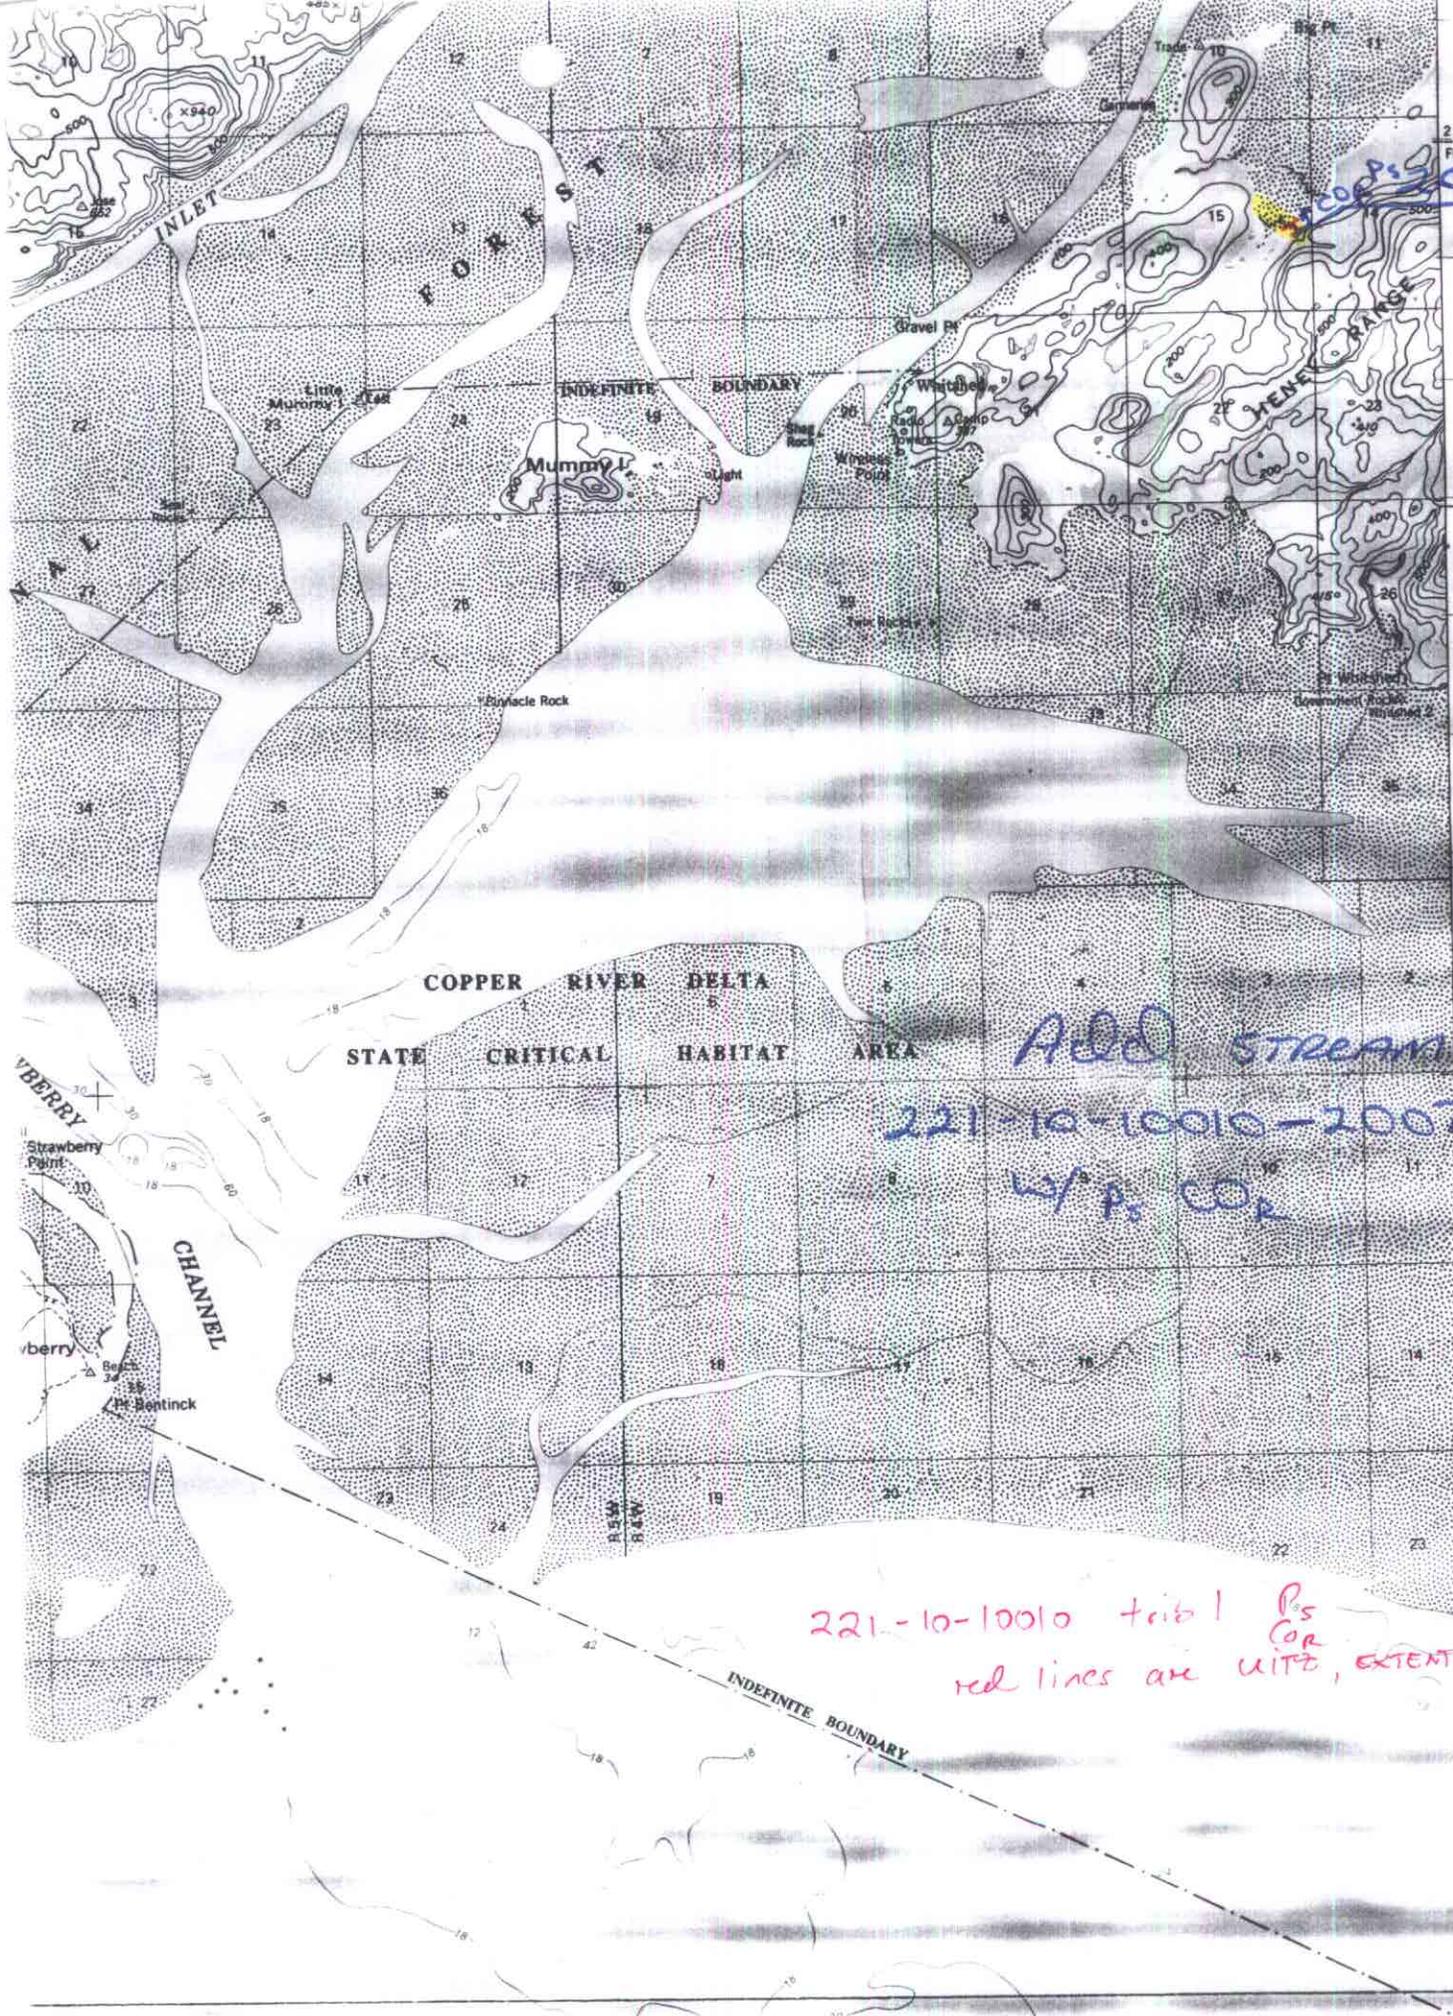

2 370 000  
FEET  
007

T 16 S  
T 17 S

25'

(CORDOVA B-5)

COPPER RIVER DELTA  
STATE CRITICAL HABITAT AREA

ADD STREAM

221-10-10010-2007

w/ P<sub>s</sub> COR

221-10-10010 trib 1 P<sub>s</sub>  
COR  
red lines are WITZ, EXTENT

INDEFINITE BOUNDARY

INLET

FOREST

INDEFINITE BOUNDARY

MENE RANGE

CHANNEL

R 3 W  
R 4 W

STRAWBERRY POINT

STRAWBERRY POINT

POINT BENTINCK

GRAVEL Pt

WATCHET

WINDY POINT

TIME ROCK Pt

SNYACIE ROCK

GREENHORN Pt

WINDY Pt

# MEMORANDUM

# State of Alaska

DEPARTMENT OF FISH & GAME

**TO:** Ed Weiss  
Habitat Biologist  
Region II  
Habitat and Restoration Division  
Department of Fish and Game

**DATE:** November 3, 1993

**FILE NO.:**

**TELEPHONE NO.:** 267-2295

**FROM:** Kathrin Sundet  
Habitat Biologist  
Region II  
Habitat and Restoration Division  
Department of Fish and Game

**SUBJECT:** Anadromous Stream  
Nominations  
and Corrections  
Project R-51

Attached are anadromous stream nominations and corrections to be included in the Anadromous Waters Catalog for 53 streams surveyed in the fall of 1993 on private lands held by the Tatitlek and Eyak Native Corporations in northeast Prince William Sound.

Streams were surveyed by the Alaska Department of Fish and Game, Habitat and Restoration Division personnel, Kathrin Sundet, Jeff Barnhart, Dan Grey, and Wes Ghormley as part of Exxon Valdez Oil Spill Restoration project R-51 aka SHA (Stream Habitat Assessment).

Streams were surveyed on foot from the intertidal zone to the upper extent of anadromous fish distribution. Adult salmon and Dolly Varden were visually identified and enumerated. Juvenile salmon were visually identified in the stream, and then captured by electroshocking, dipnet, or minnow trap to confirm identification. Sampling was conducted periodically along the stream to determine the presence of juvenile salmon. No attempt was made to determine the rearing population sizes of juvenile salmon, or to determine the total escapement of adult salmon in a stream.

Stream data are on file at the Alaska Department of Fish and Game, Habitat and Restoration office, 333 Raspberry Road, Anchorage, Alaska.

There substantial discrepancies among shorelines on the USGS quad sheets, the DNR shoreline, and observed shorelines in this area. In some cases I have attached enlarged plots generated from GPS data and the DNR shoreline to the nomination form in order to illustrate the differences.

## Attachments

cc w/o Attachments: Lance Trasky  
Don McKay  
Mark Kuwada