



State of Alaska  
Department of Fish and Game  
Sportfish Division

Nomination Form  
Fish Distribution Database

*map 13*

Region Southeastern USGS Quad(s) Juneau A-5  
Fish Distribution Database Number of Waterway 114-31-10100

Name of Waterway Camp Creek  USGS Name  Local Name  
 Addition  Deletion  Correction  Backup Information

For Office Use

Nomination # <u>08-512</u>	<i>[Signature]</i> ADF&G Fisheries Scientist	<u>10/6/08</u> Date
Revision Year: <u>2009</u>	<i>[Signature]</i> ADNR OHMP Operations Mgr.	<u>10/6/08</u> Date
Revision to: Atlas <input type="checkbox"/> Catalog <input type="checkbox"/> Both <input checked="" type="checkbox"/>	<i>[Signature]</i> FDD Project Biologist	<u>9/3/08</u> Date
Revision Code: <u>C-9, A-3</u>	<i>[Signature]</i> Cartographer	<u>10/20/09</u> Date

OBSERVATION INFORMATION

Species	Date(s) Observed	Spawning	Rearing	Present	Anadromous


**IMPORTANT:** Provide all supporting documentation that this water body is important for the spawning, rearing or migration of anadromous fish, including: number of fish and life stages observed; sampling methods, sampling duration and area sampled; copies of field notes; etc. Attach a copy of a map showing location of mouth and observed upper extent of each species, as well as other information such as: specific stream reaches observed as spawning or rearing habitat; locations, types, and heights of any barriers; etc.


**Comments:** *add location name Camp CK*  
FID 7. This is the actual location where the road crosses the stream.  
*Redraw stream AEC using supplied shapefile  
and ortho imagery to revise hydrography  
Original AEC were hand drawn w/ coordinates*  
*pt and AEC shapefile available*

Name of Observer (please print): Kristen Dunlap  
Signature: 205.166.26.199 (Web Nomination) Date: 08/15/2008  
Agency: \_\_\_\_\_  
Address: 400 Willoughby PO Box 111050 400 Willoughby P  
Juneau, AK 99811


This certifies that in my best professional judgment and belief the above information is evidence that this waterbody should be included in or deleted from the Fish Distribution Database.

Signature of Area Biologist: \_\_\_\_\_ Date: \_\_\_\_\_ Revision 02/05  
Name of Area Biologist (please print): \_\_\_\_\_

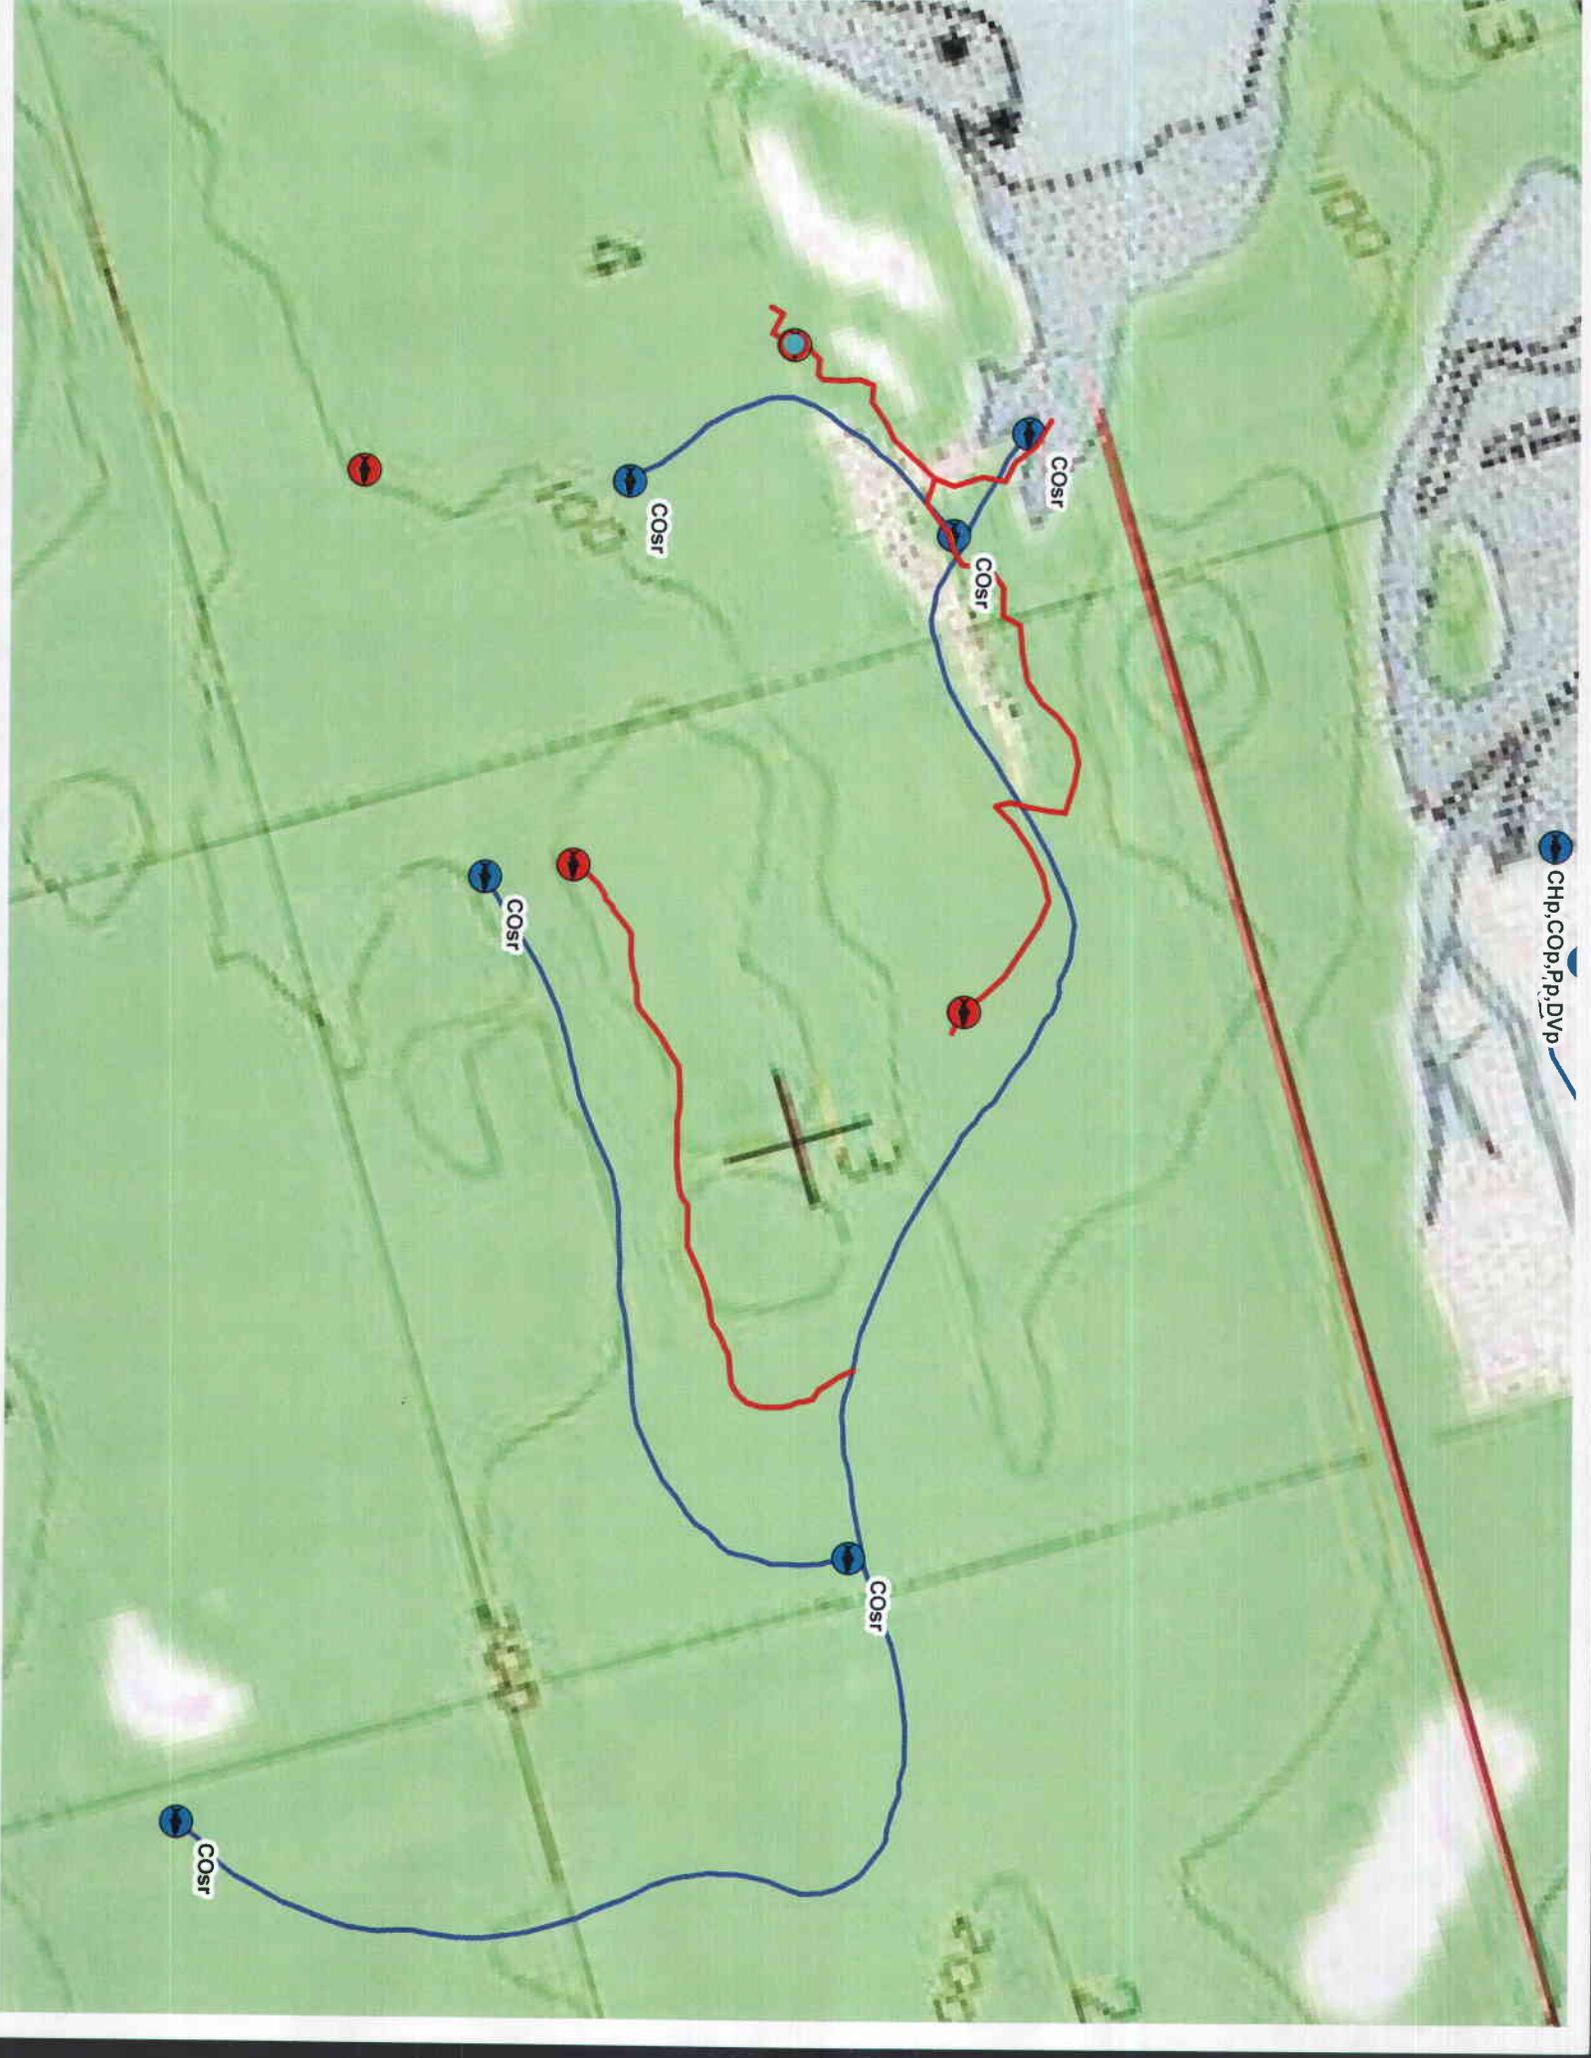


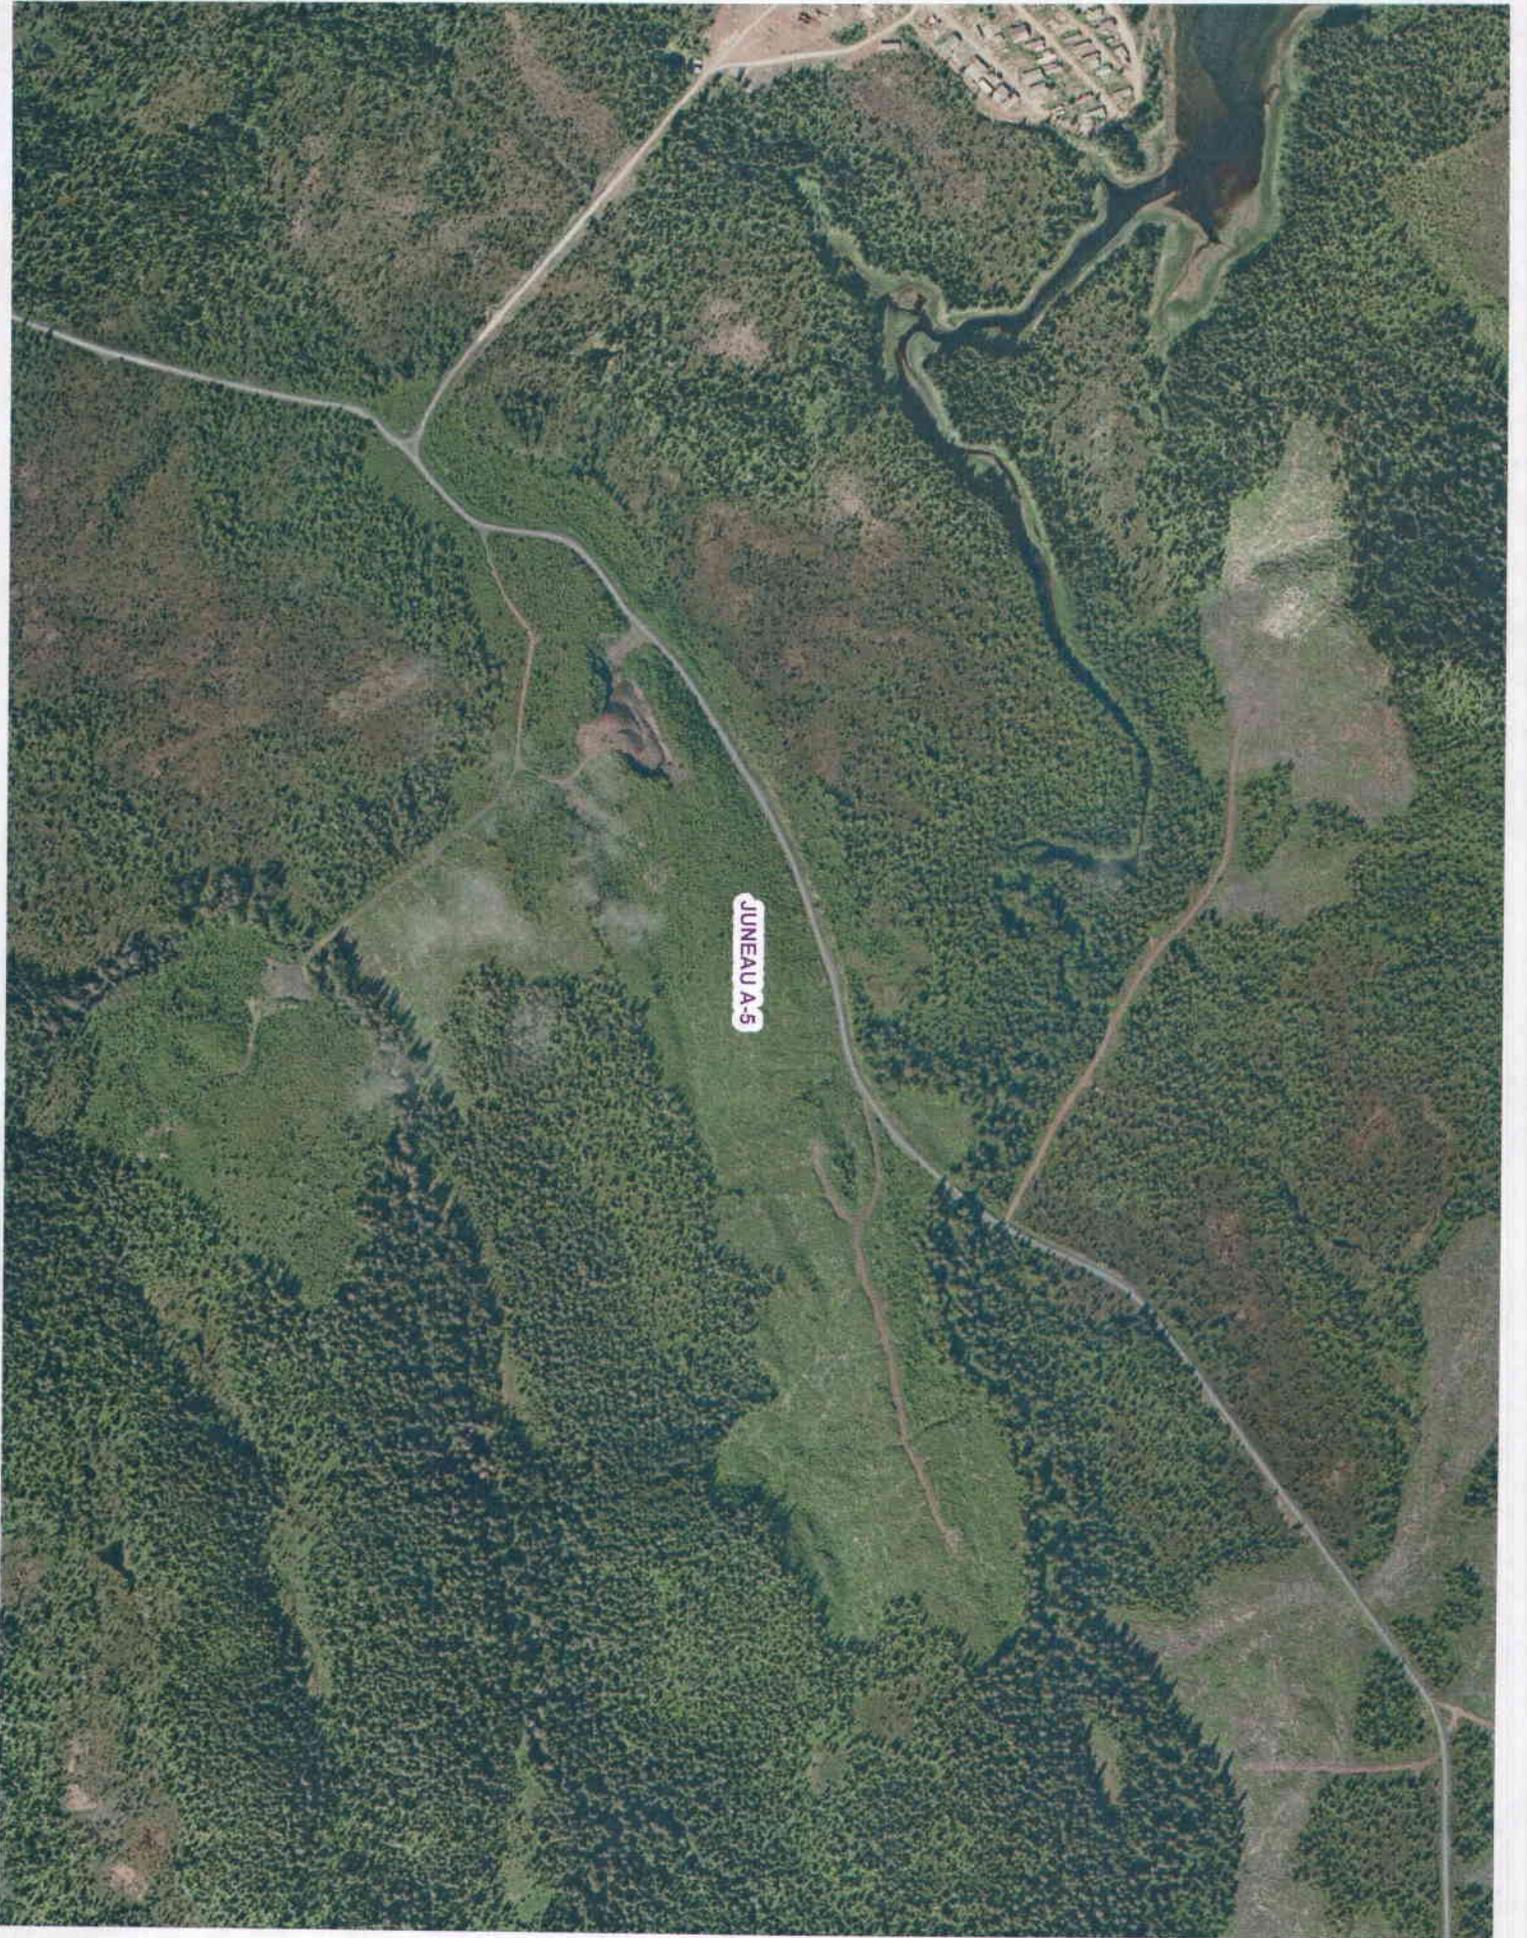

JUNEAU A-5

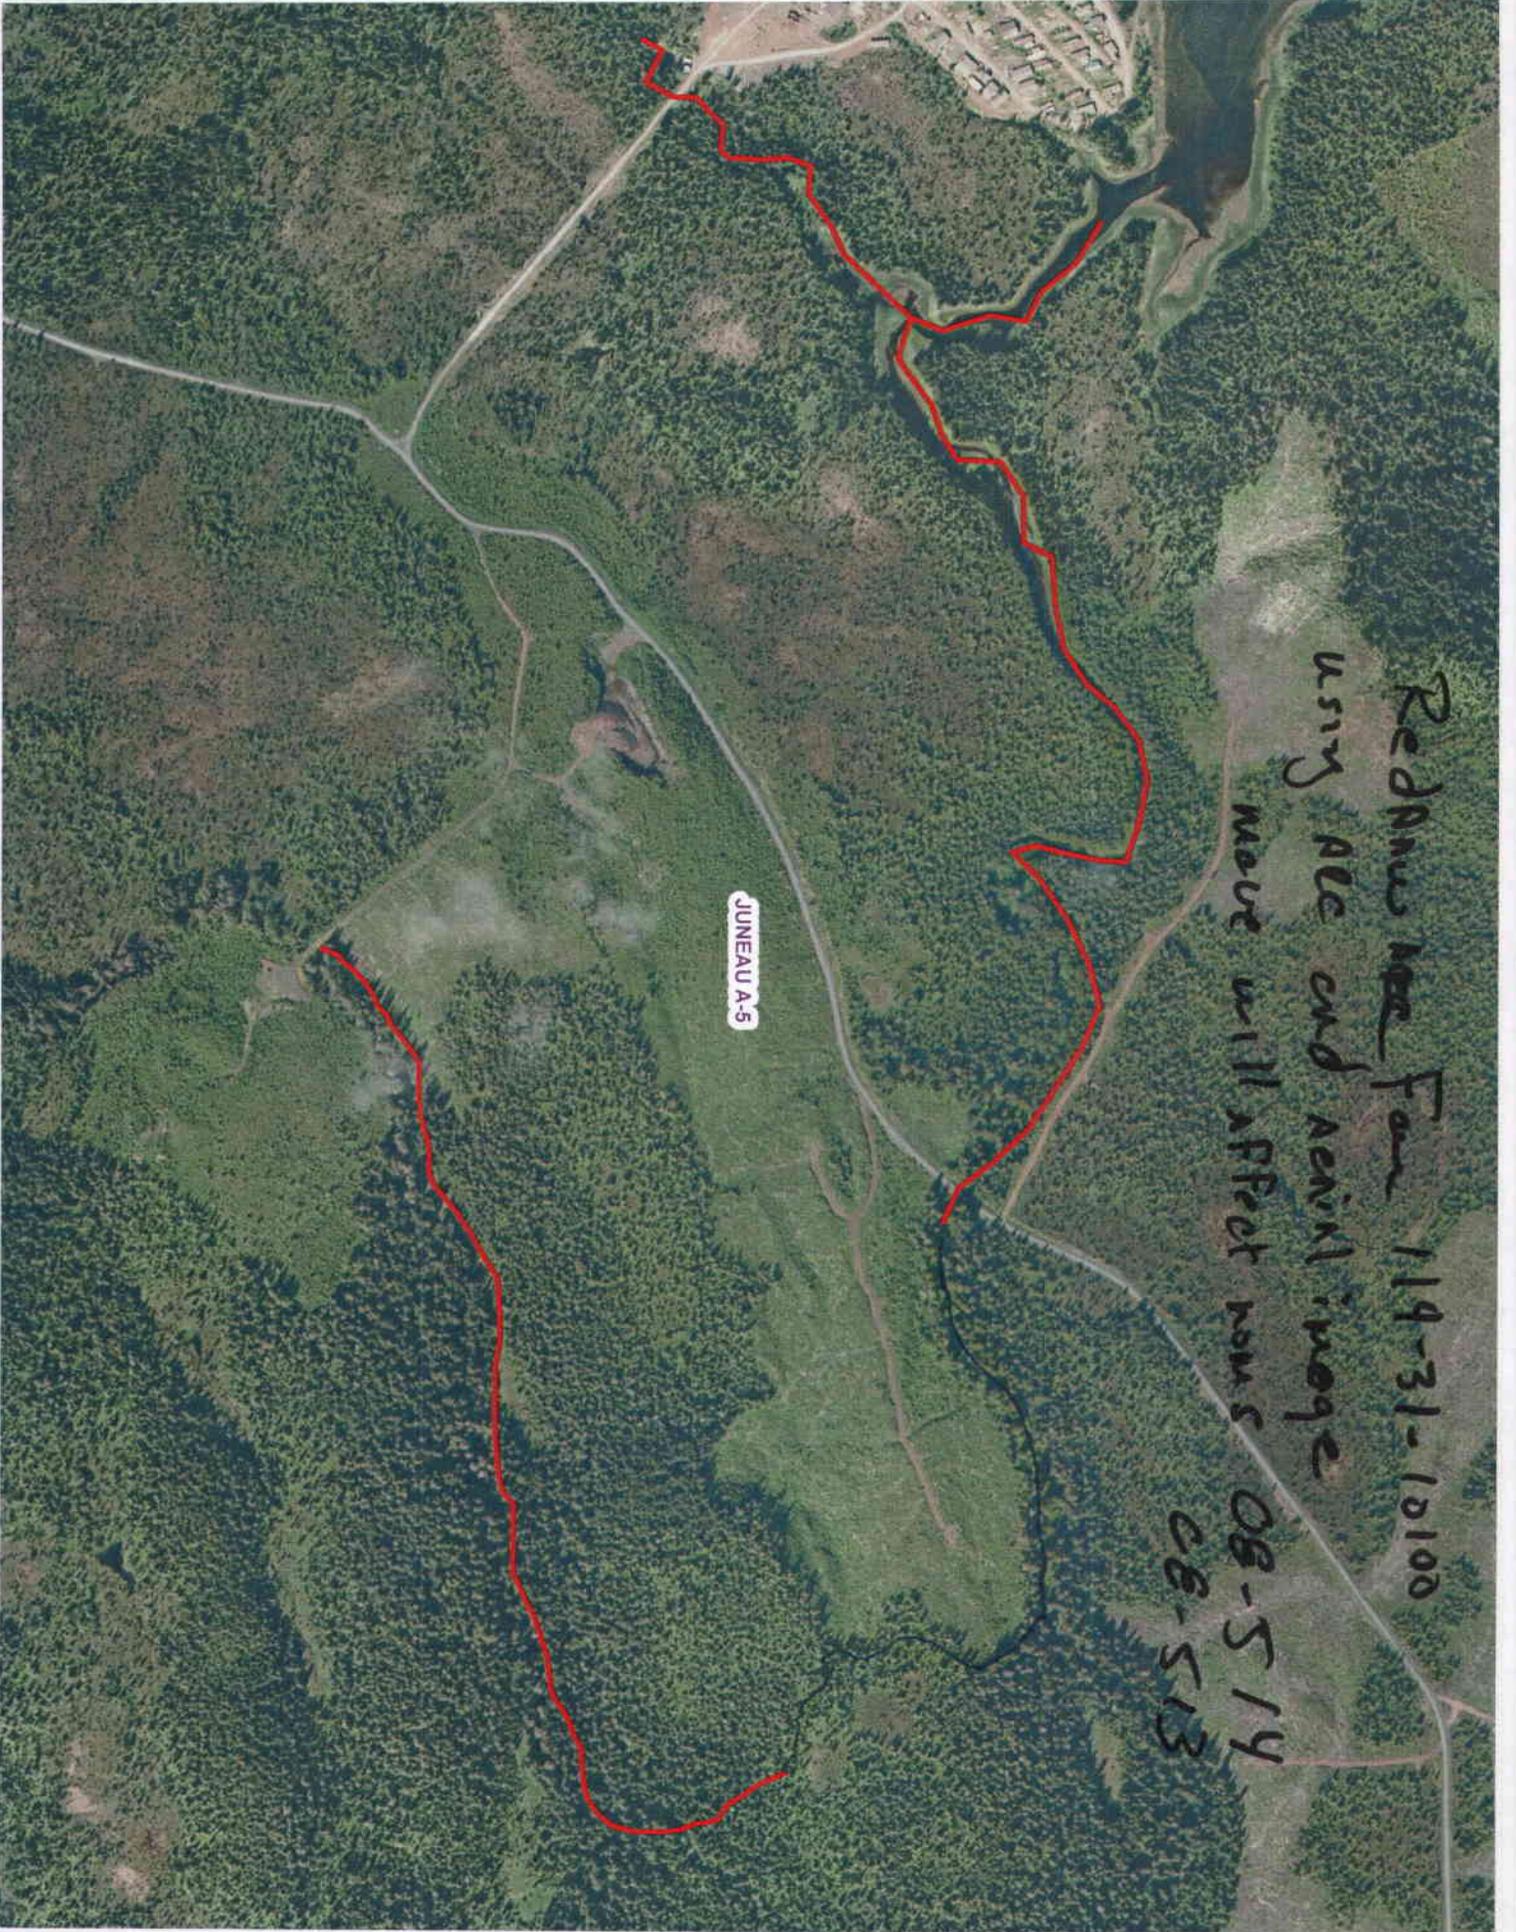

Redlines here from 119-31-10100  
using ALE and aerial image  
more will affect rows  
08-514  
08-513

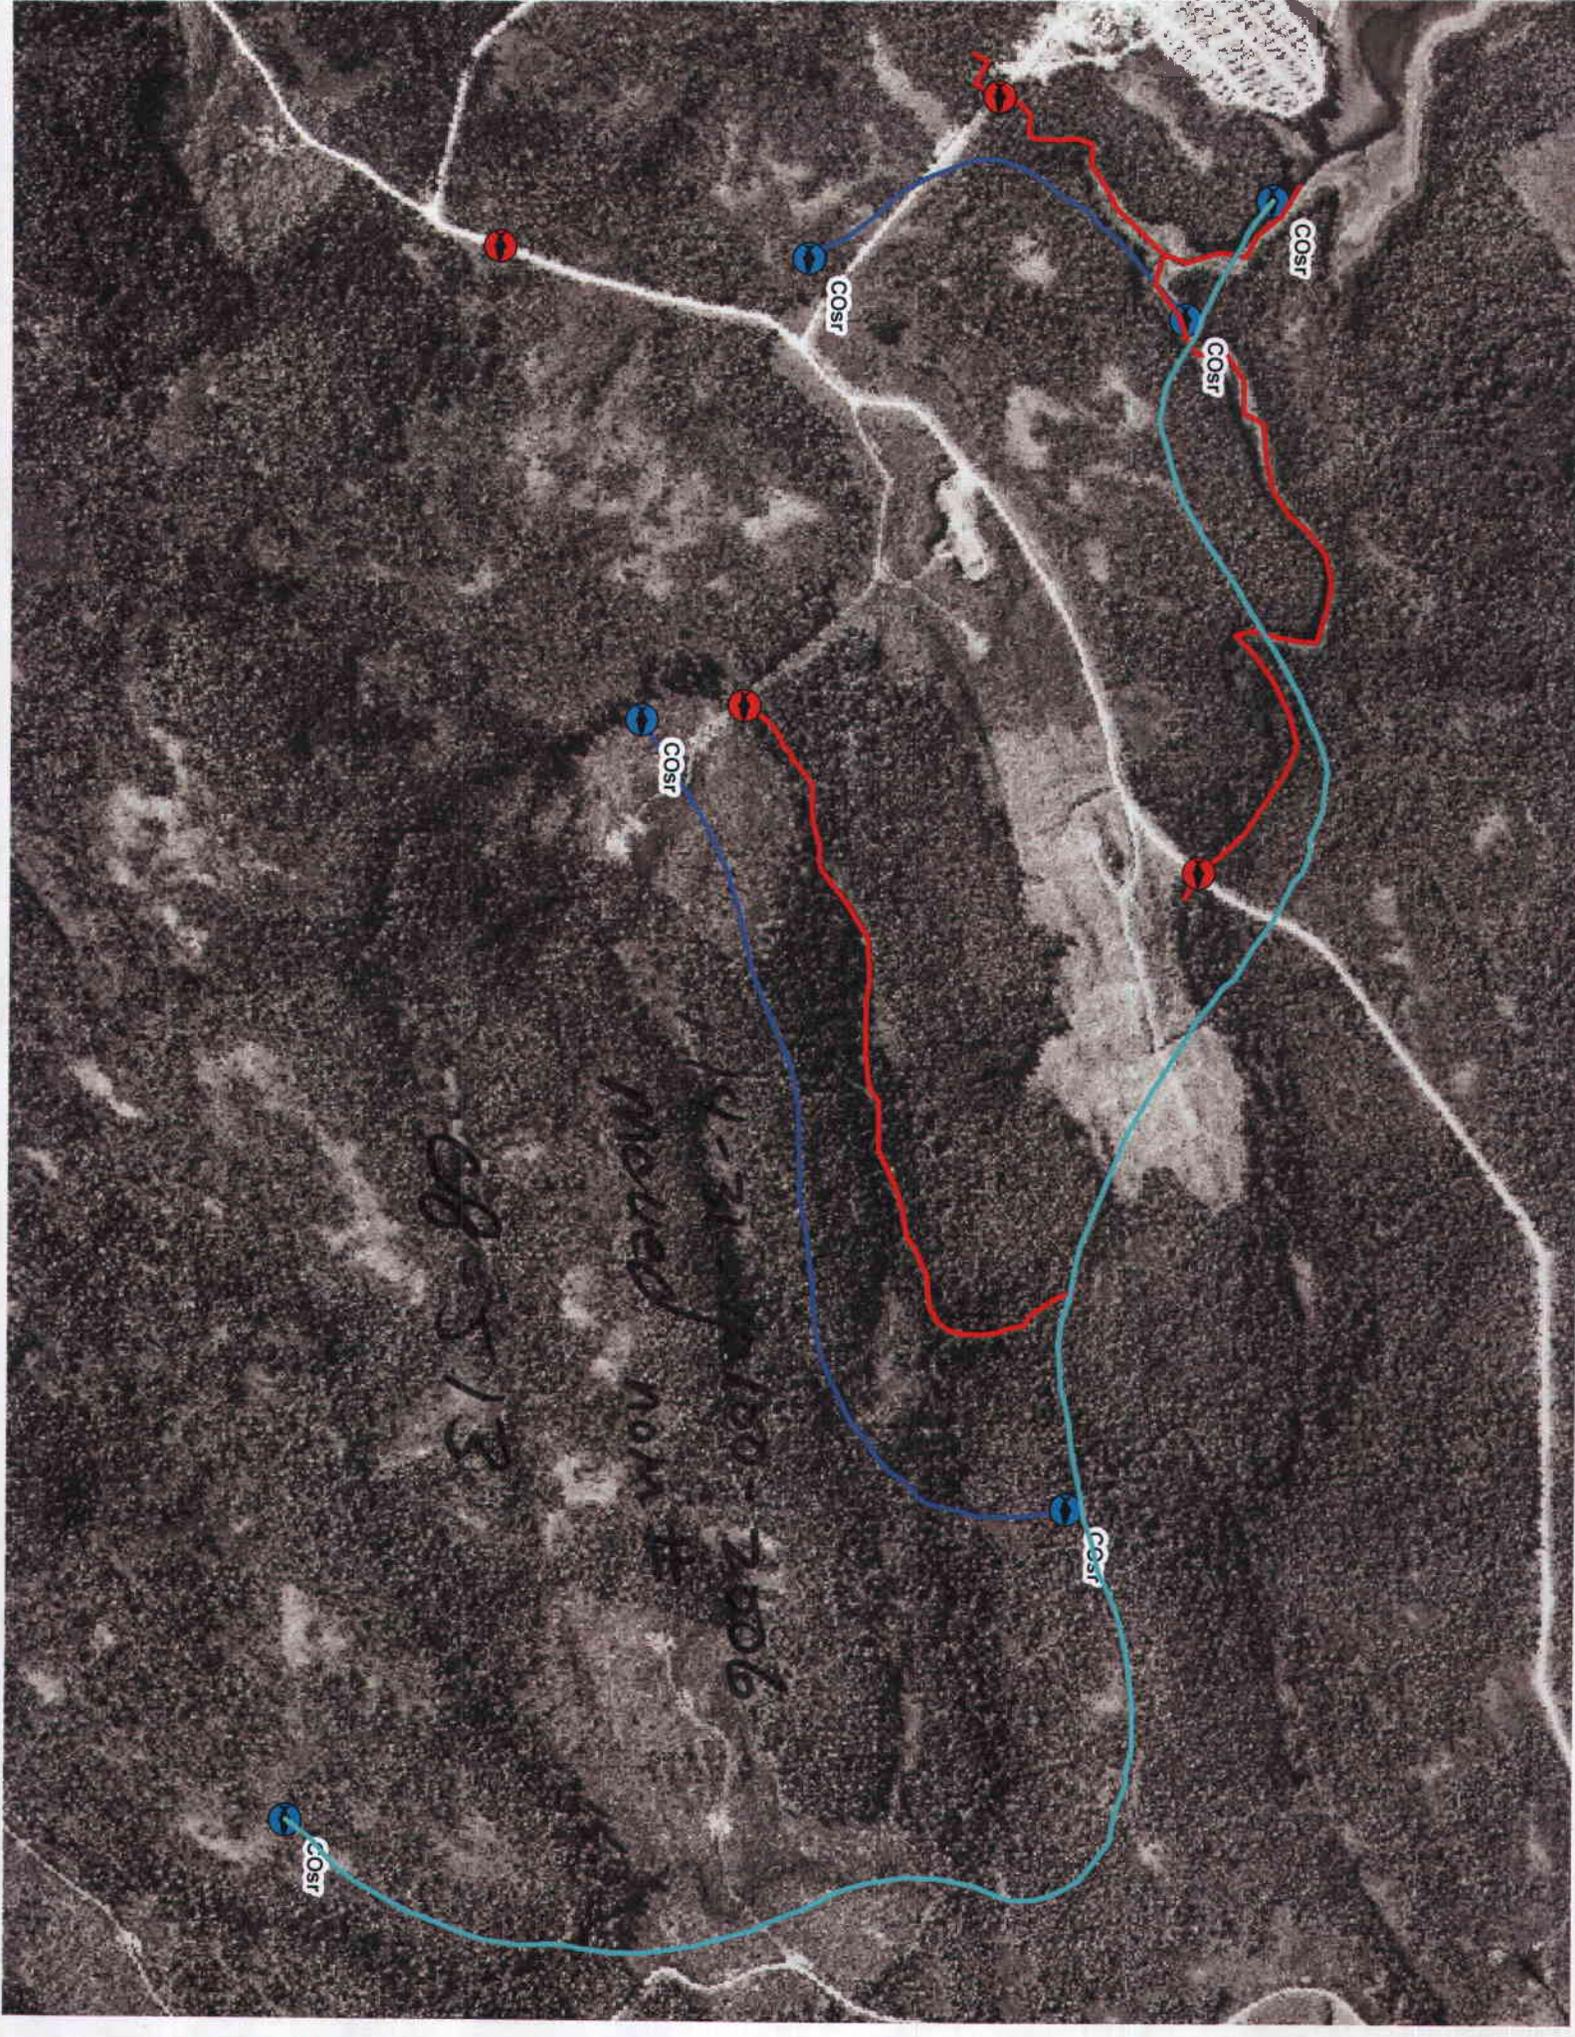

moved from # 2006

08-13

COST

COST

