



Region Southwestern

USGS Quad(s) SUTWIK ISLAND D-4

Fish Distribution Database Number of Waterway 272-80-10600

Name of Waterway Camp Creek USGS Name Local Name

Addition Deletion Correction Backup Information

For Office Use

Nomination # <u>07 720</u>	<u>[Signature]</u> ADF&G Fisheries Scientist	<u>11/2/02</u> Date
Revision Year: <u>2008</u>	<u>[Signature]</u> ADNR OHMP Operations Mgr.	<u>11/2/07</u> Date
Revision to: Atlas _____ Catalog _____ Both <u>X</u>	<u>[Signature]</u> FDD Project Biologist	<u>10/21/07</u> Date
Revision Code: <u>[Signature] A3</u>	<u>[Signature]</u> Cartographer	<u>11/26/07</u> Date

OBSERVATION INFORMATION

Species	Date(s) Observed	Spawning	Rearing	Present	Anadromous
coho salmon				X	<input checked="" type="checkbox"/>
					<input type="checkbox"/>
					<input type="checkbox"/>
					<input type="checkbox"/>
					<input type="checkbox"/>

IMPORTANT: Provide all supporting documentation that this water body is important for the spawning, rearing or migration of anadromous fish, including: number of fish and life stages observed; sampling methods, sampling duration and area sampled; copies of field notes; etc. Attach a copy of a map showing location of mouth and observed upper extent of each species, as well as other information such as: specific stream reaches observed as spawning or rearing habitat; locations, types, and heights of any barriers; etc.

Comments: Salmon presence based on observations made during surveys conducted by USF&WS personnel. Data from agency report - Carrying capacity of habitats used seasonally by coho salmon in the kametolook River 2002 - 2003, Alaska Peninsula National Wildlife Refuge


*Substantiates presence of adult coho salmon
add local name "Camp CREEK" to DTB*

Name of Observer (please print): Jeffrey Anderson
Signature: [Signature]
Agency: USF&WS
Address: 605 West 4th Avenue
Anchorage, Alaska 99501

Date: 10/12/07

This certifies that in my best professional judgment and belief the above information is evidence that this waterbody should be included in or deleted from the Fish Distribution Database.

Signature of Area Biologist: _____ Date: _____ Revision 02/05
Name of Area Biologist (please print): _____

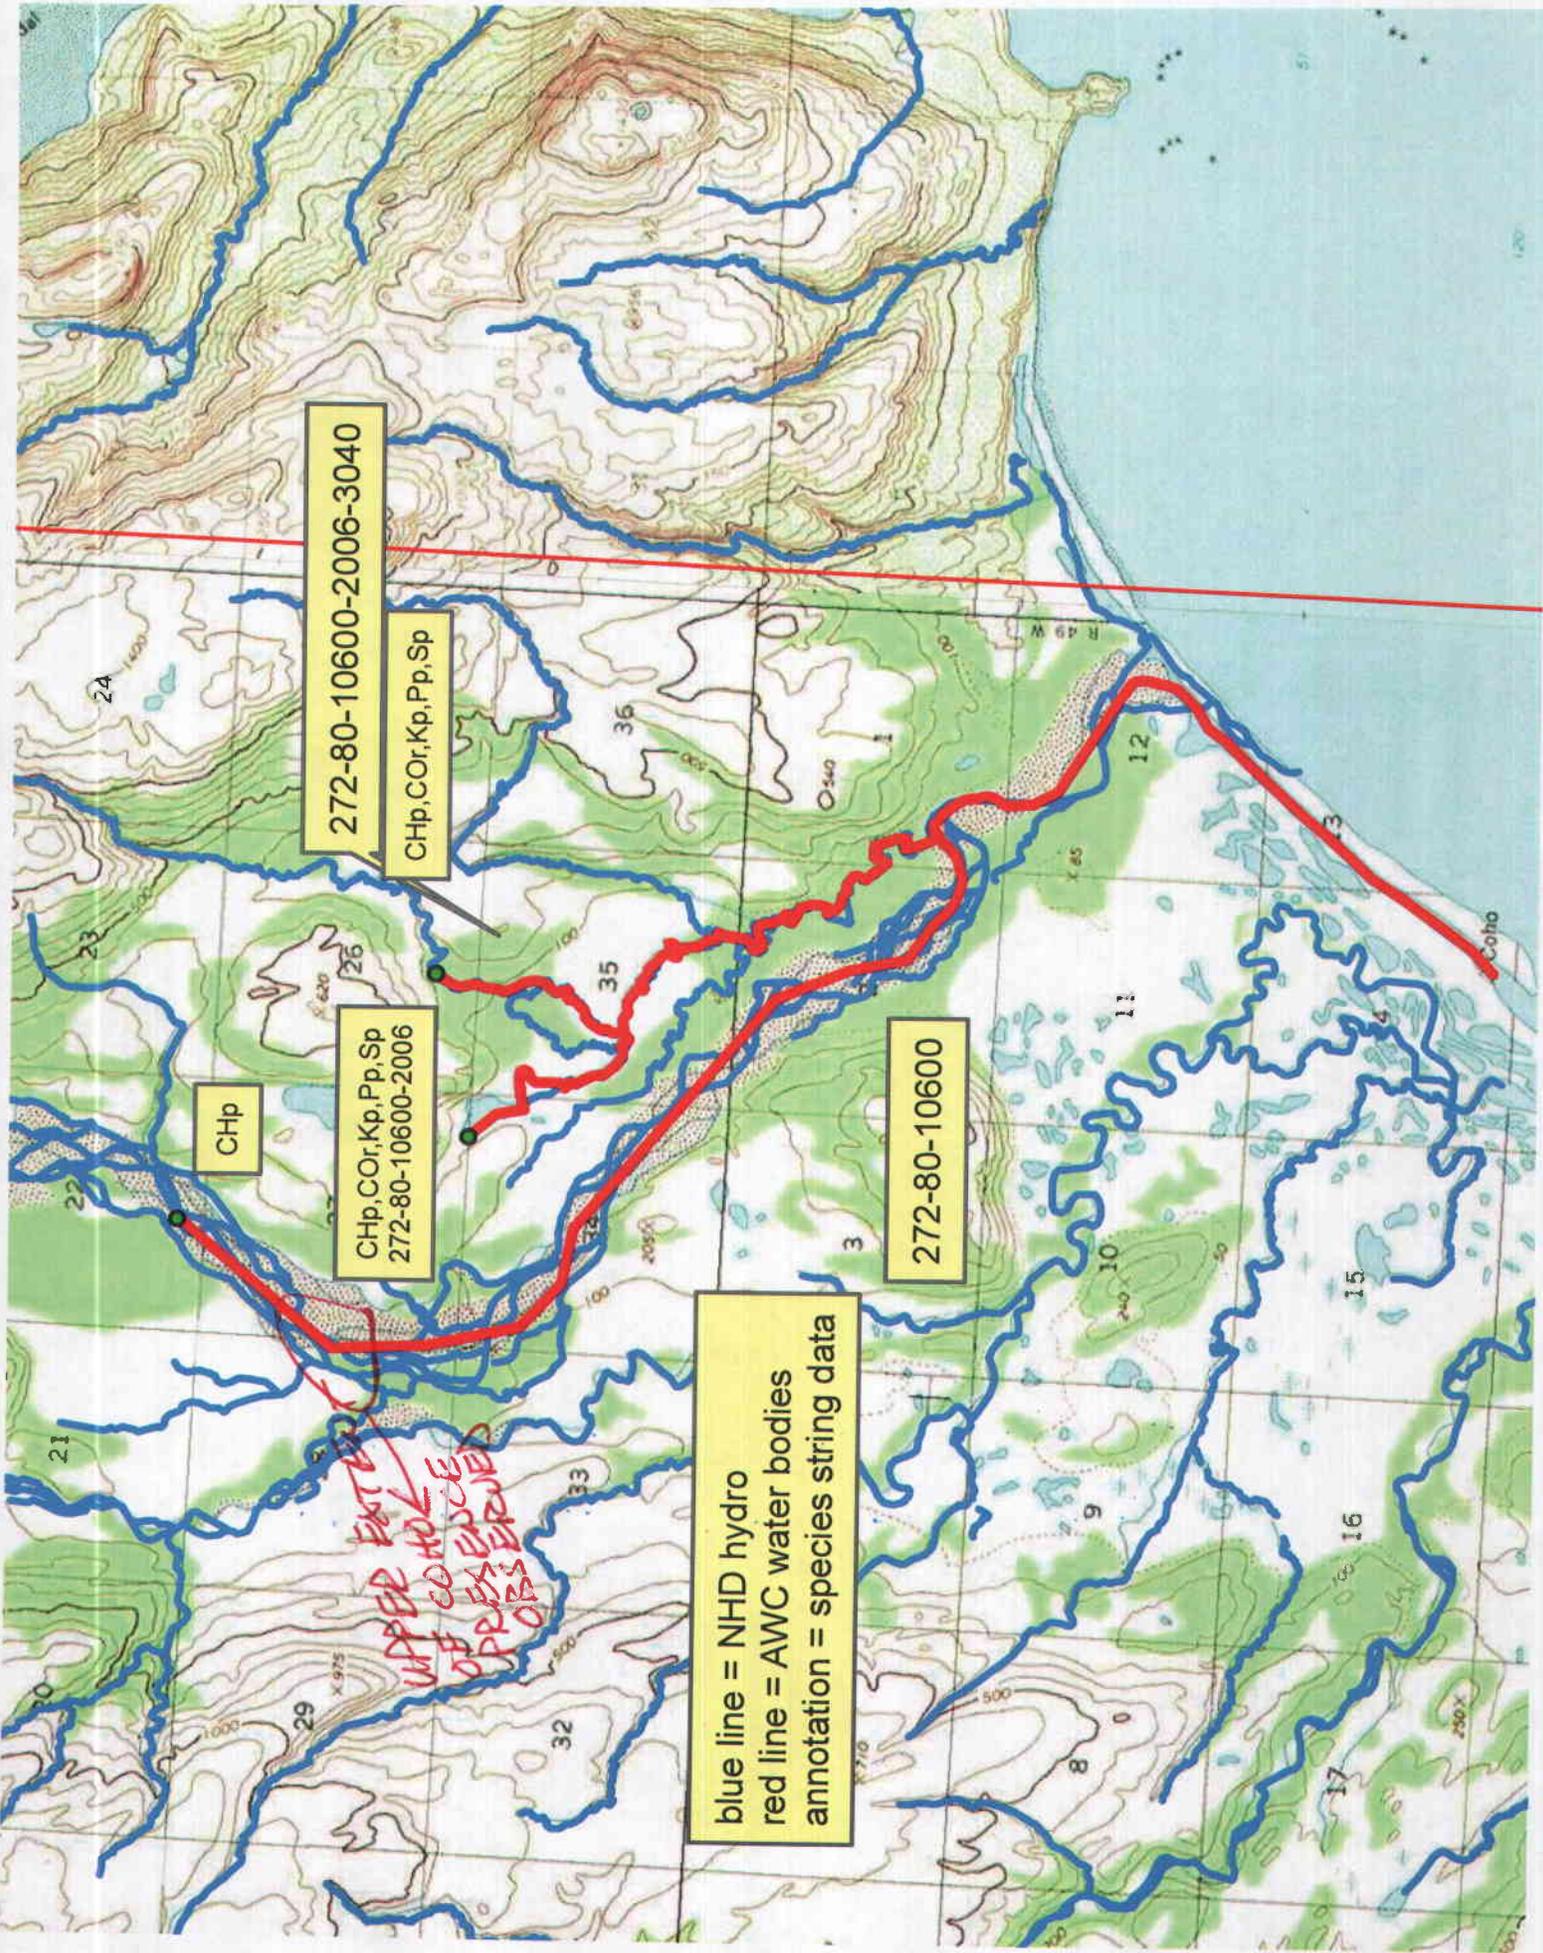

blue line = NHD hydro
red line = AWC water bodies
annotation = species string data

272-80-10600-2006-3040

CHp,CO,Or,Kp,Pp,Sp

CHp,CO,Or,Kp,Pp,Sp
272-80-10600-2006

CHp

272-80-10600

UPPER EXTENT
OF CO HOLES
OBSERVED

CoHo

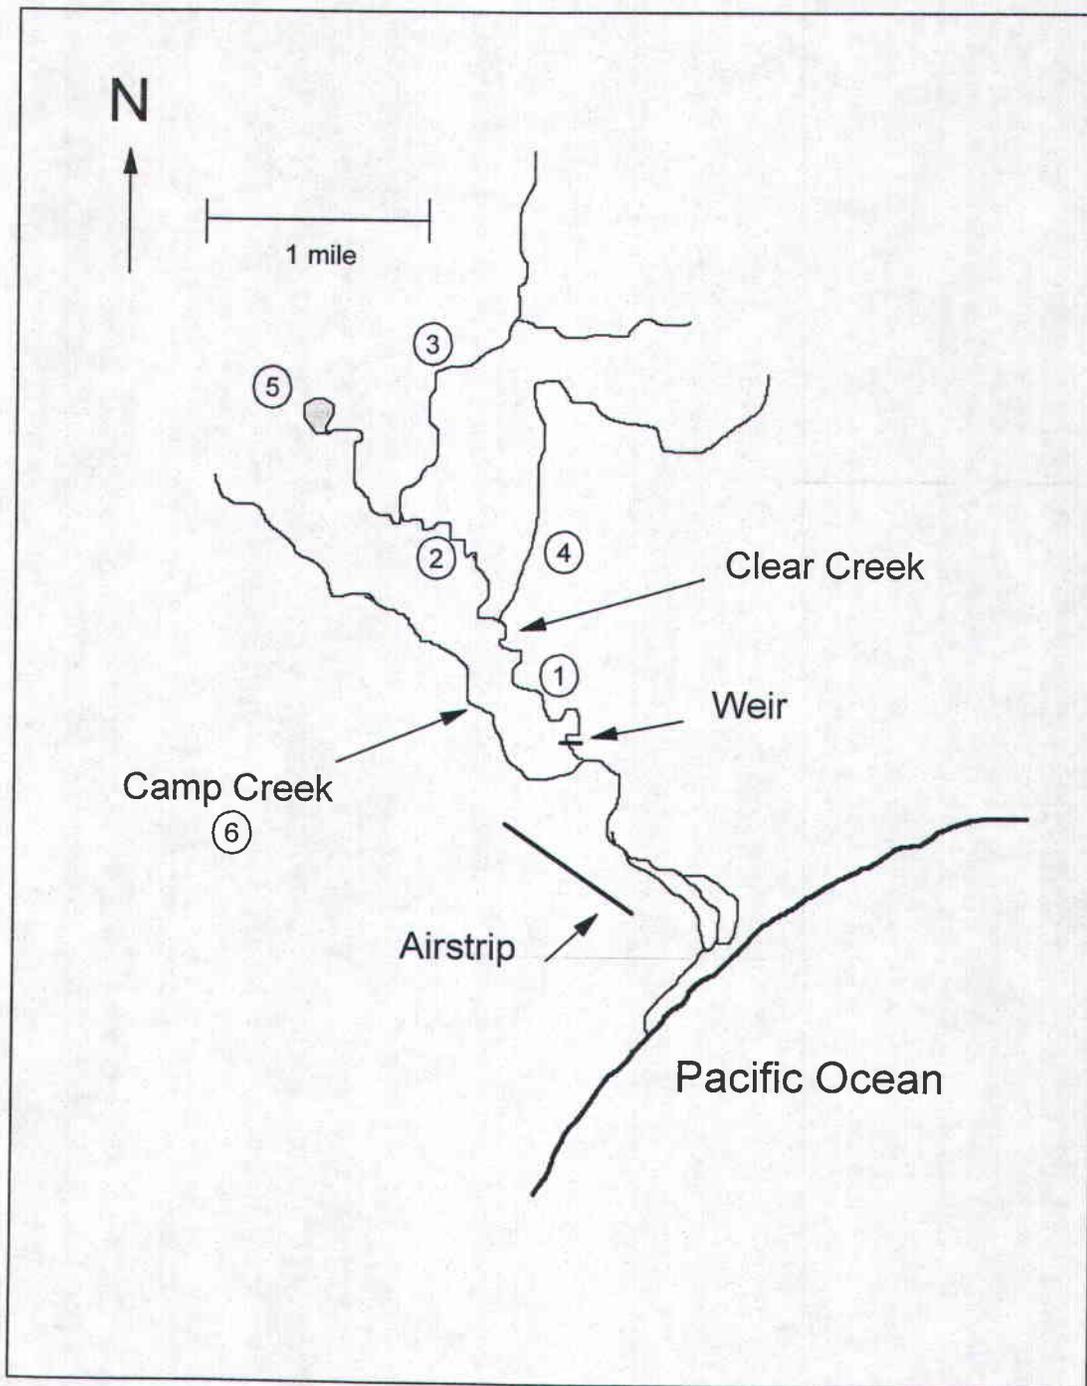


Figure 3. Clear Creek study area showing sampling strata (circled numbers), Alaska Peninsula National Wildlife Refuge.