



State of Alaska
Department of Fish and Game
Division of Sport Fish

Nomination Form
Anadromous Waters Catalog

JB

Region III, Southwestern USGS Quad(s) Bristol Bay B-1 & A-1
Anadromous Waters Catalog Number of Waterway 318-20-10200

Name of Waterway Mud Creek USGS Name Local Name
 Addition Deletion Correction Backup Information

For Office Use

Nomination # <u>09-050</u>	<u>[Signature]</u> Fisheries Scientist	<u>5/26/09</u> Date
Revision Year: <u>2010</u>	<u>[Signature]</u> Habitat Operations Manager	<u>5/26/09</u> Date
Revision to: Atlas _____ Catalog _____ Both <u>X</u>	<u>[Signature]</u> AWC Project Biologist	<u>01/23/09</u> Date
Revision Code: <u>B-1</u>	<u>[Signature]</u> Cartographer	<u>6/16/09</u> Date

OBSERVATION INFORMATION

Species	Date(s) Observed	Spawning	Rearing	Present	Anadromous
pink salmon	published in AMR, year in ()	yes		yes	<input checked="" type="checkbox"/>
					<input type="checkbox"/>
					<input type="checkbox"/>
					<input type="checkbox"/>
					<input type="checkbox"/>


IMPORTANT: Provide all supporting documentation that this water body is important for the spawning, rearing or migration of anadromous fish, including number of fish and life stages observed; sampling methods, sampling duration and area sampled; copies of field notes; etc. **Attach a copy of a map showing location of mouth and observed upper extent of each species**, as well as other information such as: specific stream reaches observed as spawning or rearing habitat; locations, types, and heights of any barriers; etc.

318-20.04 Mud Creek. Aerial surveys have been conducted on this system since the **1970s** and observers have noted the presence of **pink, sockeye, coho, chum, and chinook salmon**, which has been published in our ADF&G Annual Salmon Management Reports (AMR).

Please add pink (2006) salmon; please see attached map.
Add pink salmon presence spawning to 318-20-10200

Name of Observer (please print): on file; name and date is published in AMR
Signature: _____ Date: _____
Agency: Alaska Department of Fish & Game
Address: 211 Mission Road
Kodiak, Alaska 99615

This certifies that in my best professional judgment and belief the above information is evidence that this waterbody should be included in or deleted from the Anadromous Waters Catalog.
Signature of Area Biologist: Robert Murphy Date: 4/14/08 Revision 02/08
Name of Area Biologist (please print): Robert Murphy, FBIII

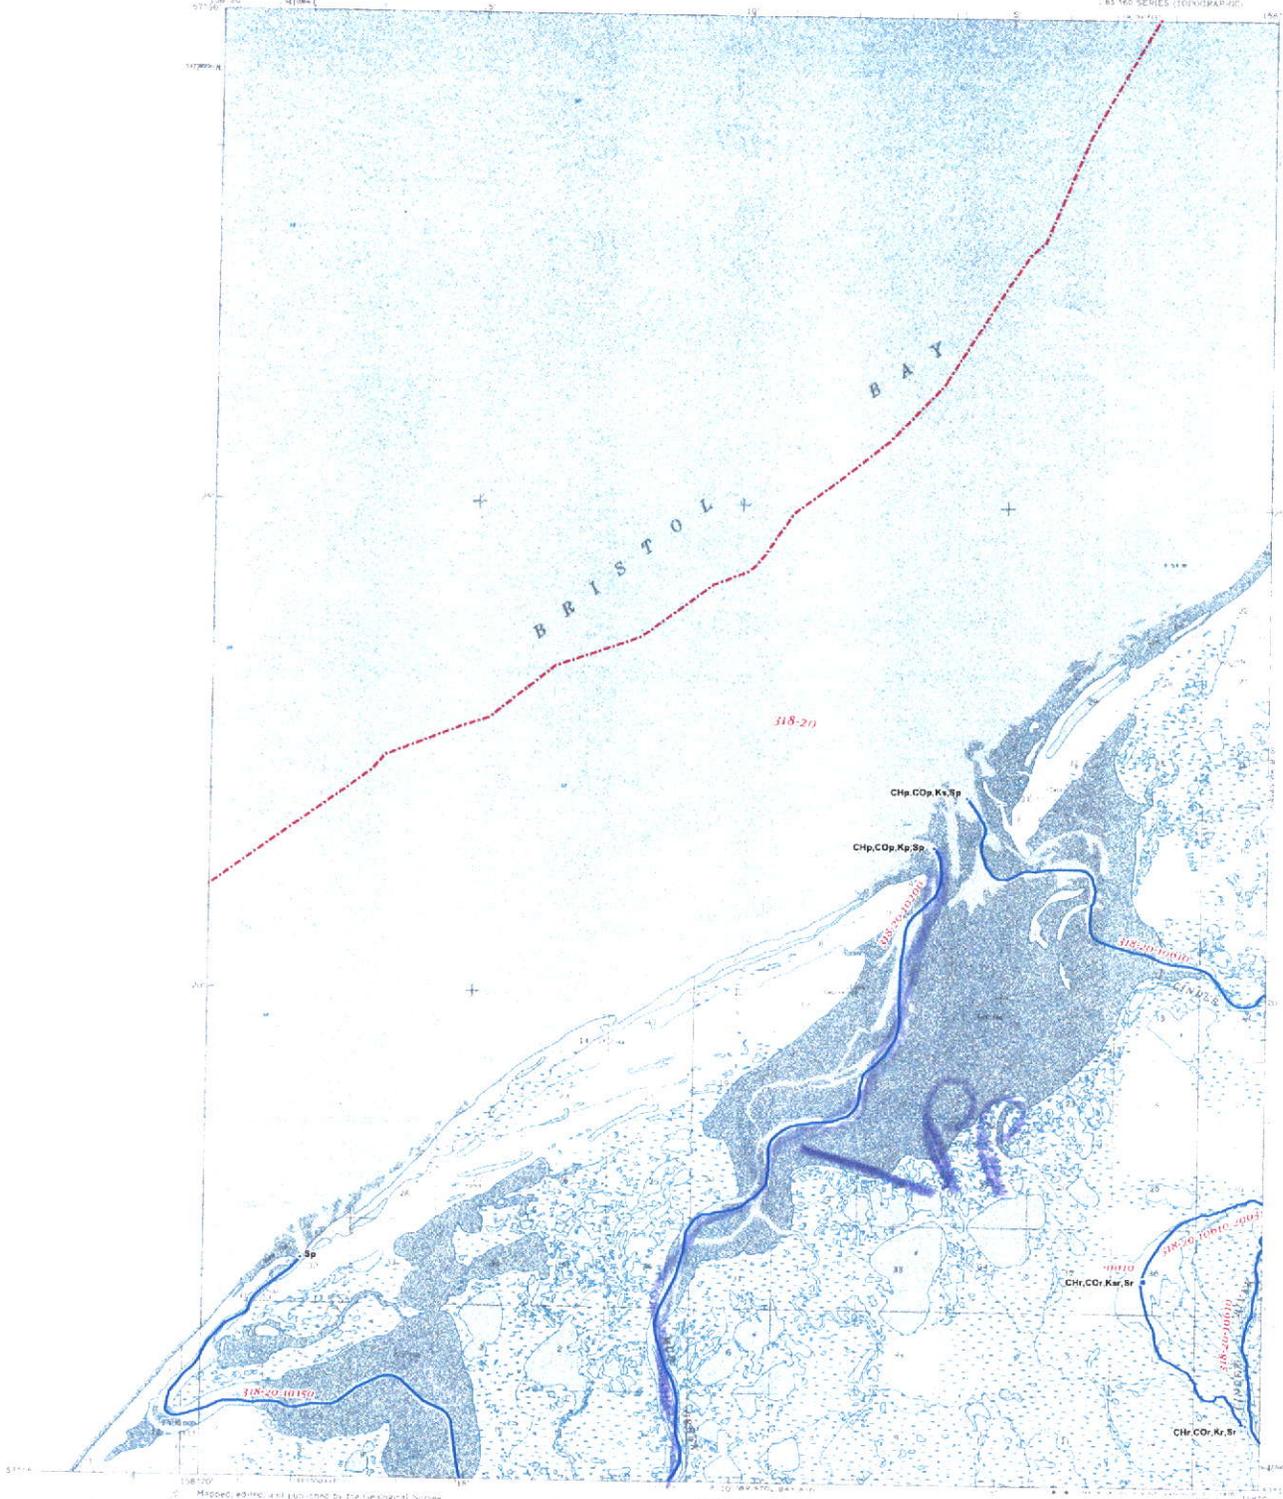

Key to Robert Murphy's Maps

- P = Purple** **CO = Blue**
CH = Green **S = Red** **K = Yellow**
DV = Orange
SH = Brown

• Lower/Upper Point of Stream
 L Midstream Species Begin/End Point
 ★ Short Stream (Under 600 feet)
 ■ Lake
 ▲ Barrier
 Anadromous Streams
 Anadromous Areas
 AWC Stat Area
 Regional Boundary

Waters important to Anadromous Fish are listed pursuant to AS 41.14.870. Specified species distribution and life functions reflect known data. Actual distribution and use may extend beyond specified limits. Migration upstream and/or downstream is assumed for specified stream reaches.

SPECIES CODES	
CO	coho salmon
CH	chum salmon
K	king salmon (king)
P	pink salmon
S	sockeye salmon
AC	Arctic char
CT	cutoffthroat trout
DV	Dolly varies
SH	steelhead
SP	Inconnu (sheefish)
W	wildfishes
DU	eulachon
SM	smelt
ST	sturgeon
AL	Arctic lamprey
LP	lamprey (land/feralized)
PC	Pacific lamprey
LV	river lamprey
LIFE STAGE CODES	
p	Present
m	Migration
r	Rearing
k	Known
s	Spawning




Produced By
State of Alaska
Department of Fish and Game

Fish Distribution Database Atlas

Quad No. 041

**Bristol Bay
B-1**

Revision Date 3/20/2008

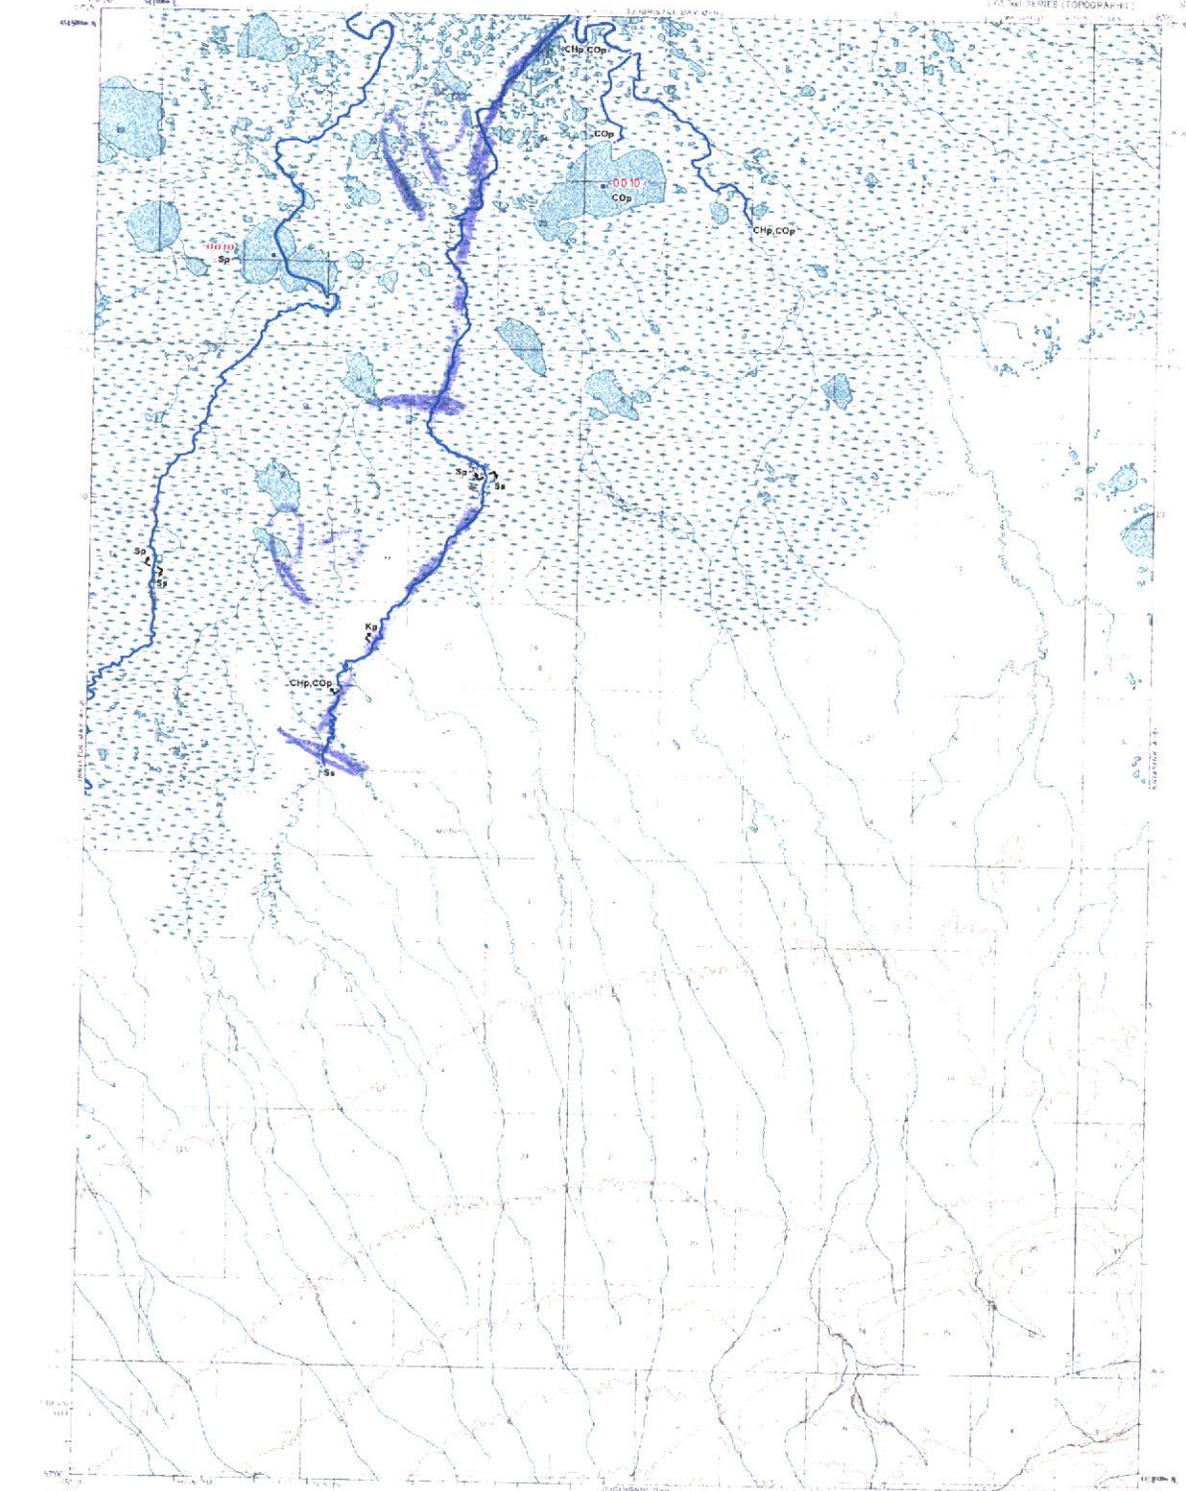

Map of Alaska and outline of the Geological Survey
Copyright 1963 by the U.S. Geological Survey
This map is published as a separate sheet in the
United States Geological Survey Bulletin 1150, Alaska
Geological Survey, and is available for sale in
quantity at a special price. For more information,
see the back cover of this map.



SCALE 1:50,000
FOR SALE BY U.S. GEOLOGICAL SURVEY
FAIRBANKS, ALASKA 99701, DENVER, COLORADO 80226, OR WASHINGTON, D.C. 20542
A FOLDER DESCRIBING TOPOGRAPHIC MAPS AND SYMBOLS IS AVAILABLE ON REQUEST



BRISTOL BAY (A-1) ALASKA
1:50,000 (7/1963/150)

Key to Robert Murphy's Maps
P = Purple **CO = Blue**
CH = Green **S = Red** **K = Yellow**
DV = Orange
SH = Brown



Add pink salmon
resort or spawning
to 318-20-10200

PS
PS

PS
PP

PPV

A-5

B-6

B-1

A-2