



State of Alaska  
Department of Fish and Game  
Division of Sport Fish

Nomination Form  
Anadromous Waters Catalog

JB

Region III, Southwestern USGS Quad(s) Chignik C- 2  
Anadromous Waters Catalog Number of Waterway 317-20-10700-2020

Name of Waterway Braided Creek  USGS Name  Local Name  
 Addition  Deletion  Correction  Backup Information

For Office Use

Nomination # <u>09-064</u>	<u>[Signature]</u> Fisheries Scientist	<u>5/26/09</u> Date
Revision Year: <u>2010</u>	<u>[Signature]</u> Habitat Operations Manager	<u>5/26/09</u> Date
Revision to: Atlas _____ Catalog _____ Both <u>X</u>	<u>[Signature]</u> AWC Project Biologist	<u>01/29/09</u> Date
Revision Code: <u>B-1</u>	<u>[Signature]</u> Cartographer	<u>4/17/09</u> Date

OBSERVATION INFORMATION

Species	Date(s) Observed	Spawning	Rearing	Present	Anadromous
dolly varden	see below			yes	<input checked="" type="checkbox"/>
					<input type="checkbox"/>
					<input type="checkbox"/>
					<input type="checkbox"/>
					<input type="checkbox"/>

**IMPORTANT:** Provide all supporting documentation that this water body is important for the spawning, rearing or migration of anadromous fish, including: number of fish and life stages observed; sampling methods, sampling duration and area sampled; copies of field notes; etc. **Attach a copy of a map showing location of mouth and observed upper extent of each species,** as well as other information such as: specific stream reaches observed as spawning or rearing habitat; locations, types, and heights of any barriers; etc.

**317-20.7B. Braided Creek.** Aerial surveys have been conducted on this system since the **1960s** and observers have noted the presence of **sockeye, coho, chum and chinook salmon**, which has been published in our ADF&G Annual Salmon Management Reports (AMR).

add Dolly Varden present to 317-20-10700-2020

**In addition, I have been the area biologist who conducted aerial surveys in this region for the past 19 years and have personally witnessed dolly varden in this stream; please add.**


Name of Observer (please print): Robert Murphy Date: \_\_\_\_\_  
Signature: \_\_\_\_\_  
Agency: Alaska Department of Fish & Game  
Address: 211 Mission Road  
Kodiak, Alaska 99615

This certifies that in my best professional judgment and belief the above information is evidence that this waterbody should be included in or deleted from the Anadromous Waters Catalog.

Signature of Area Biologist: Robert Murphy Date: 11/14/08 Revision 02/08  
Name of Area Biologist (please print): Robert Murphy, FBIII





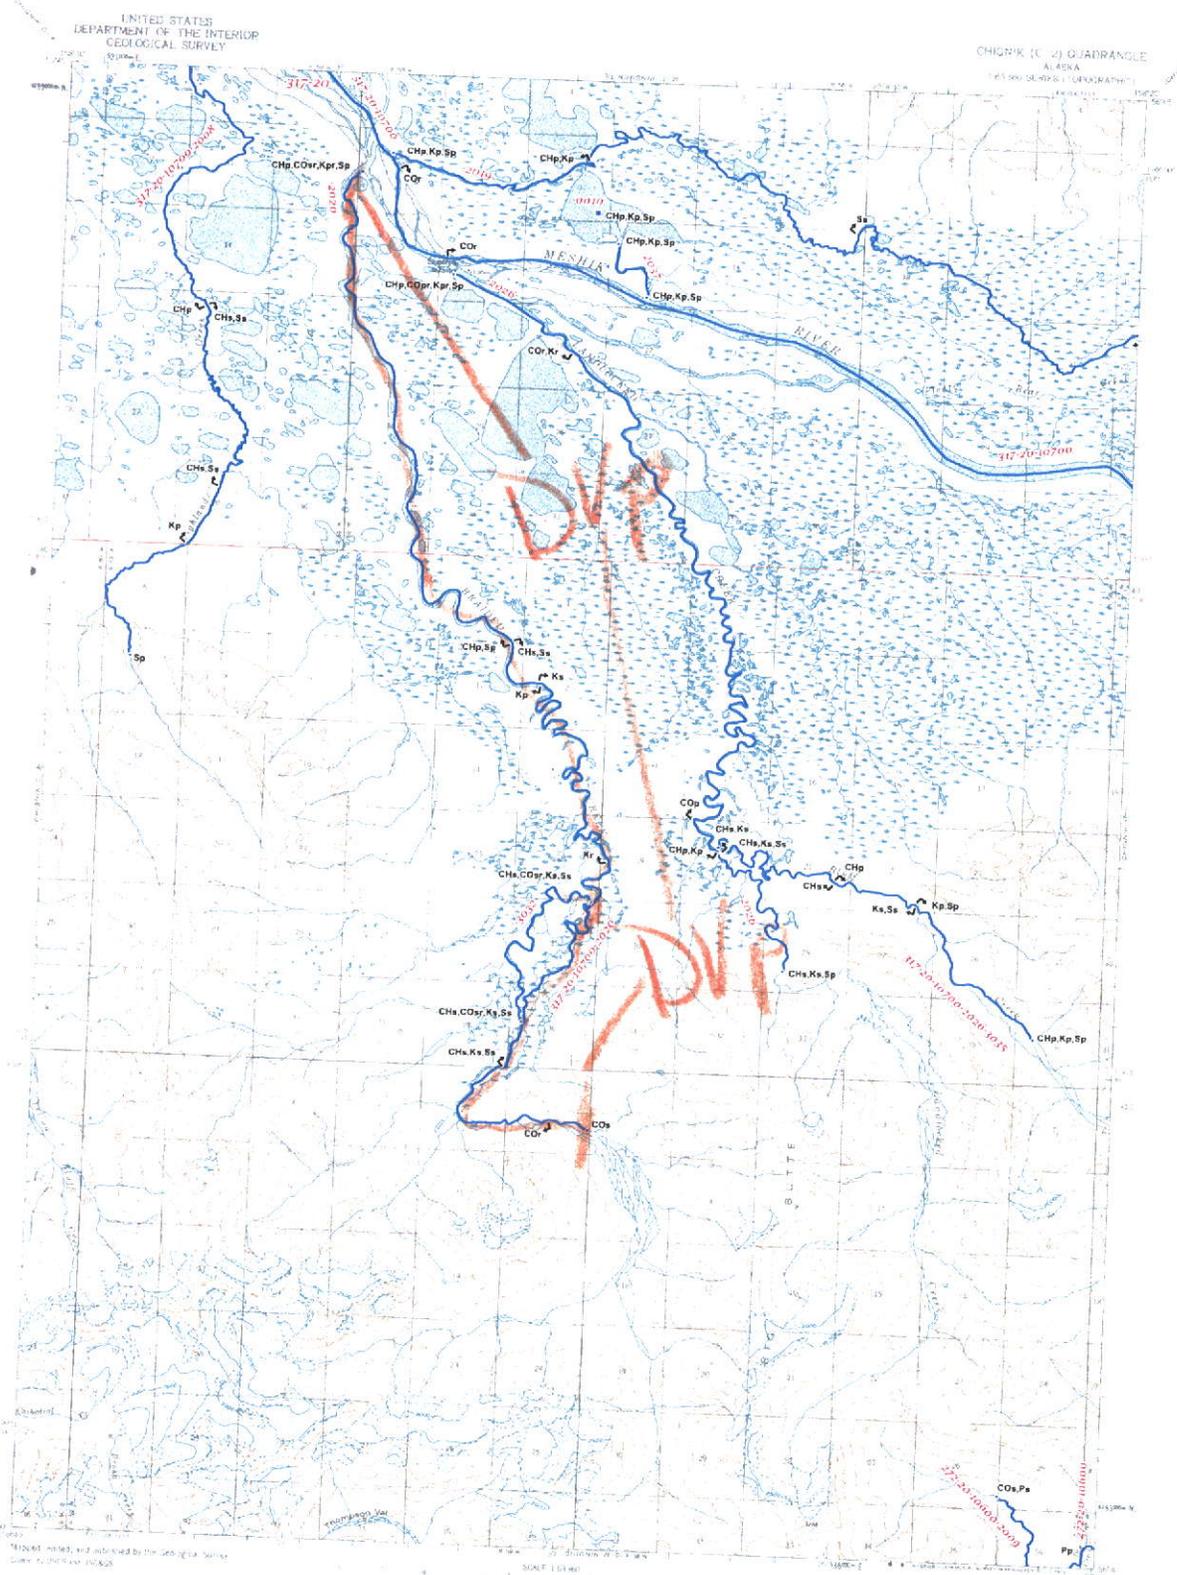

**Key to Robert Murphy's Maps**

- P = Purple**    **CO = Blue**
- CH = Green**    **S = Red**    **K = Yellow**
- DV = Orange**
- SH = Brown**

• Lower/Upper Point of Stream  
 † Midstream Species Begin/End Point  
 ★ Short Stream (Under 660 feet)  
 ■ Lake  
 ▲ Barrier

Anadromous Streams  
 Anadromous Areas  
 AWC Stat Area  
 Regional Boundary

Waters Important to Anadromous Fish are listed pursuant to AS 41.14.870. Specified species distribution and life functions reflect known data. Actual distribution and use may extend beyond specified limits. Migration upstream and/or downstream is assumed for specified stream reaches.

SPECIES CODES		LIFE STAGE CODES	
CO	coho salmon	P	Present
CH	chum salmon	M	Migration
K	king salmon	R	Rearing
P	pink salmon	K	Known
S	sockeye salmon	S	Spawning
AC	Arctic char		
CT	cutthroat trout		
DU	Dolly Varden		
SH	steelhead		
WF	winter whitefish		
W	whitefish		
DU	cutthroat trout		
SM	smelt		
ST	sturgeon		
AL	Arctic lamprey		
LP	lamprey (unidentified)		
PC	Pacific lamprey		
LV	river lamprey		



**Fish Distribution Database Atlas**


Quad No. 034

**Chignik  
C-2**

Revised Date 1/17/2006

FOR SALE BY U.S. GEOLOGICAL SURVEY  
ALASKA 92701 DENVER COLORADO 86000 OR WASHINGTON, D.C. 20542  
DESCRIPTIVE CATALOGUE MAPS AND ORDERS IS AVAILABLE ON REQUEST

CHIGNIK (C-2) ALASKA  
SCALE 1:50,000 (1:62,500)  
1963

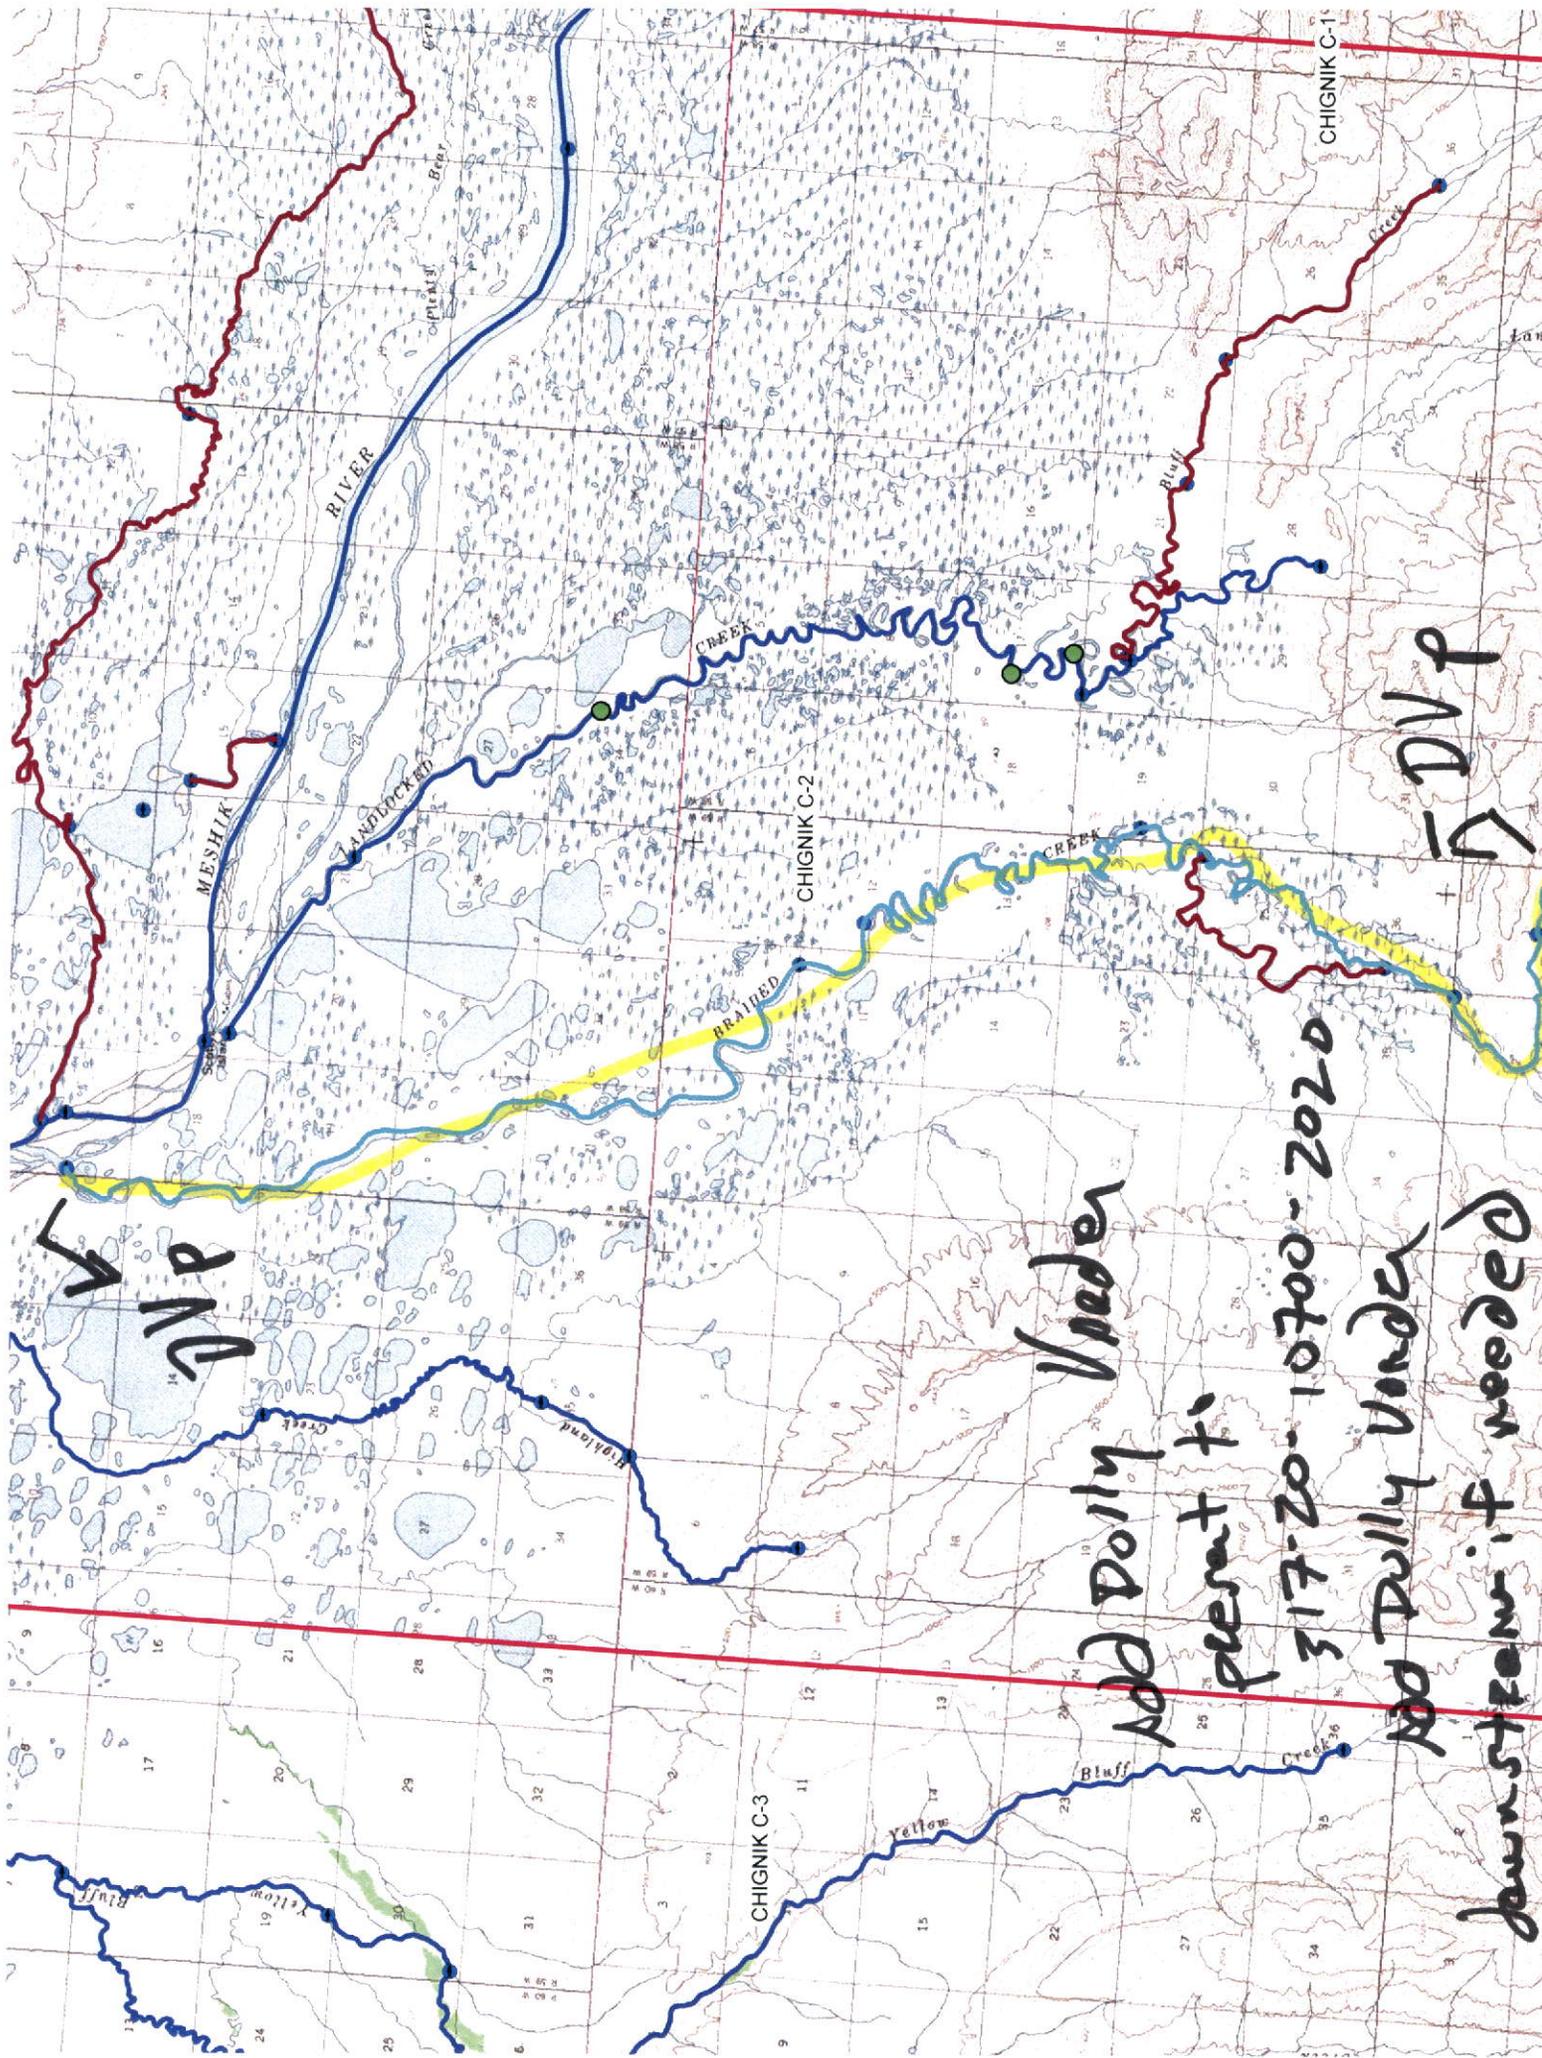

DVP

Add Dolly Under

present to

317.20-10700-2020

Add Dolly Under  
downstream if needed

DVP

CHIGNIK C-1

CHIGNIK C-2

CHIGNIK C-3

MESHIK RIVER

ANDLOCKETT RIVER

CREEK

BR. ICED CREEK

CREEK

Yellow

Bluff

Creek

Peck