



State of Alaska
Department of Fish and Game
Division of Sport Fish

Nomination Form
Anadromous Waters Catalog

JS

Region III, Southwestern USGS Quad(s) Chignik C-1; D-1
Anadromous Waters Catalog Number of Waterway 317-20-10700-2099

Name of Waterway Waterfall Creek USGS Name Local Name
 Addition Deletion Correction Backup Information

For Office Use

Nomination # <u>09-071</u> Revision Year: <u>2010</u> Revision to: Atlas _____ Catalog _____ Both <u>y</u> Revision Code: <u>6-LF-1</u>	<table style="width: 100%; border-collapse: collapse;"> <tr> <td style="border-bottom: 1px solid black; width: 60%;"></td> <td style="border-bottom: 1px solid black; width: 40%;"></td> </tr> <tr> <td style="text-align: center;">Fisheries Scientist</td> <td style="text-align: center;">Date</td> </tr> <tr> <td style="border-bottom: 1px solid black; text-align: center;"><i>[Signature]</i></td> <td style="border-bottom: 1px solid black;"></td> </tr> <tr> <td style="text-align: center;">Habitat Operations Manager</td> <td style="text-align: center;">Date</td> </tr> <tr> <td style="border-bottom: 1px solid black; text-align: center;"><i>[Signature]</i></td> <td style="border-bottom: 1px solid black; text-align: center;"><u>1/28/09</u></td> </tr> <tr> <td style="text-align: center;">AWC Project Biologist</td> <td style="text-align: center;">Date</td> </tr> <tr> <td style="border-bottom: 1px solid black;"></td> <td style="border-bottom: 1px solid black;"></td> </tr> <tr> <td style="text-align: center;">Cartographer</td> <td style="text-align: center;">Date</td> </tr> </table>			Fisheries Scientist	Date	<i>[Signature]</i>		Habitat Operations Manager	Date	<i>[Signature]</i>	<u>1/28/09</u>	AWC Project Biologist	Date			Cartographer	Date
Fisheries Scientist	Date																
<i>[Signature]</i>																	
Habitat Operations Manager	Date																
<i>[Signature]</i>	<u>1/28/09</u>																
AWC Project Biologist	Date																
Cartographer	Date																

OBSERVATION INFORMATION

Species	Date(s) Observed	Spawning	Rearing	Present	Anadromous
coho salmon	published in AMR, year in ()	<u>yes</u>		<u>yes</u>	<input checked="" type="checkbox"/>
					<input type="checkbox"/>
					<input type="checkbox"/>
					<input type="checkbox"/>
					<input type="checkbox"/>

IMPORTANT: Provide all supporting documentation that this water body is important for the spawning, rearing or migration of anadromous fish, including: number of fish and life stages observed; sampling methods, sampling duration and area sampled; copies of field notes; etc. **Attach a copy of a map showing location of mouth and observed upper extent of each species,** as well as other information such as: specific stream reaches observed as spawning or rearing habitat; locations, types, and heights of any barriers; etc.


317-20.7P. Waterfall Creek. Aerial surveys have been conducted on this system since the **1960s** and observers have noted the presence of **sockeye, coho, chum and chinook salmon**, which has been published in our ADF&G Annual Salmon Management Reports (AMR).

Please add coho (1970) salmon; see attached map.
Add coho salmon spawning on present to 317-20-10700-2099

Name of Observer (please print): on file; name and date is published in AMR
 Signature: _____ Date: _____
 Agency: Alaska Department of Fish & Game
 Address: 211 Mission Road
Kodiak, Alaska 99615

This certifies that in my best professional judgment and belief the above information is evidence that this waterbody should be included in or deleted from the Anadromous Waters Catalog.

Signature of Area Biologist: *Robert Murphy* Date: 11/14/08 Revision 02/08
 Name of Area Biologist (please print): Robert Murphy, FBIII

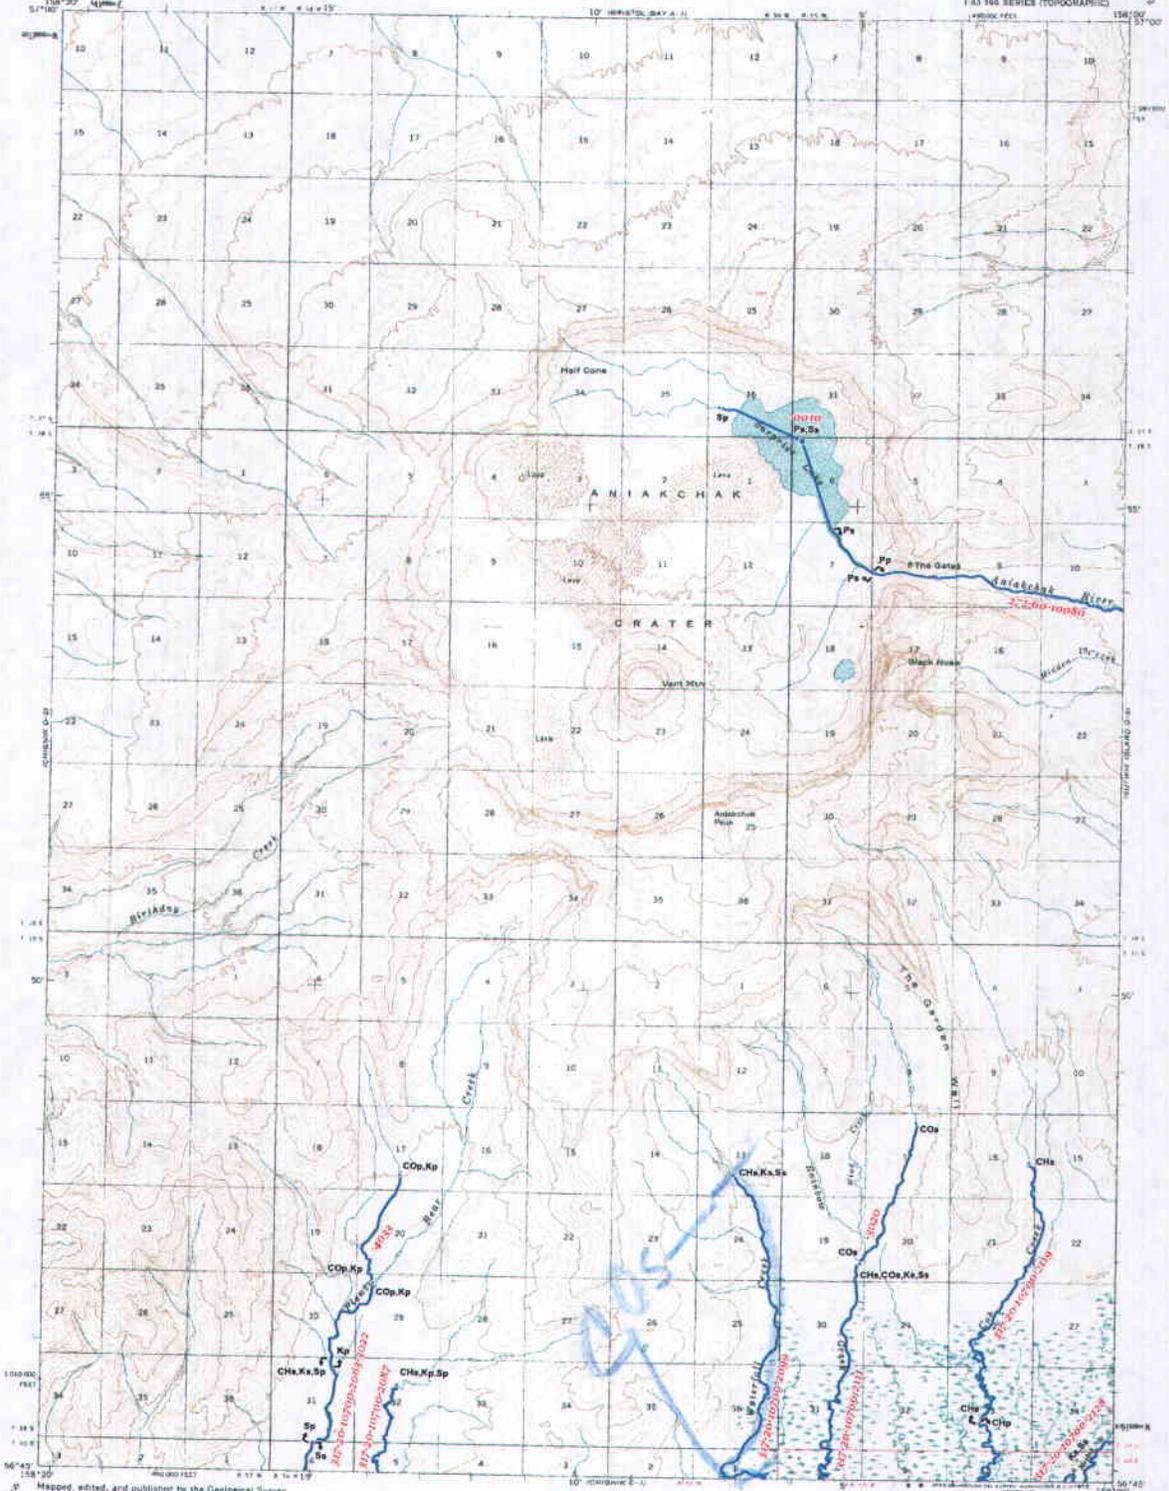

Key to Robert Murphy's Maps

P = Purple **CO = Blue**

CH = Green **S = Red** **K = Yellow**

DV = Orange

SH = Brown



FOR SALE BY U. S. GEOLOGICAL SURVEY
ALASKA 99701, DENVER, COLORADO 80228, OR WASHINGTON, D. C. 20542
DESCRIPTIVE TOPOGRAPHIC MAPS AND SYMBOLS IS AVAILABLE ON REQUEST



CHIGNIK (D-1), ALASKA
N5645 - W15800/15200
1963

• Lower/Upper Point of Stream
⋈ Midstream Species Begin/End Point
★ Short Stream (Under 600 feet)
■ Lake
▲ Barrier

• Anadromous Streams
▨ Anadromous Areas
— AWC Stat Area
— Regional Boundary


Warning: Important to Anadromous Fish are listed pursuant to AS 41.14.870. Specified species distribution and life functions reflect known data. Actual distribution and use may extend beyond specified limits. Migration upstream and/or downstream is assumed for specified stream reaches.


SPECIES CODES	
CO	coho salmon
CH	chum salmon
K	king salmon (Ming)
P	pink salmon
S	sockeye salmon
AO	Arctic char
CT	cutthroat trout
DV	Dolly varden
SH	steelhead
WF	Wentworth (herring)
W	whitefish
CU	culicid
OM	rainbow smelt
SW	swella
ST	sturgeon
AL	Arctic lamprey
LP	lamprey (unidentified)
PC	Pacific lamprey
LV	river lamprey

LIFE STAGE CODES	
P	Present
m	Migrating
R	Residing
s	Known
	Spawning



Fish Distribution Database Atlas
Quad No. 034
Chignik D-1
Published By
State of Alaska
Department of Fish and Game
Revision Date 10/31/2008

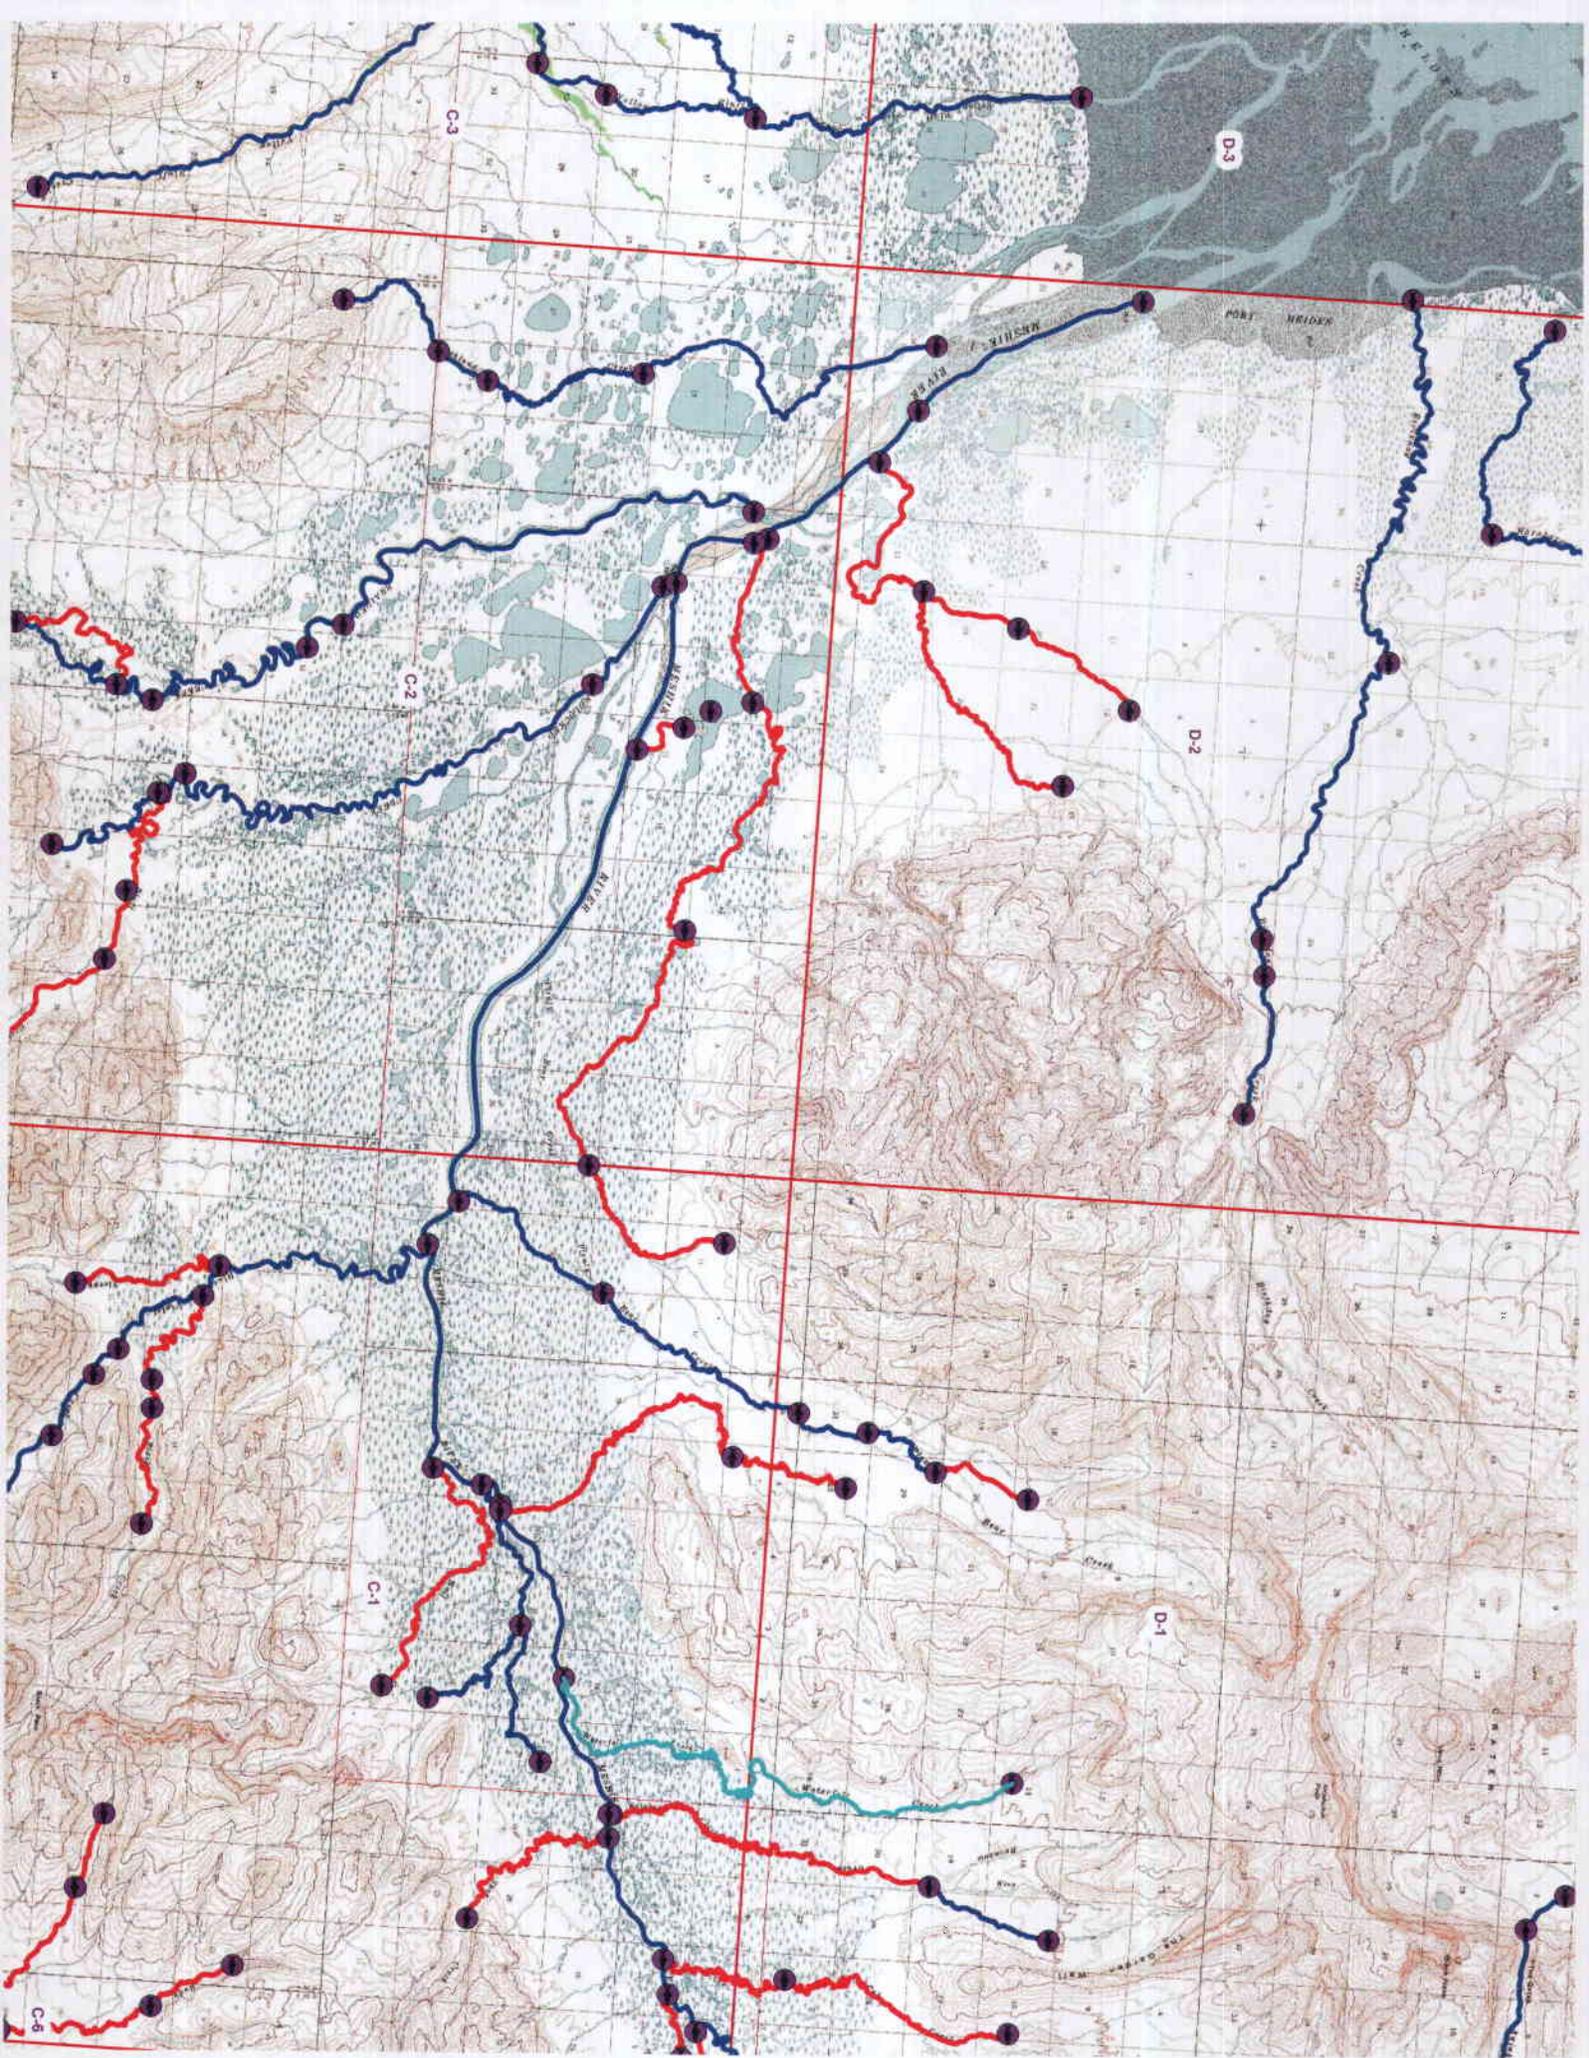

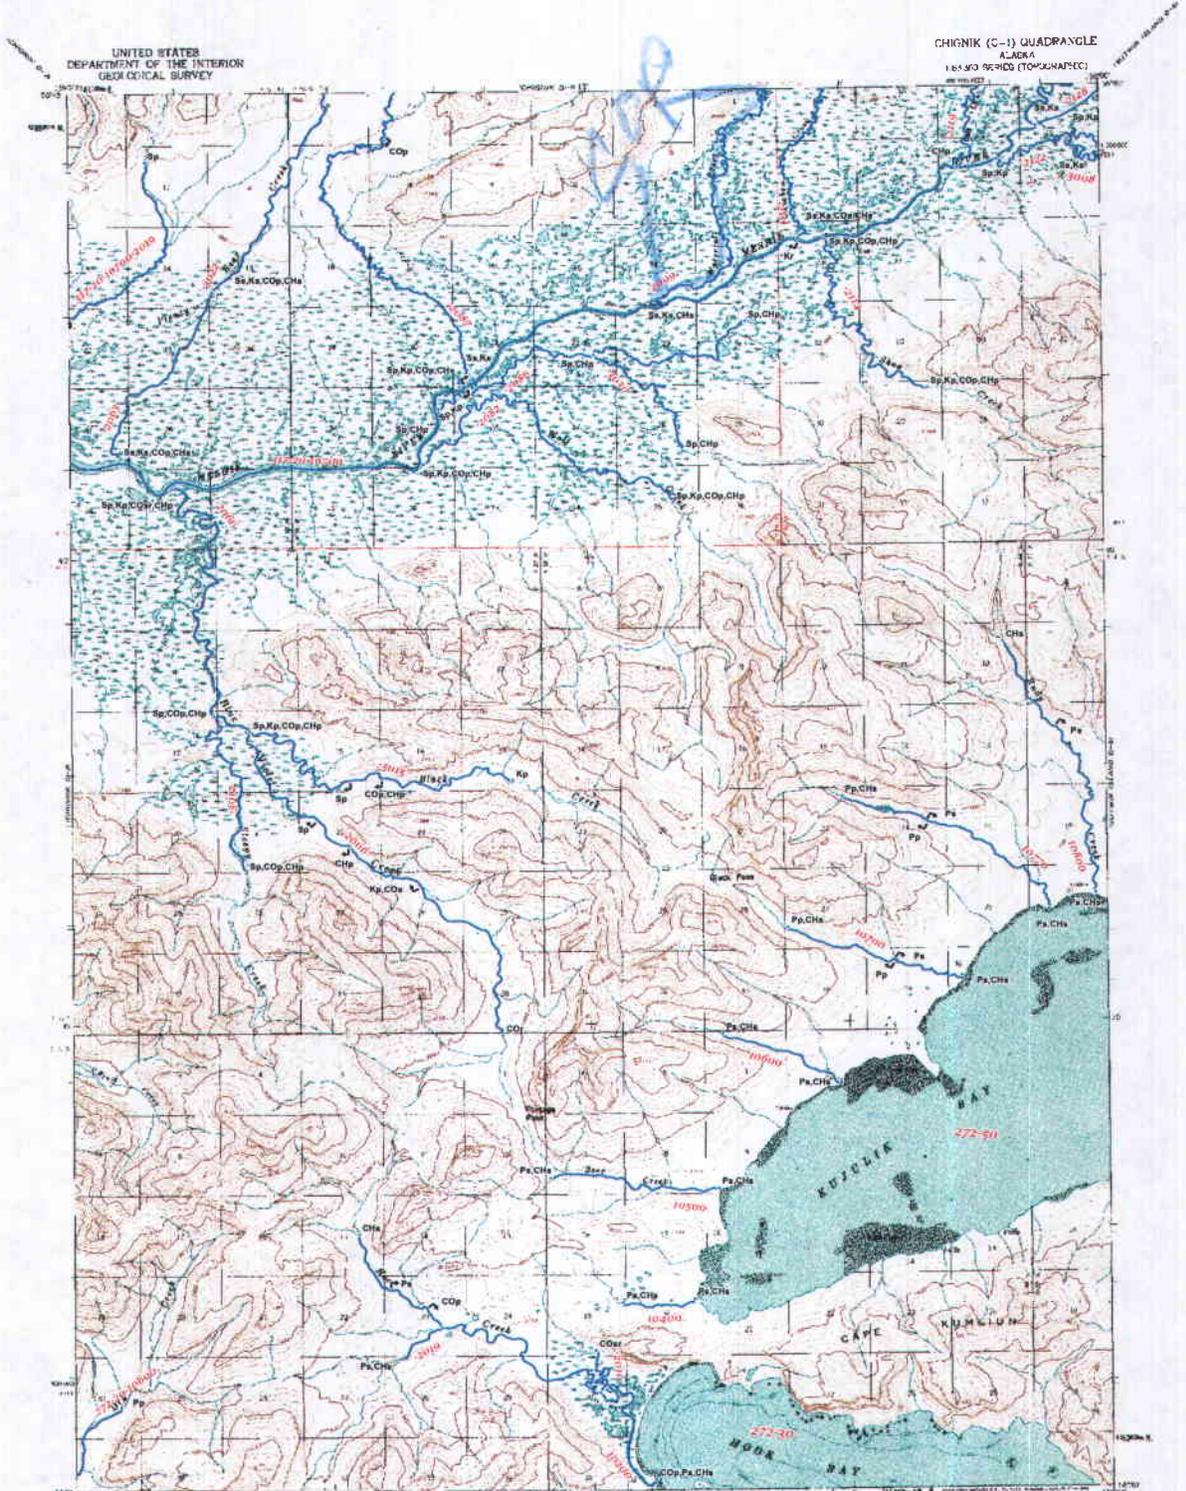

Key to Robert Murphy's Maps

- P = Purple** **CO = Blue**
- CH = Green** **S = Red** **K = Yellow**
- DV = Orange**
- SH = Brown**

SCALE 1:63,400
 LONGITUDE 151° 00' WEST
 LATITUDE 61° 00' NORTH
 PINK SALE BY U. S. GEOLOGICAL SURVEY
 FAIRBANKS, ALASKA 99701, DENVER, COLORADO 80226 OR WASHINGTON, D. C. 20548
 A FOLDER DESCRIBING TOPOGRAPHIC MAPS AND SYMBOLS IS AVAILABLE ON REQUEST

CHIGNIK (C-1) ALASKA
 964100 9/1950/1960
 1961

• Lower/Upper Point of Stream
 † Midstream Species Begin/End Point
 ★ Short Stream (Under 550 feet)
 ■ Lake
 ▲ Barrier
 Anadromous Streams
 Anadromous Areas
 AWC Stat Area
 Regional Boundary
 Waters Important to Anadromous Fish are listed pursuant to AS 41.14.870. Specified species distribution and life functions reflect known data. Actual distribution and use may extend beyond specified limits. Migration upstream and/or downstream is assumed for specified stream reaches.


SPECIES CODES		LIFE STAGE CODES	
CO	coho salmon	p	Present
CH	chum salmon	m	Migration
K	king salmon	r	Rearing
P	pink salmon	s	Known
S	sockeye salmon	sp	Spawning
CT	cutthroat trout		
DV	dobsonfly		
GF	grayling		
SI	silverside		
ST	steelhead		
SH	sheephead		
W	whitefish		
AC	arctic char		



Fish Distribution Database Atlas

Chignik C - 1

Revision Date 04/2003

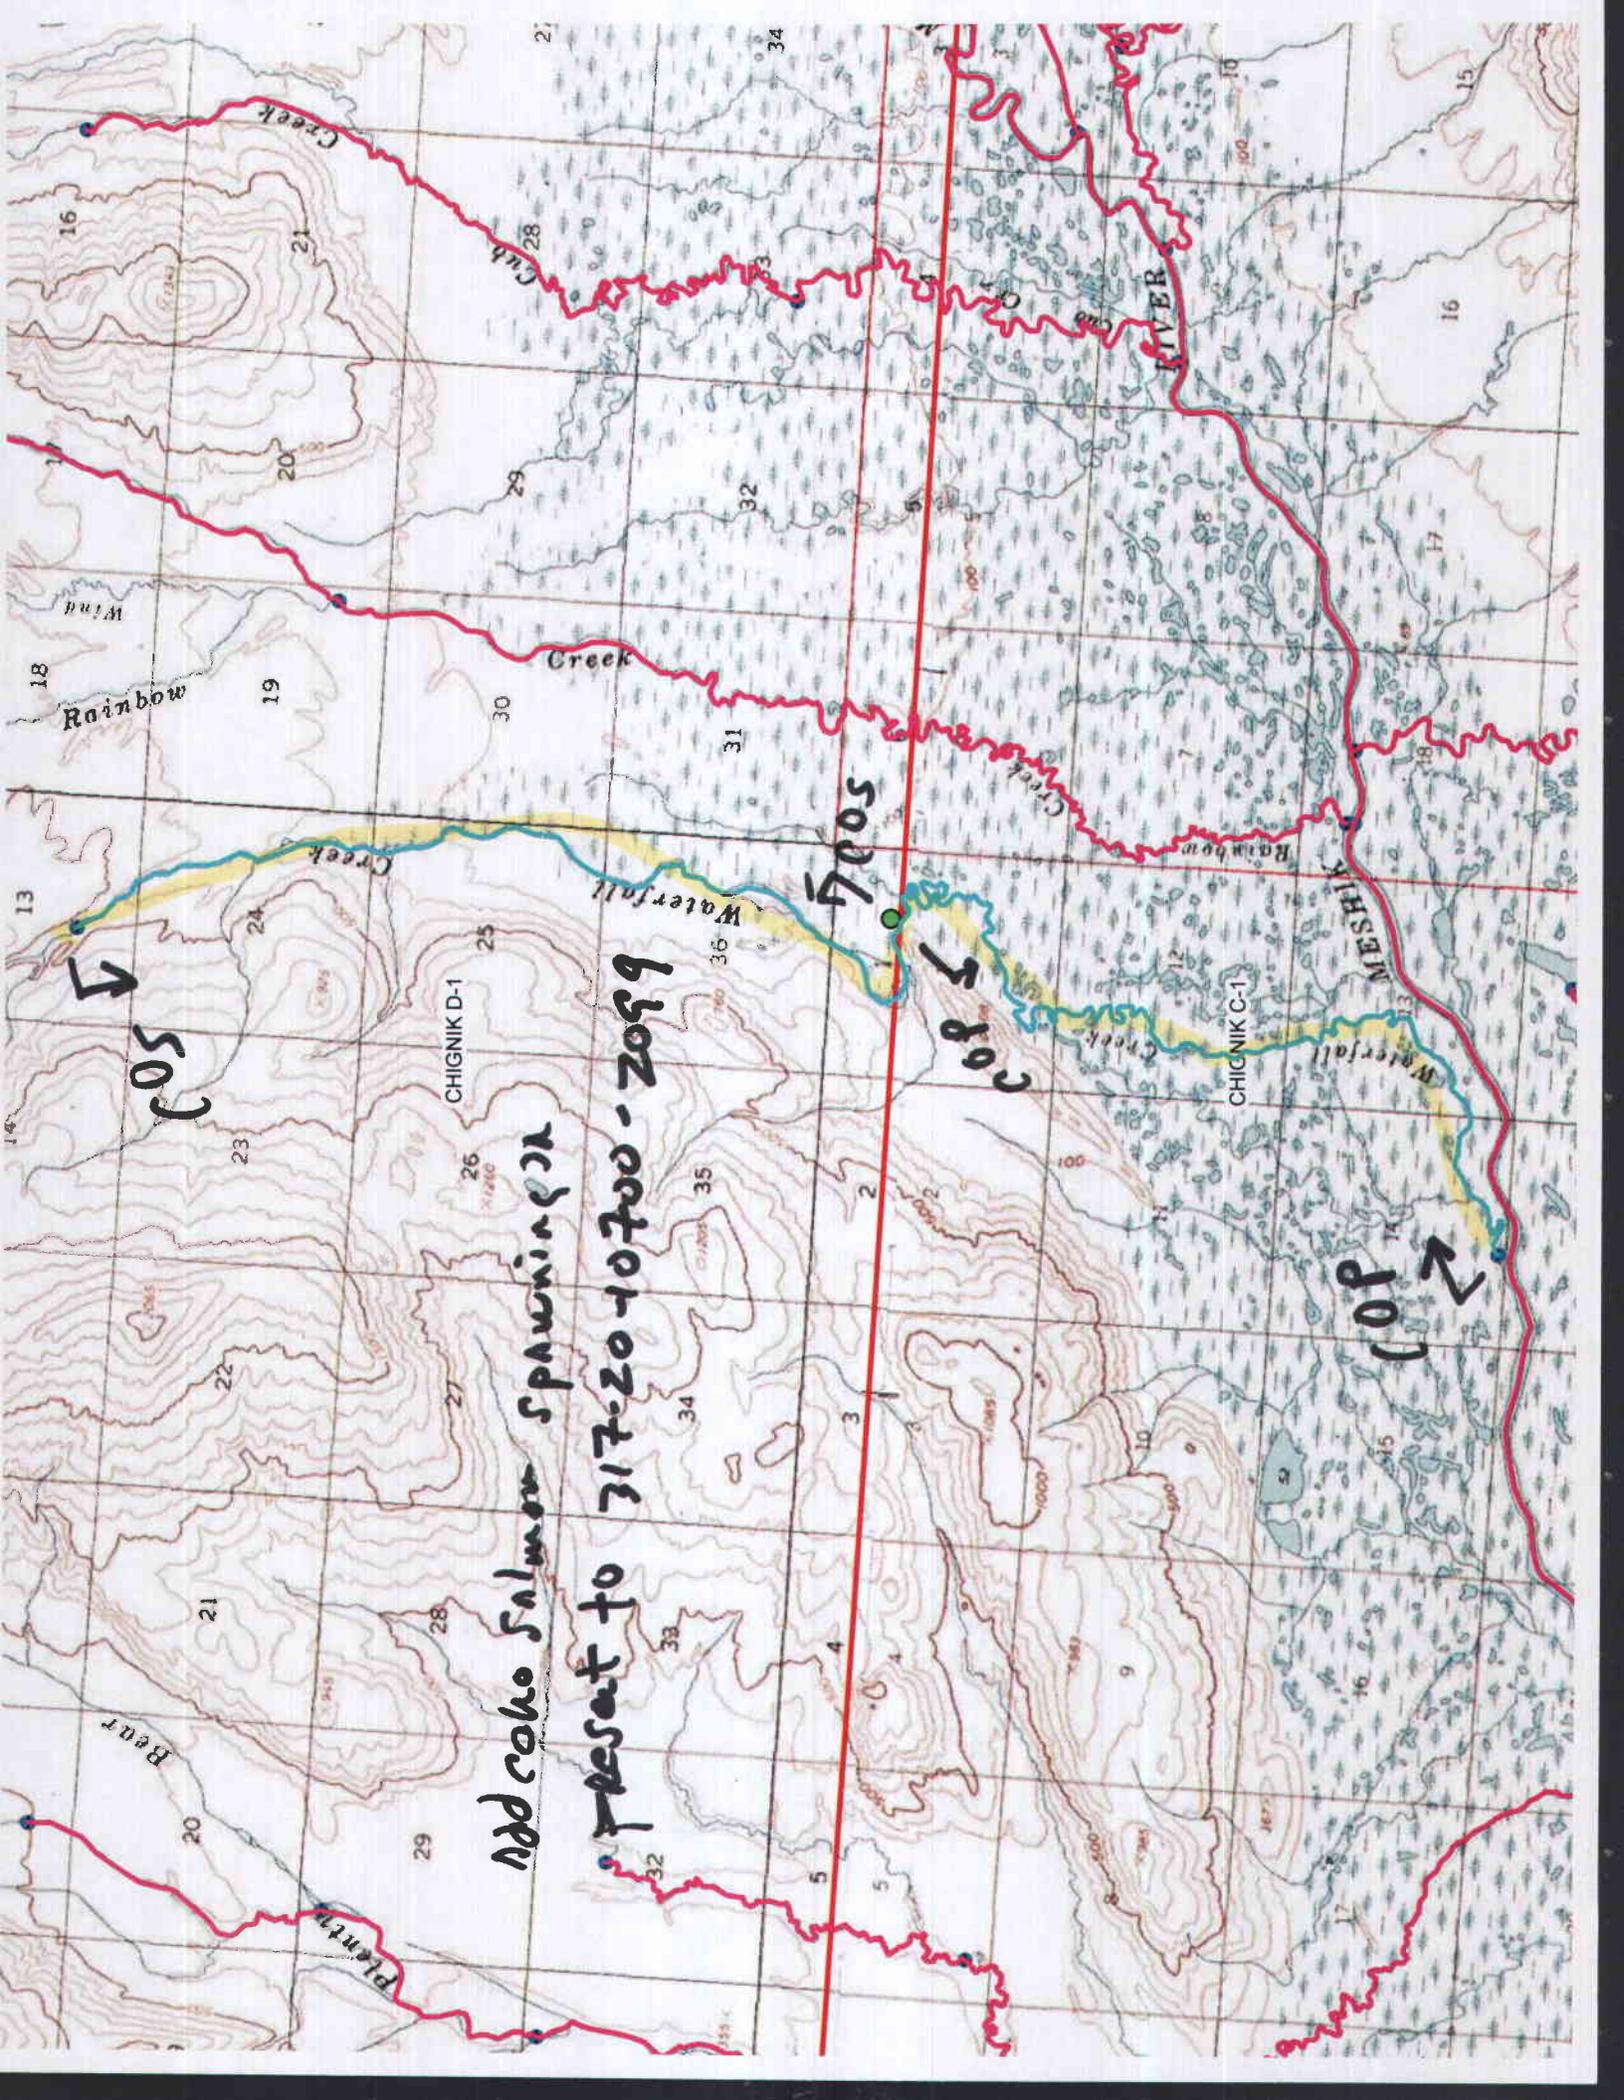

Add coho salmon spawning

Present to 317-20-10700-2099

7005

COP ↓

COP ↓

COP ↗

