



State of Alaska
Department of Fish and Game
Division of Sport Fish

Nomination Form
Anadromous Waters Catalog

x303

Region III, Southwestern USGS Quad(s) Port Moller C-6
Anadromous Waters Catalog Number of Waterway 313-30-10140-2016

Name of Waterway David's River USGS Name Local Name
 Addition Deletion Correction Backup Information

For Office Use

Nomination # <u>C9-102</u>	_____	_____
Revision Year: <u>2010</u>	Fisheries Scientist	Date
Revision to: Atlas _____ Catalog _____	Habitat Operations Manager	Date
Both _____	<u>9/1</u>	<u>02/09/09</u>
Revision Code: <u>F-1</u>	AWC Project Biologist	Date
	_____	_____
	Cartographer	Date

OBSERVATION INFORMATION

Species	Date(s) Observed	Spawning	Rearing	Present	Anadromous
chum salmon	published in AMR, year in ()			yes	<input checked="" type="checkbox"/>
					<input type="checkbox"/>
					<input type="checkbox"/>
					<input type="checkbox"/>
					<input type="checkbox"/>

IMPORTANT: Provide all supporting documentation that this water body is important for the spawning, rearing or migration of anadromous fish, including: number of fish and life stages observed; sampling methods, sampling duration and area sampled; copies of field notes; etc. **Attach a copy of a map showing location of mouth and observed upper extent of each species,** as well as other information such as: specific stream reaches observed as spawning or rearing habitat; locations, types, and heights of any barriers; etc.

313-30.01 David's River. Aerial surveys have been conducted on this system since the **1960s** and observers have noted the presence of **sockeye, coho, chum and chinook salmon**, which has been published in our ADF&G Annual Salmon Management Reports (AMR).


Please add chum (1960,1963,1964,1965,1966,1970,1976) salmon.

supported by nom # C9-147, 09-146, 09-115

Name of Observer (please print): on file; name and date is published in AMR
Signature: _____ Date: _____
Agency: Alaska Department of Fish & Game
Address: 211 Mission Road
Kodiak, Alaska 99615

This certifies that in my best professional judgment and belief the above information is evidence that this waterbody should be included in or deleted from the Anadromous Waters Catalog.

Signature of Area Biologist: Robert Murphy Date: 11/14/08 Revision 02/08
Name of Area Biologist (please print): Robert Murphy, FBIII

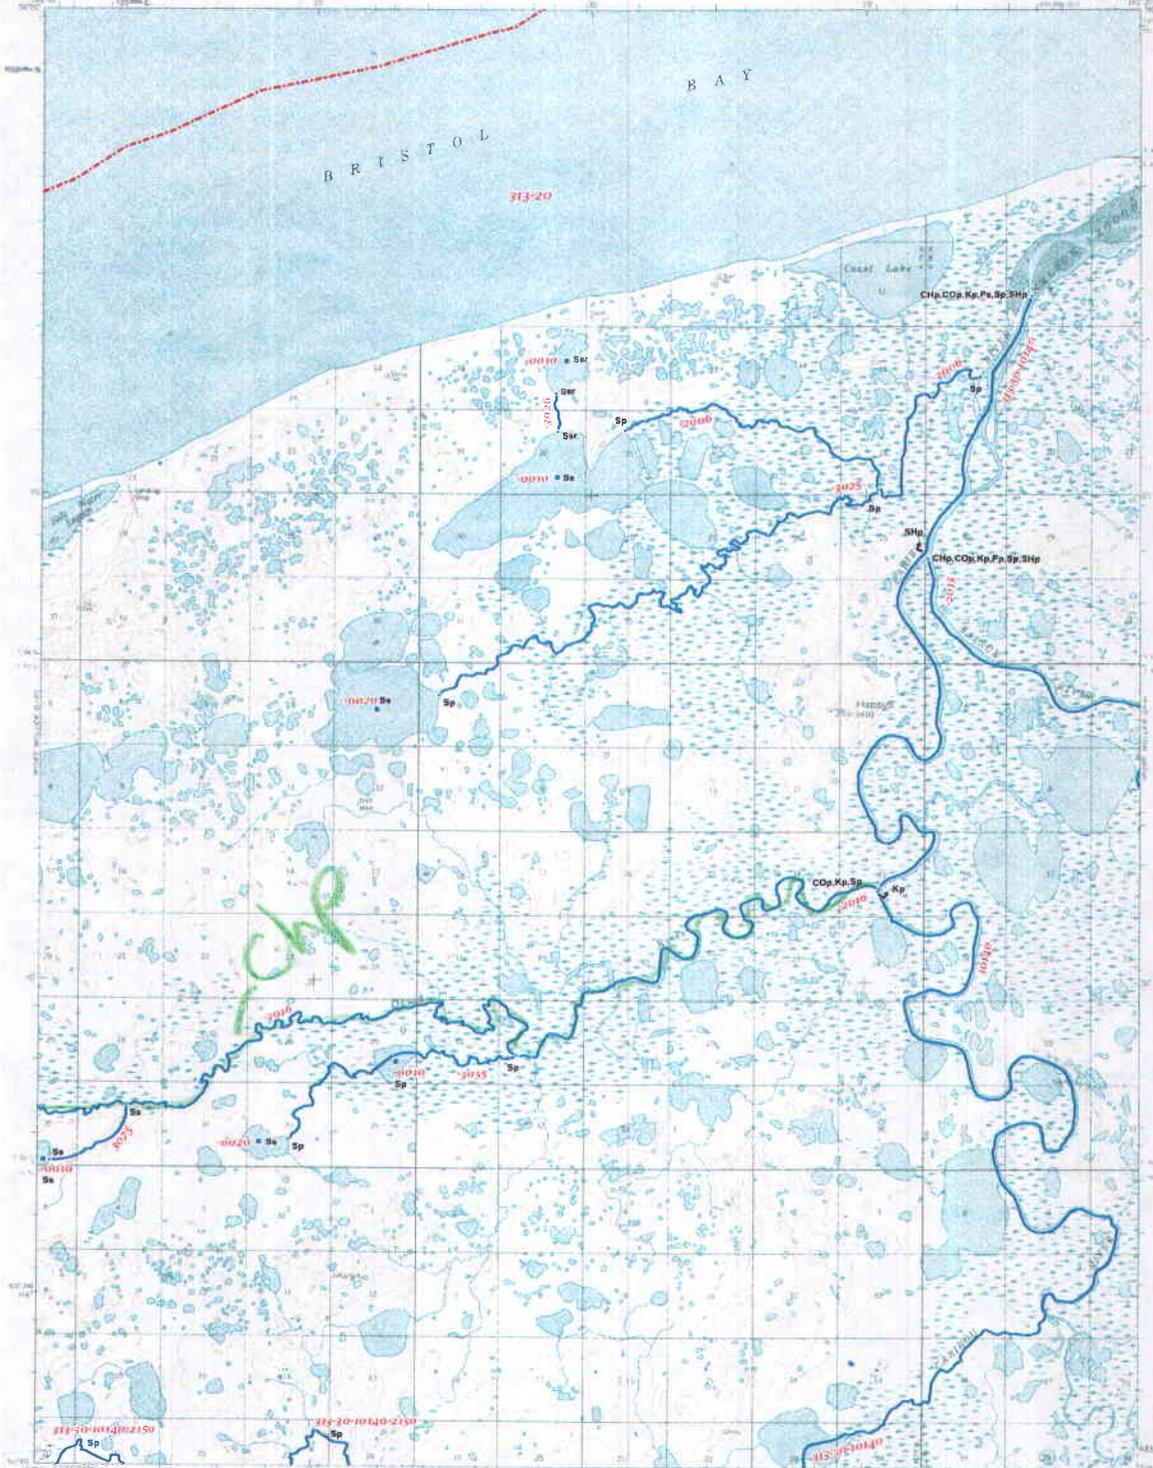

Map(s) edited and updated by the Geological Survey
Scale 1:50,000 and 1:25,000
Topographic map(s) prepared by the Geological Survey

CONTOUR INTERVAL 50 FEET
NATIONAL GEODESIC SYSTEM, DATUM OF 1983
SOUNDING IN FEET OVER 10 METERS (32.8 FEET) LOW WATER
SHORELINE SHOWN REPRESENTS THE APPROXIMATE LINE OF 6504 FEET BATHY
THE HIGH RANGE OF TIDE IS APPROXIMATELY 4 FEET

FOR SALE BY U.S. GEOLOGICAL SURVEY
ANIBANK, ALASKA 99501, DENVER, COLORADO 80202, OR RESTON, VIRGINIA 22082
A FOLDER CONTAINING TOPOGRAPHIC MAPS AND SYMBOLS IS AVAILABLE ON REQUEST

PORT MOLLER (D-5) ALASKA
1:50,000 SERIES
1981
MINOR REVISION 1984

Key to Robert Murphy's Maps
P = Purple **CO = Blue**
CH = Green **S = Red** **K = Yellow**
DV = Orange
SH = Brown

- Lower/Upper Point of Stream
- ⊔ Midstream Species Begin/End Point
- ★ Short Stream (Under 660 feet)
- Lake
- ▲ Barrier
- Anadromous Streams
- ▨ Anadromous Areas
- AWC Stat Area
- Regional Boundary

SPECIES CODES	
CO	coho salmon
CH	chum salmon
K	Chinook salmon (king)
P	pink salmon
S	sockeye salmon
LIFESTAGE CODES	
p	Present
m	Migration
r	Rearing
s	Known Spawning
AC	Arctic char
AL	Arctic lamprey
AW	Arctic cisco
BC	Broad whitefish
BW	Berry osco
CI	cutthroat trout
DV	Dolly Varden
HW	humpback whitefish
LC	least cisco
LP	lamprey, undifferentiated
LV	river lamprey
OL	longfin smelt
OM	rainbow smelt
OU	ouletion
PC	Pacific lamprey
SF	Inconnu (sheefish)
SH	sheephead trout
SM	smelt, undifferentiated
ST	sturgeon, undifferentiated
W	whitefish, undifferentiated



Fish Distribution Database Atlas
 Quad No. 032

Port Moller
D- 5

08-102

Produced by
 State of Alaska
 Department of
 Fish and Game

Waters Important to Anadromous Fish are listed pursuant to AS 41.14.870. Specified species distribution and life functions reflect known data. Actual distribution and use may extend beyond specified limits. Migration upstream and/or downstream is assumed for specified stream reaches.




Key to Robert Murphy's Maps

- P = Purple** **CO = Blue**
- CH = Green** **S = Red** **K = Yellow**
- DV = Orange**
- SH = Brown**

FOR SALE BY U. S. GEOLOGICAL SURVEY
U.S. ALASKA MAPS, DENVER, COLORADO 80202, OR RESTON, VIRGINIA 20192
LIST DESCRIBING TOPOGRAPHIC MAPS AND SYMBOLS IS AVAILABLE ON REQUEST

PORT MOLLER (D-6), ALASKA
18545-11815-010000
1963

<p>Lower/Upper Point of Stream</p> <p>Midstream Species Begin/End Point</p> <p>Short Stream (Under 660 feet)</p> <p>Lake</p> <p>Barrier</p>	<p>Anadromous Streams</p> <p>Anadromous Areas</p> <p>AWC Stat Area</p> <p>Regional Boundary</p>	<p>SPECIES CODES</p> <p>CO coho salmon</p> <p>CH chin salmon</p> <p>K king salmon</p> <p>P pink salmon</p> <p>S sockeye salmon</p> <p>AC Arctic char</p> <p>CT cutthroat trout</p> <p>DV Dolly varden</p> <p>SH sheepshead</p> <p>SF Inconnu (sheefish)</p> <p>W whitefishes</p> <p>OU outouchon</p> <p>SM smelt</p>	<p>ST sturgeon</p> <p>AL Arctic lamprey</p> <p>LP lamprey (unidentified)</p> <p>PC Pacific lamprey</p> <p>LV lar lamprey</p>	<p>LIFE STAGE CODES</p> <p>p Present</p> <p>m Migration</p> <p>R Rearing</p> <p>↑ Known</p> <p>Spawning</p>	<p>Fish Distribution Database Atlas</p> <p>Quad No. 032</p> <p>Port Moller</p> <p>D-6</p> <p>Produced By State of Alaska Department of Fish and Game</p> <p>Revision Date 12/06/2000</p>
---	---	---	--	--	---

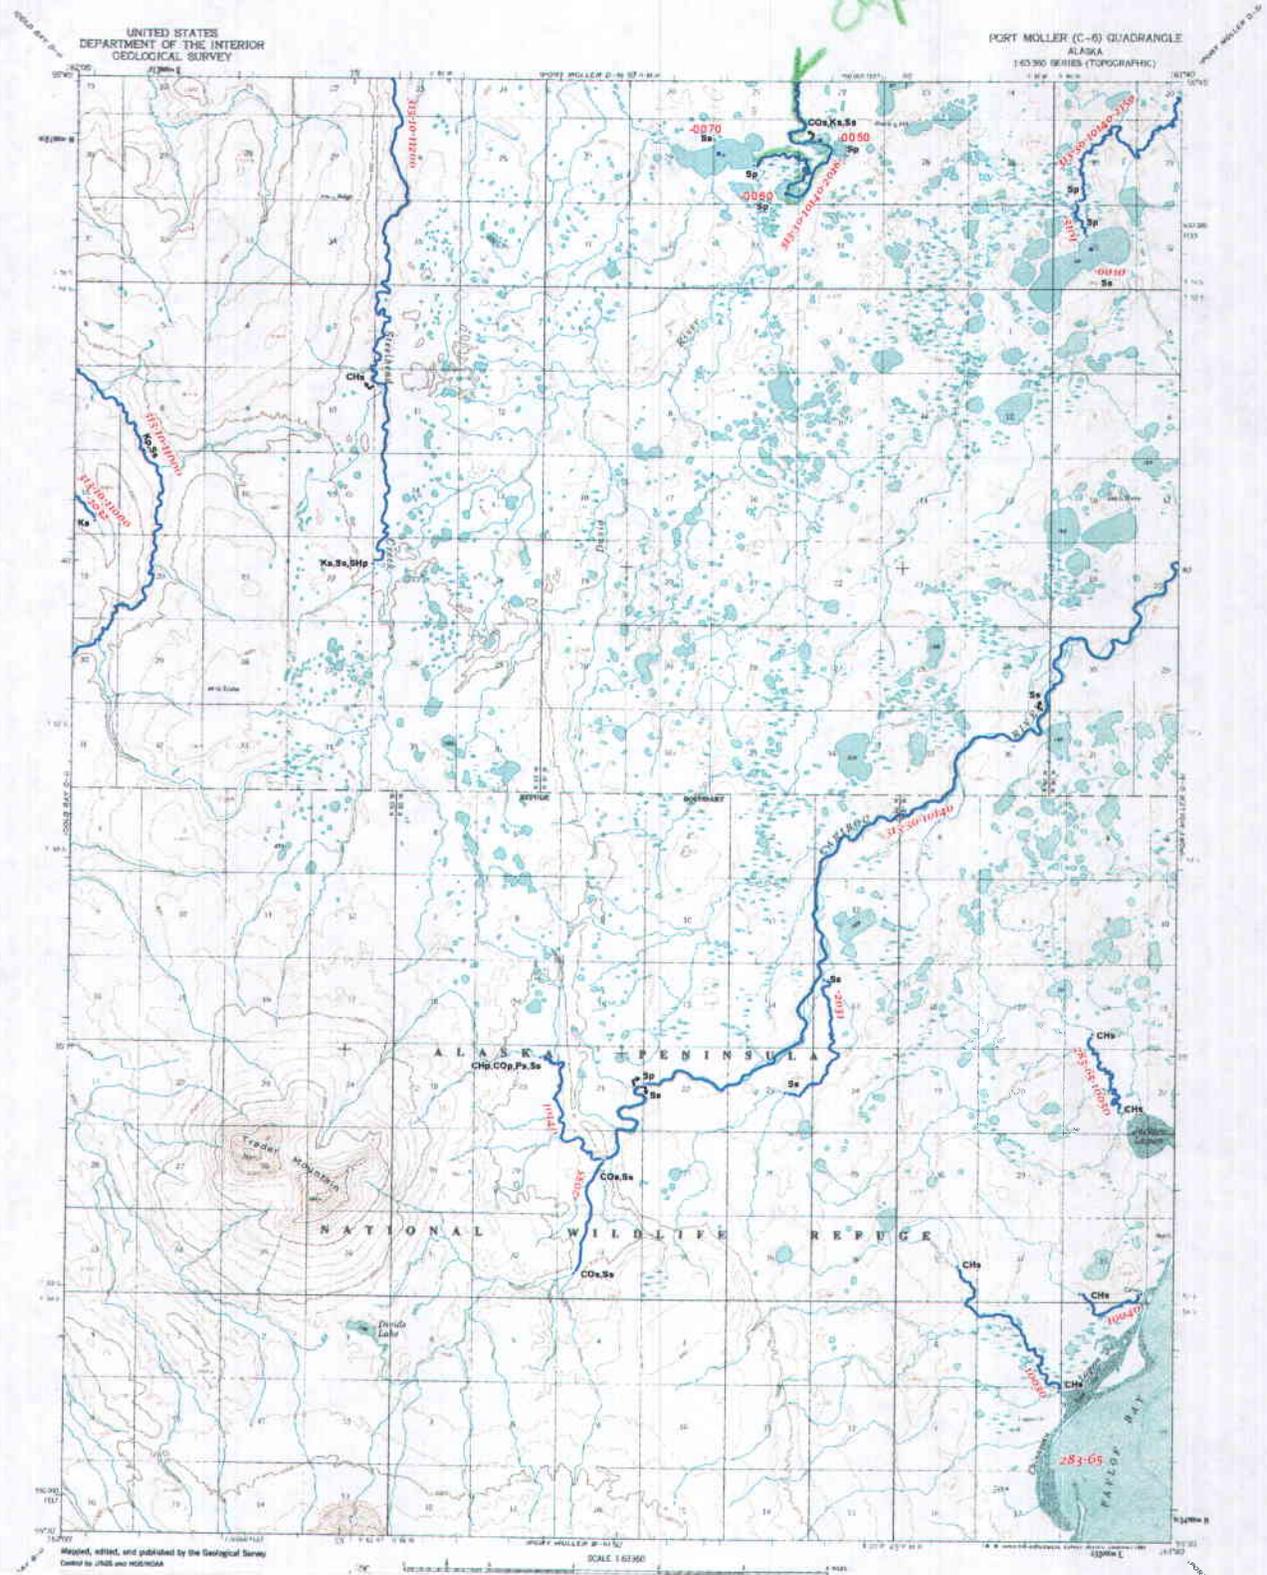

Key to Robert Murphy's Maps

- P = Purple** **CO = Blue**
- CH = Green** **S = Red** **K = Yellow**
- DV = Orange**
- SH = Brown**

- Lower/Upper Point of Stream
- ⊥ Midstream Species Begin/End Point
- ★ Short Stream (Under 600 feet)
- ▲ Lake
- ▲ Barrier

- Anadromous Streams
- Anadromous Areas
- AWC Stat Area
- Regional Boundary

SPECIES CODES	
CO	coho salmon
CH	chum salmon
K	king salmon (lingcod)
P	pink salmon
S	sockeye salmon
AC	Arctic char
CT	cutthroat trout
DV	Dolly varden
SH	sheefish
SP	Sierran (sheefish)
W	whitefishes
CA	cutthroat
CM	rainbow smelt
SM	smelt
ST	sturgeon
AL	Arctic lamprey
LP	lamprey (undetermined)
PC	Pacific lamprey
LV	river lamprey

LIFE STAGE CODES	
p	Present
m	Migration
r	Residing
s	Known Spawning



Produced By
State of Alaska
Department of Fish and Game

Fish Distribution Database Atlas
 Quad No. 032
Port Moller
C-6

FOR SALE BY U. S. GEOLOGICAL SURVEY
 WMS, ALASKA 99701, DENVER, COLORADO 80201, DR. RESTON, VIRGINIA 22092
 ALSO DESCRIBING TOPOGRAPHIC MAPS AND SYMBOLS AVAILABLE ON REQUEST

PORT MOLLER (C-6), ALASKA
 55161-66-17-063
 1983
 WIDTH REVISION 1984

ROAD CLASSIFICATION
 See map or table in this area

SCALE 1:62,500
 COLOUR INTERVAL 100 FEET
 HATCHED LINES REPRESENT 100 FEET CONTOURS
 DOTTED LINES REPRESENT 200 FEET CONTOURS
 DOTTED LINES REPRESENT 400 FEET CONTOURS
 DOTTED LINES REPRESENT 800 FEET CONTOURS
 DOTTED LINES REPRESENT 1600 FEET CONTOURS
 DOTTED LINES REPRESENT 3200 FEET CONTOURS
 DOTTED LINES REPRESENT 6400 FEET CONTOURS
 DOTTED LINES REPRESENT 12800 FEET CONTOURS

Revision Date 12/8/00

ADF&G, Aerial Survey Map

This map is to be used as a reference tool. Please see Robert Murphy's USGS maps for species codes.

