



State of Alaska
Department of Fish and Game
Division of Sport Fish

Nomination Form
Anadromous Waters Catalog

1B

Region III, Southwestern USGS Quad(s) Port Moller C-3
Anadromous Waters Catalog Number of Waterway 314-20-10410

Name of Waterway Deer Valley USGS Name Local Name
 Addition Deletion Correction Backup Information

For Office Use

Nomination # <u>09-104</u>	<u>[Signature]</u> Fisheries Scientist	<u>5/26/09</u> Date
Revision Year: <u>2010</u>	<u>[Signature]</u> Habitat Operations Manager	<u>5/26/09</u> Date
Revision to: Atlas _____ Catalog _____ Both <u>X</u>	<u>[Signature]</u> AWC Project Biologist	<u>02/07/09</u> Date
Revision Code: <u>B1</u>	<u>[Signature]</u> Cartographer	<u>7/10/9</u> Date

OBSERVATION INFORMATION

Species	Date(s) Observed	Spawning	Rearing	Present	Anadromous
pink salmon	see below ()			yes	<input checked="" type="checkbox"/>
					<input type="checkbox"/>
					<input type="checkbox"/>
					<input type="checkbox"/>
					<input type="checkbox"/>

IMPORTANT: Provide all supporting documentation that this water body is important for the spawning, rearing or migration of anadromous fish, including: number of fish and life stages observed, sampling methods, sampling duration and area sampled; copies of field notes, etc. Attach a copy of a map showing location of mouth and observed upper extent of each species, as well as other information such as: specific stream reaches observed as spawning or rearing habitat; locations, types, and heights of any barriers, etc.


314-20.04 Deer Valley. Aerial surveys have been conducted on this system since the **1960s** and observers have noted the presence of **pink, sockeye, coho and chum salmon**, which has been published in our ADF&G Annual Salmon Management Reports (AMR).

Please add pink (1984,1992,1997,1999,2000,2004,2005,2006,2008) salmon; see attached map.

Add pink salmon present to 314-20-10410

Name of Observer (please print): on file; published in AMR
Signature: _____ Date: _____
Agency: Alaska Department of Fish & Game
Address: 211 Mission Road
Kodiak, Alaska 99615

This certifies that in my best professional judgment and belief the above information is evidence that this waterbody should be included in or deleted from the Anadromous Waters Catalog.
Signature of Area Biologist: Robert Murphy Date: 11/04/08 Revision 02/08
Name of Area Biologist (please print): Robert Murphy, FBIII

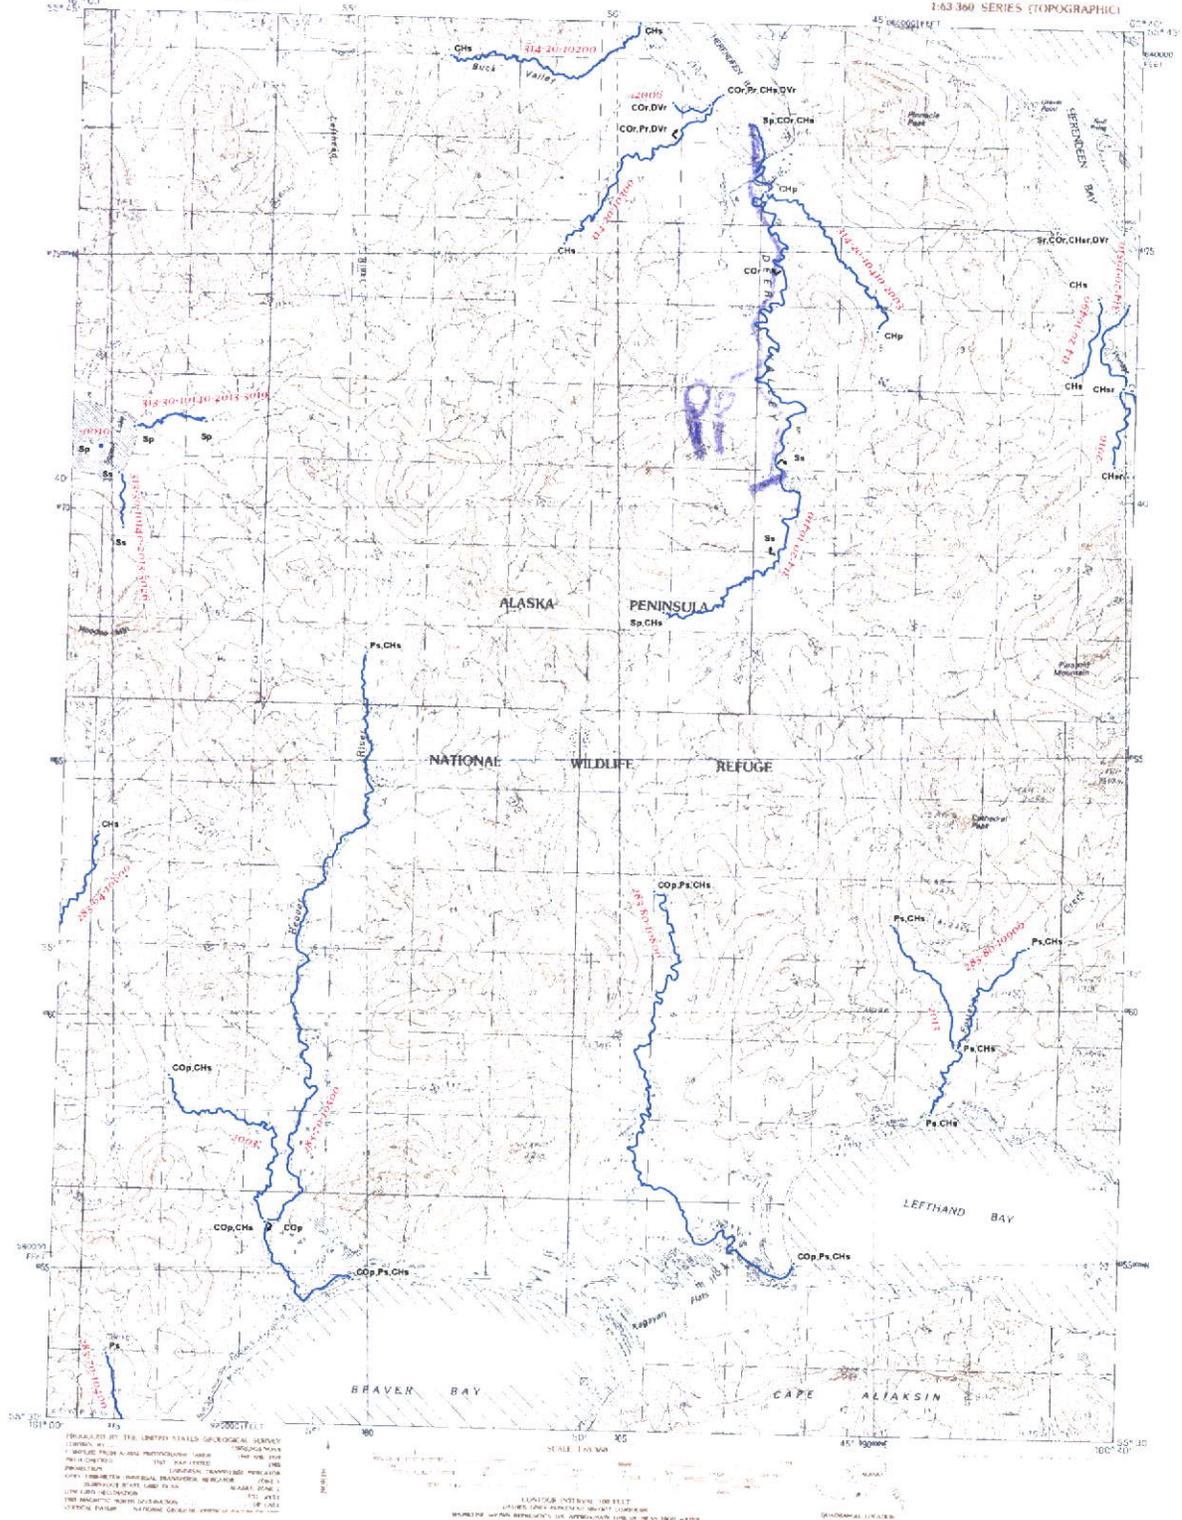

Key to Robert Murphy's Maps
P = Purple **CO = Blue**
CH = Green **S = Red** **K = Yellow**
DV = Orange
SH = Brown



PRODUCTION BY THE UNITED STATES GEOLOGICAL SURVEY
 GEOPHYSICAL RESEARCH DIVISION
 WASHINGTON, D.C. 20508
 SCALE 1:63 360
 UNITED STATES GEOLOGICAL SURVEY, WASHINGTON, D.C. 20508
 PORT MOLLER (C-3) QUADRANGLE, ALASKA
 1:63 360 SERIES (TOPOGRAPHIC)



PORT MOLLER (C-3), ALASKA
 PROFESSIONAL EDITION, 1982


Lower/Upper Point of Stream
 t Midstream Species Begin/End Point
 ★ Short Stream (Under 860 feet)
 ■ Lake
 ▲ Barrier


Waters Important to Anadromous Fish are listed pursuant to AS 41 14 870. Specified species distribution and life functions reflect known data. Actual distribution and use may extend beyond specified limits. Migration upstream and/or downstream is assumed for specified stream reaches.

SPECIES CODES		LIFE STAGE CODES	
CO	coho salmon	ST	sturgeon
CH	chinook salmon	AL	Arctic lamprey
K	king salmon	LP	lamprey (undifferentiated)
P	pink salmon	PC	Pacific lamprey
S	sockeye salmon	LV	river lamprey
AC	Arctic char		
CT	cutthroat trout	p	Present
DV	Dolly varden	m	Migration
SH	steelhead	r	Rearing
SF	steelhead (sheefish)	K	Known
W	whitefishes	s	Spawning
CU	cutthroat		
SM	smelt		



Fish Distribution Database Atlas
 Quad No. 32
Port Moller
C - 3
 Produced By
 State of Alaska
 Department of Fish and Game
 Revision Date 4/1/2005

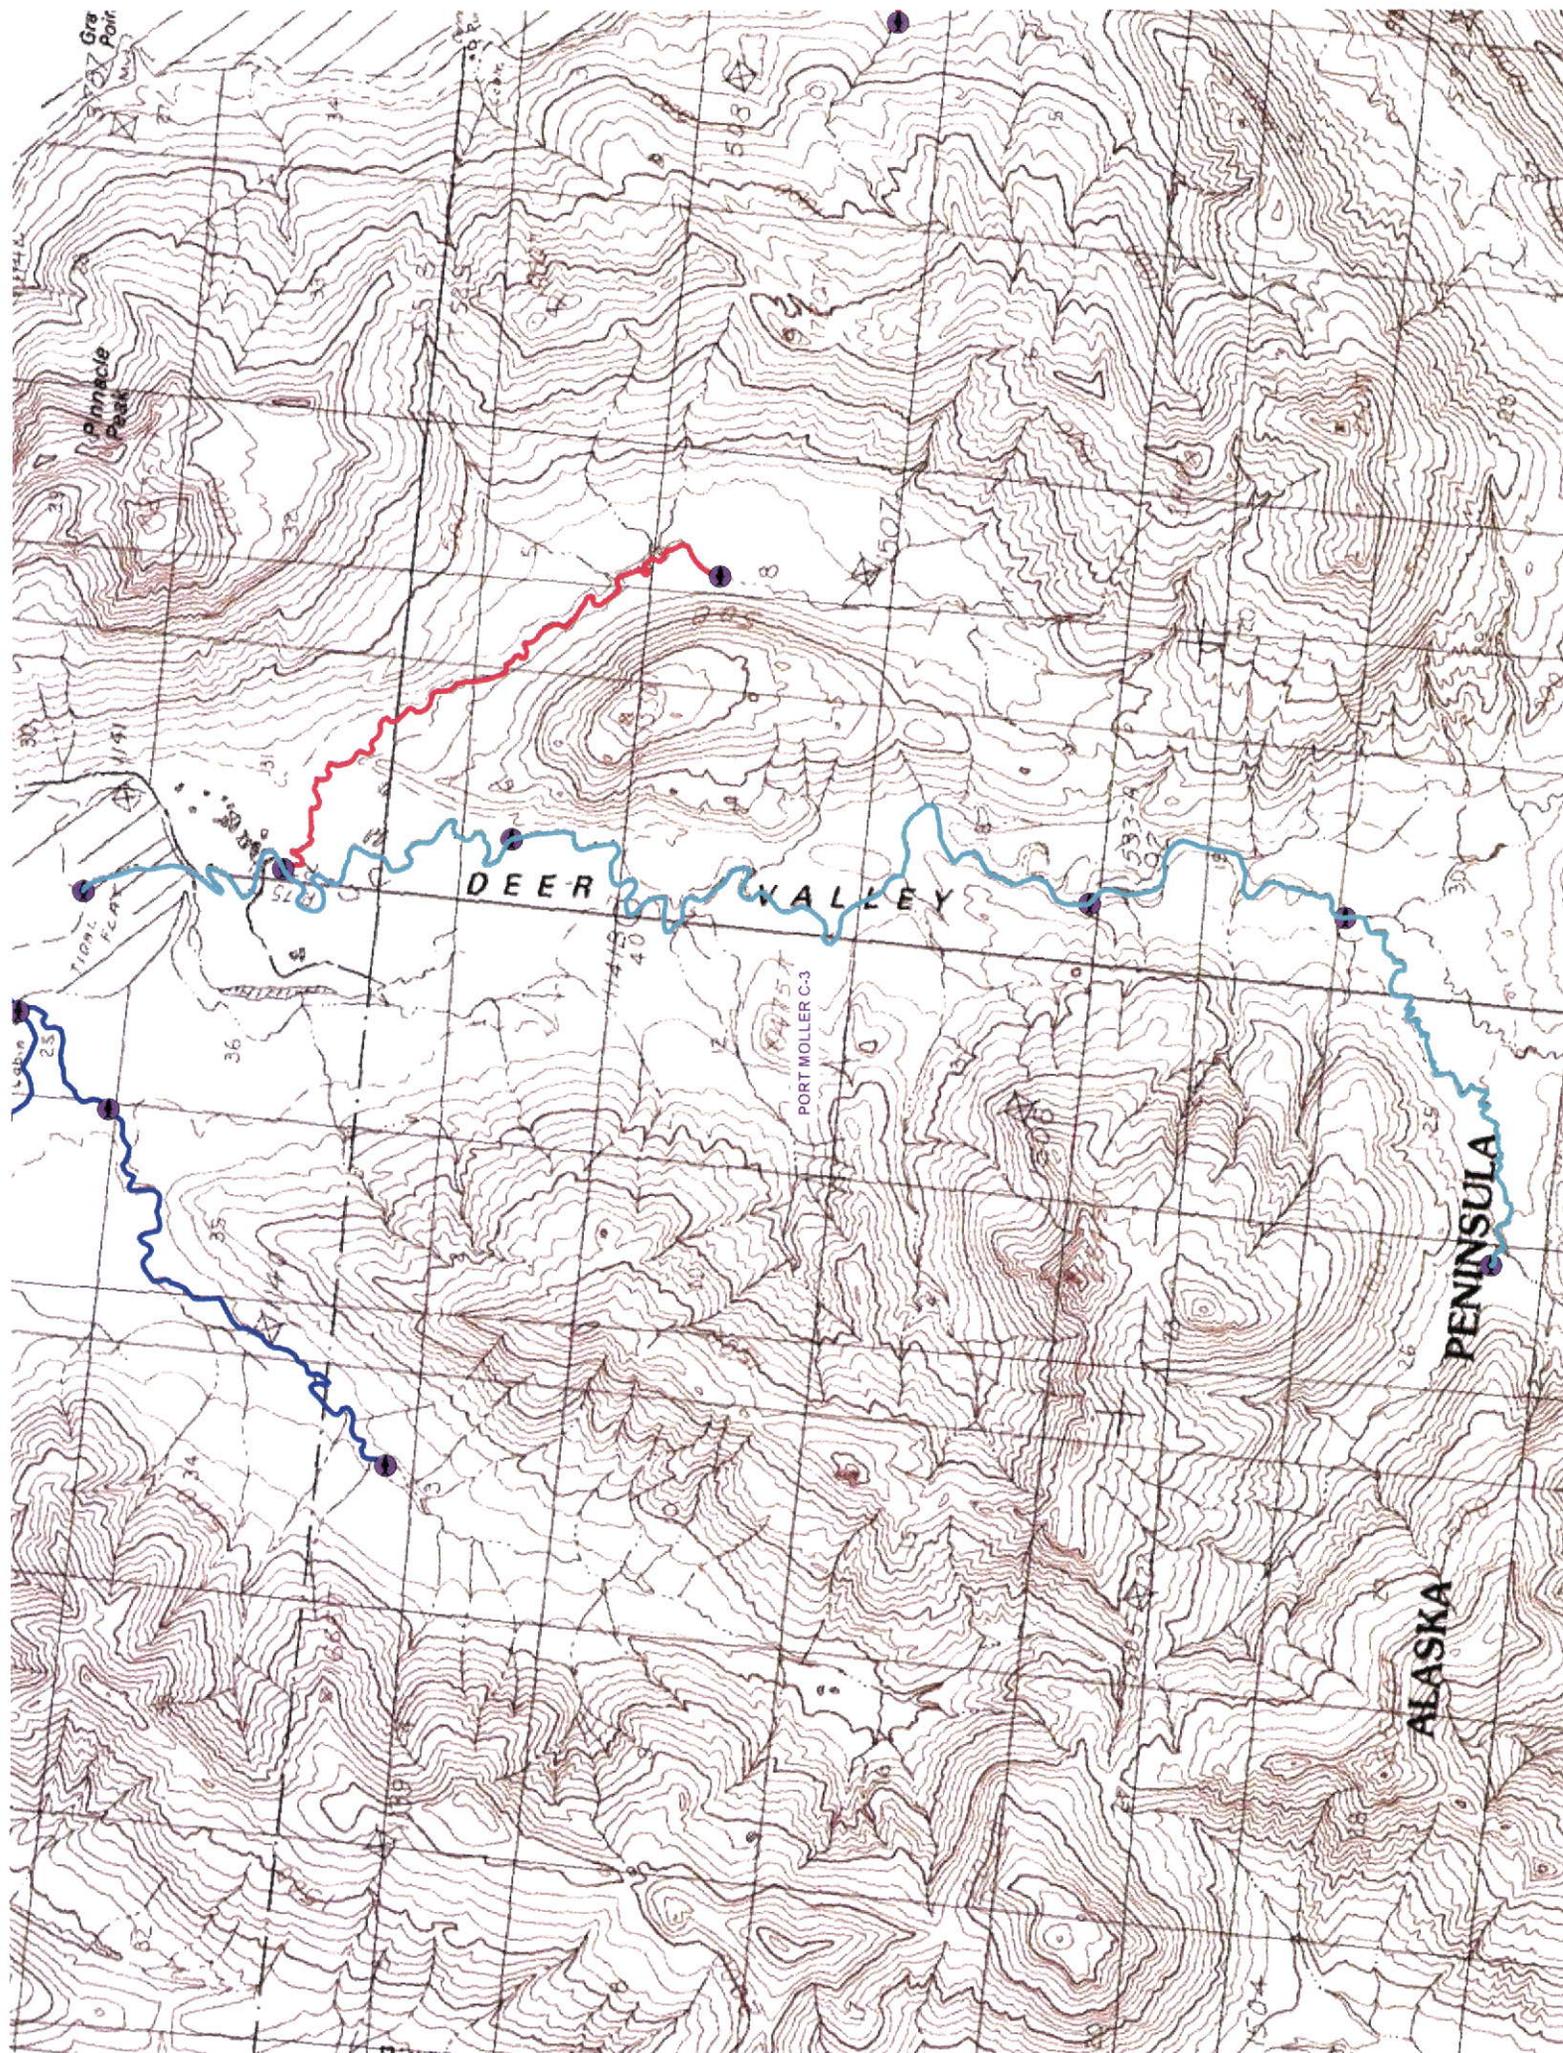

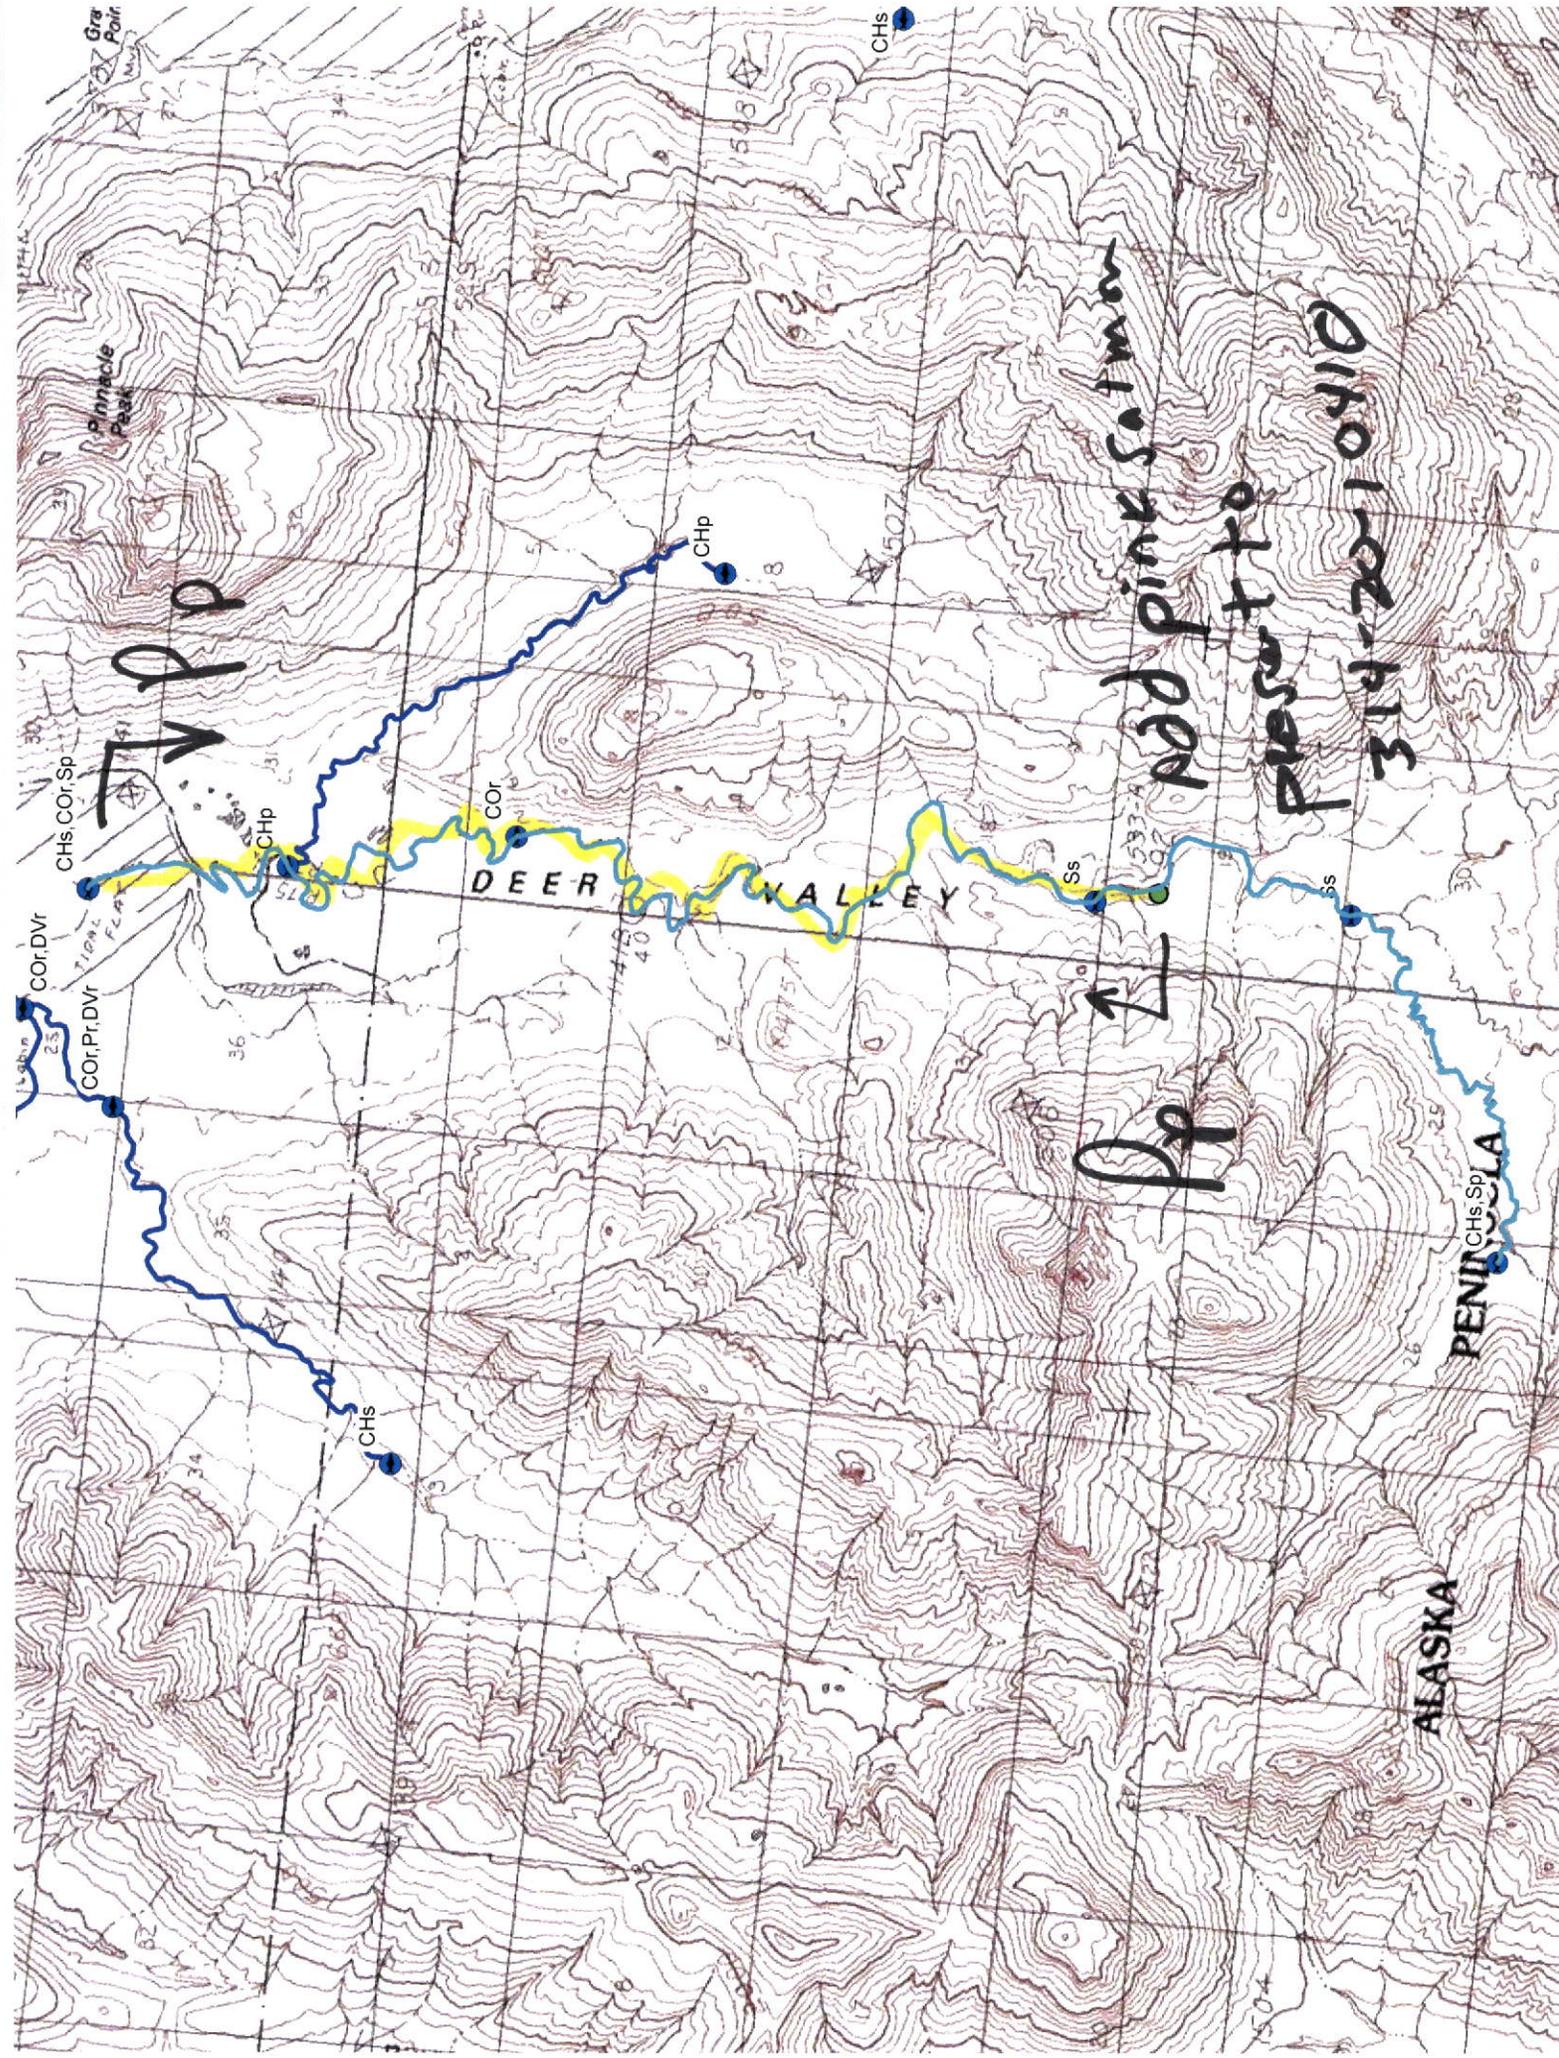

PP

PP

Add pink salmon
Present to
314-2010410

DEER VALLEY

ALASKA

PENINSULA

