



State of Alaska
Department of Fish and Game
Division of Sport Fish

Nomination Form
Anadromous Waters Catalog

dB

Region III, Southwestern USGS Quad(s) Port Moller C-2,3
Anadromous Waters Catalog Number of Waterway 314-20-10510

Name of Waterway Portage Creek USGS Name Local Name
 Addition Deletion Correction Backup Information

For Office Use

Nomination # <u>CG-105</u>	<u>[Signature]</u> Fisheries Scientist	<u>5/26/09</u> Date
Revision Year: <u>2010</u>	<u>[Signature]</u> Habitat Operations Manager	<u>5/26/09</u> Date
Revision to: Atlas _____ Catalog _____ Both <u>X</u>	<u>[Signature]</u> AWC Project Biologist	<u>01/20/09</u> Date
Revision Code: <u>B-1</u>	<u>[Signature]</u> Cartographer	<u>7/9/9</u> Date

OBSERVATION INFORMATION

Species	Date(s) Observed	Spawning	Rearing	Present	Anadromous
pink salmon	see below ()			yes	<input checked="" type="checkbox"/>
					<input type="checkbox"/>
					<input type="checkbox"/>
					<input type="checkbox"/>
					<input type="checkbox"/>

IMPORTANT: Provide all supporting documentation that this water body is important for the spawning, rearing or migration of anadromous fish, including number of fish and life stages observed; sampling methods, sampling duration and area sampled; copies of field notes; etc. Attach a copy of a map showing location of mouth and observed upper extent of each species, as well as other information such as: specific stream reaches observed as spawning or rearing habitat; locations, types, and heights of any barriers; etc.

314-20.05 Portage Valley & Portage Creek. Aerial surveys have been conducted on this system since the **1960s** and observers have noted the presence of **pink, sockeye, coho and chum salmon**, which has been published in our ADF&G Annual Salmon Management Reports (AMR).


Please add pink (1984,1997) salmon; see attached map.

Add PINK SALMON present to 314-20-10510

Name of Observer (please print): on file; published in AMR
Signature: _____ Date: _____
Agency: Alaska Department of Fish & Game
Address: 211 Mission Road
Kodiak, Alaska 99615

This certifies that in my best professional judgment and belief the above information is evidence that this waterbody should be included in or deleted from the Anadromous Waters Catalog.

Signature of Area Biologist: Robert Murphy Date: 11/14/08 Revision 02/08
Name of Area Biologist (please print): Robert Murphy, FBIII

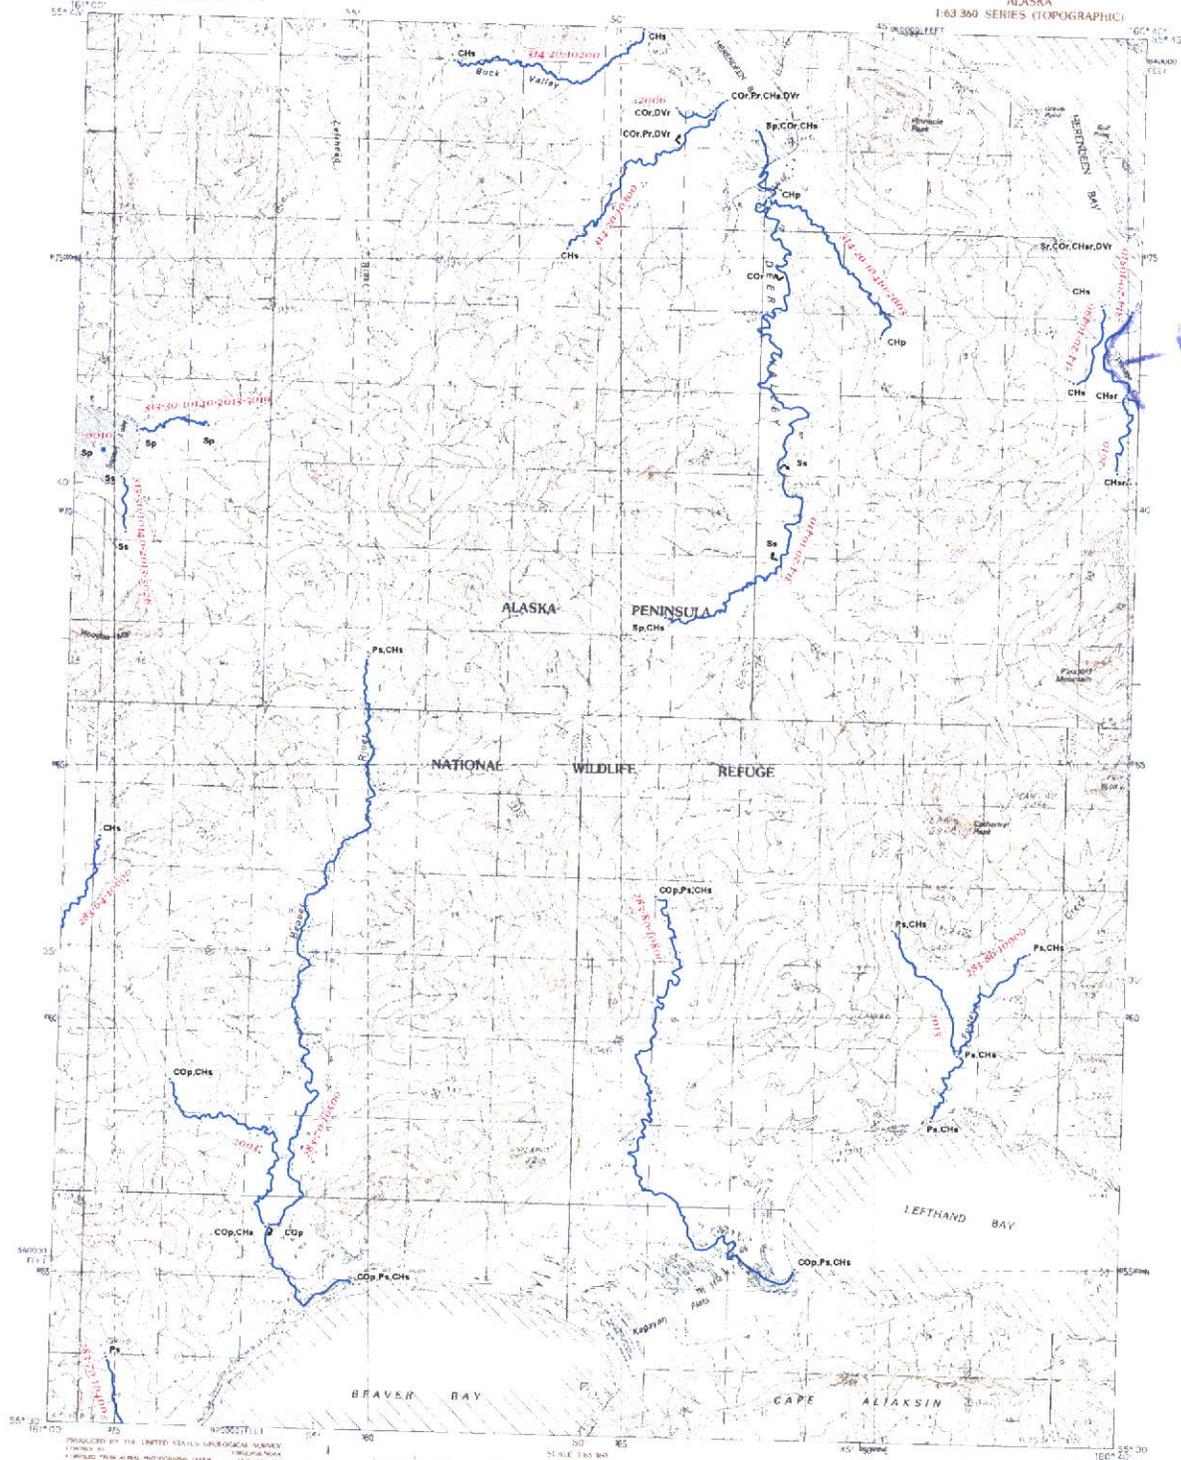

Key to Robert Murphy's Maps

- P = Purple** **CO = Blue**
- CH = Green** **S = Red** **K = Yellow**
- DV = Orange**
- SH = Brown**

- Lower/Upper Point of Stream
- ⊥ Midstream Species Begin/End Point
- ★ Short Stream (Under 600 feet)
- Lake
- ▲ Barrier
- ~ Anadromous Streams
- ▨ Anadromous Areas
- AWC Stat Area
- Regional Boundary

Waters Important to Anadromous Fish are listed pursuant to AS 41.14.870. Specified species distribution and life functions reflect known data. Actual distribution and use may extend beyond specified limits. Migration upstream and/or downstream is assumed for specified stream reaches.

SPECIES CODES	
CO	coho salmon
CH	chum salmon
K	chinook salmon (king)
P	pink salmon
S	sockeye salmon
AC	Arctic char
CT	cutthroat trout
DV	Dolly varden
SH	steelhead
IF	Inconnu (sheefish)
W	whitefishes
OU	ousted
SM	smelts
ST	sturgeon
AL	Arctic lamprey
LP	lamprey (undifferentiated)
PC	Pacific lamprey
LV	river lamprey

LIFE STAGE CODES	
p	Present
m	Migration
r	Rearing
s	Known
sp	Spawning




Produced By
State of Alaska
Department of Fish and Game

Fish Distribution Database Atlas

Quad No. 32

Port Moller
C - 3

Revision Date 4/7/2005

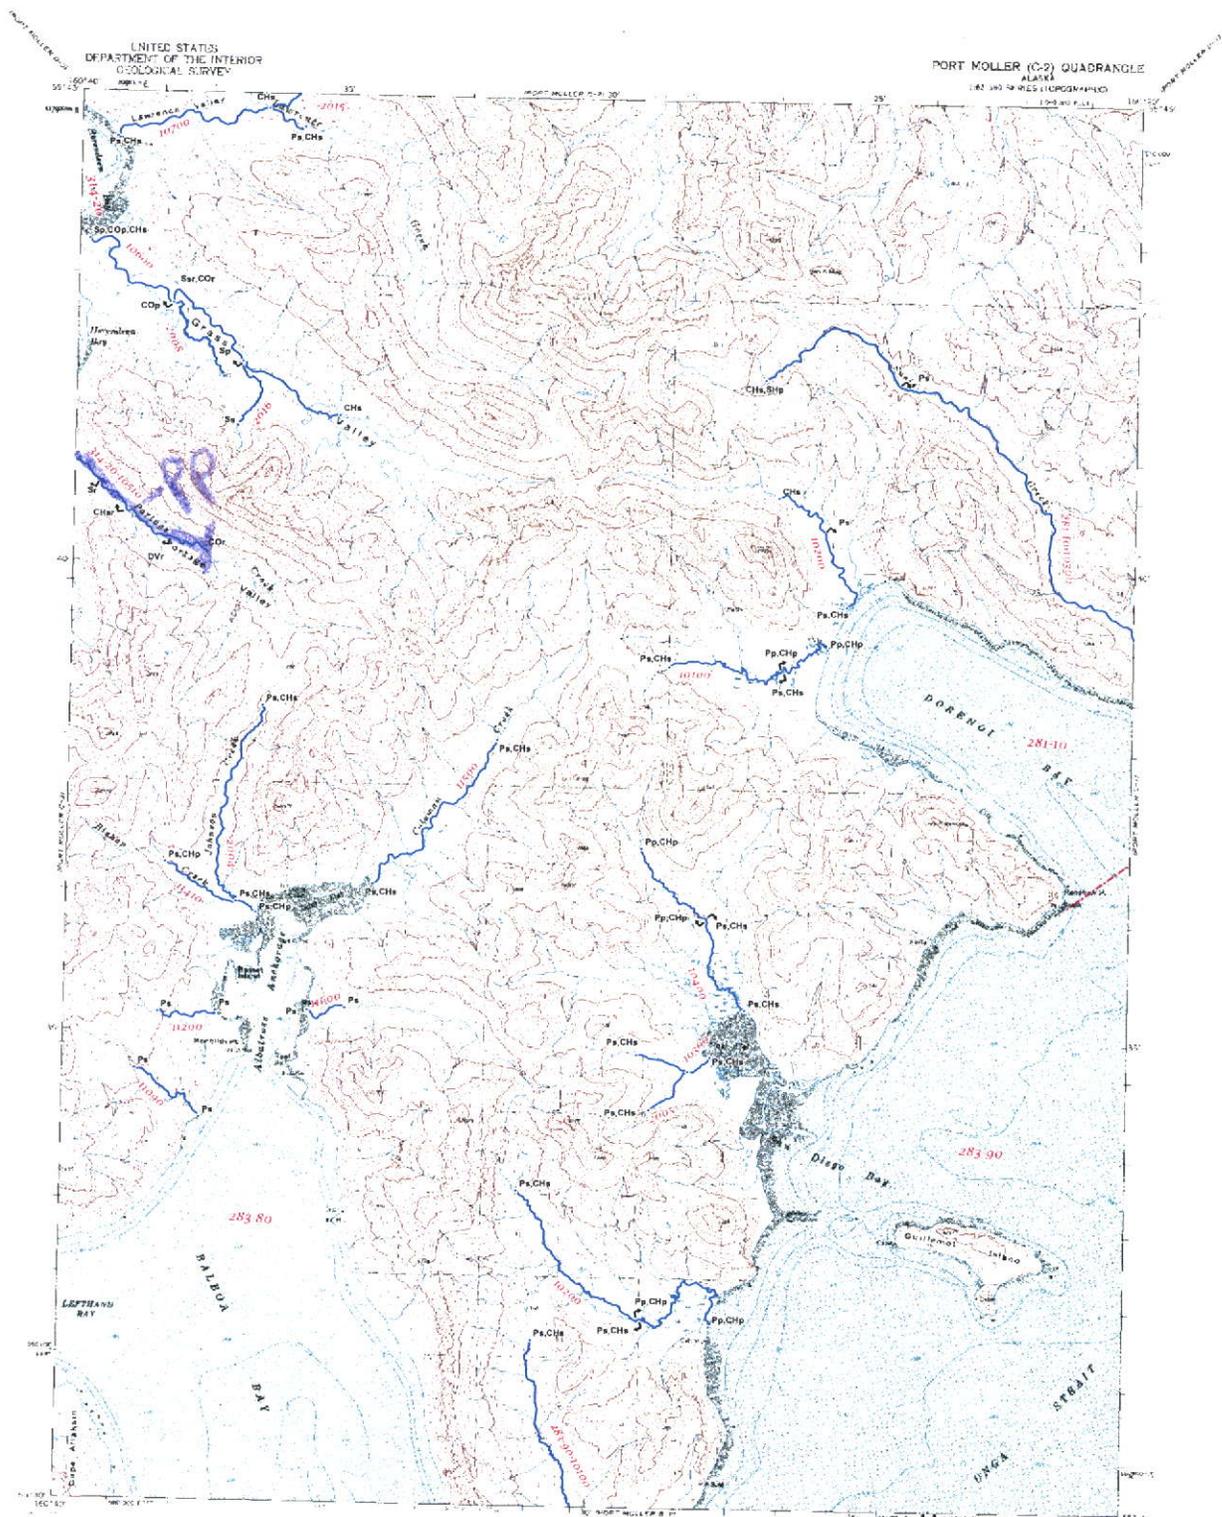

Key to Robert Murphy's Maps

- P = Purple** **CO = Blue**
- CH = Green** **S = Red** **K = Yellow**
- DV = Orange**
- SH = Brown**

SCALE 1:50,000
 UNITED STATES GEOLOGICAL SURVEY
 WASHINGTON, D. C. 20542
 PORT MOLLER (C-2), ALASKA
 1:50,000 SCALE
 1963

PORT MOLLER (C-2), ALASKA
 1:50,000 SCALE
 1963

* Lower/Upper Point of Stream
 † Midstream Species Begin/End Point
 ★ Short Stream (Under 660 feet)
 ■ Lake
 ▲ Barrier
 ~ Anadromous Streams
 ▨ Anadromous Areas
 --- AWC Stal Area
 --- Regional Boundary

Waters Important to Anadromous Fish are listed pursuant to AS 41.14.870. Specified species distribution and life functions reflect known data. Actual distribution and use may extend beyond specified limits. Migration upstream and/or downstream is assumed for specified stream reaches.

SPECIES CODES		LIFE STAGE CODES	
CO	coho salmon	p	Present
CH	chum salmon	m	Migration
K	king salmon	r	Rearing
P	pink salmon	Known	Known
CT	cutterhead trout	s	Spawning
DV	dolly varden		
SF	sockeye salmon		
SM	smelt		
ST	steelhead		
SH	sheephead		
W	whitefish		
AC	arctic char		




Produced By
 State of Alaska
 Department of Fish and Game

Fish Distribution Database Atlas

Port Moller C - 2

Revision Date 04/2003

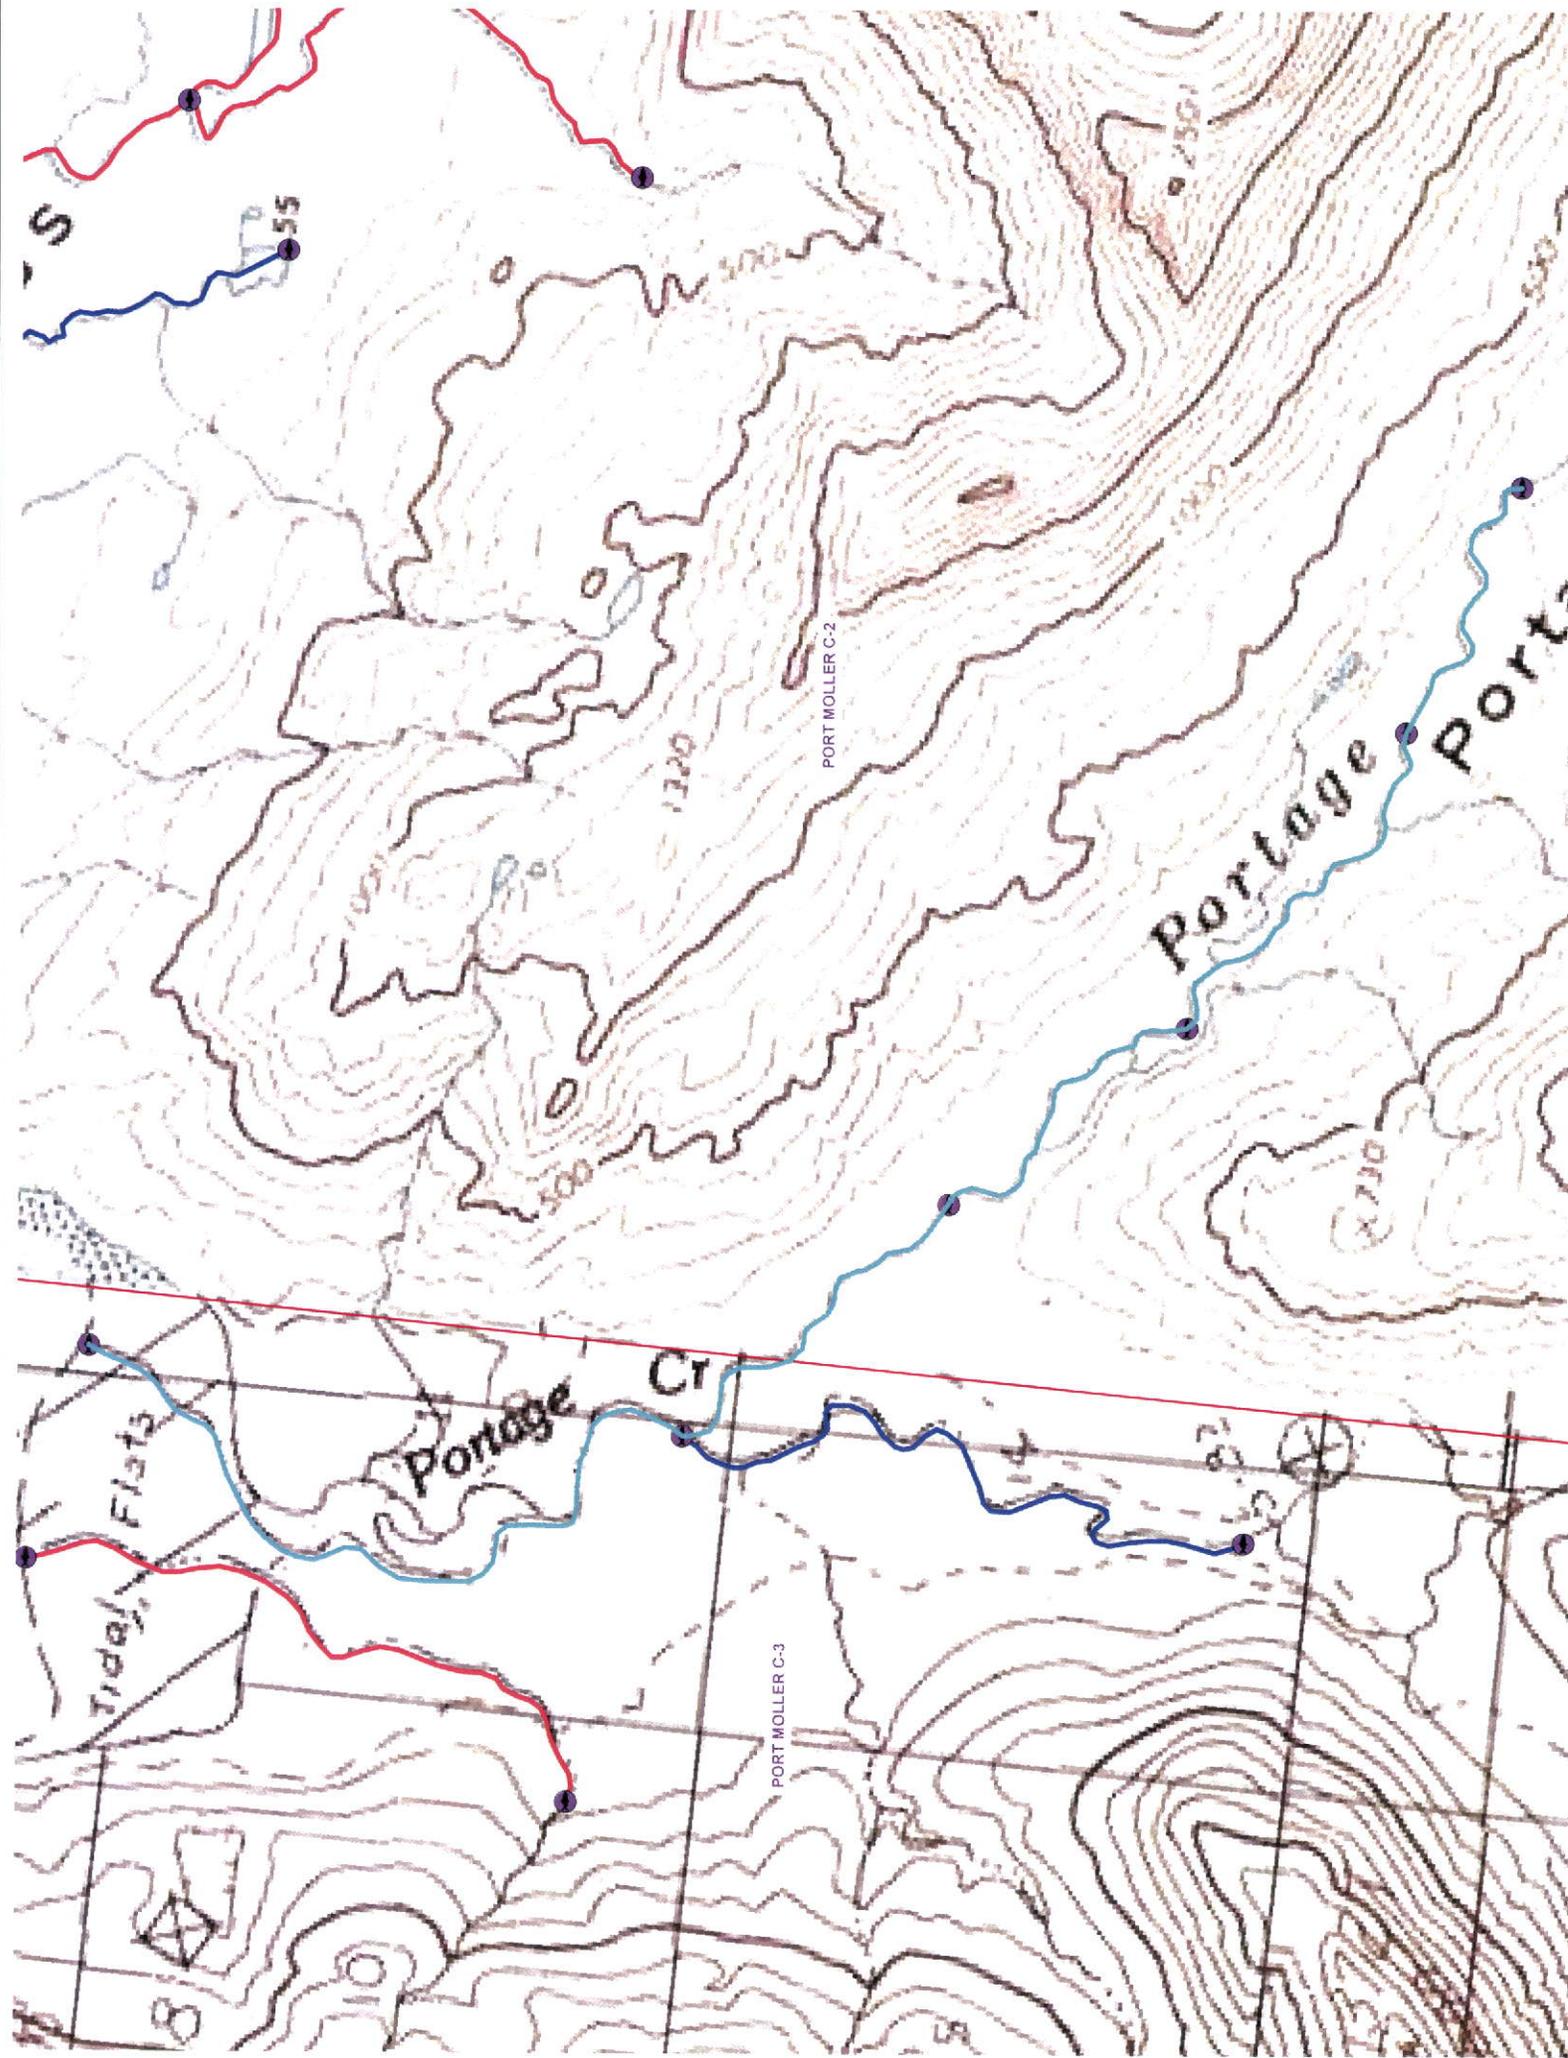

S

555


PORT MOLLER C-2

Portage Portage

Portage Cr.

Tidal Flats

PORT MOLLER C-3

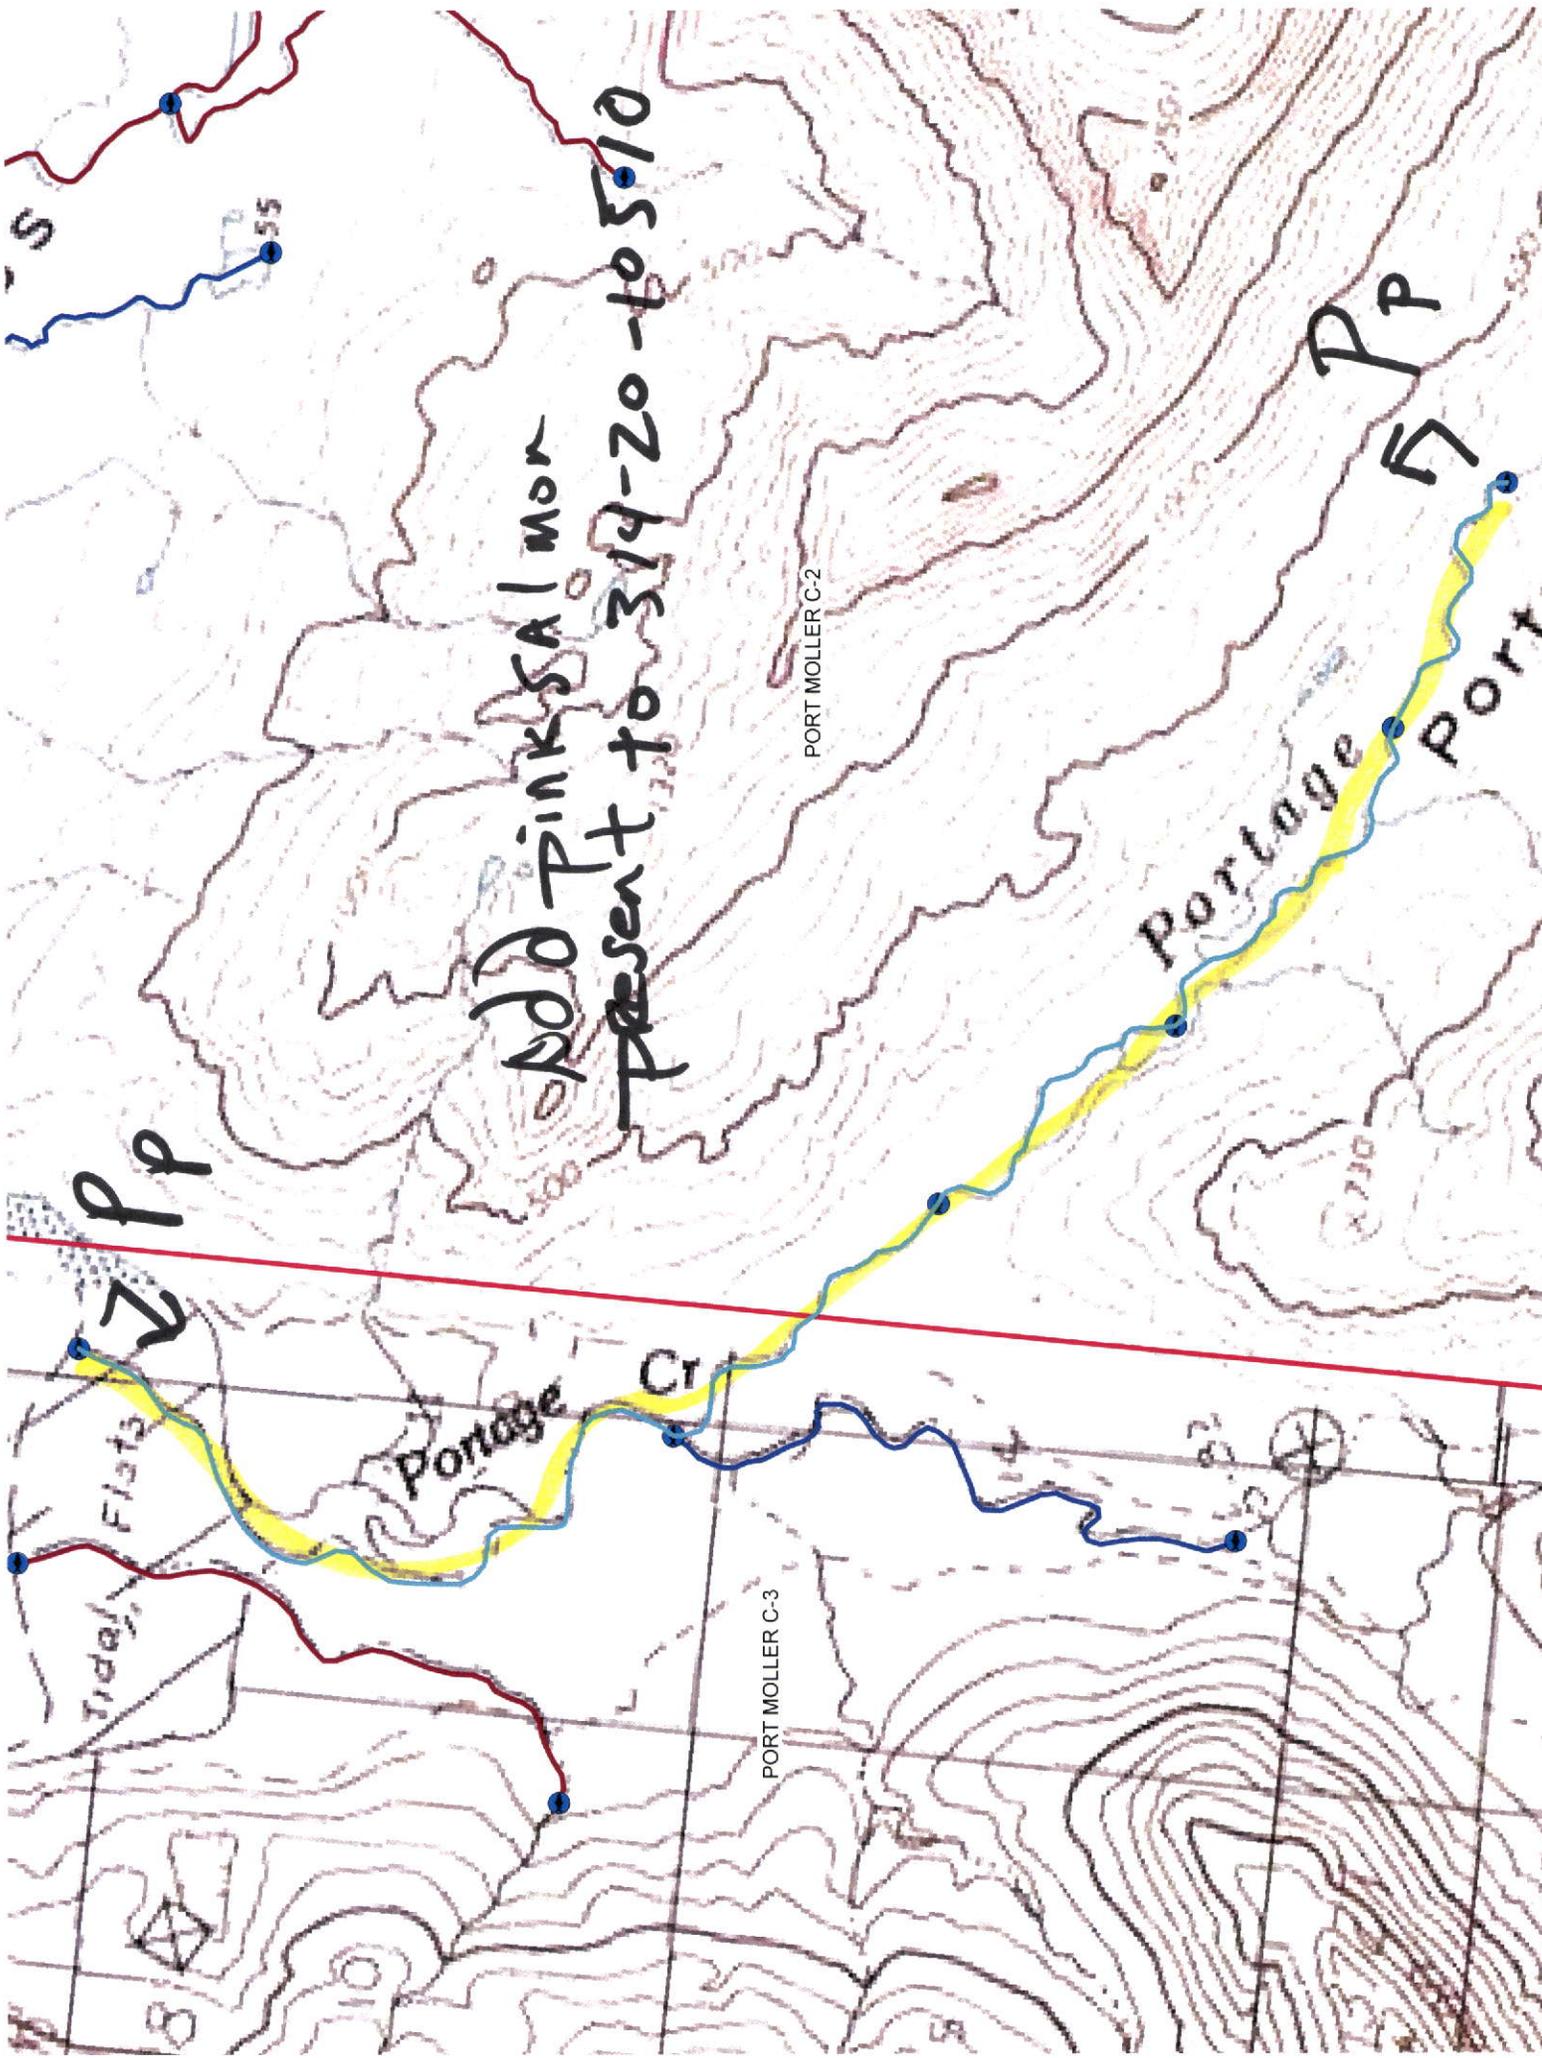

Add PINKSAL MOR
present to 314-20-10510

PP

PP

Tidal Flats

Portage Ct

PORT MOLLER C-2

Portage

Portage

PP

PORT MOLLER C-3

S

55

50

8700

83

8

82