



State of Alaska
Department of Fish and Game
Division of Sport Fish

Nomination Form
Anadromous Waters Catalog

dB

Region III, Southwestern USGS Quad(s) Unimak D-1

Anadromous Waters Catalog Number of Waterway 311-32-11000

Name of Waterway Peterson Lagoon Area USGS Name Local Name Mud Hole
 Addition Deletion Correction Backup Information

For Office Use

Nomination # <u>09-121</u>	<u>[Signature]</u> Fisheries Scientist	<u>5/26/09</u> Date
Revision Year: <u>2010</u>	<u>[Signature]</u> Habitat Operations Manager	<u>5/26/09</u> Date
Revision to: Atlas _____ Catalog _____ Both <u>X</u>	<u>[Signature]</u> AWC Project Biologist	<u>02/09/09</u> Date
Revision Code: <u>B-1</u>	<u>[Signature]</u> Cartographer	<u>7/10/09</u> Date

OBSERVATION INFORMATION


Species	Date(s) Observed	Spawning	Rearing	Present	Anadromous
coho salmon	see below in ()			yes	<input checked="" type="checkbox"/>
					<input type="checkbox"/>
					<input type="checkbox"/>
					<input type="checkbox"/>
					<input type="checkbox"/>

IMPORTANT: Provide all supporting documentation that this water body is important for the spawning, rearing or migration of anadromous fish, including: number of fish and life stages observed; sampling methods, sampling duration and area sampled; copies of field notes; etc. Attach a copy of a map showing location of mouth and observed upper extent of each species, as well as other information such as: specific stream reaches observed as spawning or rearing habitat; locations, types, and heights of any barriers; etc.

311-30.09. Mud Hole, Peterson Lagoon. Aerial surveys have been conducted on this system since the **1960s** and observers have noted the presence of **sockeye, coho and chum salmon**, which has been published in our ADF&G Annual Salmon Management Reports (AMR).
Add coho salmon present to 311-32-11000
Please add coho (2001,2003,2004,2005,2007) salmon; see attached map.

Name of Observer (please print): on file; published in AMR
 Signature: _____ Date: _____
 Agency: Alaska Department of Fish & Game
 Address: 211 Mission Road
Kodiak, Alaska 99615

This certifies that in my best professional judgment and belief the above information is evidence that this waterbody should be included in or deleted from the Anadromous Waters Catalog.
 Signature of Area Biologist: [Signature] Date: 11-25-08 Revision 02/08
 Name of Area Biologist (please print): Aaron Poetter, FBIII

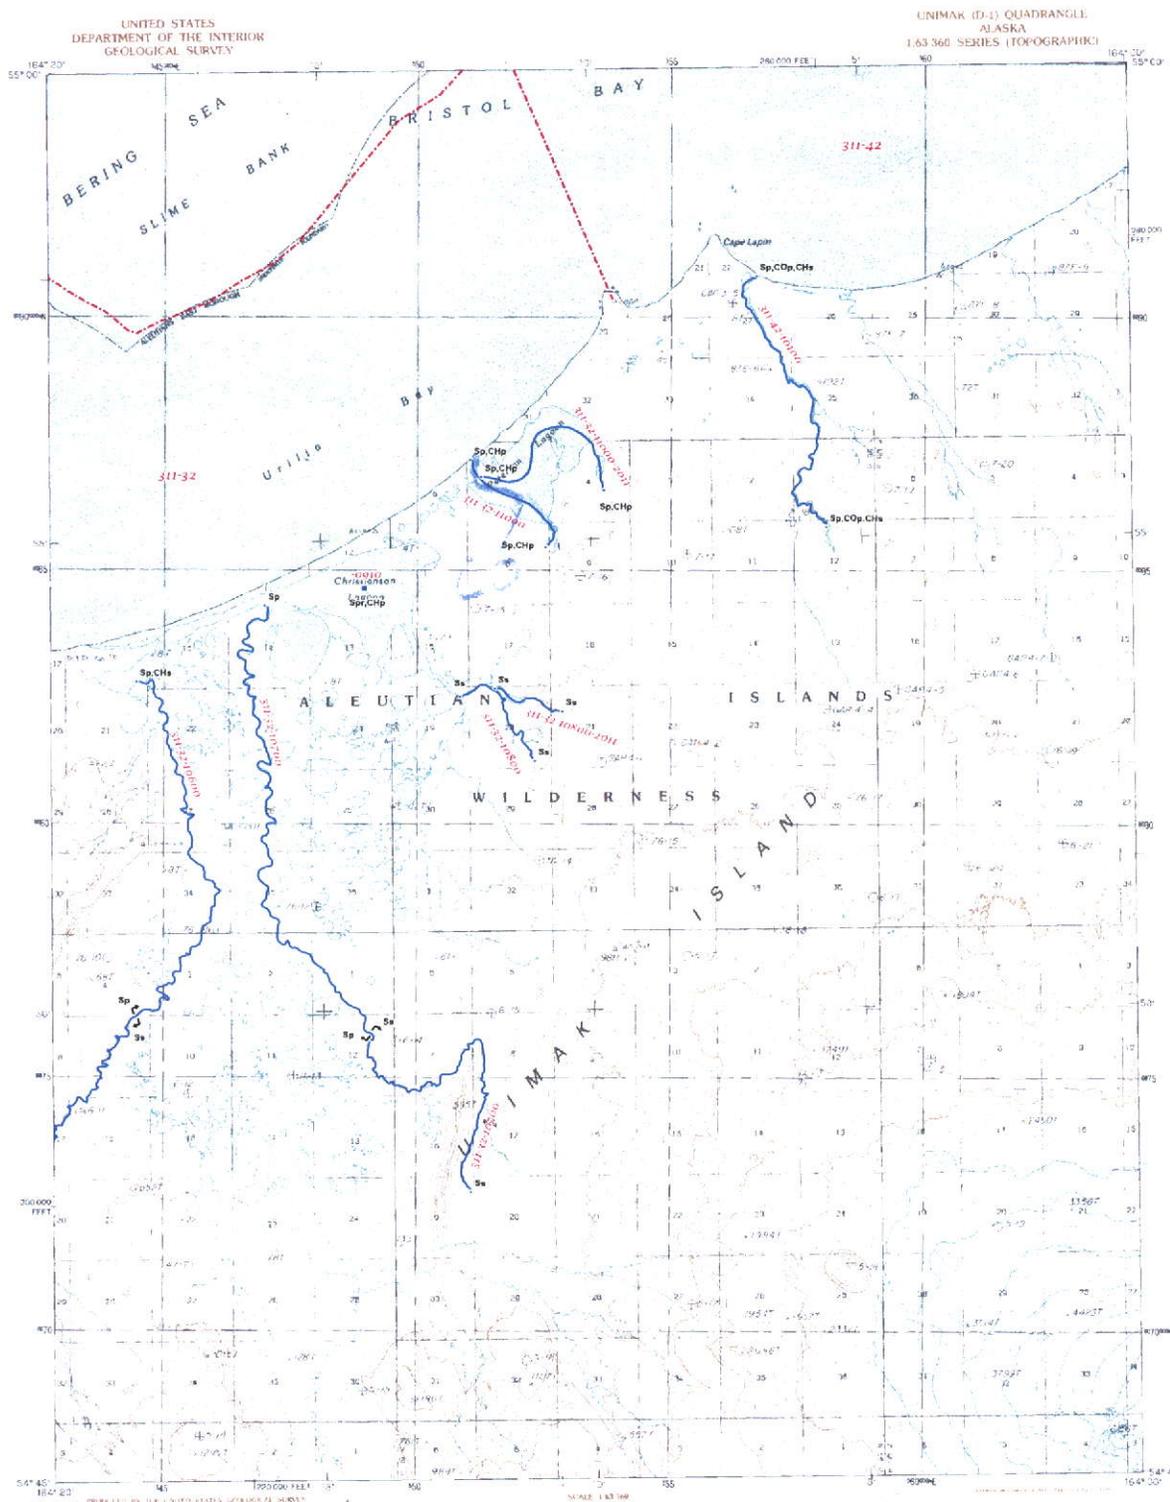

Legend to Aaron Poetter's Maps

- P = Purple** **CO = Blue**
- CH = Green** **S = Red** **K = Yellow**
- DV = Orange**
- SH = Brown**

REGIONAL MAP
 1. Area original as developed. 2. Area shown as of date of map.

UNIMAK (D-1) QUADRANGLE, ALASKA
 1:63,360 SERIES (TOPOGRAPHIC)
 UNITED STATES GEOLOGICAL SURVEY, FAIRBANKS, ALASKA 99701
 (SOURCE: U.S. GEOLOGICAL SURVEY, 1963)



UNIMAK (D-1), ALASKA
 PREPARED BY: LUTHERN, 1988
 SCALE: 1:71,360

- Lower/Upper Point of Stream
- ⊥ Midstream Species Begin/End Point
- ★ Short Stream (Under 660 feet)
- Lake
- ▲ Barrier

- Anadromous Streams
- ▨ Anadromous Area
- AVC Stat Area
- Regional Boundary


SPECIES CODES		LIFE STAGE CODES	
CO	coho salmon	p	Present
CH	chum salmon	m	Migration
K	chinook salmon (king)	R	Retiring
P	pink salmon	k	Known
S	sockeye salmon	s	Spawning
CT	cutoffroat trout		
DW	dolly varden		
SP	iscounna (sheefish)		
SM	smelts		
ST	sturgeon		
SH	steelhead		
W	whitefishes		
AC	arctic char		



Produced By
 State of Alaska
 Department of Fish and Game

Fish Distribution Database Atlas
 Quad No. 28
Unimak
D - 1
 Revisor Date 04/19/2005

Waters Important to Anadromous Fish are listed pursuant to AS 41.14.870. Specified species distribution and life functions reflect known data. Actual distribution and use may extend beyond specified limits. Migration upstream and/or downstream is assumed for specified stream reaches.

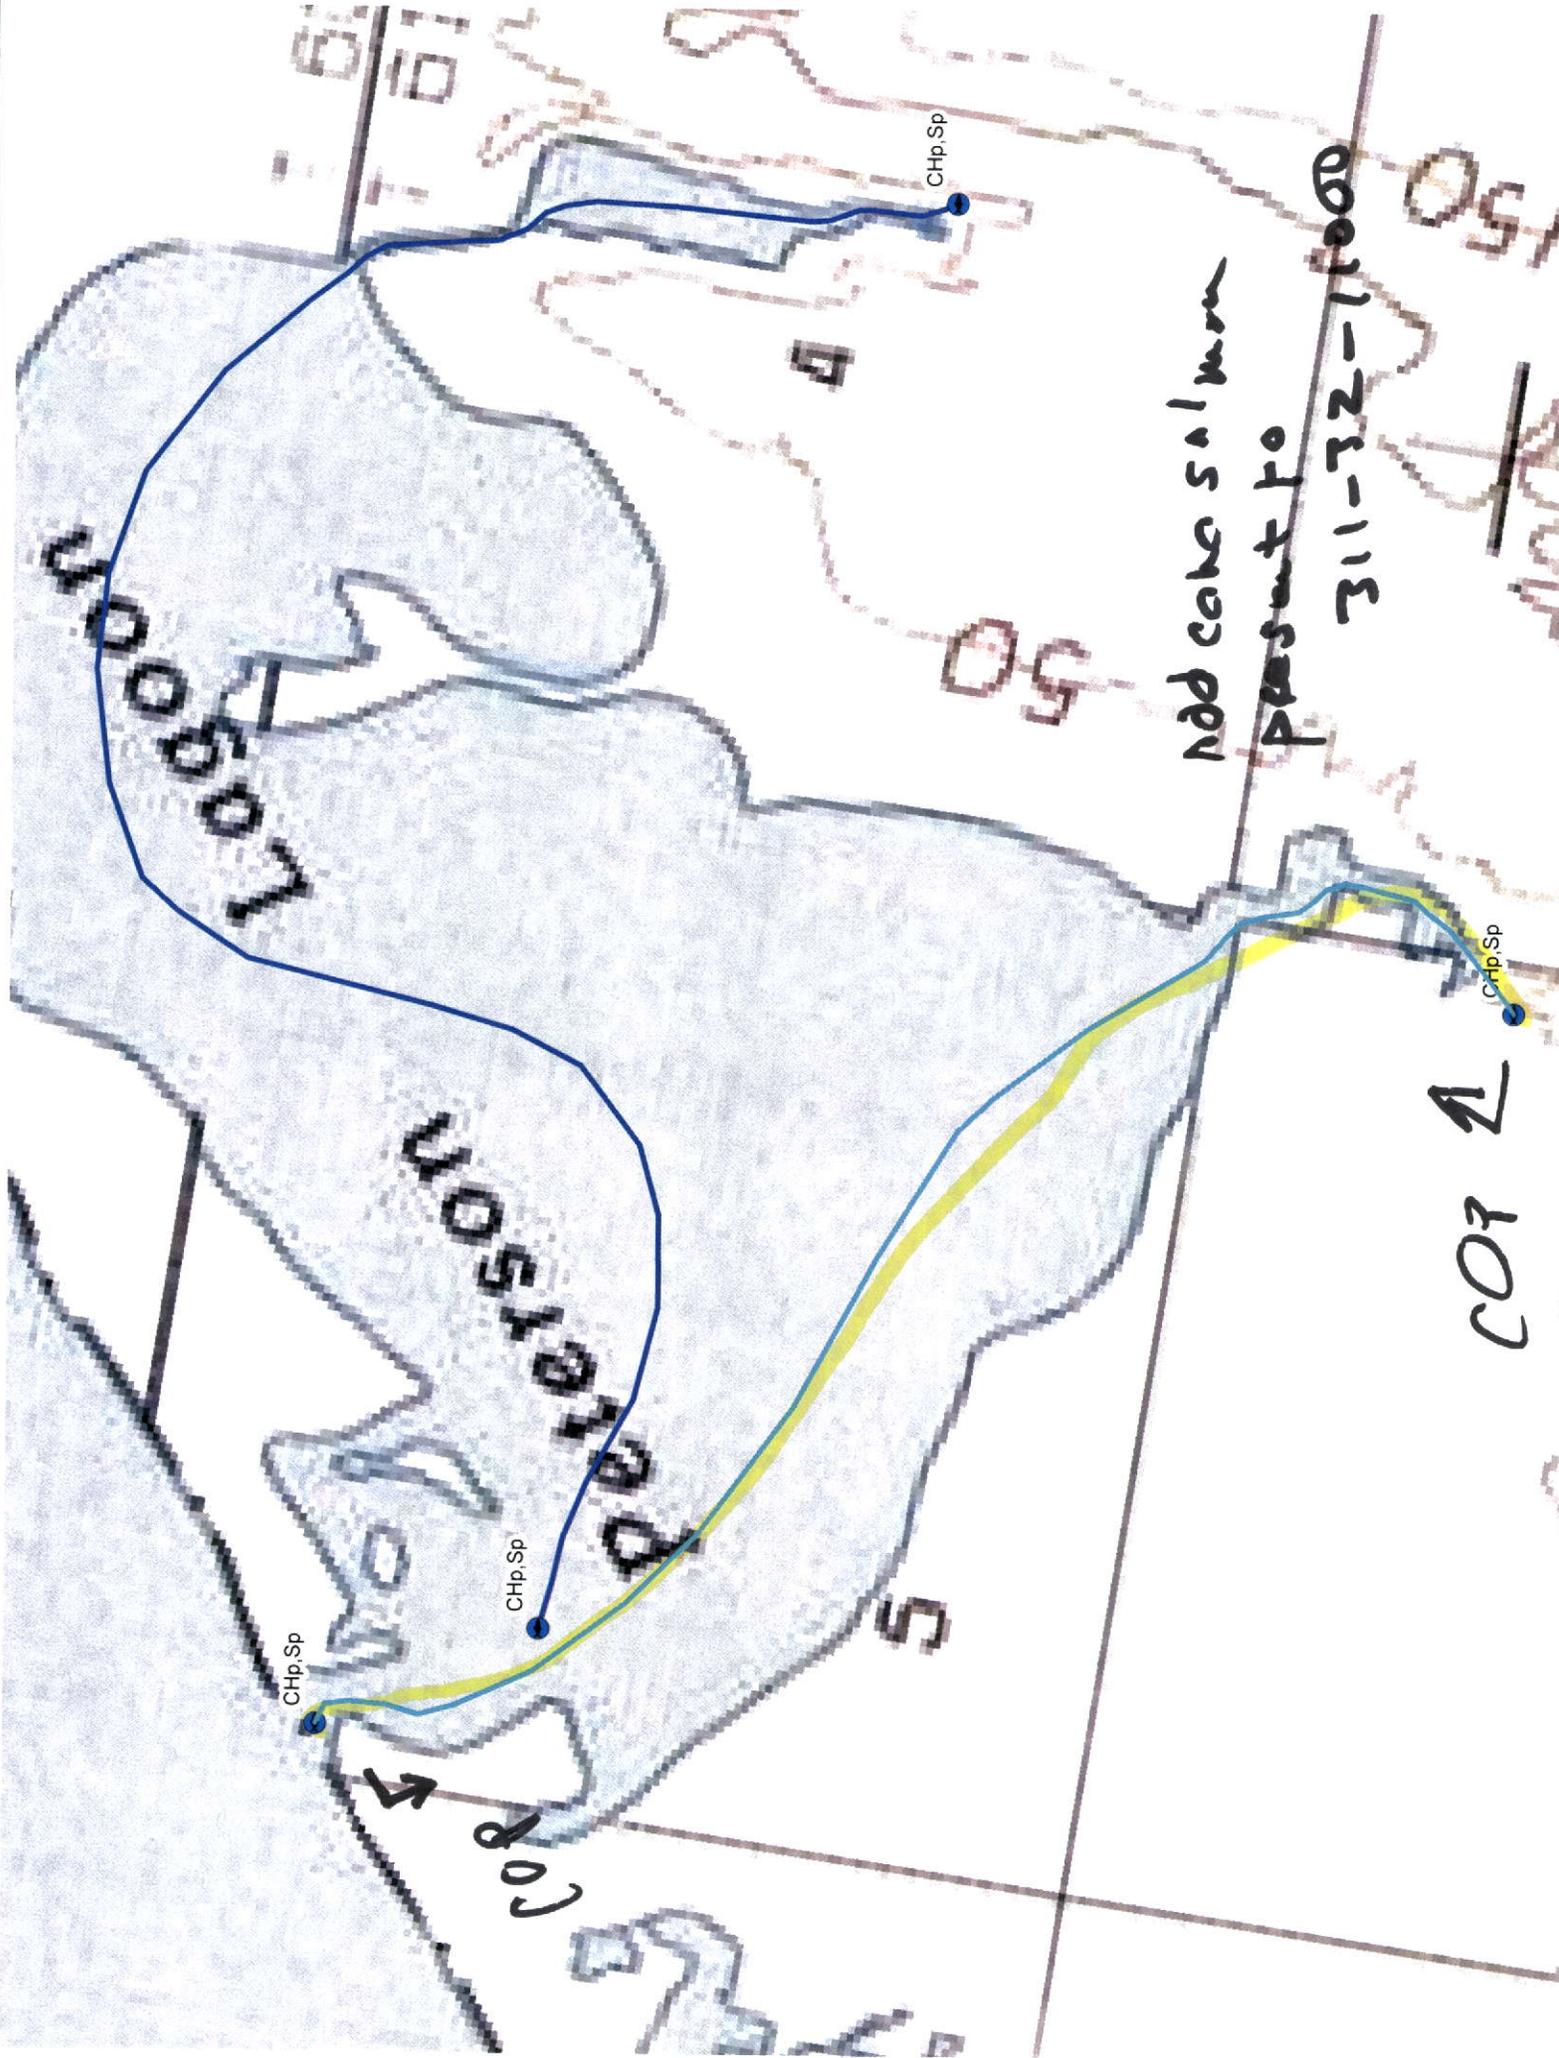

WOODHILL

WILSON

CHp.Sp

CHp.Sp

CHp.Sp

CHp.Sp

add catch salmon present to 311-32-11000

CO7