



State of Alaska  
Department of Fish and Game  
Division of Sport Fish

Nomination Form  
Anadromous Waters Catalog

JB

Region III, Southwestern USGS Quad(s) Cold Bay B-2  
Anadromous Waters Catalog Number of Waterway 312-40-10086

Name of Waterway Unnamed, springs 2 miles SW Joshua Green River  USGS Name  Local Name  
 Addition  Deletion  Correction  Backup Information

For Office Use

Nomination # <u>C9-133</u>	<u>[Signature]</u> Fisheries Scientist	<u>5/26/09</u> Date
Revision Year: <u>2010</u>	<u>[Signature]</u> Habitat Operations Manager	<u>5/26/09</u> Date
Revision to: Atlas _____ Catalog _____ Both <u>X</u>	<u>[Signature]</u> AWC Project Biologist	<u>6/29/09</u> Date
Revision Code: <u>B-1</u>	<u>[Signature]</u> Cartographer	<u>6/18/09</u> Date

OBSERVATION INFORMATION

Species	Date(s) Observed	Spawning	Rearing	Present	Anadromous
sockeye salmon	published in AMR, year in ( )			yes	<input checked="" type="checkbox"/>
					<input type="checkbox"/>
					<input type="checkbox"/>
					<input type="checkbox"/>
					<input type="checkbox"/>

**IMPORTANT:** Provide all supporting documentation that this water body is important for the spawning, rearing or migration of anadromous fish, including: number of fish and life stages observed; sampling methods, sampling duration and area sampled; copies of field notes; etc. **Attach a copy of a map showing location of mouth and observed upper extent of each species,** as well as other information such as: specific stream reaches observed as spawning or rearing habitat; locations, types, and heights of any barriers; etc.

**312-40.05. Unnamed, springs two miles SW Joshua Green River.** Aerial surveys have been conducted on this system since the 1980s and observers have noted the presence of **sockeye and chum salmon**, which has been published in our ADF&G Annual Salmon Management Reports (AMR).


**Please add (2006) salmon; see attached map.**

*Add sockeye salmon present to 312-40-10086*

Name of Observer (please print): on file; name and date is published in AMR  
Signature: \_\_\_\_\_ Date: \_\_\_\_\_  
Agency: Alaska Department of Fish & Game  
Address: 211 Mission Road  
Kodiak, Alaska 99615

This certifies that in my best professional judgment and belief the above information is evidence that this waterbody should be included in or deleted from the Anadromous Waters Catalog.

Signature of Area Biologist: [Signature] Date: 11-26-08 Revision 02/08  
Name of Area Biologist (please print): Aaron Poetter, FBIII

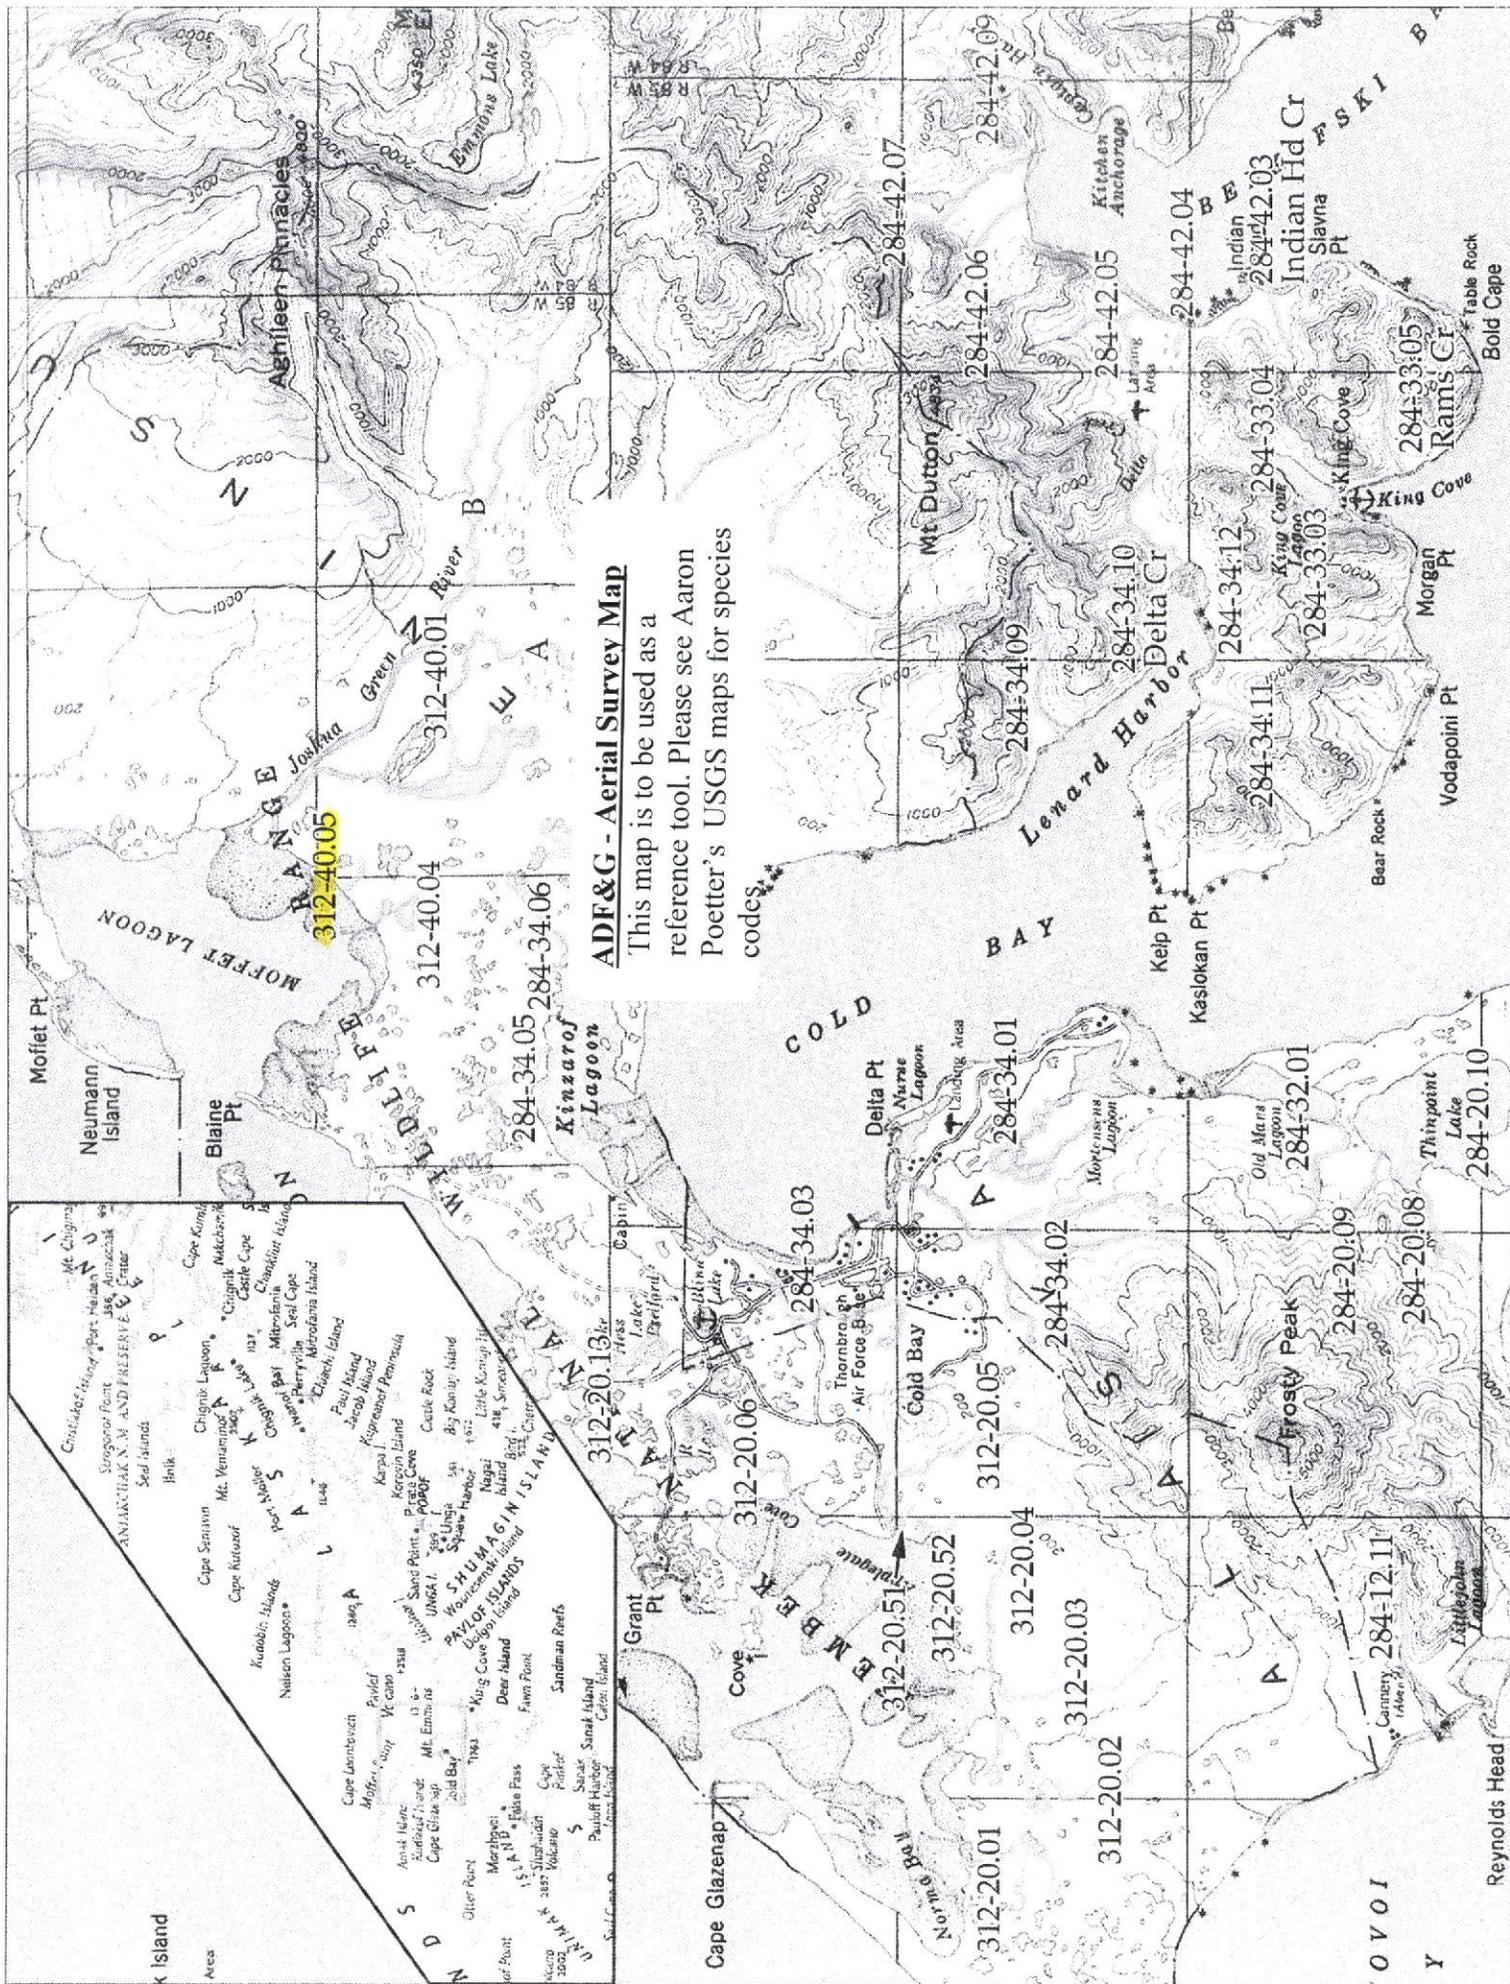

**ADF&G - Aerial Survey Map**  
 This map is to be used as a reference tool. Please see Aaron Poetter's USGS maps for species codes.



**Legend to Aaron Poetter's Maps**

- P = Purple**    **CO = Blue**
- CH = Green**    **S = Red**    **K = Yellow**
- DV = Orange**
- SH = Brown**

• Lower/Upper Point of Stream  
 ◡ Midstream Species Begin/End Point  
 ★ Short Stream (Under 600 feet)  
 ■ Lake  
 ▲ Barrier  
 --- Anadromous Streams  
 ▨ Anadromous Areas  
 --- AWC Stat Area  
 --- Regional Boundary

Waters Important to Anadromous Fish are listed pursuant to AS 41.14.870. Specified species distribution and life functions reflect known data. Actual distribution and use may extend beyond specified limits. Migration upstream and/or downstream is assumed for specified stream reaches.

SPECIES CODES		LIFE STAGE CODES	
CO	coho salmon	p	Present
CH	chum salmon	m	Migration
K	king salmon (King)	r	Rearing
P	pink salmon	k	Known
S	sockeye salmon	s	Spawning
AC	Arctic char		
CT	cutthroat trout		
DN	Dolly varden		
SH	sheepshead		
SP	herring (sheepshead)		
W	whitefish		
OU	oualichen		
SM	rainbow smelt		
SM	smelts		
ST	sturgeon		
AL	Arctic lamprey		
LP	lamprey (undifferentiated)		
PC	Pacific lamprey		
LV	river lamprey		



Produced By  
State of Alaska  
Department of Fish and Game


**Fish Distribution Database Atlas**  
 Quad No. 031  
**Cold Bay**  
**B-2**  
 Revision Date 12/15/2008

UNITED STATES GEOLOGICAL SURVEY  
 COLD BAY (B-2), ALASKA  
 1:63,360 SERIES (TOPOGRAPHIC)  
 SCALE 1:63,360  
 COLD BAY (B-2), ALASKA  
 1:63,360 SERIES (TOPOGRAPHIC)  
 1982



COLD BAY B-2

Add sockeye salmon  
Present to 312-90-10086

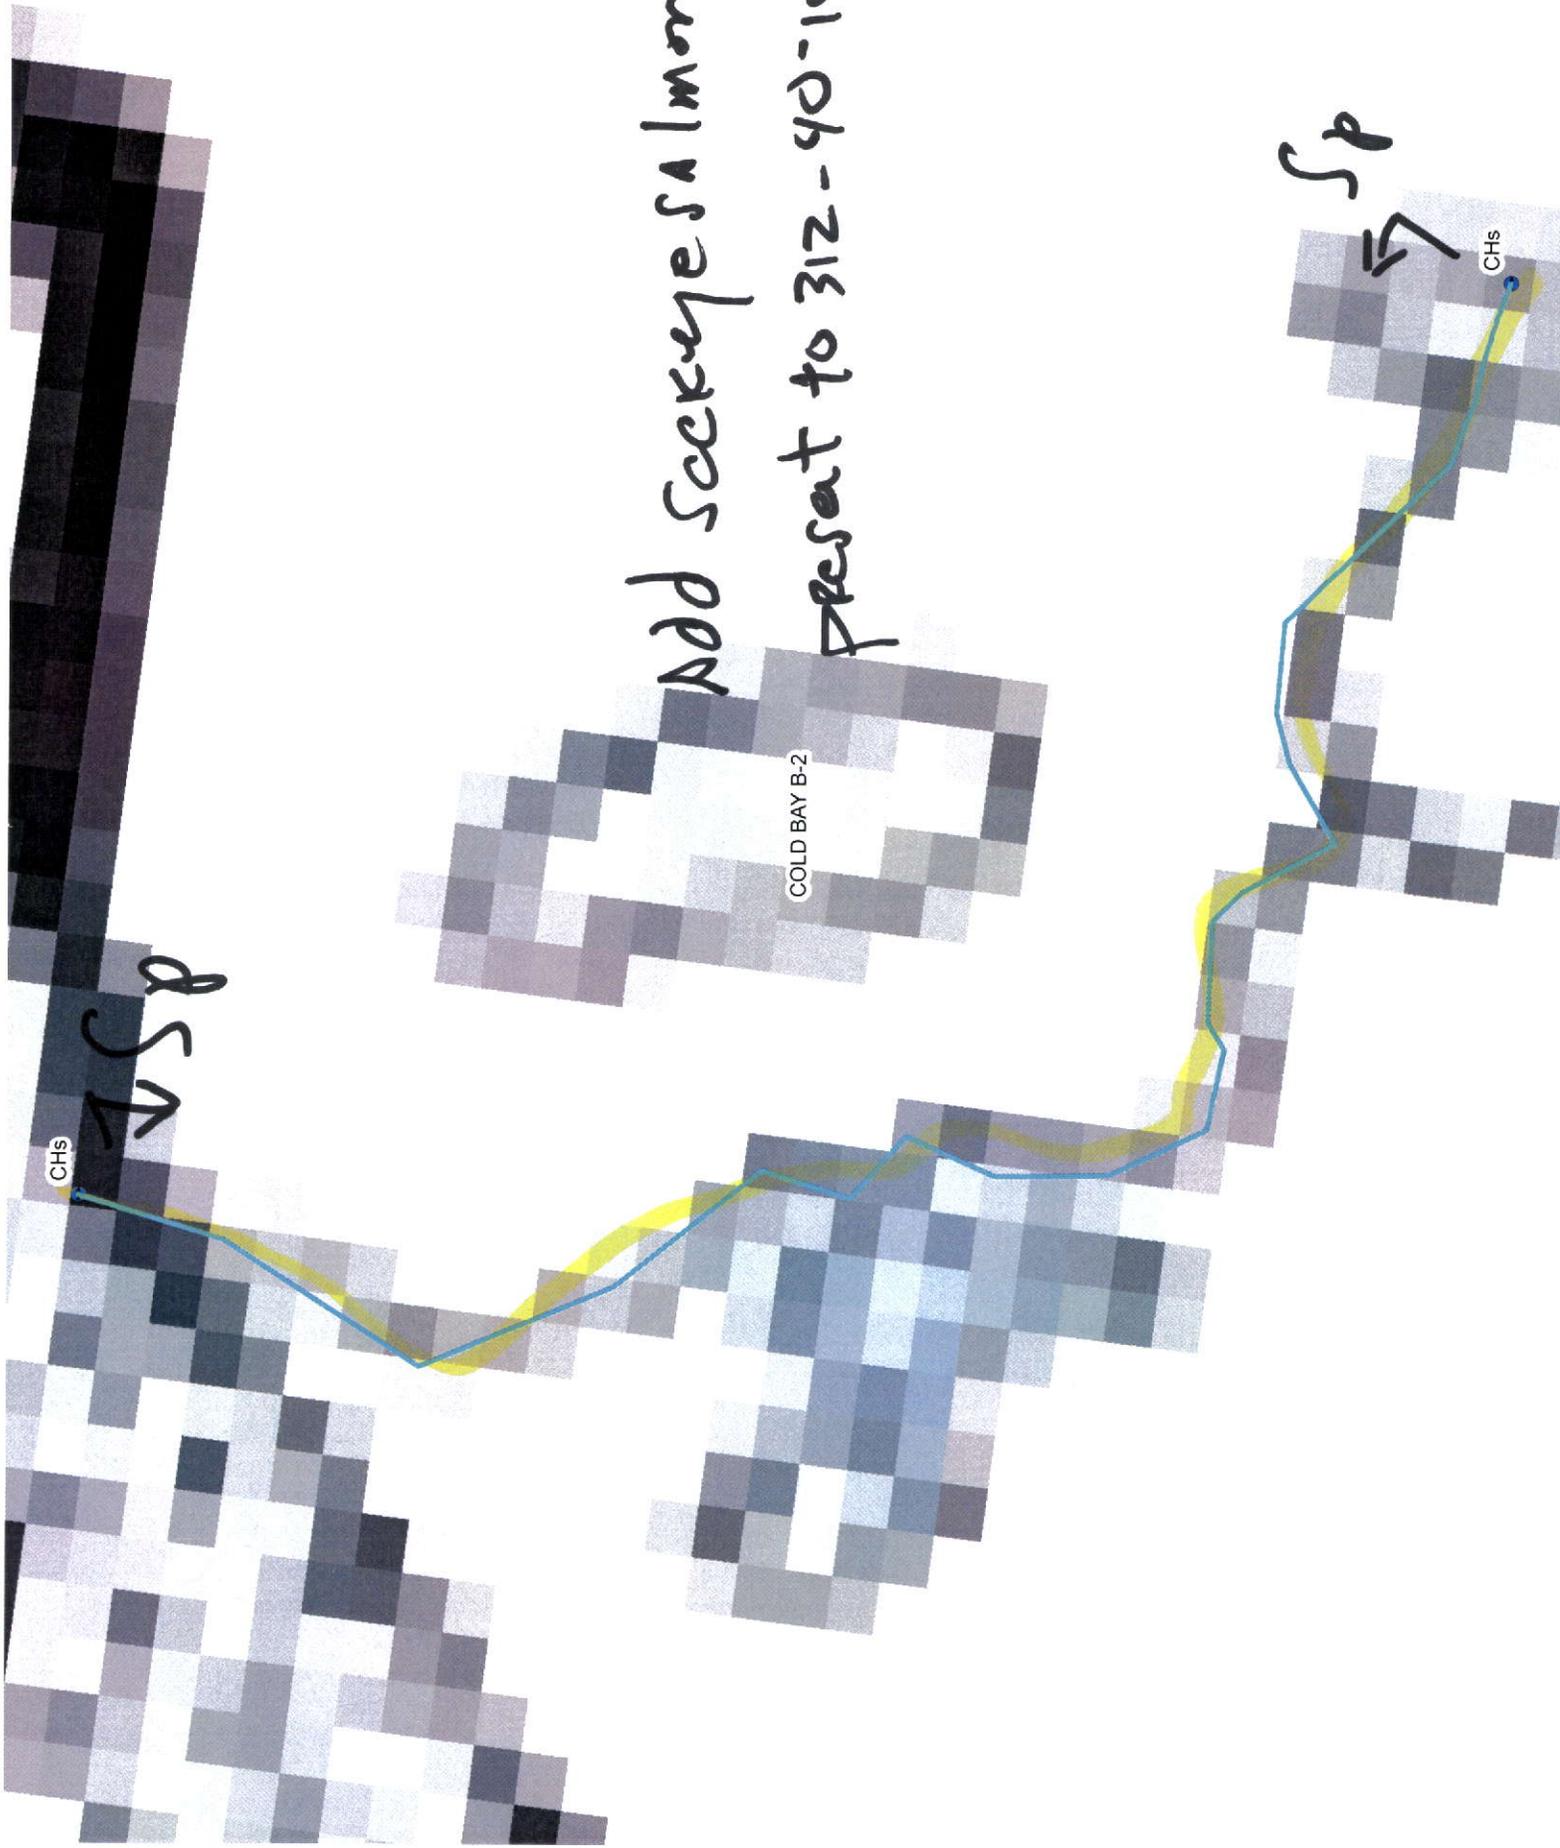

CHS

COLD BAY B-2

CHS

SSP

Sp