



State of Alaska
Department of Fish and Game
Division of Sport Fish

Nomination Form
Anadromous Waters Catalog

Region Southwest USGS Quad(s) Dillingham A-7
 Anadromous Waters Catalog Number of Waterway 525-30-10100-2019
 Name of Waterway unnamed stream USGS Name Local Name
 Addition Deletion Correction Backup Information

For Office Use

Nomination # <u>10-892</u>	<u>[Signature]</u> Fisheries Scientist	<u>10/26/10</u> Date
Revision Year: <u>2011</u>	<u>[Signature]</u> Habitat Operations Manager	<u>10/26/10</u> Date
Revision to: Atlas _____ Catalog _____ Both <u>X</u>	<u>[Signature]</u> AWC Project Biologist	<u>7 OCT 10</u> Date
Revision Code: <u>A-2</u>	<u>[Signature]</u> Cartographer	<u>11/19/10</u> Date

OBSERVATION INFORMATION

Species	Date(s) Observed	Spawning	Rearing	Present	Anadromous
coho salmon	9/14/2010		2		<input checked="" type="checkbox"/>
Alaska blackfish	9/14/2010			8	<input type="checkbox"/>
					<input type="checkbox"/>
					<input type="checkbox"/>
					<input type="checkbox"/>

IMPORTANT: Provide all supporting documentation that this water body is important for the spawning, rearing or migration of anadromous fish, including: number of fish and life stages observed; sampling methods, sampling duration and area sampled; copies of field notes; etc. Attach a copy of a map showing location of mouth and observed upper extent of each species, as well as other information such as: specific stream reaches observed as spawning or rearing habitat; locations, types, and heights of any barriers; etc.


Comments: Set four baited minnow traps in the unnamed stream at 8:40 pm on September 13, 2010. Two traps were set upstream of the culvert under Kananak Road and two traps were set downstream of the culvert. The traps were pulled at 4:05 pm on September 14, 2010.

Add new stream w/ coho salmon rearing



Name of Observer (please print): Jim Bales, Habitat Biologist
 Signature: [Signature] Date: 9/30/2010
 Agency: Alaska Department of Fish and Game
 Address: 333 Raspberry Road
Anchorage, AK 99518

This certifies that in my best professional judgment and belief the above information is evidence that this waterbody should be included in or deleted from the Anadromous Waters Catalog.

Signature of Area Biologist: _____ Date: _____ Revision 05/08
 Name of Area Biologist (please print): _____

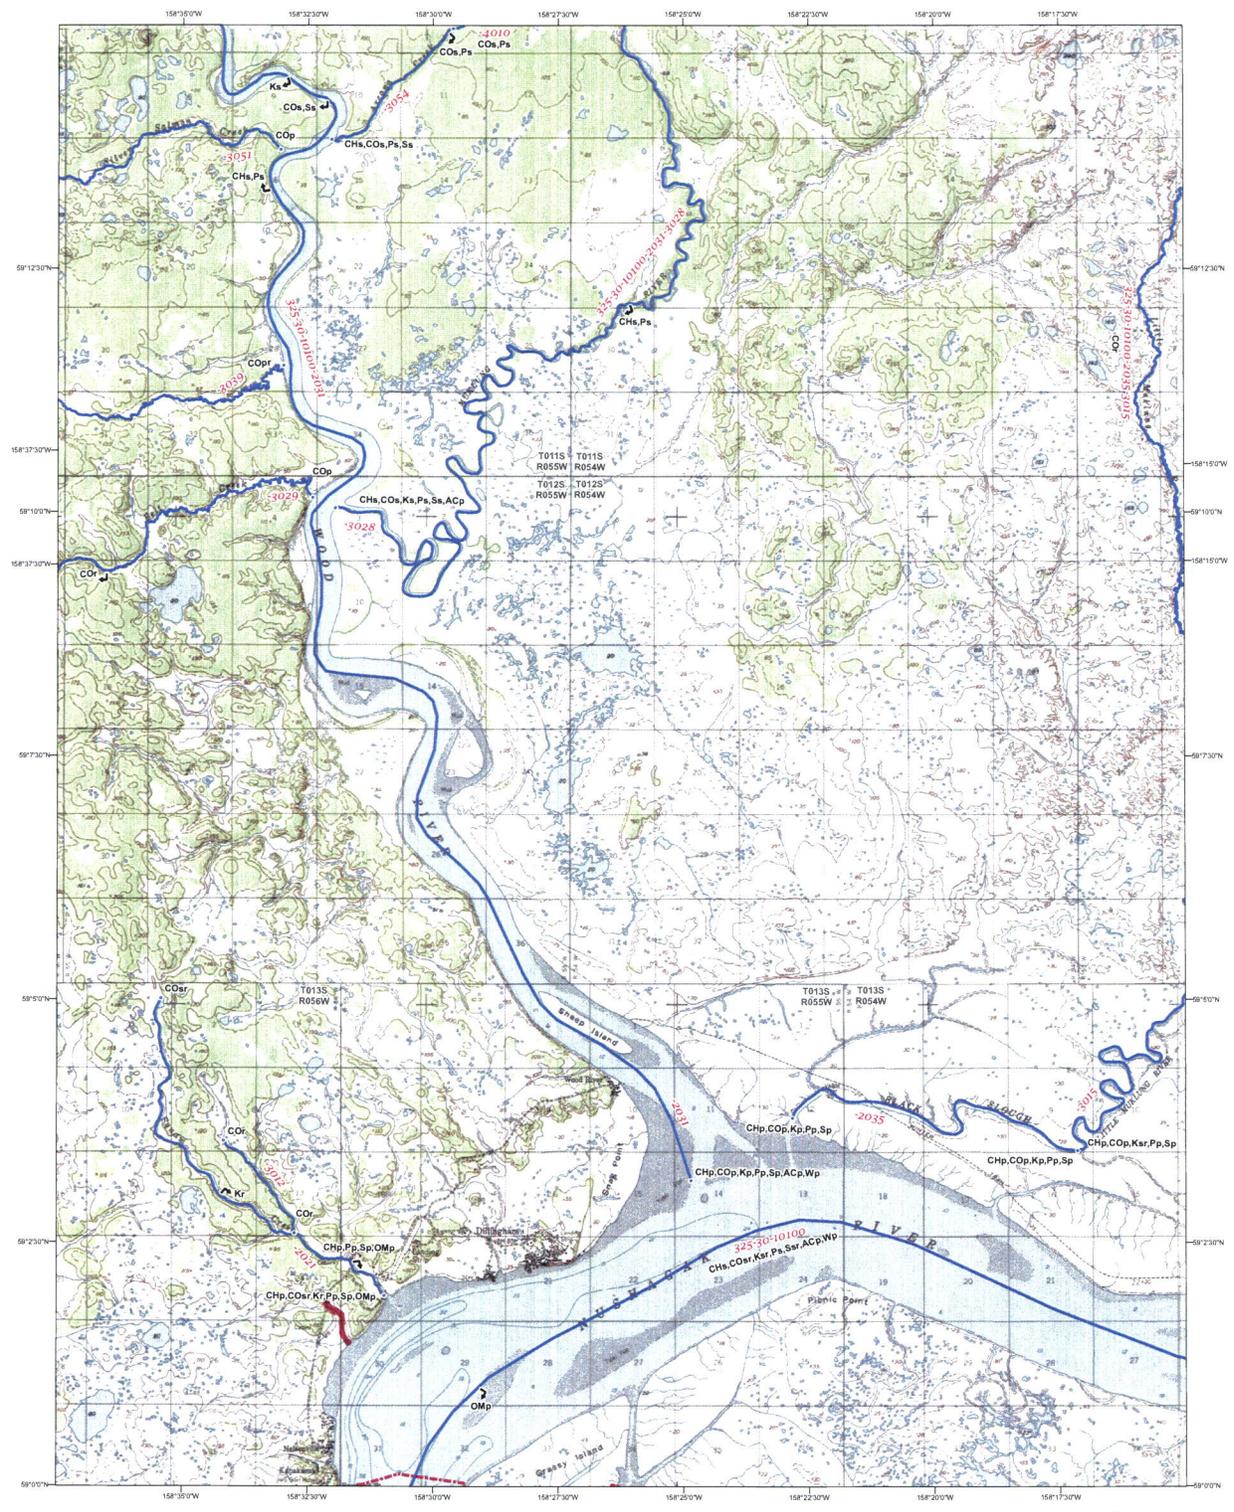

Base map created with TOPOI. ©2006 National Geographic Maps. All Rights Reserved.
 The geographical base map data are based on USGS topographic maps, USGS elevation data, and the USGS Geographic Names Information System. Please consider carefully the fact that the geographic data may not be adequate for purposes requiring precision in depiction of geographic features, exact measurement of direction or distance, or for similar purposes including but not limited to navigation, tracking, or emergency response.
 Access this map on the web at <http://www.af.adfg.state.ak.us/SARRIAWC>

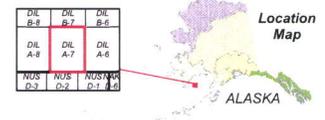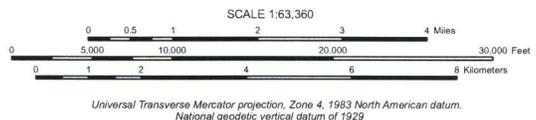

- Lower/Upper Point of Stream
 - ⚡ Midstream Species Begin/End Point
 - ★ Short Stream (Under 660 feet)
 - Lake
 - ▬ Barrier
 - ▬ Anadromous Streams
 - ▨ Anadromous Areas
 - ▬ AWC Stat Area
 - ▬ Regional Boundary
- Waters important to Anadromous Fish are listed pursuant to AS 16.05.871. Specified species distribution and life functions reflect known data. Actual distribution and use may extend beyond specified limits. Migration upstream and/or downstream is assumed for specified stream reaches.


SPECIES CODES	AC Arctic char	LV river lamprey
CO coho salmon	AL Arctic lamprey	OL longfin smelt
CH chum salmon	AW Arctic cisco	OM rainbow smelt
K chinook salmon (king)	BC brook whitefish	OU eulachon
P pink salmon	BW Bering cisco	PC Pacific lamprey
S sockeye salmon	CT outthroat trout	SF inconnu (sheefish)
	DV Dolly Varden	SH steelhead trout
	CS green sturgeon	SM smelt, undifferentiated
	HW humpback whitefish	ST sturgeon, undifferentiated
	LB western brook lamprey	W whitefish, undifferentiated
	LC least cisco	WS white sturgeon
	LP lamprey, undifferentiated	



Anadromous Waters Atlas
 Quad No. 069 (DIL)
Dillingham
A-7

Produced By
 State of Alaska
 Department of
 Fish and Game

Revision Date 11/28/2008

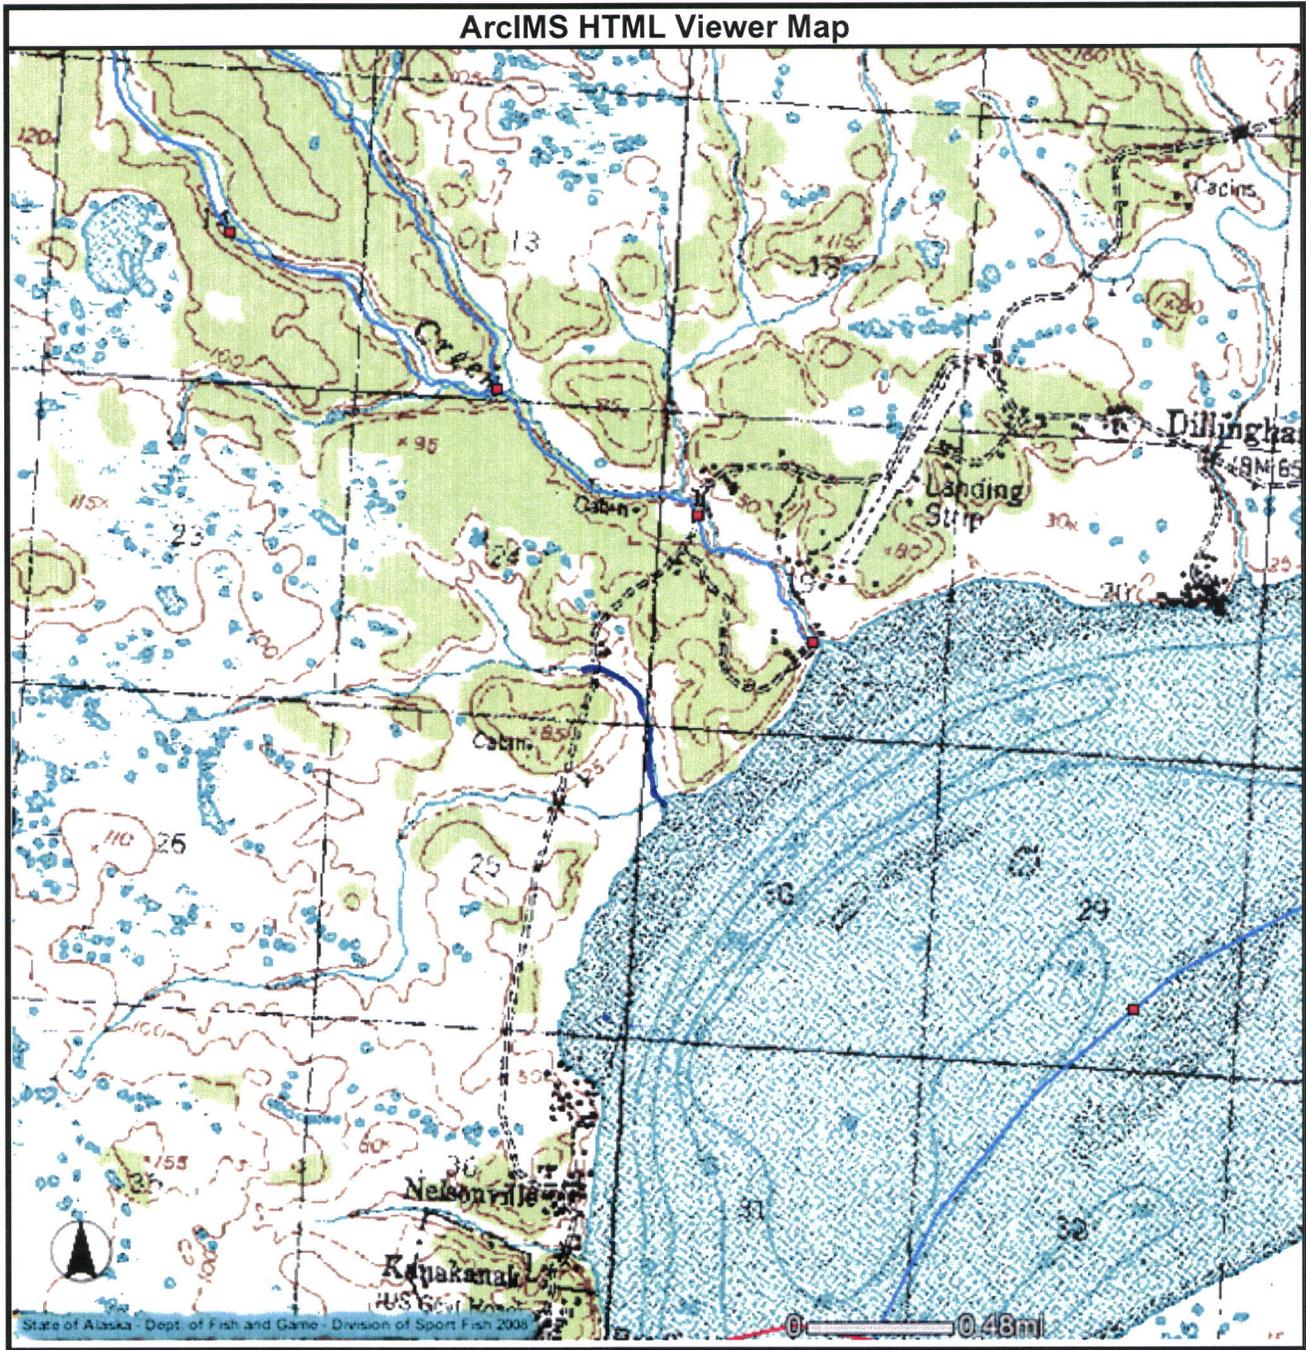

Upper extent of Sampling

Approximately

*59° 1' 50.07" N
158° 32' 10.51" W*

Imagery Date: Apr 27, 2006

59°01'50.78" N 158°32'09.98" W elev 25 ft

© 2010 Europa Technologies
Image © 2010 DigitalGlobe
© 2010 Google

Eye alt 1272 ft



Untitled Placemark



Kanakanak



Dillingham Kakanak Road sampling - September 13 and 14, 2010

Unnamed Stream 1

Species	Fork Length(mm)
Blackfish	70
Blackfish	100
Blackfish	100
Blackfish	105
Blackfish	109
Coho	90
Blackfish	131
Blackfish	115
Blackfish	92
Coho	97

Unnamed Stream 2

Species	Fork Length(mm)
Blackfish	110
Coho	80
Coho	56
Coho	80
Coho	83
Coho	48
Coho	70
Blackfish	70
Coho	65
Coho	47
Coho	65
Coho	66
Chinook	85
Blackfish	75
Coho	53
Blackfish	105
Coho	60
Coho	85


Unnamed Stream 3

Species	Fork Length(mm)
Chinook	79
Chinook	85
Chinook	75
Chinook	78
Chinook	86
Coho	65
Chinook	78
Chinook	69
Chinook	68
Coho	66
Coho	75
Sockeye	64
Sockeye	64
Coho	60

4 adult pink salmon and 1 adult coho salmon were also observed in the stream

Scandinavian Creek


Species	Fork Length(mm)
Chinook	88
Chinook	85
Chinook	81
Coho	64
Chinook	85
Coho	75
Coho	70
Coho	85

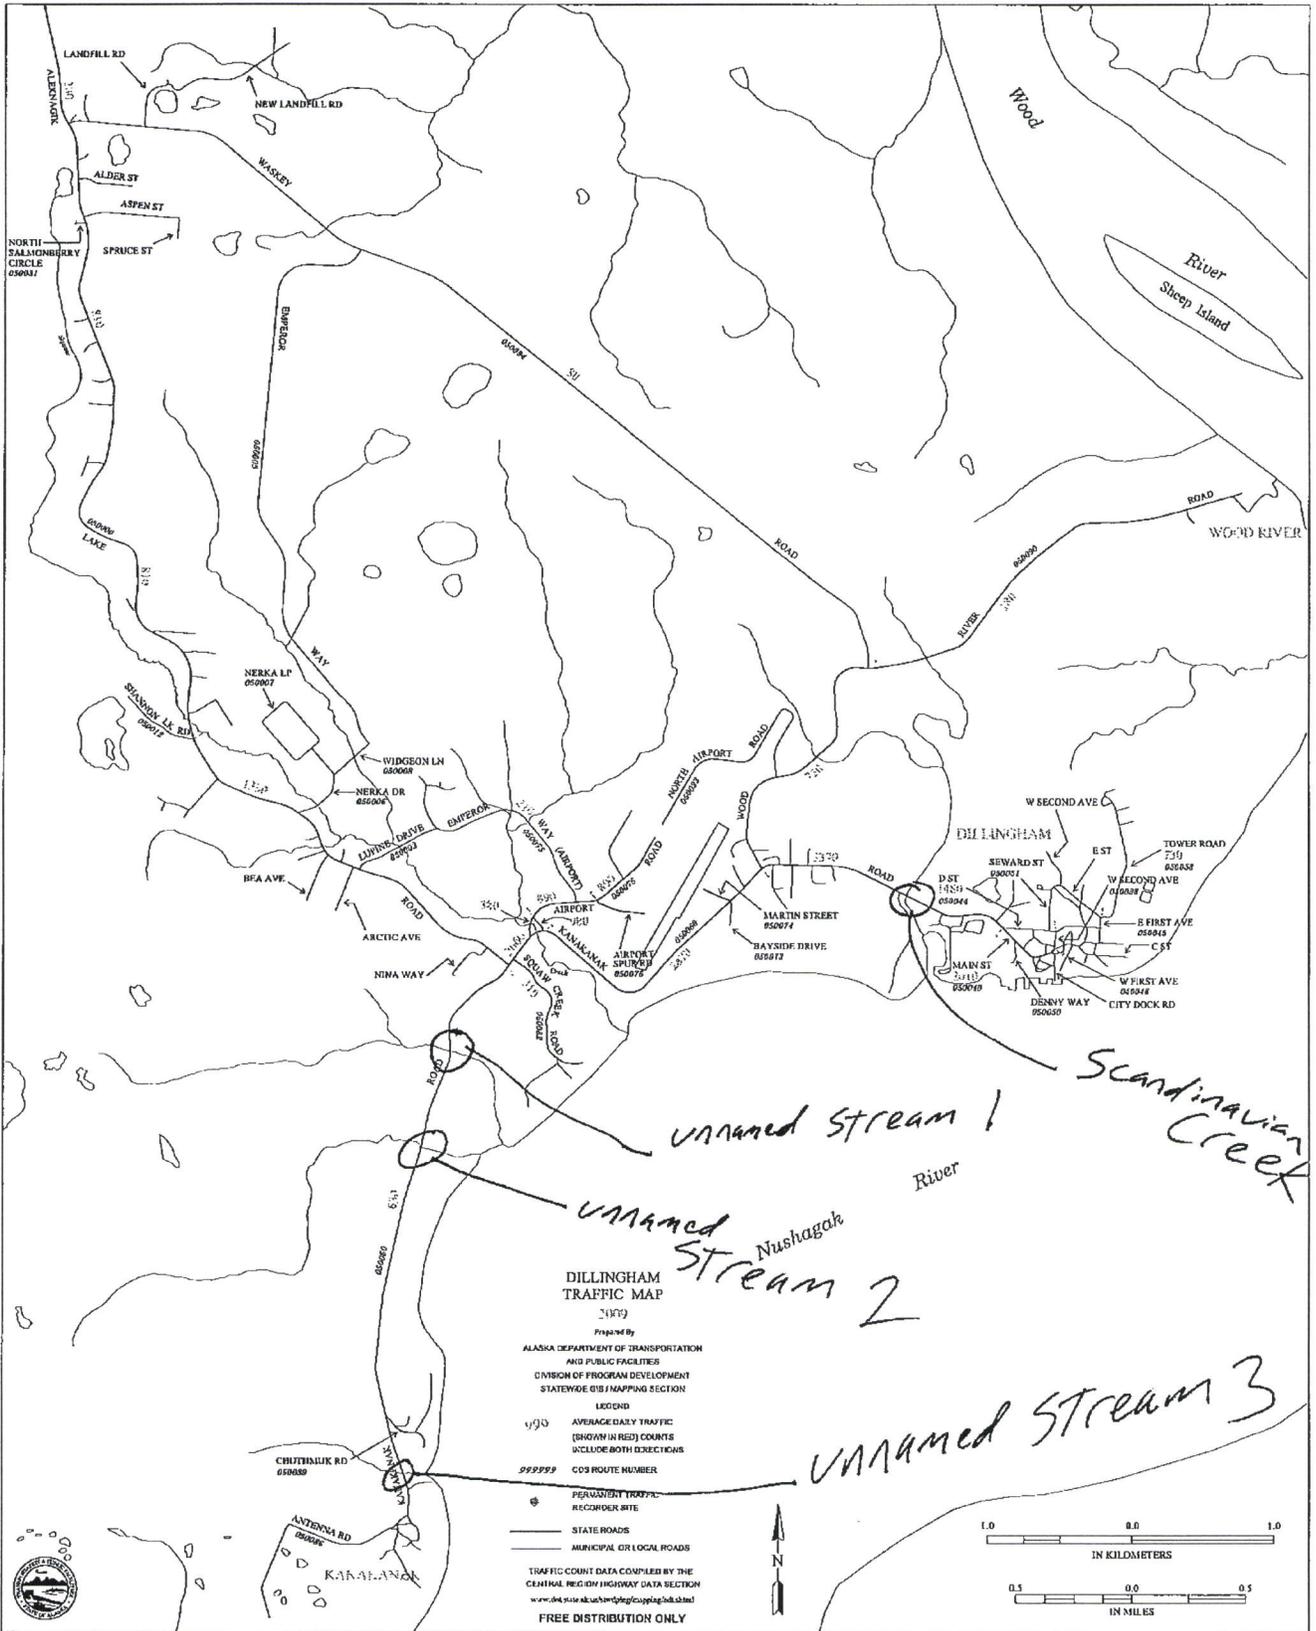

DILLINGHAM TRAFFIC MAP

1979
 Prepared by
 ALASKA DEPARTMENT OF TRANSPORTATION
 AND PUBLIC FACILITIES
 DIVISION OF PROGRAM DEVELOPMENT
 STATEWIDE GIS/MAPPING SECTION


- LEGEND
- 1990 AVERAGE DAILY TRAFFIC (SHOWN IN RED) COUNTS INCLUDE BOTH DIRECTIONS
 - 999999 CO'S ROUTE NUMBER
 - PERMANENT TRAFFIC RECORDER SITE
 - STATE ROADS
 - MUNICIPAL OR LOCAL ROADS
- TRAFFIC COUNT DATA COMPILED BY THE CENTRAL REGION HIGHWAY DATA SECTION
www.adot.state.ak.us/hwydata/central.htm
 FREE DISTRIBUTION ONLY

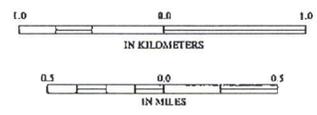

unnamed Stream 1
unnamed Stream 2
unnamed Stream 3
 River
 Scandinavian Creek





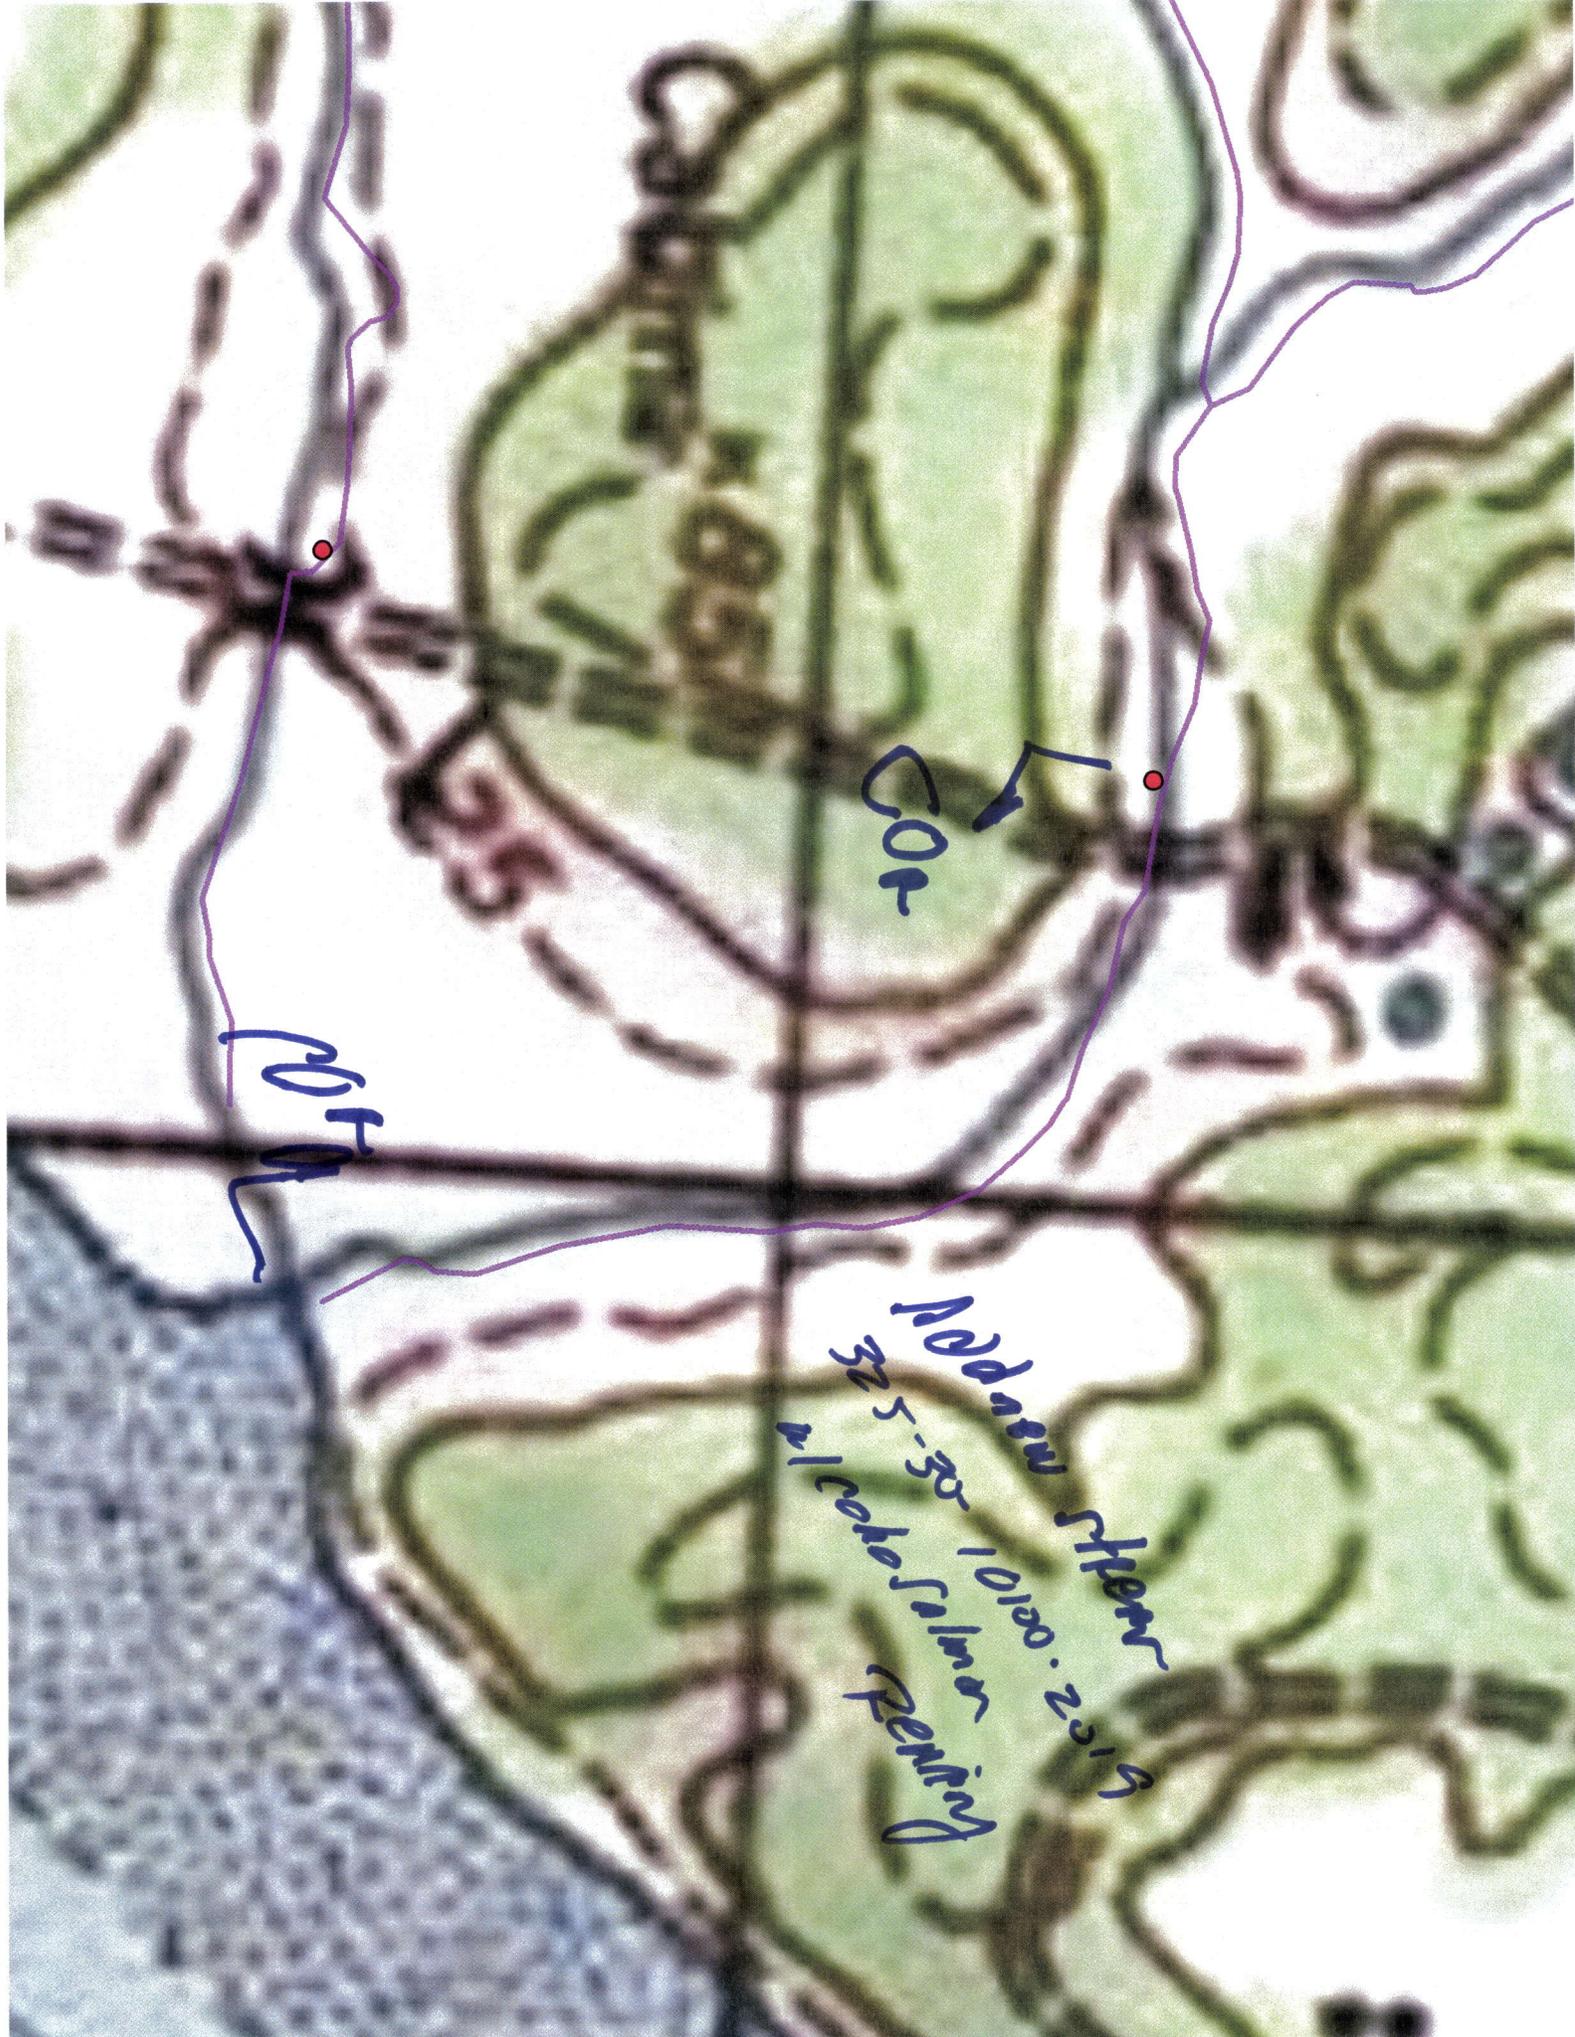

COR

POTA

New Station 91.22.0010 32.5-30