

84-075

*John S. Miller*



ALASKA DEPT. OF FISH & GAME

STATE OF ALASKA  
DEPARTMENT OF FISH AND GAME  
NOMINATION FOR WATERS  
IMPORTANT TO ANADROMOUS SPECIES

OCT 01 1984

REGION IV  
HABITAT DIVISION

ADDITION

DELETION

NAME OF WATERBODY (IF KNOWN) EASTERN CREEK 251-650

LOCATION:

ANADROMOUS WATERS CATALOG VOLUME SW REGION; RESOURCE MGMT. REGION III

USGS 1:63,360 QUADRANGLE AFOGNAK C2 AND C3

OR 1:250,000 (IF 1:63,360 NOT AVAILABLE) \_\_\_\_\_

SPECIES	DATE(S) OBSERVED	STAGE(S) (SPAWNING, REARING, MIGRATION, AND OVERWINTERING)
<u>PINK</u>	<u>9/9/84</u>	<u>MIGRATION, SPAWNING.</u>
<u>COHO</u>	<u>9/9/84</u>	<u>OFF MOUTH ON THIS DATE,</u>
		<u>UNDOUBTEDLY HOMING ON THIS</u>
		<u>SYSTEM.</u>

COMMENTS: PLEASE PROVIDE ANY CLARIFYING INFORMATION IN ADDITION TO IDENTIFICATION ON ANADROMOUS WATERS CATALOG PUBLIC REVIEW MAPS.

FOOT SURVEY OBSERVATIONS.  
Already included


\*THIS FORM MUST BE ACCOMPANIED BY 1:63,360 OR 1:250,000 QUADRANGLE OR COPY OF QUADRANGLE IDENTIFYING KNOWN EXTENT OF SPECIES.

NAME OF OBSERVER (PLEASE PRINT) LARRY MALLOY for MATT COLE / TED STRAK

DATE: 9/26/84 SIGNATURE: Larry Malloy

*Larry Malloy*  
*Ken R. Waples*

*10/26/84*  
*10/84 cp*

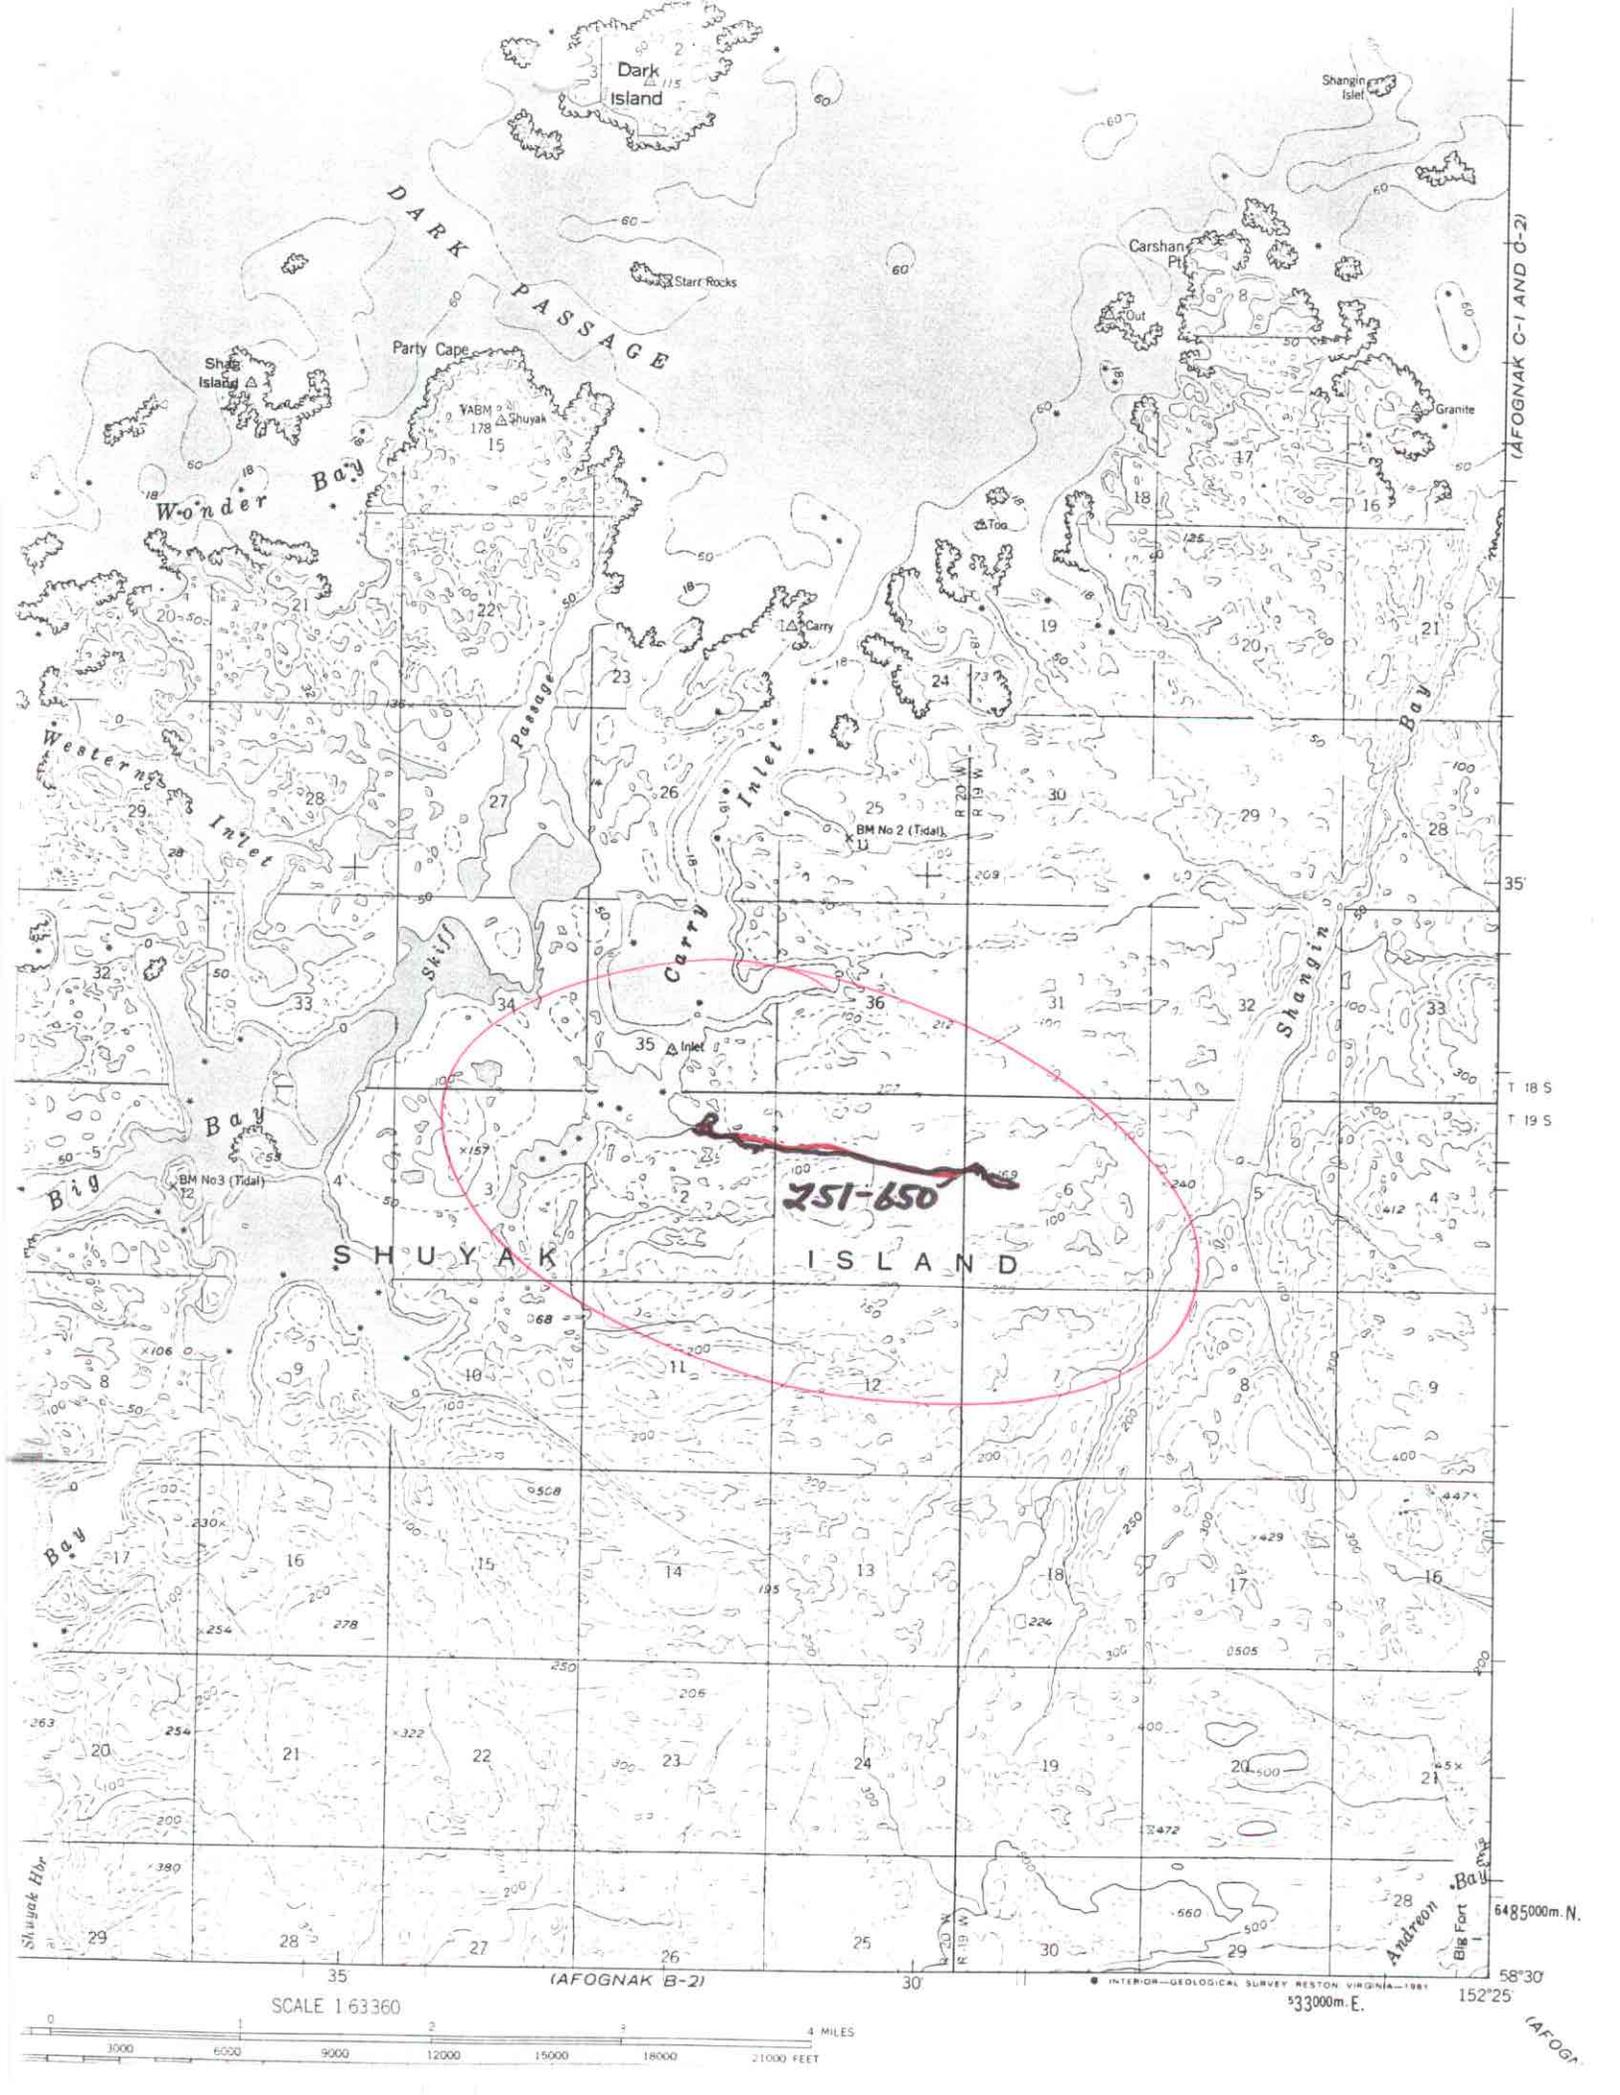

(AFOGNAK C-1 AND C-2)

T 18 S  
T 19 S

6485000m. N.

58°30'

152°25'

(AFOGNAK C-1 AND C-2)

SCALE 1:63360

(AFOGNAK B-2)

INTERIOR GEOLOGICAL SURVEY RESTON, VIRGINIA—1981

533000m. E.

