FISH DISTRIBUTION DATABASE CATALOG/ATLAS
CORRECTION FORM

CORRECTION TO: Atlas X Catalog X

Region: ARC

Map: BEECHEY POINT ~~B-3~~ B-3

Water Body Number: 330-00-10415

Describe Change(s): Change species code for whitefish ~~presence~~ reading from Wr to BCr (broad whitefish) and add end point for LCr (least cisco) and AWr (Arctic cisco)

Change Requested By: J. Johnson 5/22/2007 Date

Drafted/Digitized By: [signature] 5/18/08 Date

Revision Code: E-7

Nomination Number: 08-005

**ATTACH THIS FORM TO EXISTING NOMINATION FORM**

(Rev 05/07)

State of Alaska
Department of Fish and Game
Nomination for Waters
Important to Anadromous Fish

Region: ARCTIC

USGS Quad: BEECHEY POINT B-3

Anadromous Water Catalog Number of Waterway: 330-00-10415

Name of Waterway: PUTULIGAYUK

☒ USGS Name ☐ Local Nam

☒ Addition ☐ Deletion ☐ Correction ☐ Backup Information

For Office Use

| | | | |
|---|---|---|---|
| Nomination # | 97 043 | | |
| Revision Year: | | | |
| Revision to: | Atlas ____ Catalog ____ Both ____ | Regional Supervisor OKLLT | 12-4-96 Date |
| Revision Code: | B1 | AWC Project Biologist | 2/11/97 Date |
| | | Drafted | 12/2/97 Date |

OBSERVATION INFORMATION

| Species | Date(s) Observed | Spawning | Rearing | Present | Anadromous |
|---|---|---|---|---|---|
| ARCTIC CISCO | 1993 | | X | | ☒ |
| LEAST CISCO | 1993 | | X | | ☒ |
| RAINBOW SMELT | 1993 | | X | | ☒ |
| | | | | | ☐ |
| | | | | | ☐ |

**IMPORTANT**: Provide all supporting documentation that this water body is important for the spawning, rearing or migration of anadromous fish, including: number of fish and life stages observed; sampling methods, sampling duration and area sampled; copies of field notes; etc. Attach a copy of a map showing location of mouth and observed upper extent of each species, as well as other information such as: specific stream reaches observed as spawning or rearing habitat; locations, types, and heights of any barriers; etc.

Comments:

ATTACHED: TECHNICAL REPORT 95-3
BY CARL R. HEMMING

ALASKA DEPT. OF FISH & GAME

Name of Observer (please print): CARL HEMMING

Date: 12-4-96 Signature: Carl Hemming

Address: 1300 COLLEGE ROAD
FAIRBANKS, AK 99709

DEC 06 1996
REGION II
HABITAT AND RESTORATION DIVISION

This certifies that in my best professional judgment and belief the above information is evidence that this waterbody should be included in or deleted from the Catalog of Waters Important for Spawning, Rearing or Migration of Anadromous Fishes per AS 16.05.870.

Signature of Area Biologist: Carl Hemming

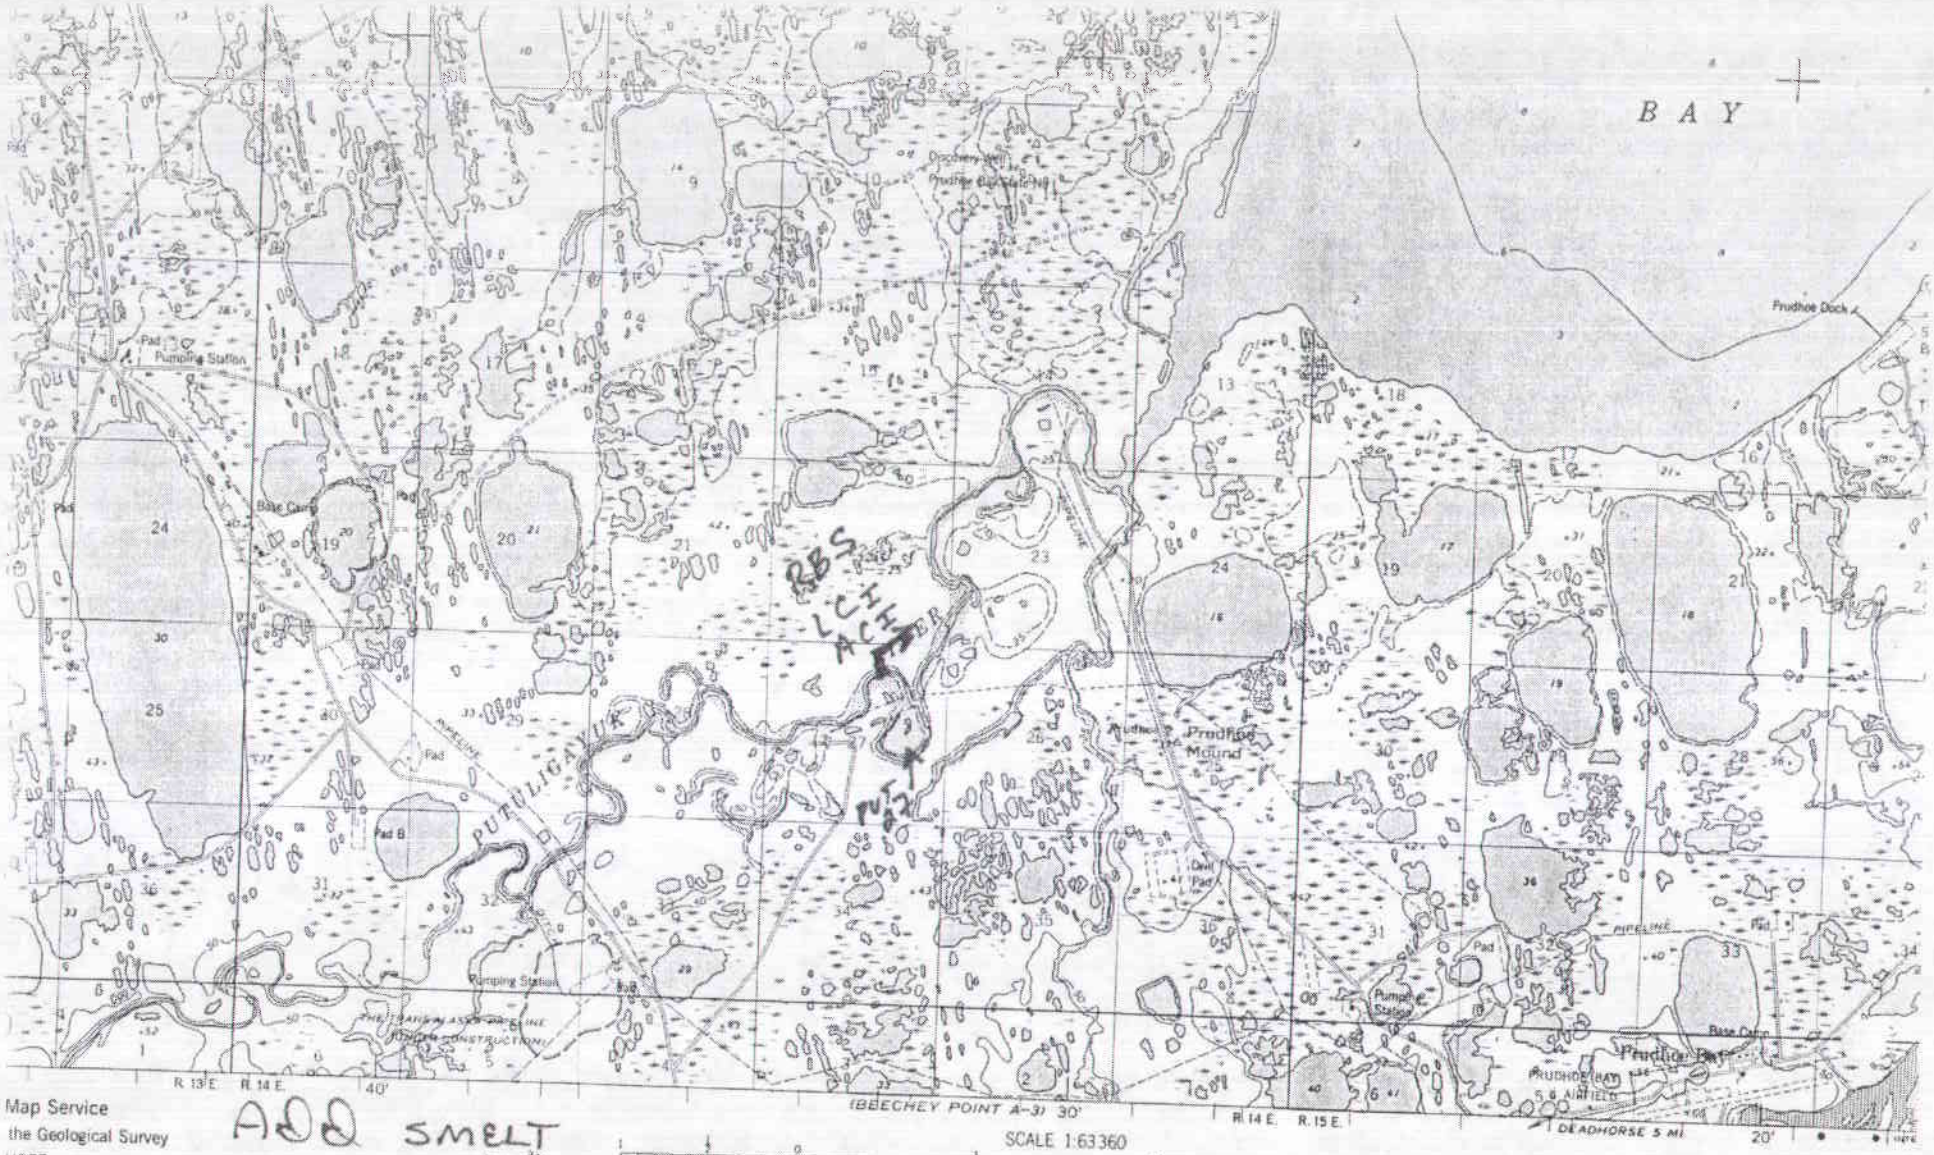


Map Service
the Geological Survey
USCE
imetric methods from aerial photographs
ted 1955. Map not field checked
ta compiled from USC&GS
is information is not intended

cator projection, 1927 North American datum
sed on Alaska coordinate system, zone 6
nsverse Mercator grid ticks,

unsurveyed and unmarked locations
reau of Land Management
n
cked

ADD SMELT STREAM
330-00-10415

APPROXIMATE MEAN DECLINATION, 1975

BEECHY POINT B-3

SCALE 1:63360

CONTOUR INTERVAL 50 FEET
DASHED LINES REPRESENT 25-FOOT CONTOURS
NATIONAL GEODETIC VERTICAL DATUM OF 1929
DEPTH CURVES AND SOUNDINGS IN FEET—DATUM IS MEAN LOWER LOW WATER
SHORELINE SHOWN REPRESENTS THE APPROXIMATE LINE OF MEAN HIGH WATER
THE MEAN RANGE OF TIDE IS APPROXIMATELY 0.5 OF A FOOT

FOR SALE BY U. S. GEOLOGICAL SURVEY
FAIRBANKS, ALASKA 99701, DENVER, COLORADO 80225, OR RESTON, VIRGINIA 22092
A FOLDER DESCRIBING TOPOGRAPHIC MAPS AND SYMBOLS IS AVAILABLE ON REQUEST

ALASKA
QUADRANGLE LOCATION

Revisions shown in purple compiled from aerial photographs taken 1975. This information not field checked

State of Alaska
Department of Fish and Game
Nomination for Waters
Important to Anadromous Fish

Region: ARCTIC ⬇ USGS Quad: BEECHY POINT B-3

Anadromous Water Catalog Number of Waterway: 330-00-10415

Name of Waterway: PUTULIGAYUK RIVER ☐ USGS Name ☐ Local Nam

☒ Addition ☐ Deletion ☒ Correction ☒ Backup Information

For Office Use

| | | | |
|---|---|---|---|
| Nomination #: 97 044 | | | |
| Revision Year: | | | |
| Revision to: Atlas X Catalog | | Regional Supervisor OKLLH | Date 12-4-96 |
| Both X | | AWC Project Biologist | Date 2/10/97 |
| Revision Code: E-7 A-1 | | Drafted | Date 12/2/97 |

OBSERVATION INFORMATION

| Species | Date(s) Observed | Spawning | Rearing | Present | Anadromous |
|---|---|---|---|---|---|
| BROAD WHITEFISH | 6-27-96 | | X | | ☒ |
| DOLLY VARDEN | 6-28-96 | | X | | ☒ |
| | | | | | ☐ |
| | | | | | ☐ |
| | | | | | ☐ |

**IMPORTANT**: Provide all supporting documentation that this water body is important for the spawning, rearing or migration of anadromous fish, including: number of fish and life stages observed; sampling methods, sampling duration and area sampled; copies of field notes; etc. Attach a copy of a map showing location of mouth and observed upper extent of each species, as well as other information such as: specific stream reaches observed as spawning or rearing habitat; locations, types, and heights of any barriers; etc.

Comments:
PLEASE CHANGE AC TO DU (DOLLY VARDEN) .*
TRIP REPORT W/DATA ATTACHED

ALASKA DEPT. OF FISH & GAME
DEC
REGION II
HABITAT AND RESTORATION DIVISION

Name of Observer (please print): CARL HEMMING
Date: 12-4-96 Signature: Carl Hemming
Address: 1300 COLLEGE ROAD
FAIRBANKS, ALASKA 99709

This certifies that in my best professional judgment and belief the above information is evidence that this waterbody should be included in or deleted from the Catalog of Waters Important for Spawning, Rearing or Migration of Anadromous Fishes per AS 16.05.870.

Signature of Area Biologist: Carl Hemming

Revision 11/95

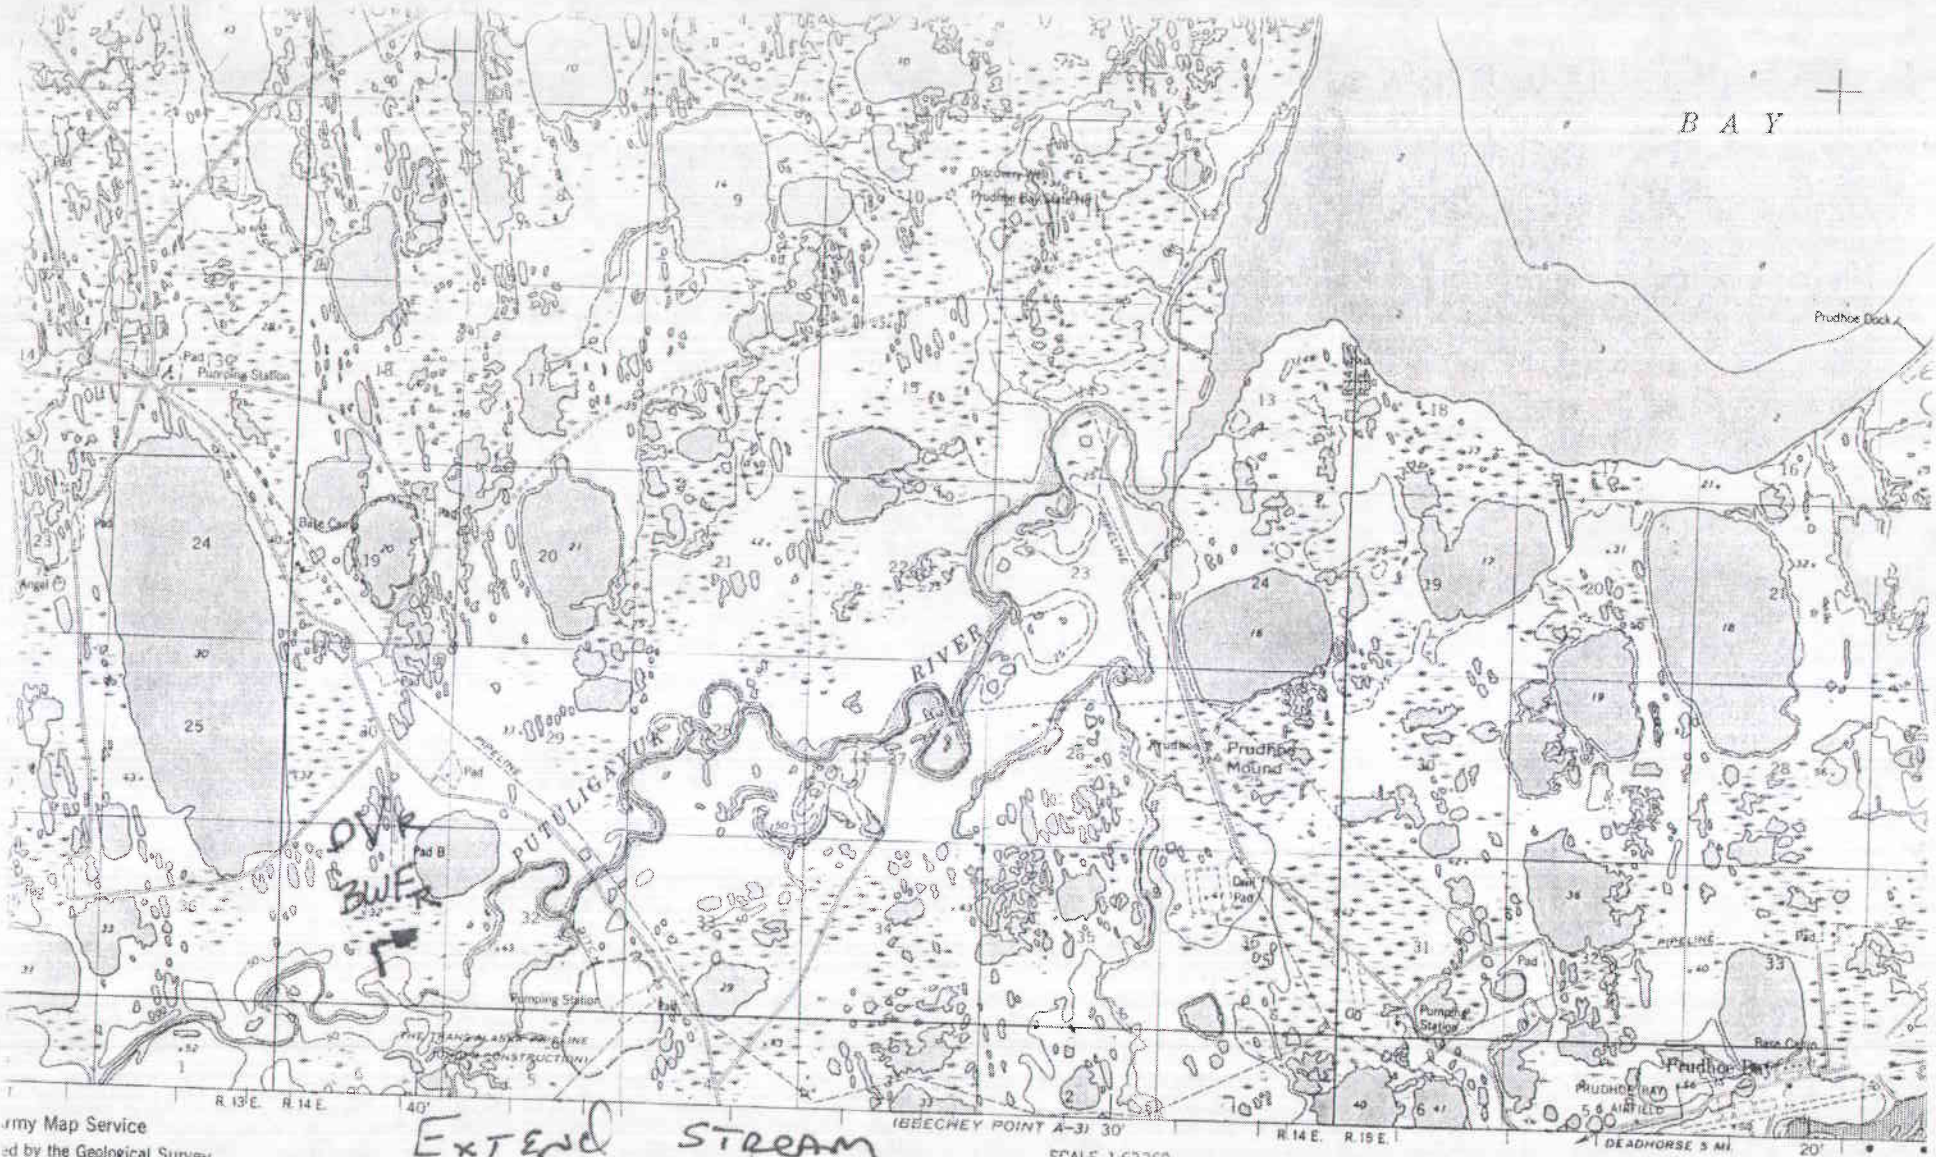


rmy Map Service

ed by the Geological Survey

and USCE

ogrammetric methods from aerial photographs
nnotated 1955. Map not field checked

ic date compiled from USC&GS
This information is not intended
poses

Mercator projection, 1927 North American datum
ks based on Alaska coordinate system, zone 5
al Transverse Mercator grid ticks,
ue

esent unsurveyed and unmarked locations
e Bureau of Land Management
eridian

unchecked

Revisions shown in purple compiled from aerial photographs taken 1975. This information not field checked

Department of Fish and Game
Nomination for Waters
Important to Anadromous Species

1988
Year of Revision

88 31

Approved

Regional Supervisor — 8-19-88 Date

[illegible] — 11/3/88

FI — 10/12/88
Drafted

ALASKA DEPT. OF FISH & GAME
AUG 24 1988
REGION II
HABITAT DIVISION

Name of Waterway Putuligayuk River

AWC# of Waterway None 330-00-10415

AWC Volume & Number

USGS Quad Beechey Point B-3 T11N, R14E, Sec 27

Addition X
Deletion

Correction
Change

Change to
Atlas
Catalog
X Both

| Species | Date(s) Observed | Spawning | Rearing | Migration |
|---|---|---|---|---|
| arctic char | 7/28; 7/29; 7/30 | | X | |
| broad whitefish | 7/28; 7/29; 7/30 | | X | |
| | | | | |
| | | | | |

Comments: Provide any clarifying information, including number of fish observed, location of fish survey data, etc.

net sites approximately 200 and 600 m downstream of drill site 15 road crossing

7/28 - 1 arctic char (203 mm); 1 broad whitefish (82 mm)

7/29 2 arctic char (233; 201 mm); 3 broad whitefish (122; 93; 88 mm)

7/30 3 arctic char (191; 200; 203 mm); 1 broad whitefish (96 mm)

Attach a copy of a map showing location of mouth and upper points of each species, specific stream reaches identified for spawning or rearing, locations of barriers, such as falls. Attach a copy of the fish survey data, if available.

Name of Observer (please print) Jack F Winters / Roger A Post

Date: 8/16/88

Signature: Jack F. Winters / Roger A. Post

Address: Habitat Division
1300 College Rd
Fairbanks, Alaska 99701

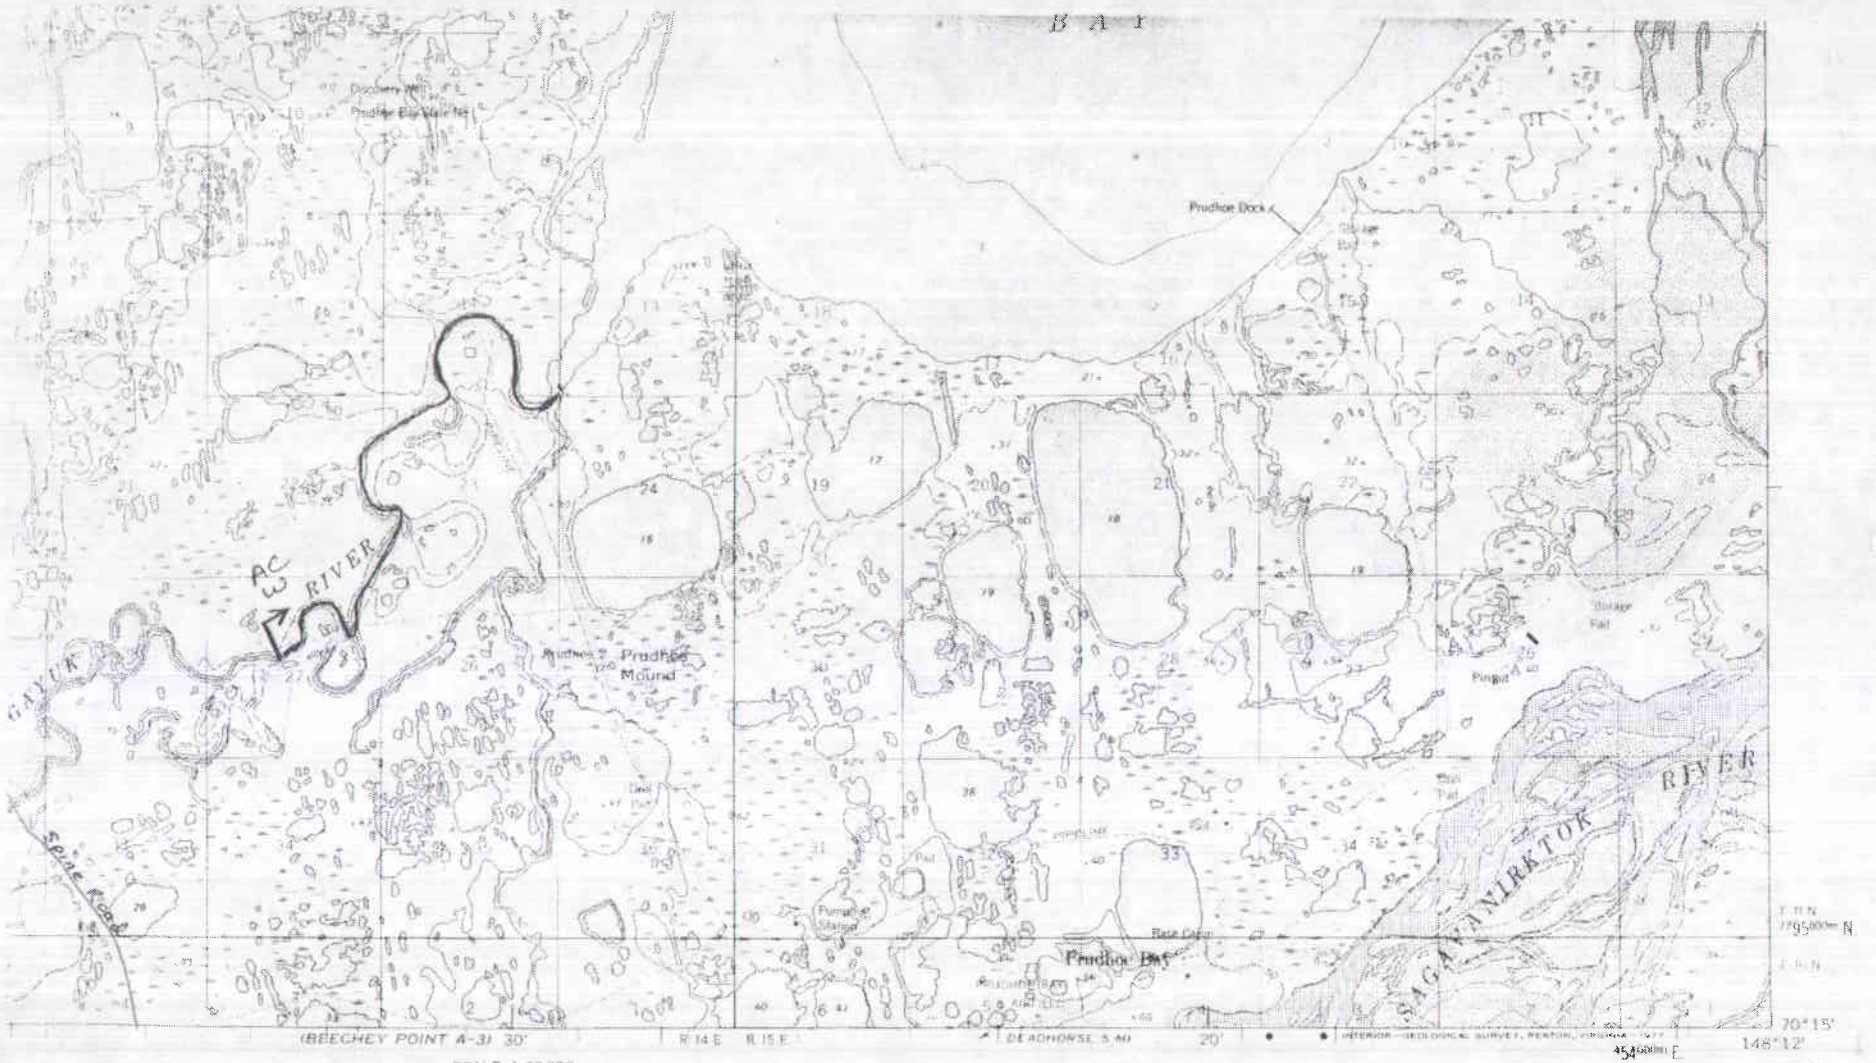


SCALE 1:63,360

4 MILES
21000 FEET
5 KILOMETERS

CONTOUR INTERVAL 50 FEET
DASHED LINES REPRESENT 25-FOOT CONTOURS
NATIONAL GEODETIC VERTICAL DATUM OF 1929
DEPTH CURVES AND SOUNDINGS IN FEET—DATUM IS MEAN LOWER LOW WATER
SHORELINE SHOWN REPRESENTS THE APPROXIMATE LINE OF MEAN HIGH WATER
THE MEAN RANGE OF TIDE IS APPROXIMATELY 0.5 OF A FOOT

FOR SALE BY U. S. GEOLOGICAL SURVEY
FAIRBANKS, ALASKA 99701, DENVER, COLORADO 80225, OR RESTON, VIRGINIA 22092
A FOLDER DESCRIBING TOPOGRAPHIC MAPS AND SYMBOLS IS AVAILABLE ON REQUEST

QUADRANGLE LOCATION

ROAD CLASSIFICATION

Light duty ——— Unimproved dirt - - - - -

# BEECHEY POINT (B-3), ALASKA

N7015—W14812/15 X 36

1955
PHOTOREVISED 1975

Revisions shown in purple compiled from aerial photographs taken 1975. This information not field checked

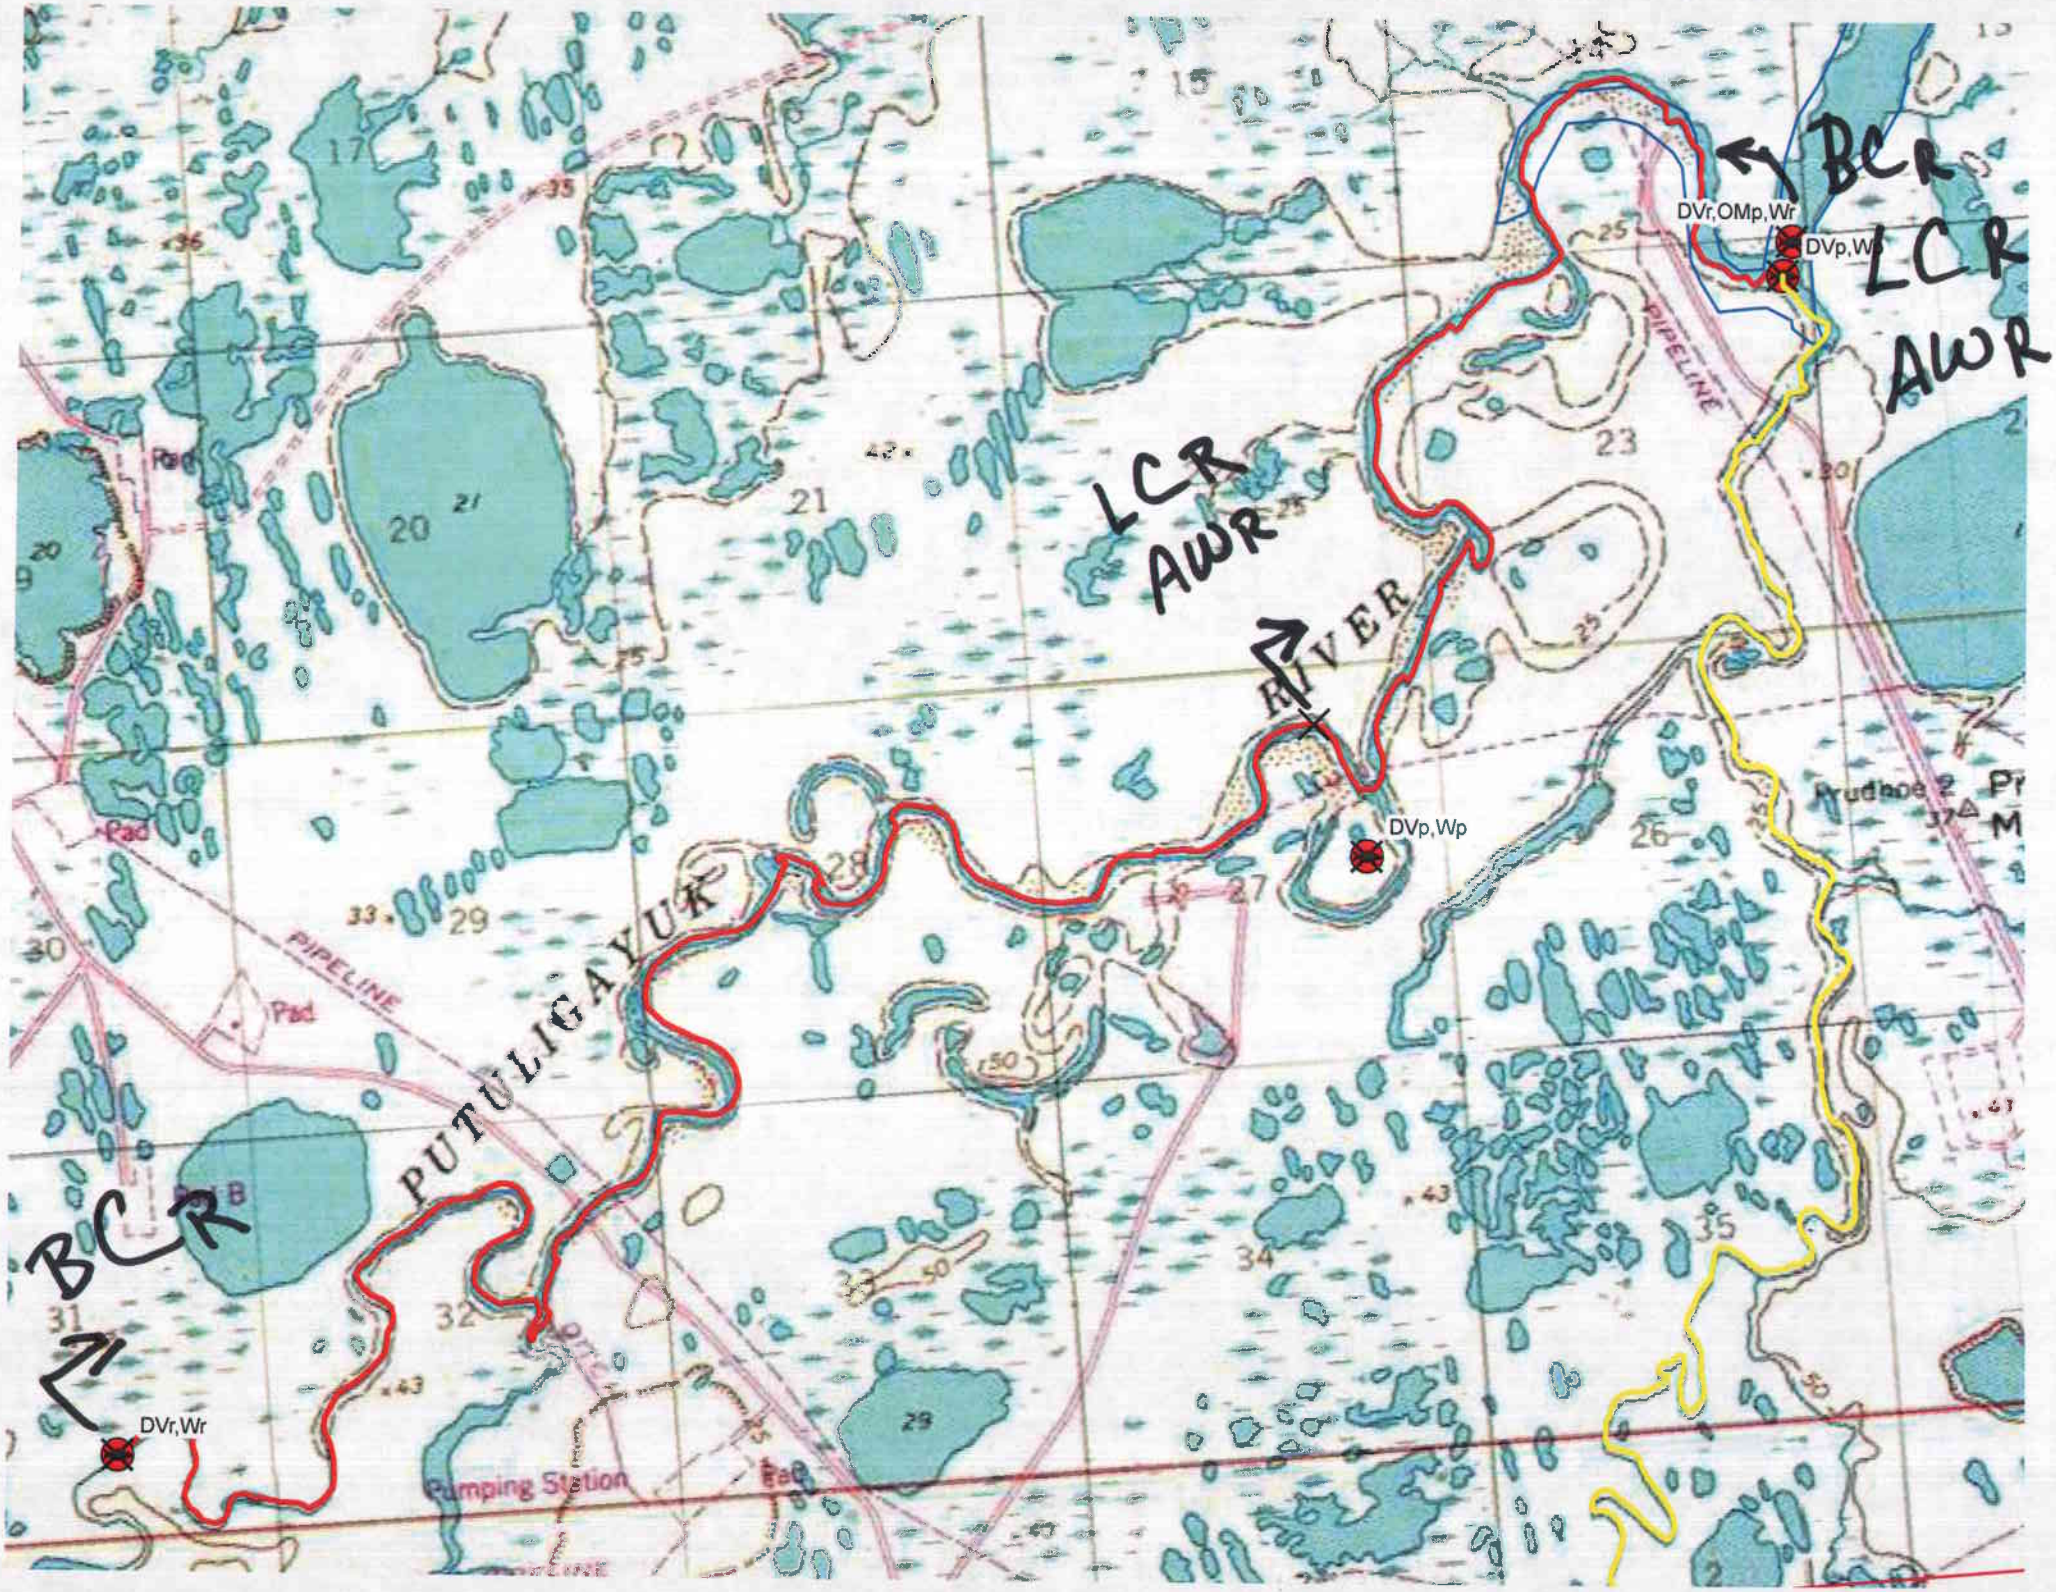
BCR
LCR
AWR
DVr,OMp,Wr
DVp,Wp
LCR
AWR
RIVER
DVp,Wp
PUTULIGAYUK
PIPELINE
Pad
BCR
DVr,Wr
Pumping Station
Pad
PIPELINE
Prudhoe 2