83-1363

State of Alaska
Department of Fish and Game
Public Review Nomination for Waters
Important to Anadromous Species

☒ Addition ☐ Deletion

Name of Waterbody (if known): Tenderfoot Creek
334-40-11000-2490-3373

Location:

Anadromous Waters Catalog Volume and Number _____

USGS 1:63,360 Quadrangle Big Delta B-5, NE¼ of Sec 5, T8S R8E

or 1:250,000 (if 1:63,360 not available) _____

Species	Date(s) Observed	Stage(s) (Spawning, Rearing, Migration)
Coho Salmon	5/30/79	Rearing

Comments: Please provide any clarifying information in addition to identification on Anadromous Waters Catalog Public Review Maps.

8 Coho were caught in minnow traps along with 4 chubs and 2 suckers. Sets were made within ¼ mile of mouth. Numerous unidentified fry were observed in same area on 5/20/79. Rearing habitat most likely limited to section of creek below Richardson Hwy. crossing since presently (1982) a beaver dam at culvert is most likely a barrier.

Name of Observer (please print) WILLIAM RIDDER

Date: 1/4/83 Signature: W. P. Ridder

Address: ADF&G
Box 605
Delta Jct., AK. 99737

Drafted 2/8/83 T. A. [illegible]

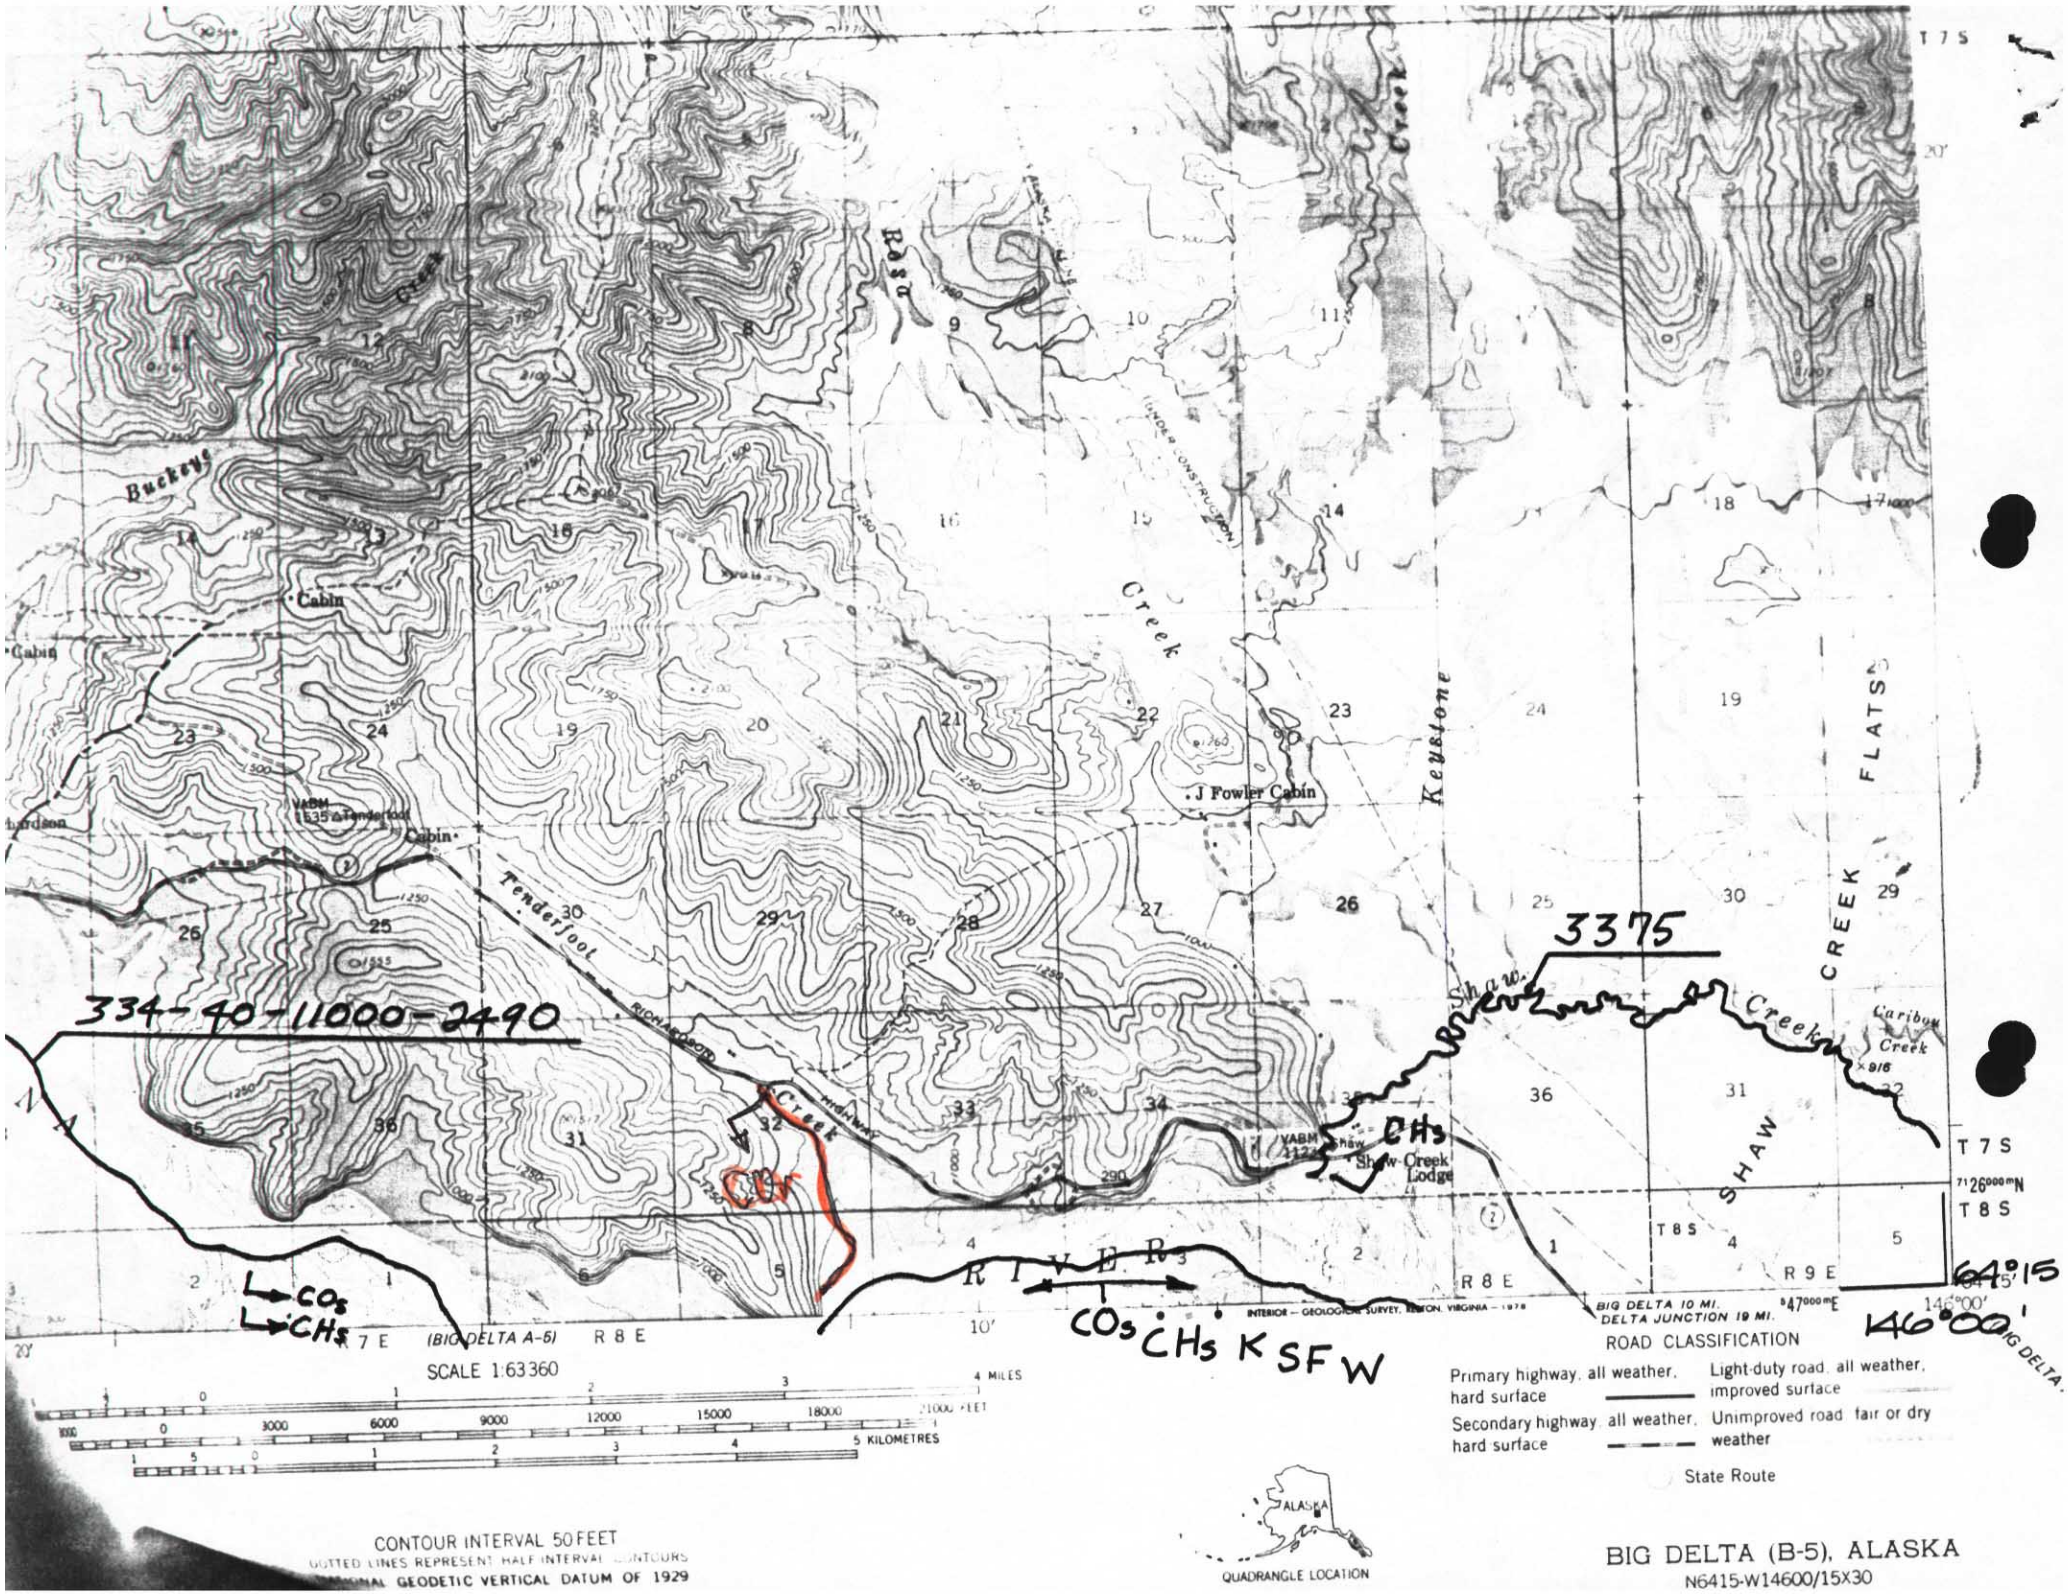

334-40-11000-2490
3375
Buckeye
Cabin
Tenderfoot
Creek
Rosa
Creek
Keystone
J Fowler Cabin
Shaw
Creek
Caribou Creek
SHAW CREEK FLATS
Shaw Creek Lodge
RIVER
CHs
COs
CHs
COs CHs K SF W
T 7 S
T 8 S
R 8 E
R 9 E
R 7 E
(BIG DELTA A-5)
BIG DELTA 10 MI.
DELTA JUNCTION 19 MI.
INTERIOR — GEOLOGICAL SURVEY, RESTON, VIRGINIA — 1978
64°15'
146°00'
SCALE 1:63360
4 MILES
21000 FEET
5 KILOMETRES
CONTOUR INTERVAL 50 FEET
DOTTED LINES REPRESENT HALF INTERVAL CONTOURS
NATIONAL GEODETIC VERTICAL DATUM OF 1929
ROAD CLASSIFICATION
Primary highway, all weather, hard surface
Light-duty road, all weather, improved surface
Secondary highway, all weather, hard surface
Unimproved road, fair or dry weather
State Route
ALASKA
QUADRANGLE LOCATION
BIG DELTA (B-5), ALASKA
N6415-W14600/15X30