Department of Fish and Game
Nomination for Waters
Important to Anadromous Fish

SEP 10 19

REGION II
HABITAT DIVI

AWC Volume SE SC SW W AR (IN) USGS Quad (125) Wiseman (B-1), Alaska

334-40-11000-2125-3912

Anadromous Water Catalog Number of Waterway Drains into Middle Fork Koyukuk R.

Name of Waterway ~~Marion Creek~~ MIDDLE FORK KOYUKUK RIVER USGS name X Local name X

Addition X Deletion ___ Correction ___ Backup Information ___

For Office Use

Nomination # ~~93 031~~ 93 031

Revision Year: ___

Revision to: Atlas ___ Catalog ___

Both ___

Revision Code: ___

Regional Supervisor — Date: 10/28/92

Ed Weiss — 1/26/93

Drafted — Date: 11/5/92

OBSERVATION INFORMATION

Species	Date(s) Observed	Spawning	Rearing	Migration	Anadromous
Chinook salmon	8-6-92	No	Yes	Yes	Yes
chum salmon	8-6-92	Yes	No	Yes	Yes

Provide any clarifying information, including number of fish observed, location of fish survey data, etc. Attach a copy of the fish survey data, if available. Attach a copy of a map showing location of mouth and upper points of each species, specific stream reaches identified for spawning or rearing, locations of barriers, such as falls.

Comments:

On 8-6-92, while electroshocking, I observed one adult chum salmon in Marion Creek near the Trans Alaska Pipeline stream crossing. This is approx. 250-300 yards upstream of the confluence with the Middle Fork Koyukuk R. I also ~~shock~~ shocked one king salmon juvenile approx. 50 yards from the confluence. This is also consistent with BLM's "Open File

Name of Observer (please print) Frederick M. Thompson

Date: 9/8/92 Signature: Frederick M. Thompson

Address: 411 W. 4th Ave. Suite 2C
Anchorage, Ak. 99501

Signature of Area Biologist: ___

Rev. 12/91

report - TAPS Fish Streams" which identifies Marion Crk. as supporting king salmon.

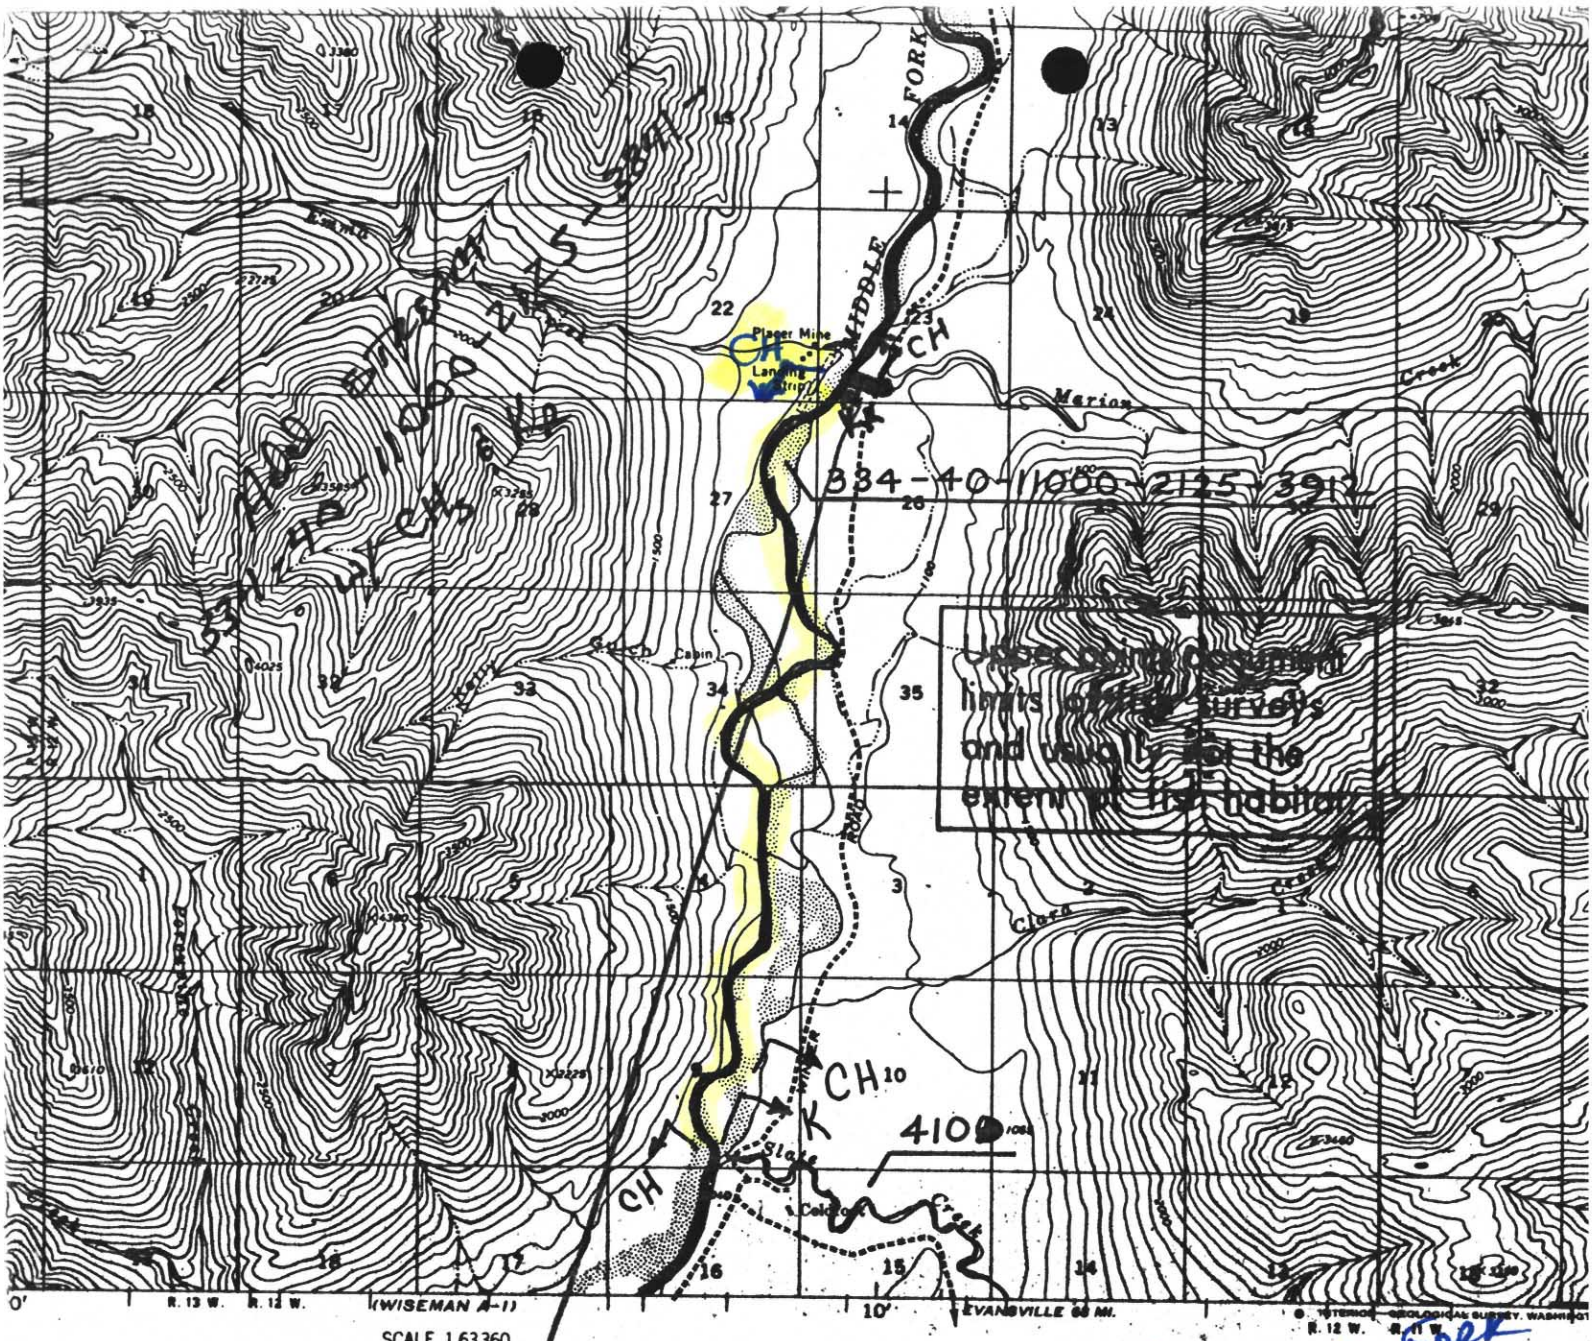

EXTENDS CH IN MIDDLE FORK KOYUKUK PER NOMINATION FOR MARION CK

WISEMAN (B-
N6715—W1500
1971

upper reach of Salmon observed in 1992 was the pipeline crossing.
Mike Thompson

AWC63

PROJ. TITLE.

ANADROMOUS WATERS CATALOG

ANADROMOUS WATERS ARE LISTED PURSUANT TO AS 16.05.870 (a)

ALASKA DEPARTMENT OF FISH AND GAME

State of Alaska
Department of Fish and Game
Nomination for Waters
Important to Anadromous Fish

FISH & GAM

SEP 10 19

REGION II
HABITAT DIVIS

AWC Volume SE SC SW W AR (IN) USGS Quad (125) Wiseman (B-1), Alaska

334-40-11000-2125-3912-4112

Anadromous Water Catalog Number of Waterway Drains into Middle Fork Koyukuk R.

Name of Waterway Marion Creek USGS name X Local name X

Addition X Deletion ___ Correction ___ Backup Information ___

For Office Use

Nomination # 93 031 93 031

Revision Year: ___

Revision to: Atlas ___ Catalog ___ Both ___

Revision Code: ___

Philip A. Brna — Regional Supervisor — 10/28/92 Date

Ed Weiss — 1/26/93

L. Drone — Drafted — 11/5/92 Date

OBSERVATION INFORMATION

Species	Date(s) Observed	Spawning	Rearing	Migration	Anadromous
Chinook salmon	8-6-92	No	Yes	Yes	Yes
chum salmon	8-6-92	Yes	No	Yes	Yes

Provide any clarifying information, including number of fish observed, location of fish survey data, etc. Attach a copy of the fish survey data, if available. Attach a copy of a map showing location of mouth and upper points of each species, specific stream reaches identified for spawning or rearing, locations of barriers, such as falls.

Comments:

On 8-6-92, while electroshocking, I observed one adult chum salmon in Marion Creek near the Trans Alaska Pipeline stream crossing. This is approx. 250-300 yards upstream of the confluence with the Middle Fork Koyukuk R. I also ~~Sobac~~ shocked one king salmon juvenile approx. 50 yards from the confluence. This is also consistent with BLM's "Open File

Name of Observer (please print) Frederick M. Thompson

Date: 9/8/92 Signature: Frederick M. Thompson

Address: 411 W. 4th Ave. Suite 2C
Anchorage, Ak. 99501

Signature of Area Biologist: ___

Rev. 12/91

report - TAPS Fish Streams" which identifies Marion Crk.

4128

4123

Wiseman

Landing Strip

Kr

Cabin

Creek

RIVER

KOYUKUK

MIDDLE FORK

WINTER TRAIL

ROAD

Placer Mine

Landing Strip

Marion Creek

Mouse Creek

Slate Creek

Colorado Creek

Evansville 68 mi.

(CHANDALAR B-6)

(CHANDALAR A-6)

(WISEMAN A-1)

T. 30 N.

T. 29 N.

T. 28 N.

R. 13 W. R. 12 W. R. 11 W.

20'

10'

67°15'

150°00'

7463000m.N.

629000m.E.

334-40-11000-2125-3912

334-42-11000-2125-3912

CH

CH 10

4100

Upper points documented limits of field surveys and usually not the extent of fish habitat

upper reach of Salmon observed in 1992. was the pipeline crossing.

Mike Thompson

SCALE 1:63360

4 MILES

0 1 2 3

3000 0 3000 6000 9000 12000 15000 18000 21000 FEET

1.5 0 1 2 3 4 5 KILOMETERS

CONTOUR INTERVAL 100 FEET

DATUM IS MEAN SEA LEVEL

MAGNETIC NORTH

ROAD CLASSIFICATION

Unimproved dirt ---------

ALASKA

QUADRANGLE LOCATION

WISEMAN (B-1), ALASKA

N6715—W150000/15 X 30

1971

AWC63 12521 WISE B-1

N

SCALE:
1" = 1 MILE
1 : 63,360

PROJ. TITLE.

ANADROMOUS WATERS CATALOG

ANADROMOUS WATERS ARE LISTED PURSUANT TO AS 16.05.870 (a)

MAP TITLE

WISEMAN B-1

STATE OF ALASKA
DEPARTMENT OF FISH AND GAME
habitat protection division
JUNEAU, ALASKA

BY
BB
SJS
EWW
REVISI