83-006

State of Alaska
Department of Fish and Game
Public Review Nomination for Waters
Important to Anadromous Species

[X] Addition [ ] Deletion

Name of Waterbody (if known): Rabbit Creek

Location:

Anadromous Waters Catalog Volume and Number _____

USGS 1:63,360 Quadrangle Anchorage A-8 of 58

or 1:250,000 (if 1:63,360 not available) _____

Species	Date(s) Observed	Stage(s) (Spawning, Rearing, Migration)
COHO	Summer 82	Spawning / Rearing
Pink	" "	Spawning
King	" "	Spawning/rearing

Comments: Please provide any clarifying information in addition to identification on Anadromous Waters Catalog Public Review Maps.

1st order number (247-60-10320) should go to Rabbit Creek. Little Rabbit Creek is a tributary to Rabbit Creek.

Name of Observer (please print) _____

Date: 12/27/82 Signature: Philip J. Brna

Address: ADF&G
Anchorage

Drafted 12/29/82 - T.D.

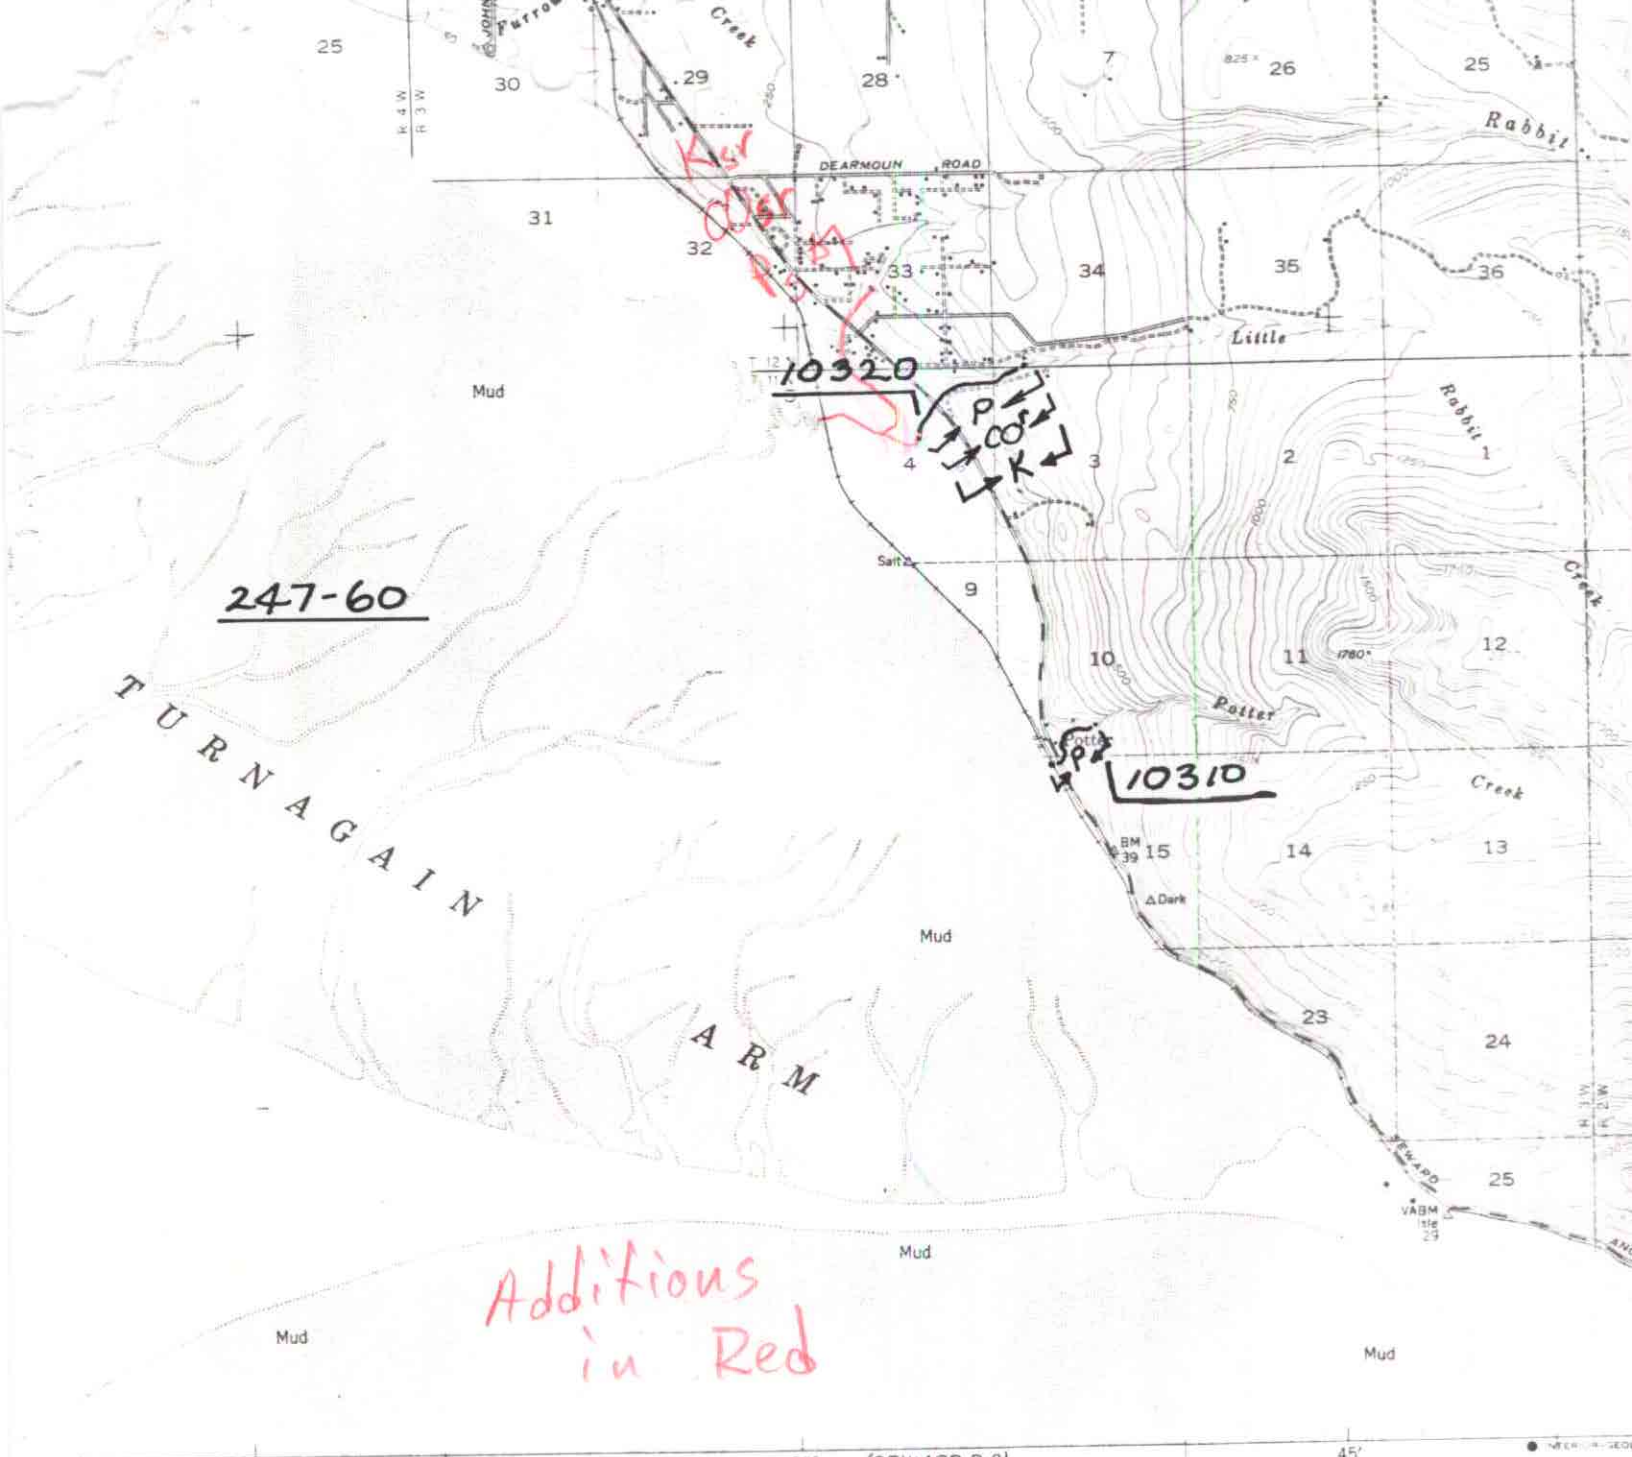

e Geological Survey

from aerial photographs

USC & GS Charts 8557
mation is not intended

1927 North American datum
nate system, zone 4
or grid ticks,

ndmark buildings are shown

rveyed and
Bureau of
Meridian

wetter areas,
aerial photographs

APPROXIMATE MEAN DECLINATION, 1952

SCALE 1:63360

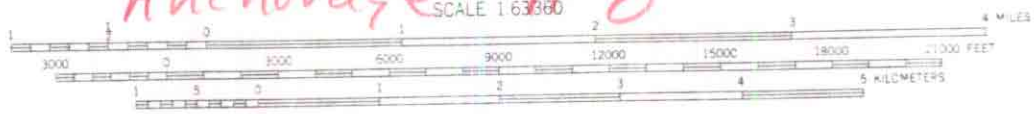

CONTOUR INTERVAL 50 FEET
DOTTED LINES REPRESENT 25-FOOT CONTOURS
DATUM IS MEAN SEA LEVEL
DEPTH CURVES IN FEET DATUM IS MEAN LOWER LOW WATER
SHORELINE SHOWN REPRESENTS THE APPROXIMATE LINE OF MEAN HIGH WATER
THE AVERAGE RANGE OF TIDE IS APPROXIMATELY 27 FEET

QUADRANGLE LOCATI

FOR SALE BY U. S. GEOLOGICAL SURVEY
FAIRBANKS, ALASKA 99701, DENVER, COLORADO 80225 OR WASHINGTON, D. C. 20242
A FOLDER DESCRIBING TOPOGRAPHIC MAPS AND SYMBOLS IS AVAILABLE ON REQUEST

wning	COMP. DRC DRAWN CB		PROJ. TITLE ANADROMOUS WATERS CATALOG