83-017

State of Alaska
Department of Fish and Game
Public Review Nomination for Waters
Important to Anadromous Species

☒ Addition ☐ Deletion

Name of Waterbody (if known): Sheppard Creek

200-20-10110-0010-2032

Location:

Anadromous Waters Catalog Volume and Number South Central Region II Review Copy #1

USGS 1:63,360 Quadrangle Cordova B-1

or 1:250,000 (if 1:63,360 not available)

Species	Date(s) Observed	Stage(s) (Spawning, Rearing, Migration)
Chum Salmon	8/5/82	Spawning

Comments: Please provide any clarifying information in addition to identification on Anadromous Waters Catalog Public Review Maps.

Observed by Sam Sharr
ADF&G Stock Separation

Name of Observer (please print) Kenneth Roberson

Date: 2/25/83 Signature: [signature]

Address: Box 47 ADF&G
Glennallen, AK 99588

Q 3/83

Durand 3-1-83

ACE 7784559

State of Alaska
Department of Fish and Game
Public Review Nomination for Waters
Important to Anadromous Species

☒ Addition ☐ Deletion

Name of Waterbody (if known): Kushtaka Lake

Location: 200-20-10110-2051-0010

Anadromous Waters Catalog Volume and Number

USGS 1:63,360 Quadrangle Cordova B-1

or 1:250,000 (if 1:63,360 not available)

Species	Date(s) Observed	Stage(s) (Spawning, Rearing, Migration)
Pink Salmon	7/24/82	Spawning
Chum Salmon	"	"
King Salmon	"	" / Migrating

Comments: Please provide any clarifying information in addition to identification on Anadromous Waters Catalog Public Review Maps.

Observed by Sam Sharr ADF&G
Stock Separation

Name of Observer (please print) Kenneth Robarson

Date: 2/25/83 Signature: [signature]

Address: Box 47 ADF&G
Glennallen, AK 99588

cp 3/83

Dumped 3-1-83

ACE 7784558 + IP

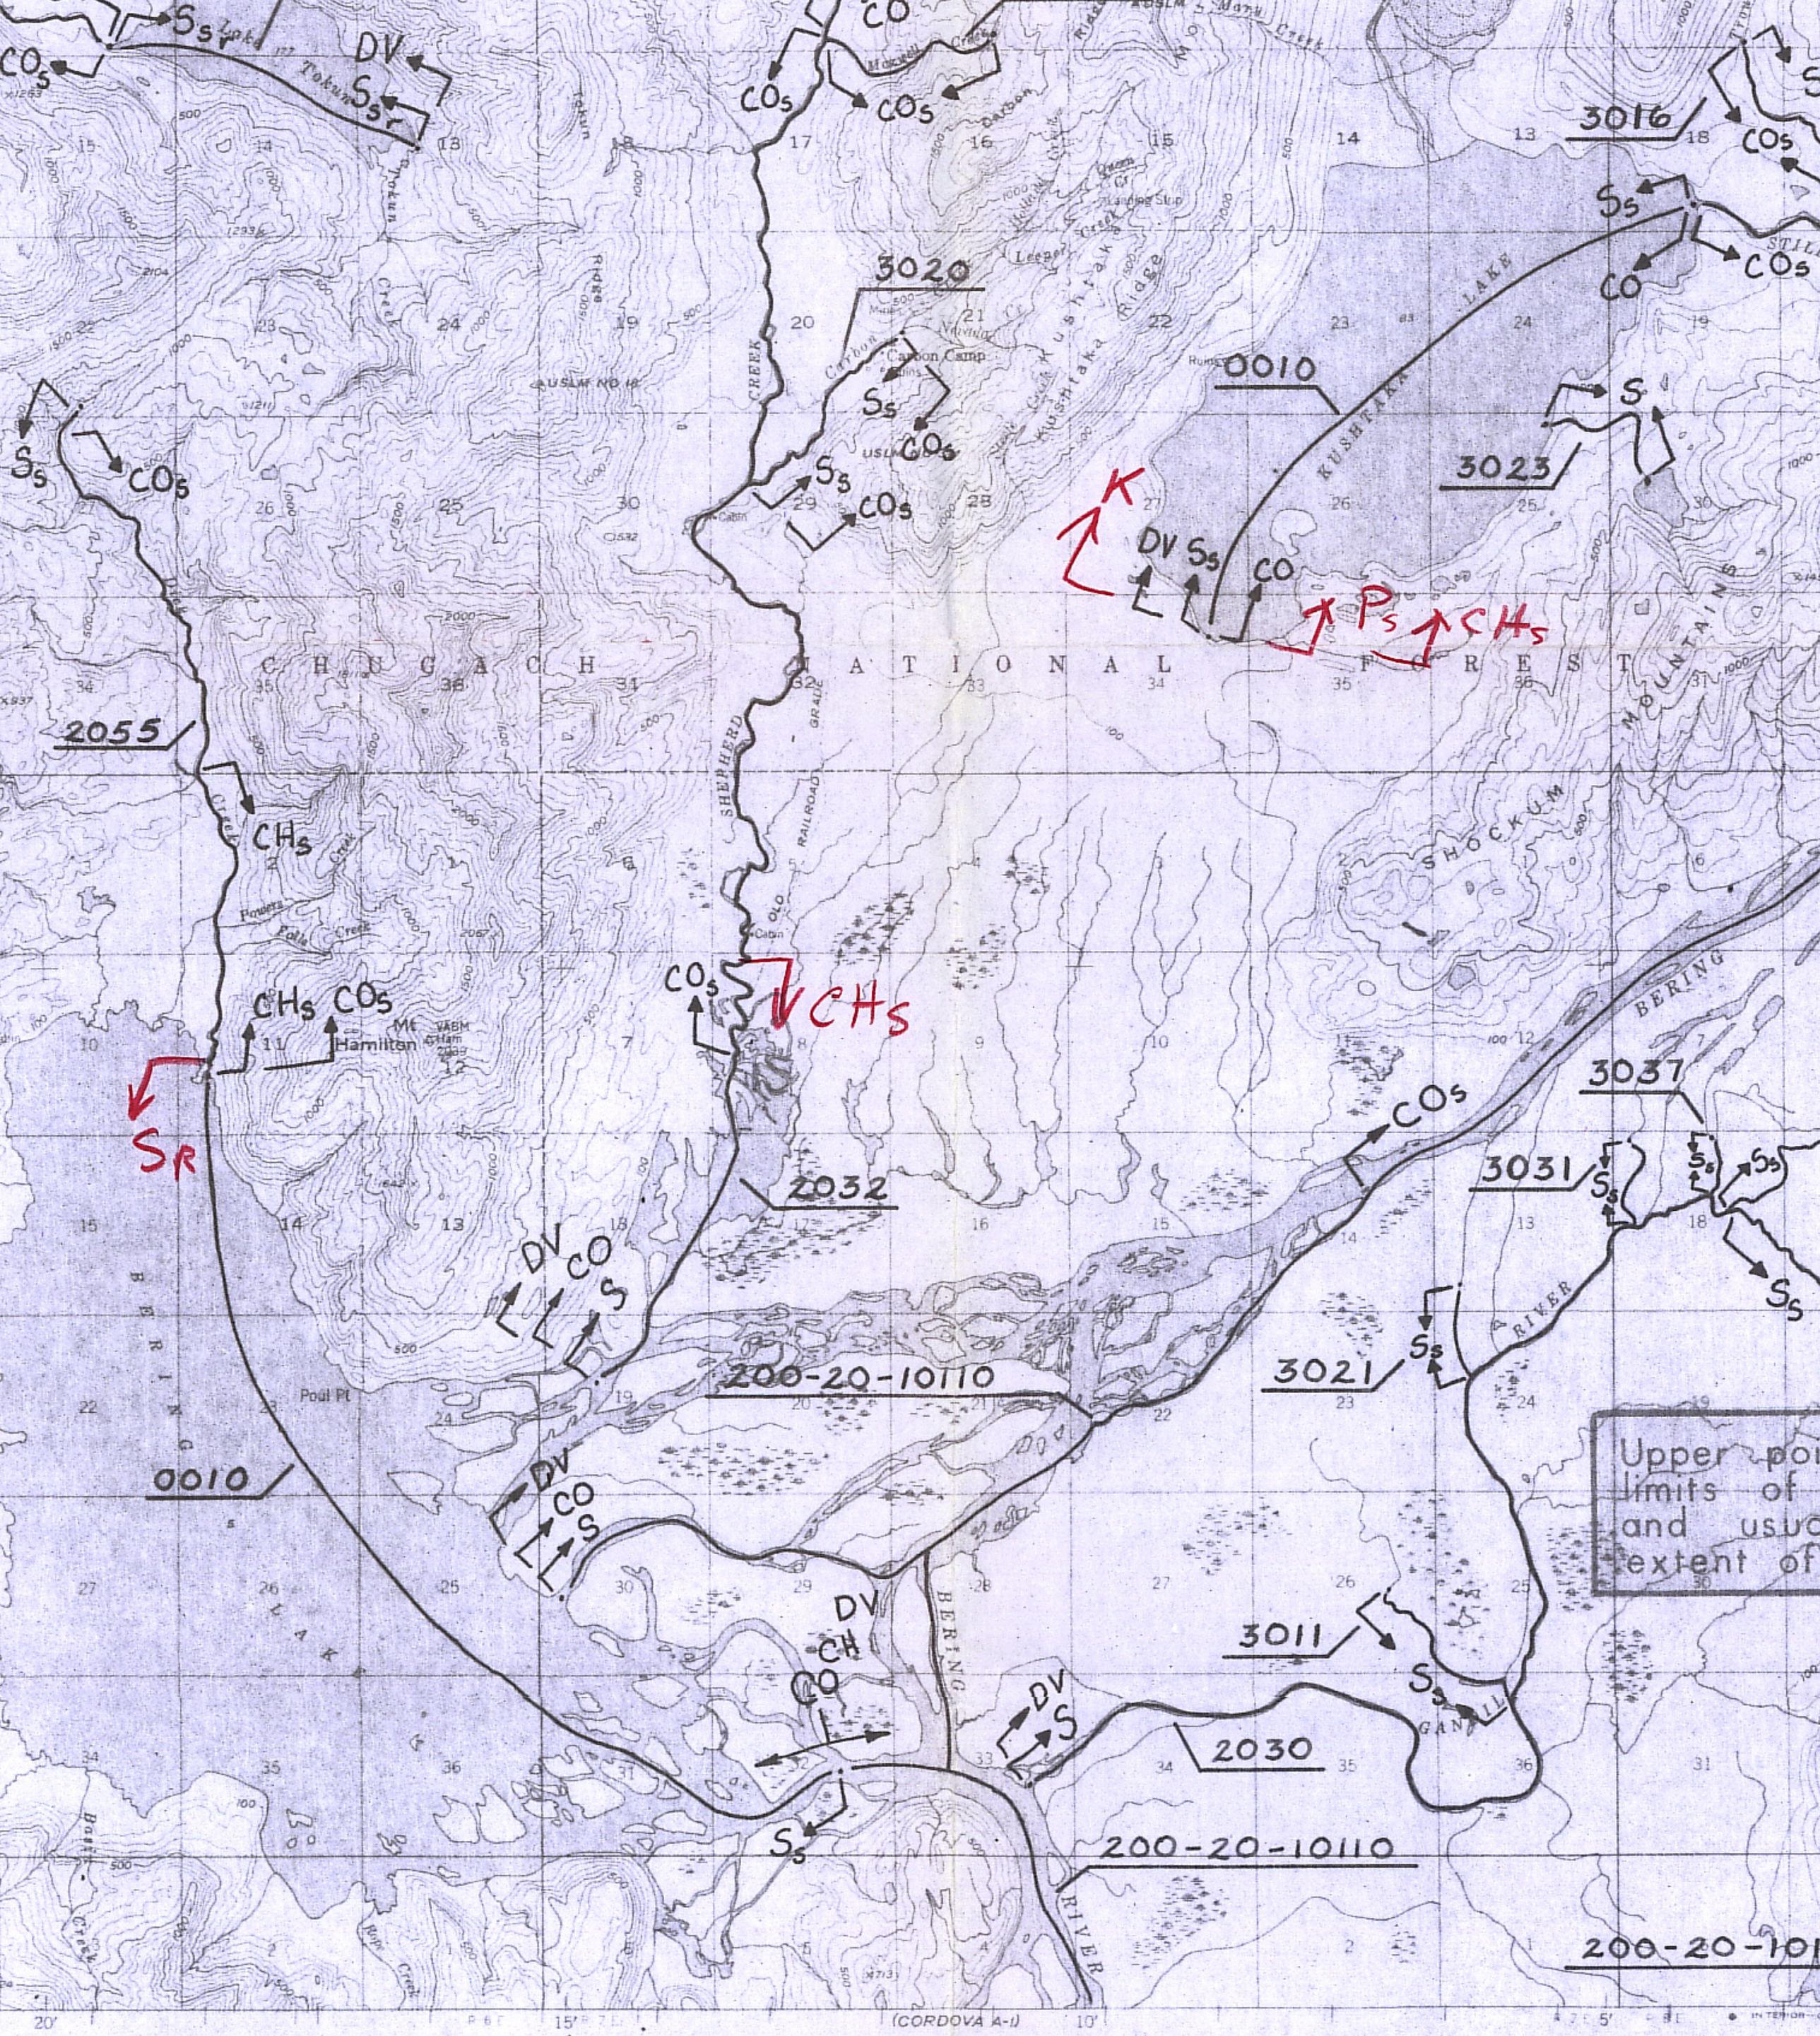
CHUGACH NATIONAL FOREST
KUSHTAKA LAKE
BERING RIVER
SHOCKUM MOUNTAIN
Mt Hamilton
Carbon Camp
Poul Pt
3016
3020
0010
3023
2055
2032
200-20-10110
3021
3011
2030
3037
3031
Upper po
limits of
and usuo
extent of
(CORDOVA A-1)
SCALE 1:63360
4 MILES

UNITED STATES
DEPARTMENT OF THE INTERIOR
GEOLOGICAL SURVEY

FINAL

CORDOVA (B-1) QUADRANGLE
ALASKA
1:63 360 SERIES (TOPOGRAPHIC)

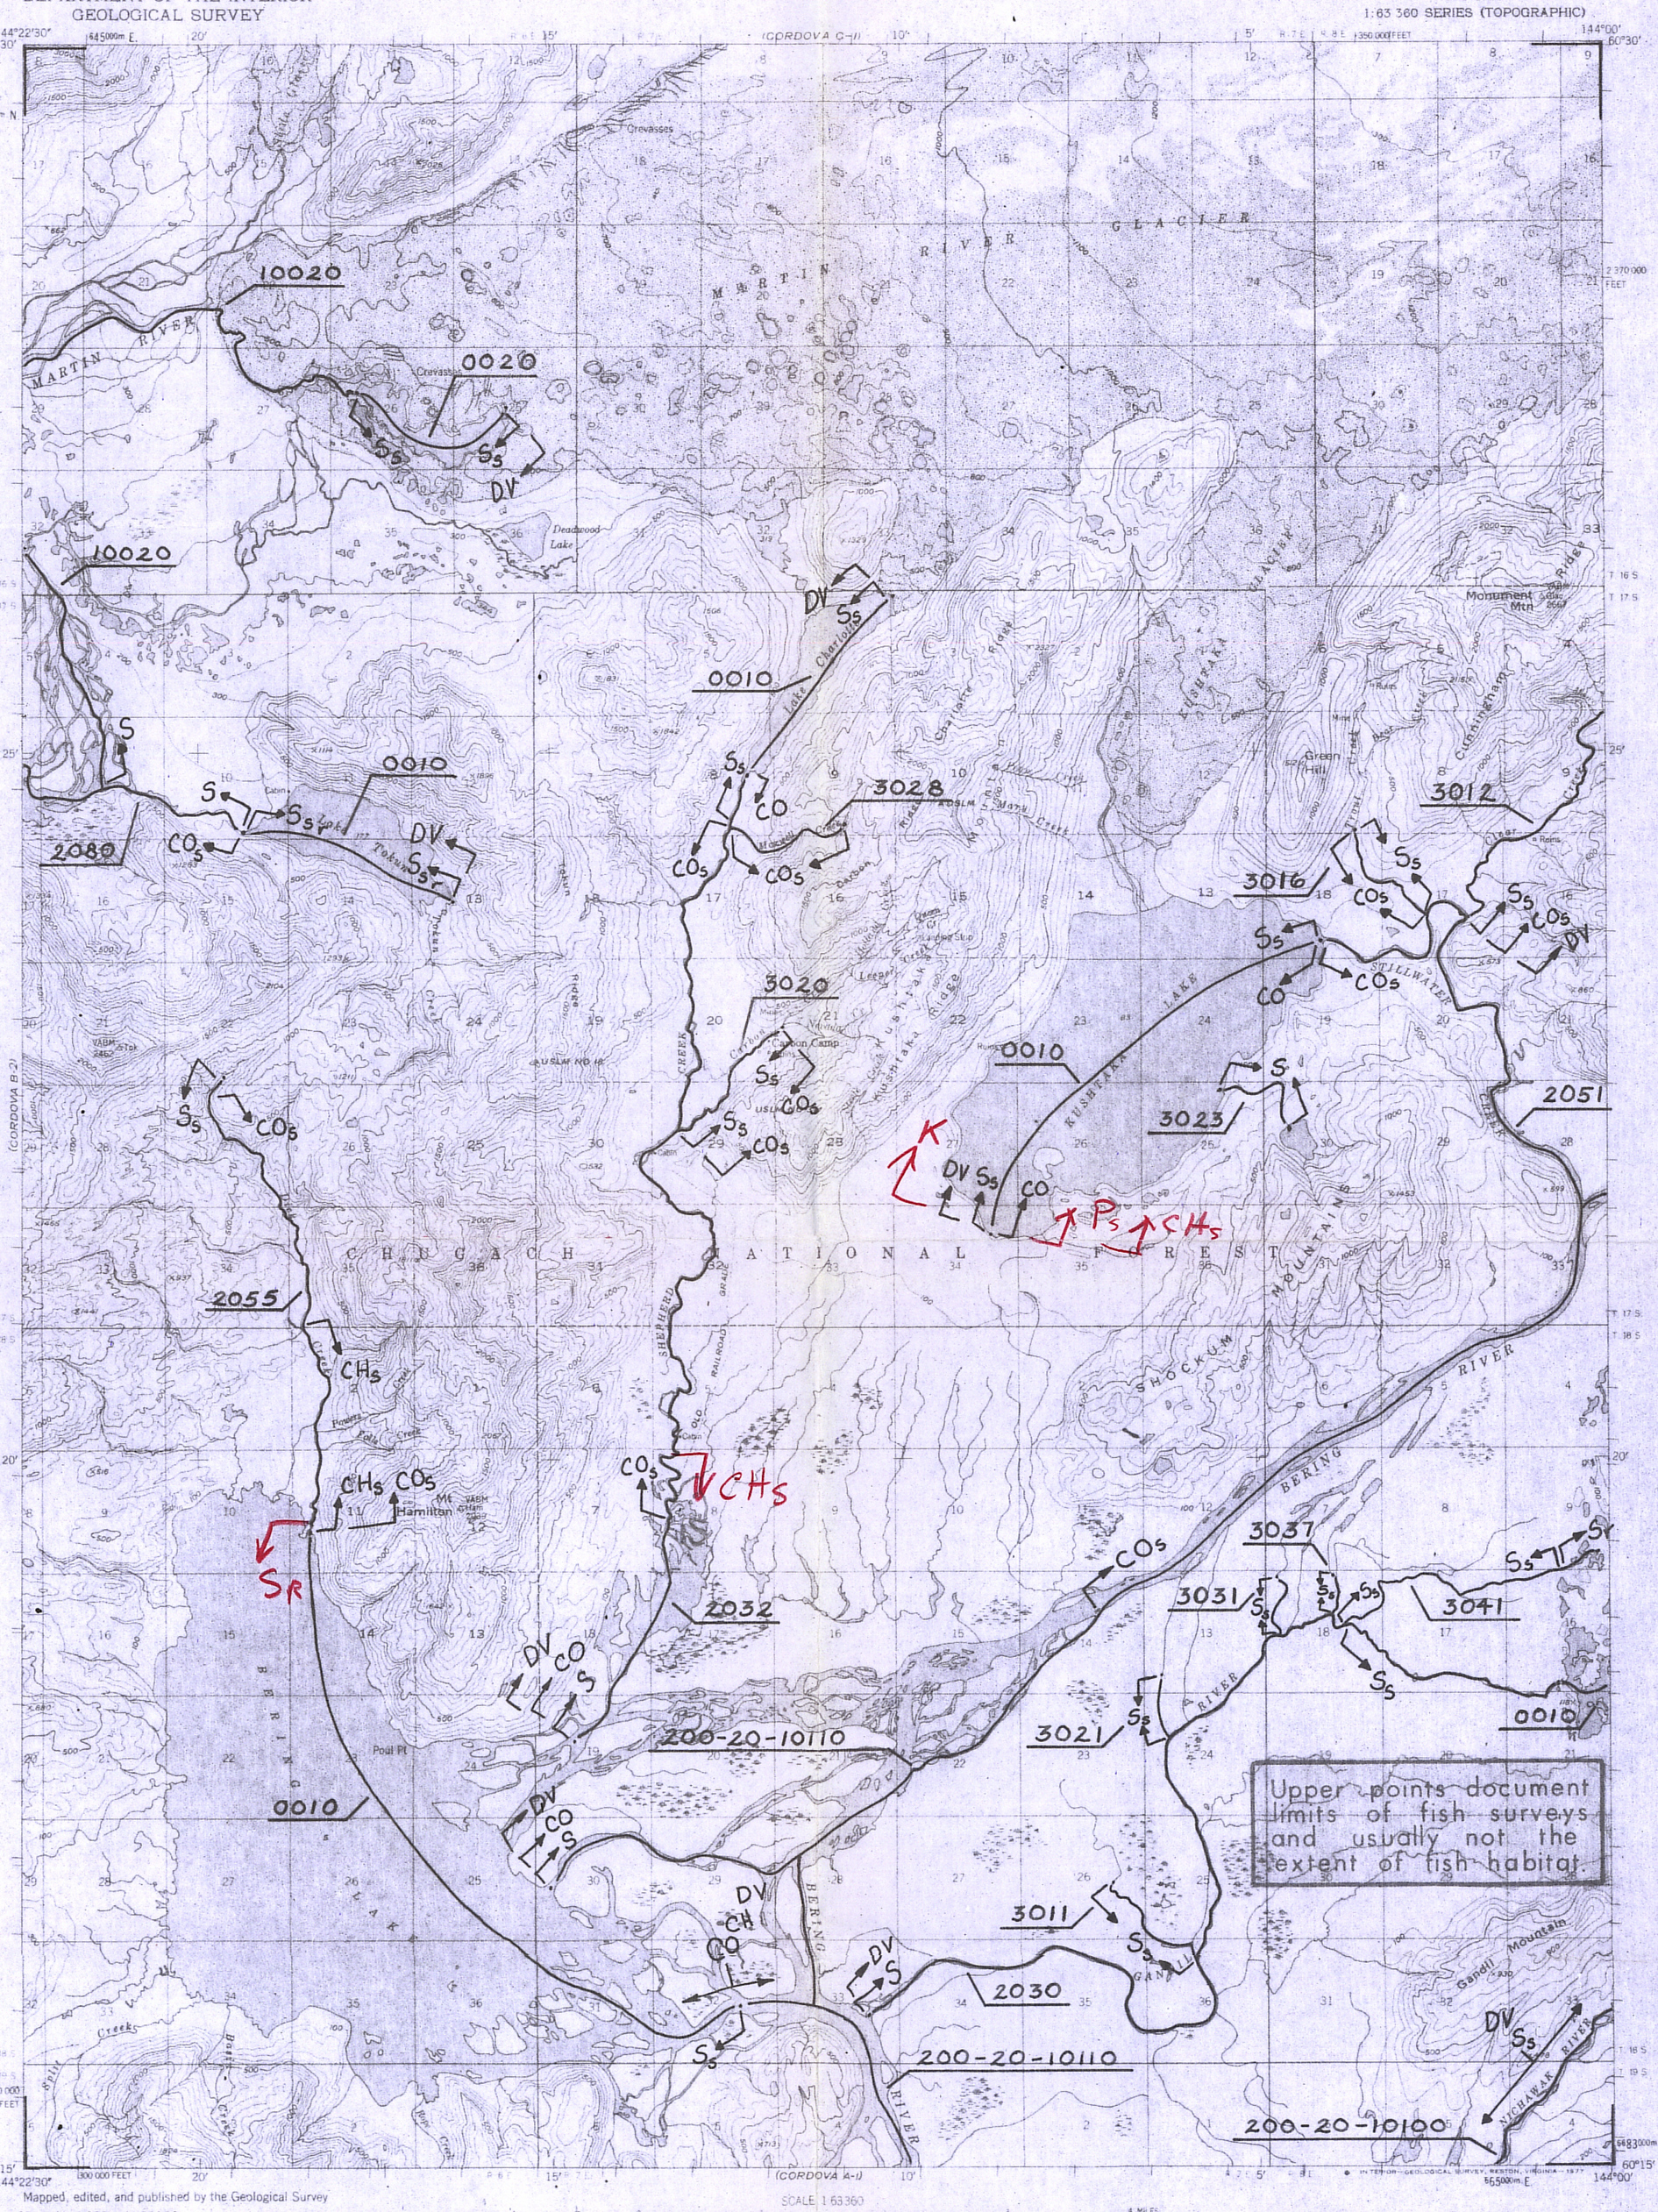

Upper points document limits of fish surveys and usually not the extent of fish habitat.

Mapped, edited, and published by the Geological Survey

Control by USGS and USC&GS

Topography by photogrammetric methods from aerial photographs taken 1950, field annotated 1951. Map not field checked

Universal Transverse Mercator projection; 1927 North American datum
10,000-foot grid based on Alaska coordinate system, zone 3
1000-meter Universal Transverse Mercator grid ticks, zone 6, shown in blue

Land lines printed in gray represent unsurveyed and unmarked locations predetermined by the Bureau of Land Management. Folios CR-9 and CR-10, Copper River Meridian
Dashed red land lines indicate approximate locations of existing ground surveys

Swamps, as portrayed, indicate only the wetter areas, usually of low relief, as interpreted from aerial photographs

TRUE NORTH
MAGNETIC NORTH
APPROXIMATE MEAN DECLINATION, 1951

SCALE 1:63360

CONTOUR INTERVAL 100 FEET
NATIONAL GEODETIC VERTICAL DATUM OF 1929

FOR SALE BY U.S. GEOLOGICAL SURVEY
FAIRBANKS, ALASKA 99701, DENVER, COLORADO 80225, OR RESTON, VIRGINIA 22092
A FOLDER DESCRIBING TOPOGRAPHIC MAPS AND SYMBOLS IS AVAILABLE ON REQUEST

ROAD CLASSIFICATION
Trails

QUADRANGLE LOCATION

CORDOVA (B-1), ALASKA
N6015–W14400/15X22.5
1951
MINOR REVISIONS 1975

KLR
FTW 3/82
RR

MAP NO. B-1 OF 54

LEGEND

S	Sockeye Salmon
K	King Salmon
CO	Coho Salmon
P	Pink Salmon
CH	Chum Salmon
SH	Steelhead Trout
DV	Dolly Varden
AC	Arctic Char
SF	Sheefish
W	Whitefish
CT	Cutthroat Trout

Subscript
s - Known Spawning
r - Rearing
*m - Migration

*Migration upstream is assumed for stream reaches where anadramous fish occur.

COMP. DRC
DRAWN CB
REVISED DRC
APPROVED ERL
DATE 4/82
FILE NO.

SCALE
1" = 1 MILE
1 : 63,360

PROJ. TITLE
ANADROMOUS WATERS CATALOG
ANADROMOUS WATERS ARE LISTED PURSUANT TO AS 16.05.870 (a)

MAP TITLE
CORDOVA (B-1)

STATE OF ALASKA
DEPARTMENT OF FISH AND GAME
habitat protection division
JUNEAU, ALASKA

BY	DATE
REVISIONS	

ACE 7784562-1P