83-039

State of Alaska
Department of Fish and Game
Public Review Nomination for Waters
Important to Anadromous Species

☒ Addition ☐ Deletion

Name of Waterbody (if known): Long Lake

212-20-10080-2300-3421-4062

Location:

Anadromous Waters Catalog Volume and Number South Central Region II Review Copy #1

USGS 1:63,360 Quadrangle Mc Carthy B-7

or 1:250,000 (if 1:63,360 not available)

Species	Date(s) Observed	Stage(s) (Spawning, Rearing, Migration)
Red Salmon	7/27/76	Rearing (103-113 mm)
Silver Salmon	7/27/76	Rearing (109 mm
Steel head	9/14-16/82	Spawning

Comments: Please provide any clarifying information in addition to identification on Anadromous Waters Catalog Public Review Maps.

Name of Observer (please print) Kenneth Roberson

Date: 2/24/83 Signature: [signature]

Address: Box 47 ADF&G
Glennallen, Alaska 99588

Diamond 2-1-83

cp 3/83

UNITED STATES
DEPARTMENT OF THE INTERIOR
GEOLOGICAL SURVEY

ADVANCE PROOF
SUBJECT TO CORRECTION
SCALE 1:63,360

MC CARTHY (B-7) QUADRANGLE
ALASKA
1:63 360 SERIES (TOPOGRAPHIC)

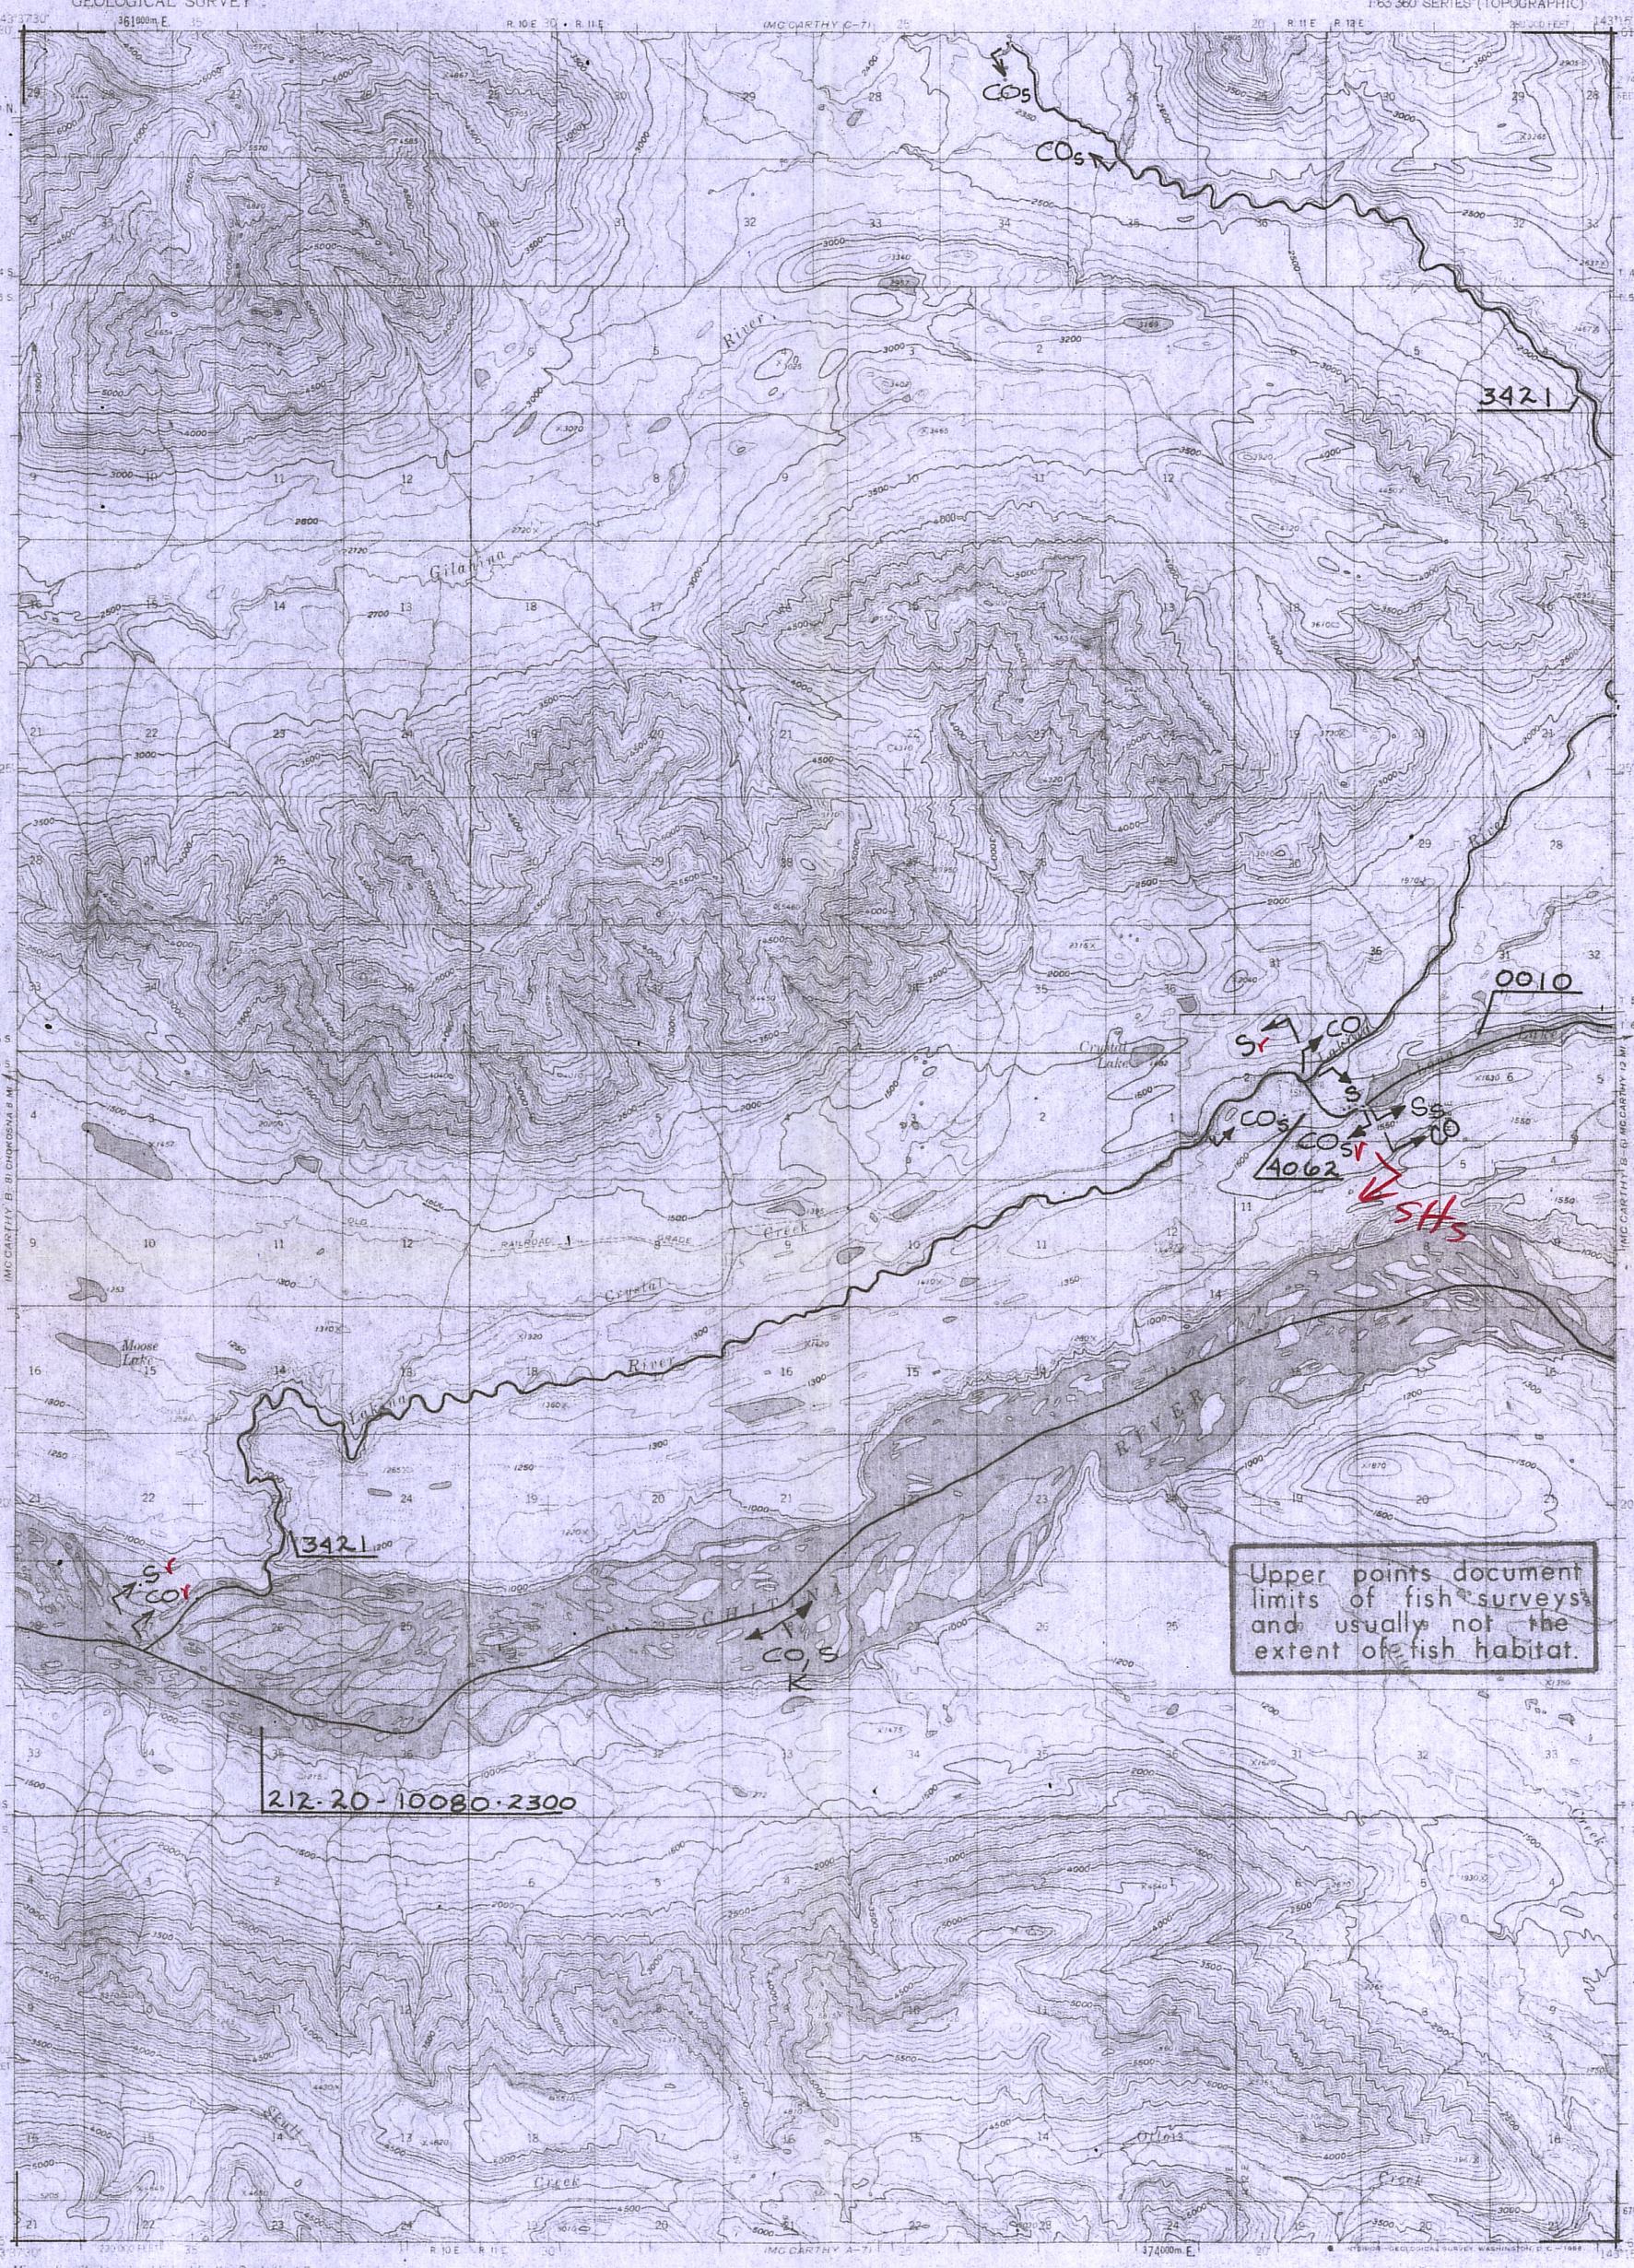

Mapped, edited, and published by the Geological Survey

Control by USGS and USC&GS

Topography by photogrammetric methods from aerial photographs taken 1957. Field annotated 1959. Map not field checked.

Universal Transverse Mercator projection, 1927 North American 10,000 foot grid based on Alaska coordinate system, zone 2. 1000-meter Universal Transverse Mercator grid ticks, zone 7, shown in blue.

Gray land lines represent unsurveyed and unmarked locations predetermined by the Bureau of Land Management. Folio CR 6, Copper River Meridian.

TRUE NORTH / MAGNETIC NORTH — APPROXIMATE MEAN DECLINATION, 1959

CONTOUR INTERVAL 100 FEET
DOTTED LINES REPRESENT SUPPLEMENTARY CONTOURS
DATUM IS MEAN SEA LEVEL

ALASKA — QUADRANGLE LOCATION

ROAD CLASSIFICATION
Trails

MC CARTHY (B-7), ALASKA
N61/15-W143/15/15X22.5
1959

FOR SALE BY U. S. GEOLOGICAL SURVEY
FAIRBANKS, ALASKA 99701, DENVER, COLORADO 80225, OR WASHINGTON, D. C. 20242
A FOLDER DESCRIBING TOPOGRAPHIC MAPS AND SYMBOLS IS AVAILABLE ON REQUEST

NOTE

This proof is sent to you for your review and co... If you observe errors or have suggestions plea... notations on the face of the map, sign and retu... copy within TEN days.

RETURN TO
ROCKY MOUNTAIN REGION ENGIN...
U.S. GEOLOGICAL SURVEY
FEDERAL CENTER, DENVER, COLORADO

BY	DATE
Signature	
Title	
Organization	
REVISIONS	

MAP NO. B-7 OF 56

LEGEND

S	Sockeye Salmon
K	King Salmon
CO	Coho Salmon
P	Pink Salmon
CH	Chum Salmon
SH	Steelhead Trout
DV	Dolly Varden
AC	Arctic Char
SF	Sheefish
W	Whitefish
CT	Cutthroat Trout

Subscript
s - Known Spawning
r - Rearing
*m - Migration

*Migration upstream is assumed for stream reaches where anadramous fish occur.

COMP. DRC
DRAWN CB
REVISED DRC
APPROVED ERL
DATE 4/82
FILE NO.

SCALE
1" = 1 MILE
1 : 63,360

PROJ. TITLE
ANADROMOUS WATERS CATALOG
ANADROMOUS WATERS ARE LISTED PURSUANT TO AS 16.05.870 (a)

MAP TITLE
McCARTHY, B-7

STATE OF ALASKA
DEPARTMENT OF FISH AND GAME
habitat protection division
JUNEAU, ALASKA