83-042

State of Alaska
Department of Fish and Game
Public Review Nomination for Waters
Important to Anadromous Species

☑ Addition ☐ Deletion

Name of Waterbody (if known): Bachatna Crk, North Fork Big River

Location:

Anadromous Waters Catalog Volume and Number South Central Reg 2

USGS 1:63,360 Quadrangle Kenai ~~D-7~~ D-6

or 1:250,000 (if 1:63,360 not available) _____

Species	Date(s) Observed	Stage(s) (Spawning, Rearing, Migration)
Coho	Aug 1981	spawning
Sockeye	Aug 1981	spawning

Comments: Please provide any clarifying information in addition to identification on Anadromous Waters Catalog Public Review Maps.

Coho and sockeye were seen spawning in upper Bachatna Creek; sockeye were seen spawning in in ~~the~~ ~~South~~ North Fork Big River from ~~the~~ unnamed lake (sec 36, 37 T9N, R17W) to confluence with Big River

Name of Observer (please print) Bruce E. King

Date: 6/24/82 Signature: Bruce E King

Drafted 2/15/83
R. Crone

Durand 2-7-83

UNITED STATES
DEPARTMENT OF THE INTERIOR
GEOLOGICAL SURVEY

FINAL

KENAI (D-6) QUADRANGLE
ALASKA—KENAI PENINSULA BOROUGH
SERIES T0POGRAPHIC

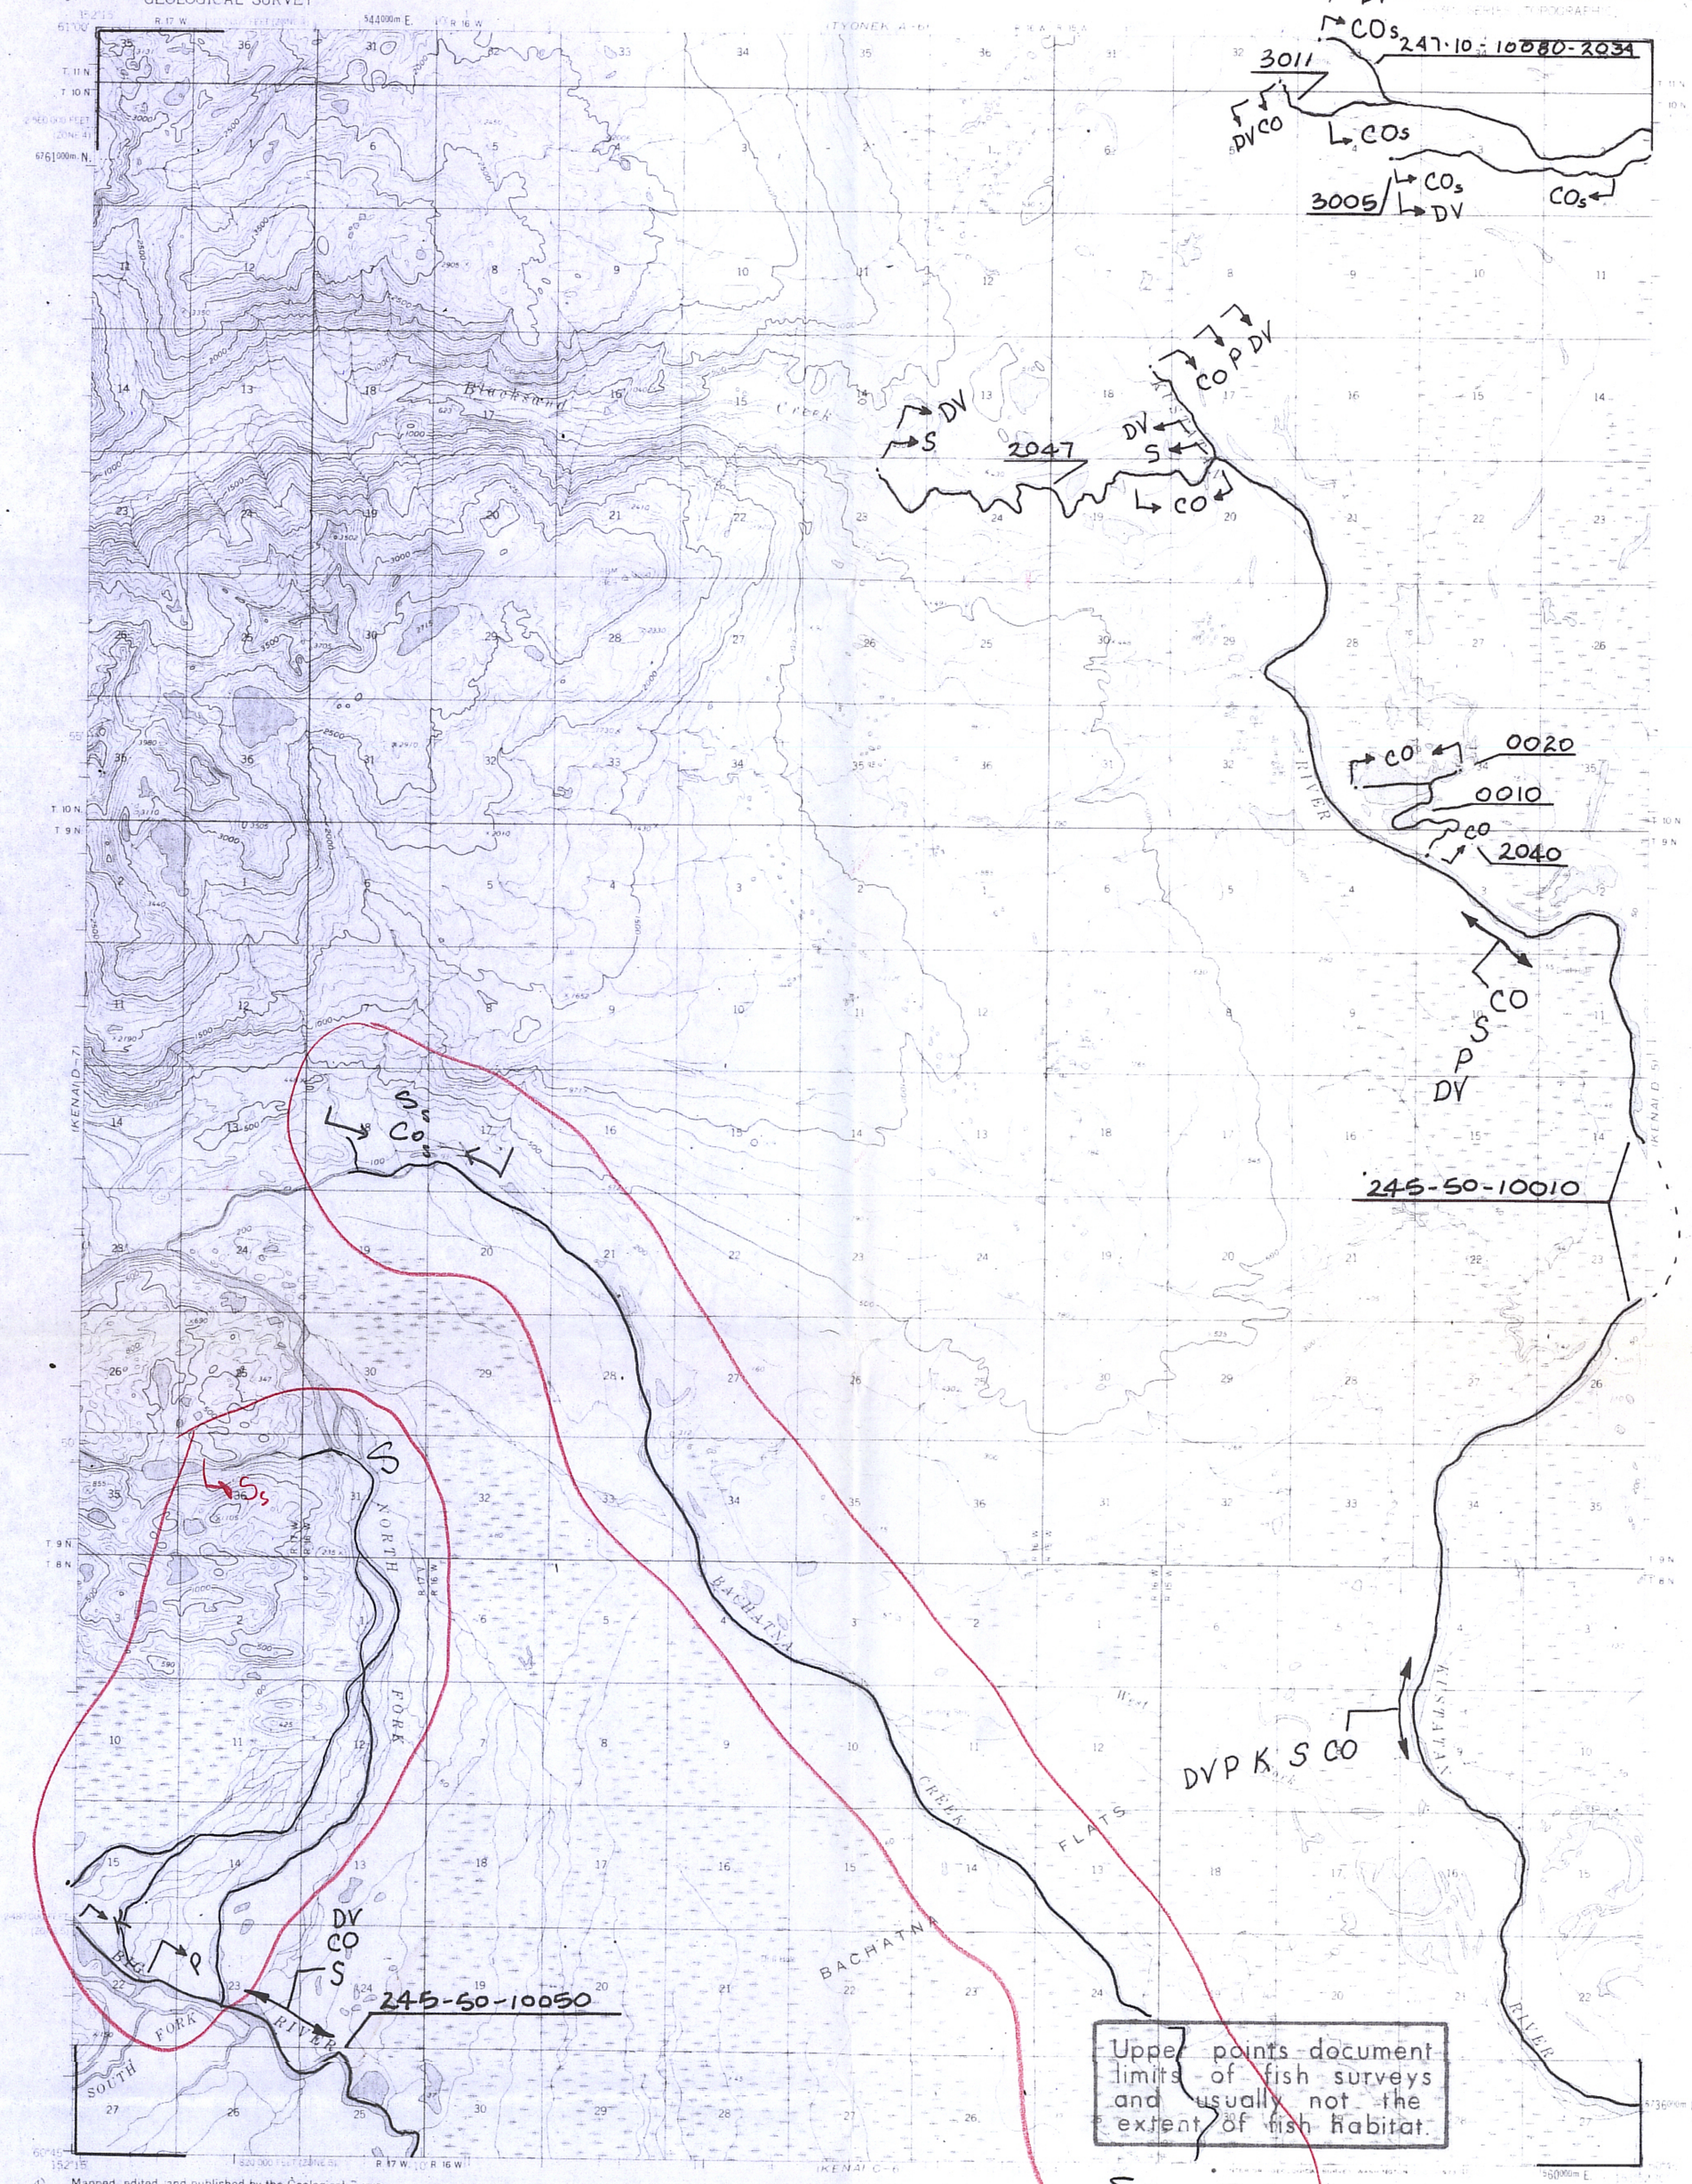

Mapped, edited, and published by the Geological Survey

Control by USGS and USC&GS

Topography by photogrammetric methods from aerial photographs taken 1952, 1954, and 1955. field annotated 1958
Map not field checked

Universal Transverse Mercator projection, 1927 North American datum
10,000-foot grids based on Alaska coordinate system, zones 5 and 4
1000-meter Universal Transverse Mercator grid ticks, zone 5, shown in blue

Gray land lines represent unsurveyed and unmarked locations predetermined by the Bureau of Land Management
Folios S-12 and S-13 Seward Meridian

Swamps, as portrayed, indicate only the wetter areas, usually of low relief, as interpreted from aerial photographs

TRUE NORTH
MAGNETIC NORTH
APPROXIMATE MEAN DECLINATION, 1958

SCALE 1:63 360

CONTOUR INTERVAL 100 FEET
DOTTED LINES REPRESENT 50-FOOT CONTOURS
DATUM IS MEAN SEA LEVEL

ROAD CLASSIFICATION
No roads or trails in this area

KENAI (D-6), ALASKA
1958

FOR SALE BY U. S. GEOLOGICAL SURVEY
FAIRBANKS, ALASKA 99701, DENVER, COLORADO 80225, OR WASHINGTON, D. C. 20242
A FOLDER DESCRIBING TOPOGRAPHIC MAPS AND SYMBOLS IS AVAILABLE ON REQUEST

BK
KT 2/82

MAP NO.
D-6

LEGEND

S	Sockeye Salmon
K	King Salmon
CO	Coho Salmon
P	Pink Salmon
CH	Chum Salmon
SH	Steelhead Trout
DV	Dolly Varden
AC	Arctic Char
SF	Sheefish
W	Whitefish
CT	Cutthroat Trout

Subscript
s - Known Spawning
r - Rearing
*m - Migration

*Migration upstream is assumed for stream reaches where anadramous fish occur.

COMP. DRC
DRAWN CB
REVISED DRC
APPROVED ERL
DATE 4/82
FILE NO.

N

SCALE
1" = 1 MILE
1 : 63,360

PROJ. TITLE
ANADROMOUS WATERS CATALOG
ANADROMOUS WATERS ARE LISTED PURSUANT TO AS 16.05.870 (a)

MAP TITLE
KENAI D-6

STATE OF ALASKA
DEPARTMENT OF FISH AND GAME
habitat protection division
JUNEAU, ALASKA

BY	DATE
REVISIONS	