83-091

State of Alaska
Department of Fish and Game
Public Review Nomination for Waters
Important to Anadromous Species

ALASKA DEPT. OF FISH & GAME
OCT 25 1982

[X] Addition [ ] Deletion

Name of Waterbody (if known): Tasnuna River
212-20-10080-2159

Location:

Anadromous Waters Catalog Volume and Number South Central Region 2

USGS 1:63,360 Quadrangle Valdez A-4

or 1:250,000 (if 1:63,360 not available) Valdez

Species	Date(s) Observed	Stage(s) (Spawning, Rearing, Migration)
Sockeye	9/3/82	Spawning

Comments: Please provide any clarifying information in addition to identification on Anadromous Waters Catalog Public Review Maps.

T9S - ~~R2E~~ R1E CRM Sec. 34-35 (approx)

Name of Observer (please print) Kenneth Roberson

Date: 10/19/82 Signature: [signature]

Demand 11/82

RECEIVED
OCT 27 1982
RESOURCE ASSESSMENT
BRANCH, HABITAT

Drafted & drawn 11/30

ACE 7739893 +18

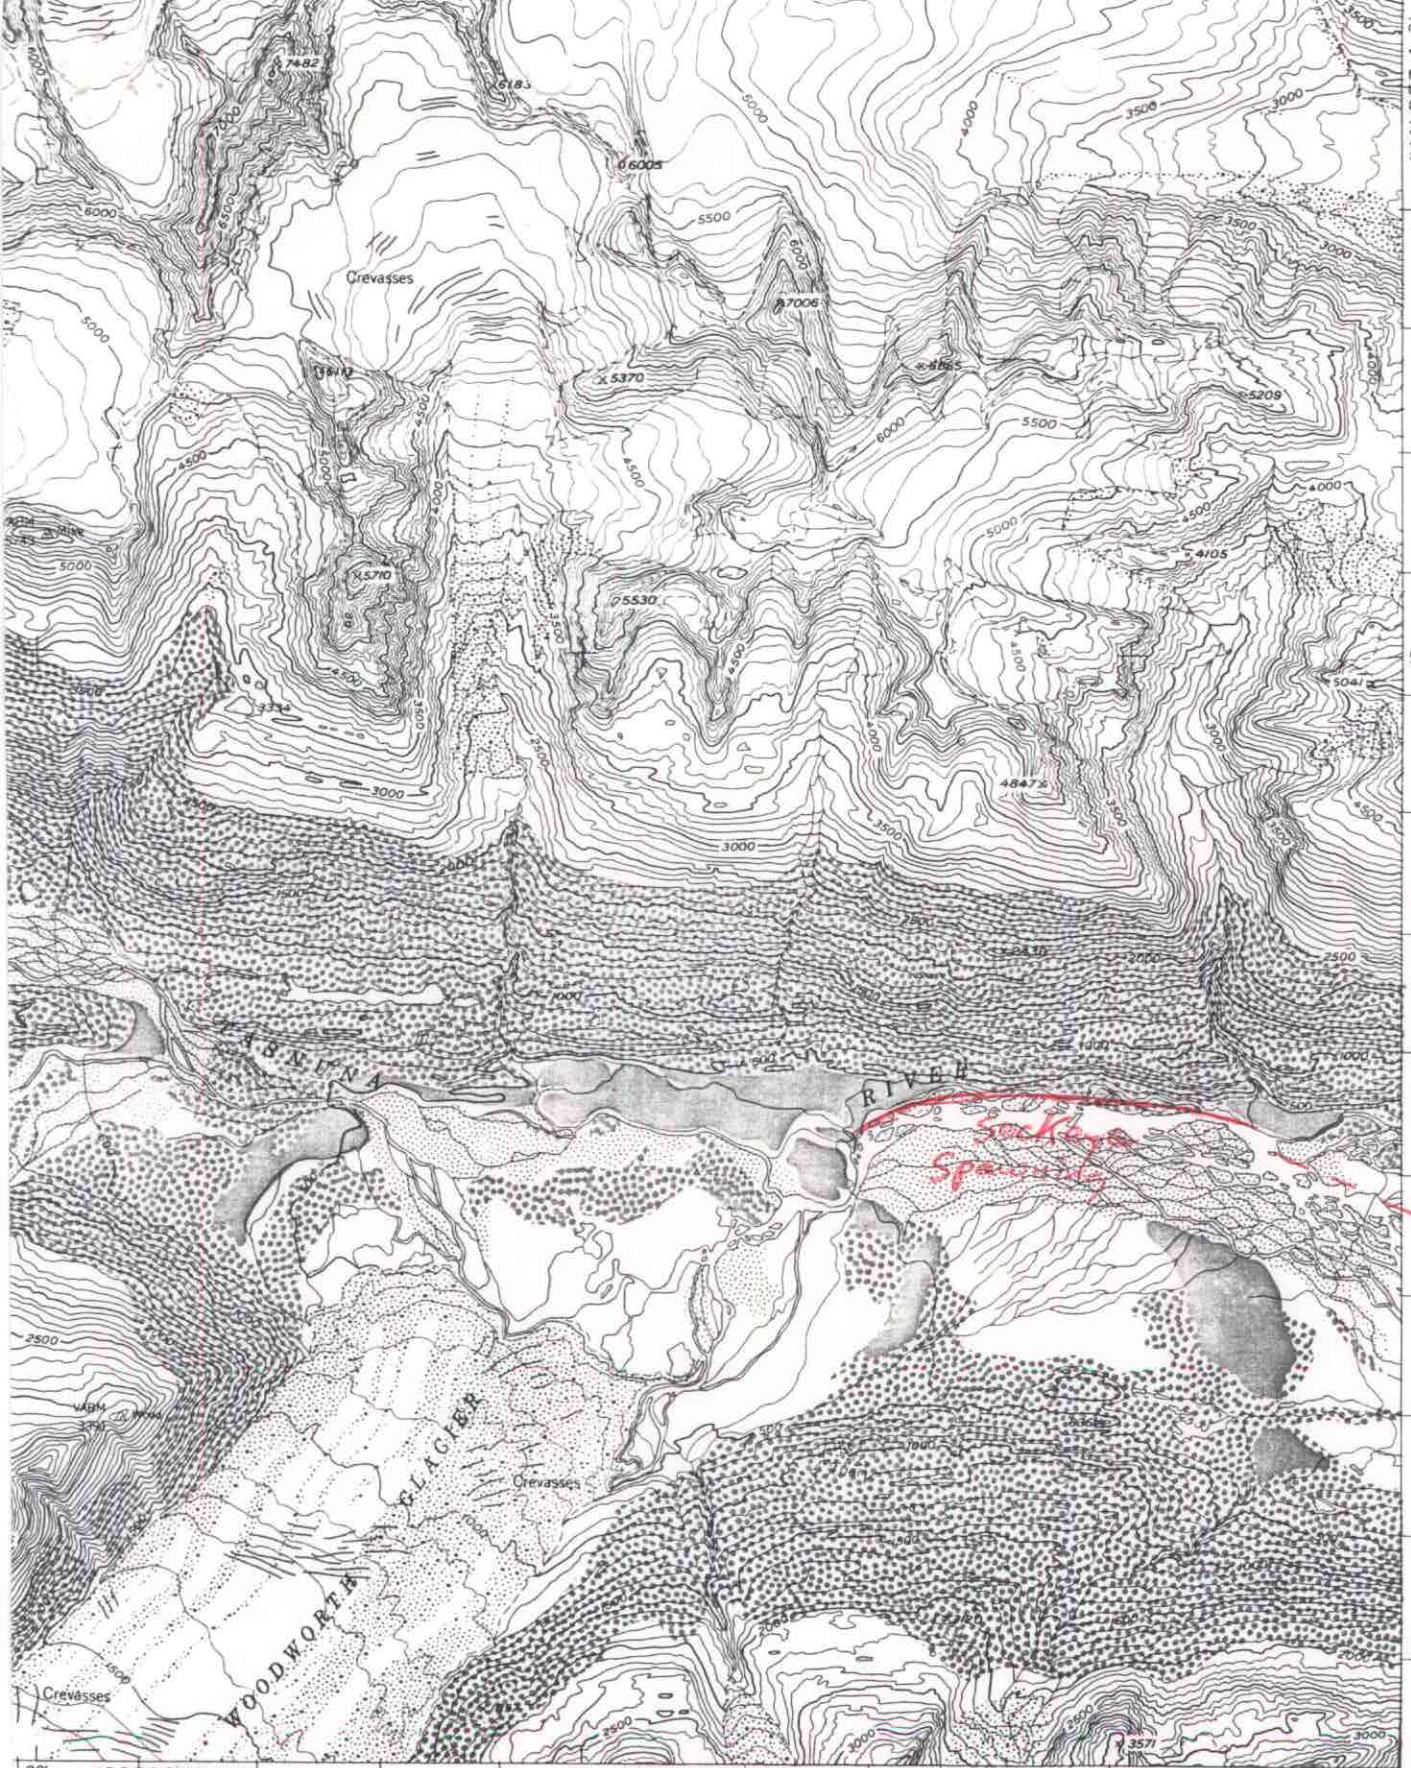

changes in red

Sockeye Spawning

migration

RR

SCALE 1:63360

1 2 3 4 MILES

6000 9000 12000 15000 18000 21000 FEET

1 2 3 4 5 KILOMETERS

CONTOUR INTERVAL 100 FEET
DATUM IS MEAN SEA LEVEL

QUADRANGLE LOCATION

ROAD CLASSIFICATION

Medium-duty ——— ◯ Alaska Route

ACE 7739894 -15

VALDEZ (A-4), ALASKA
N6100—W14507.5/15X22.5
1953

SALE BY U. S. GEOLOGICAL SURVEY
DENVER 2, COLORADO WASHINGTON 25, D. C.

(CORDOVA D-4)