State of Alaska
Department of Fish and G
Public Review Nomination for Waters
Important to Anadromous Species

1984 REVISION

84-033

X Addition ____ Deletion

Name of Waterbody (if known): See list of streams below

Location:

Anadromous Waters Catalog Volume and Number South Central II

USGS 1:63,360 Quadrangle Seward A-5

or 1:250,000 (if 1:63,360 not available) ____

Species	Date(s) Observed	Stage(s) (Spawning, Rearing, Migration)
PINK	7-8/81-82	SPAWNING

Comments: Please provide any clarifying information. Also, please include a map of the area identifying the stream reach. This can be a copy of the map from the Anadromous Waters Atlas.

refer to accompanying blue-line map
Add new stream 226-50-16480
T 25 R 5E SM, sec 2

Name of Observer (please print) Pete Fridgen

Date: 2-2-84 Signature: [signature]

Address: Comm Fish
Cordova

ACE 7784540+1P

UNITED STATES
DEPARTMENT OF THE INTERIOR
GEOLOGICAL SURVEY

FINAL

SEWARD (A-5) QUADRANGLE
ALASKA
1:63 360 SERIES (TOPOGRAPHIC)

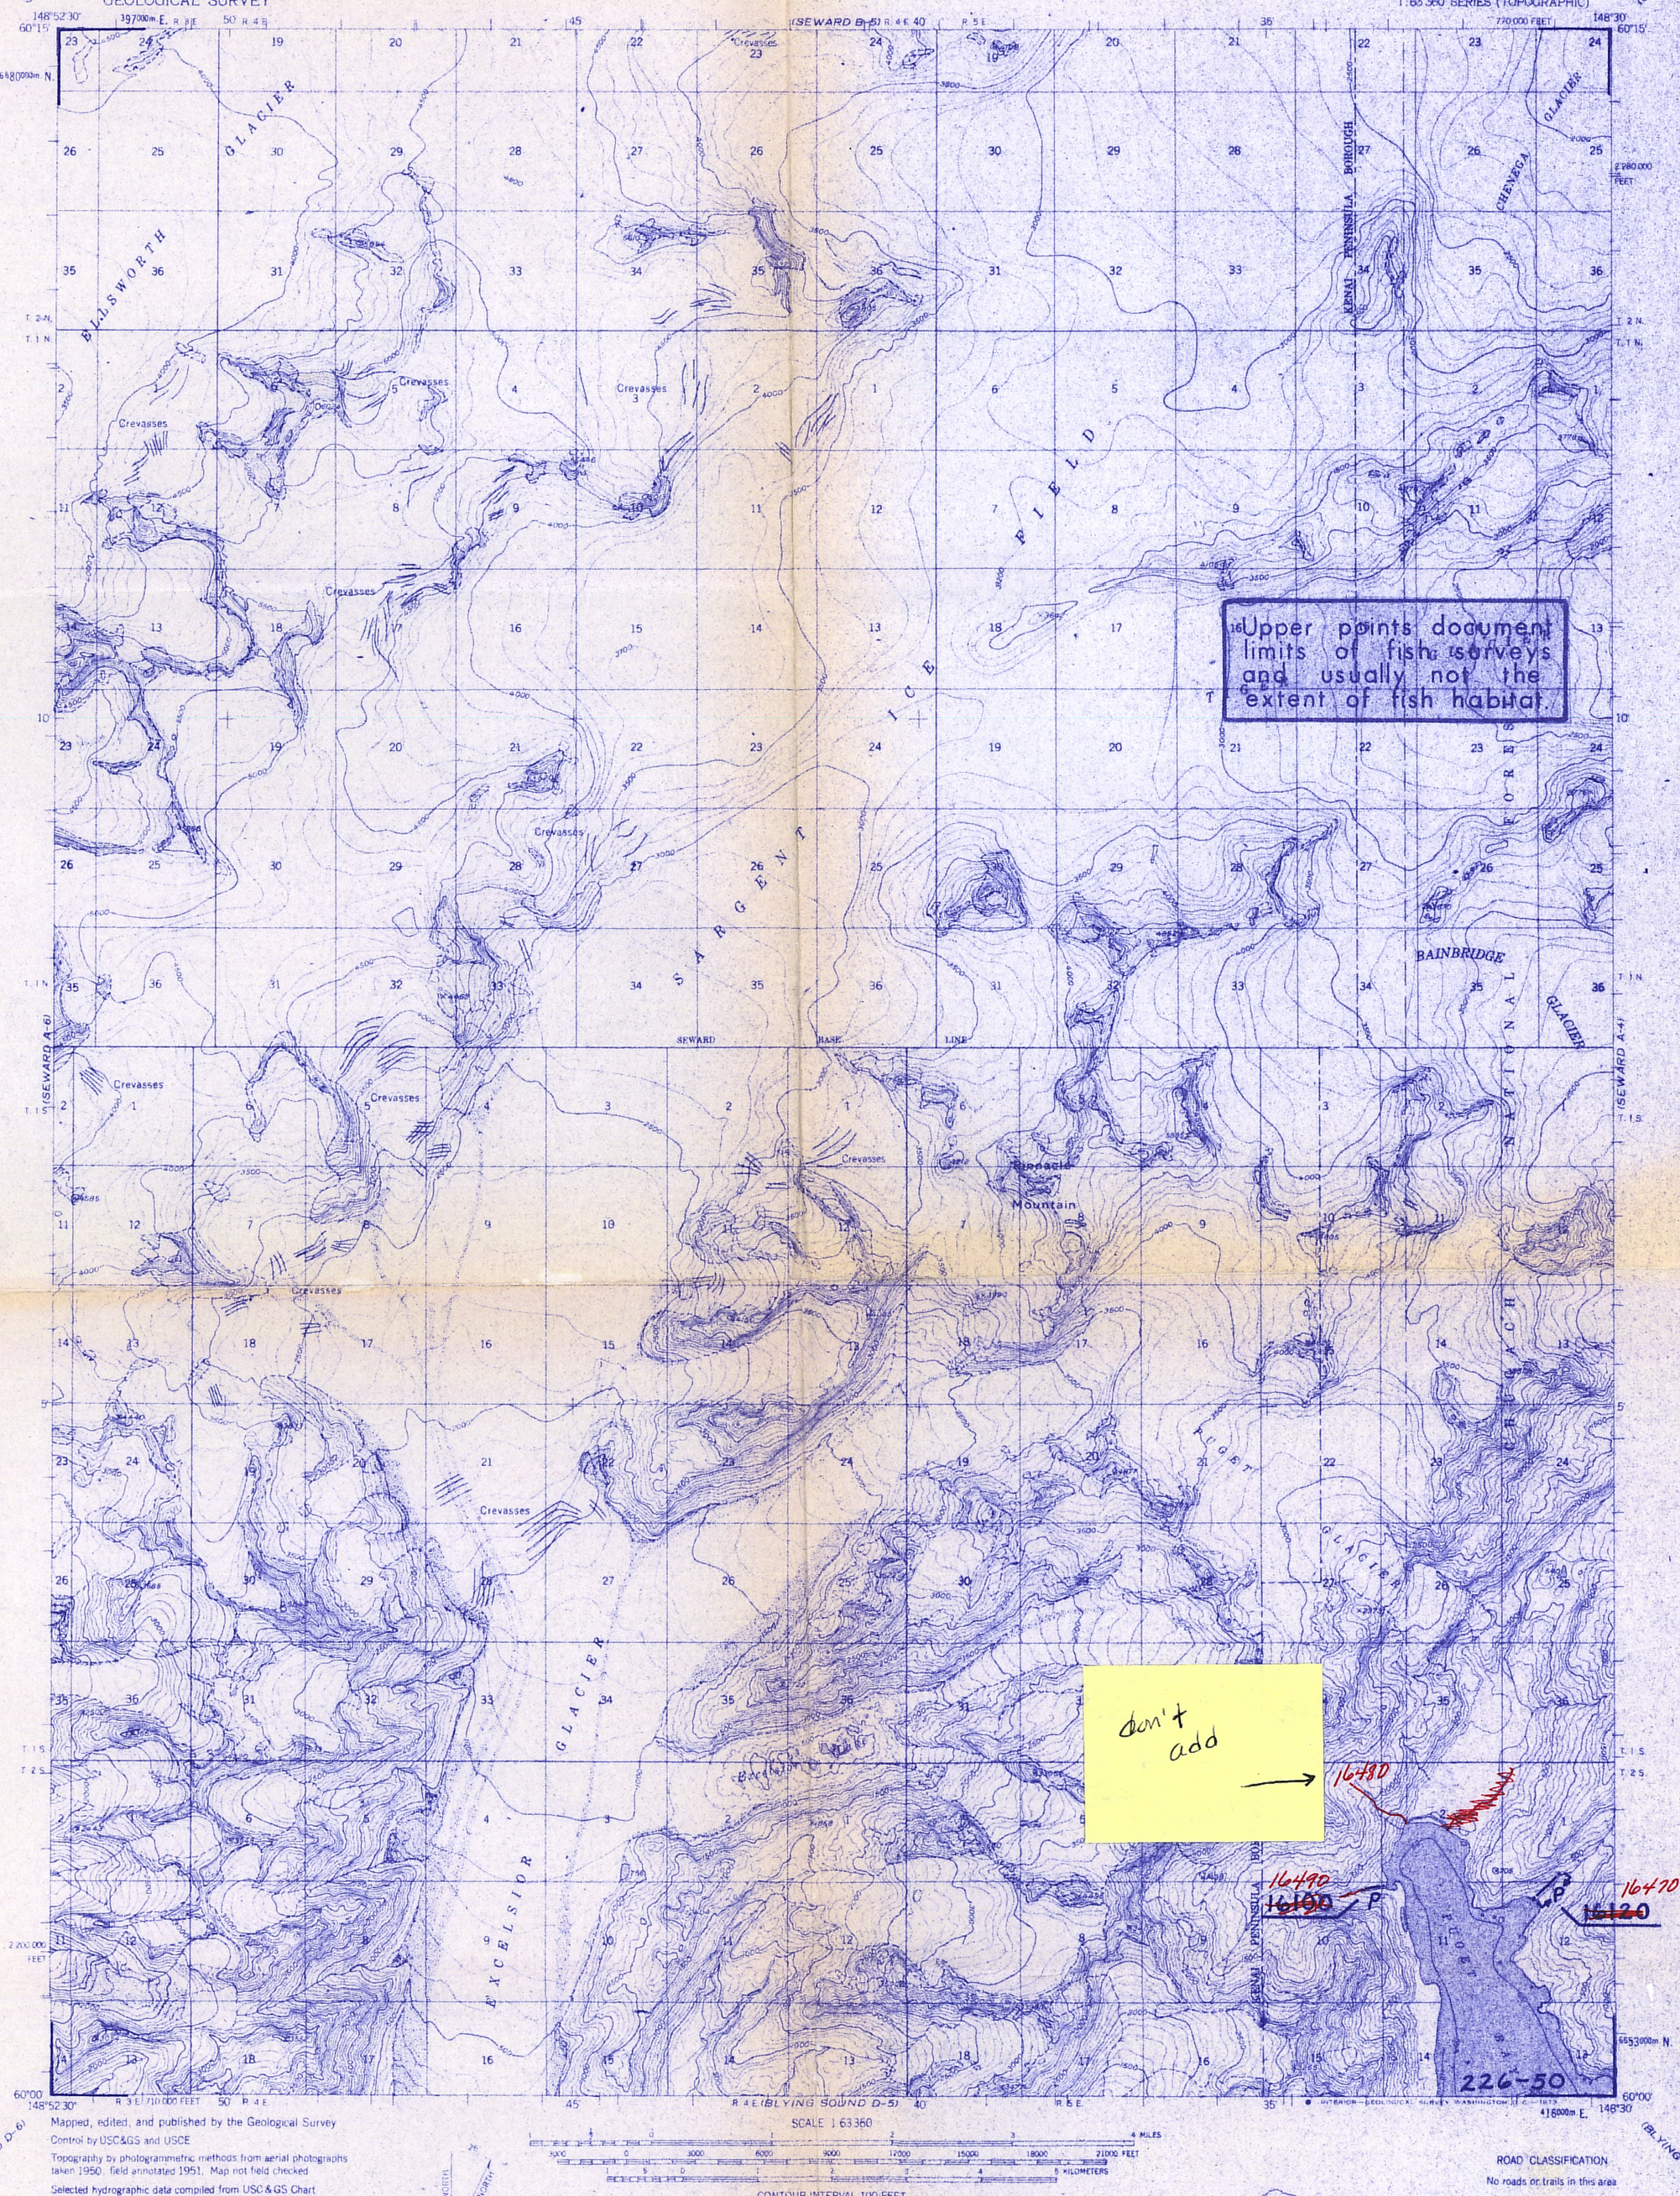

Mapped, edited, and published by the Geological Survey

Control by USC&GS and USCE

Topography by photogrammetric methods from aerial photographs taken 1950. Field annotated 1951. Map not field checked

Selected hydrographic data compiled from USC&GS Chart 8528 (1950) (1:81,436 scale). This information is not intended for navigational purposes

Universal Transverse Mercator projection, 1927 North American datum 10,000 foot grid based on Alaska coordinate system, zone 4 1000-meter Universal Transverse Mercator grid ticks, zone 6, shown in blue

Land lines represent unsurveyed and unmarked locations predetermined by the Bureau of Land Management Folios S-14 and S-15, Seward Meridian

Swamps, as portrayed, indicate only the wetter areas usually of low relief, as interpreted from aerial photographs

TRUE NORTH
MAGNETIC NORTH
26°
APPROXIMATE MEAN DECLINATION, 1951

SCALE 1:63 360

4 MILES
5 KILOMETERS

CONTOUR INTERVAL 100 FEET
DATUM IS MEAN SEA LEVEL
DEPTH CURVES: IN FEET, DATUM IS MEAN LOWER LOW WATER
SHORELINE SHOWN REPRESENTS THE APPROXIMATE LINE OF MEAN HIGH WATER
THE AVERAGE RANGE OF TIDE IS APPROXIMATELY 8 FEET

FOR SALE BY U. S. GEOLOGICAL SURVEY
FAIRBANKS, ALASKA 99701, DENVER, COLORADO 80225, OR WASHINGTON, D.C. 20242
A FOLDER DESCRIBING TOPOGRAPHIC MAPS AND SYMBOLS IS AVAILABLE ON REQUEST

QUADRANGLE LOCATION

ROAD CLASSIFICATION
No roads or trails in this area

SEWARD (A-5), ALASKA
N6000—W14830/15X22.5

1951
MINOR REVISIONS 1973

KH RR 3/82

TM 2/82

Rev. 12/21/83

MAP NO.
A-5
OF
53

LEGEND

		Subscript
S	Sockeye Salmon	s - Known Spawning
K	King Salmon	r - Rearing
CO	Coho Salmon	* m - Migration
P	Pink Salmon	
CH	Chum Salmon	
SH	Steelhead Trout	
DV	Dolly Varden	* Migration upstream is assumed for stream reaches where anadromous fish occur.
AC	Arctic Char	
SF	Sheefish	
W	Whitefish	
C	Cutthroat Trout	

ACE 7784542 - /P

COMP.	DRC
DRAWN	CB
REVISED	DRC
APPROVED	ERL
DATE	4/82
FILE NO.	

N

SCALE
1" = 1 MILE
1 : 63,360

PROJ. TITLE
ANADROMOUS WATERS CATALOG
ANADROMOUS WATERS ARE LISTED PURSUANT TO AS 16.05.870 (d)

MAP TITLE
SEWARD A-5

STATE OF ALASKA
DEPARTMENT OF FISH AND GAME
HABITAT DIVISION
JUNEAU, ALASKA

BY	DATE
REVISIONS	