1984 revision

84-048

ALASKA DEPT. OF FISH & GAME

AUG 11 1983

HABITAT REGIONAL OFFICE

State of Alaska
Department of Fish and Game
Public Review Nomination for Waters
Important to Anadromous Species

☑ Addition ☐ Deletion

Name of Waterbody (if known): Talkeetna River

Location:

Anadromous Waters Catalog Volume and Number _____

USGS 1:63,360 Quadrangle Talkeetna Mtns B-4, C-4, A-3

or 1:250,000 (if 1:63,360 not available) _____

Species	Date(s) Observed	Stage(s) (Spawning, Rearing, Migration)
King Salmon	7/24/83	Migration & spawning

Comments: Please provide any clarifying information in addition to identification on Anadromous Waters Catalog Public Review Maps.

Entire main river between confluence with Prairie Creek and Confluence of Yellowjacket Creek. Also includes side sloughs and branches of main river.

Observed live fish and carcasses entire length this portion, suspect additional fish further upstream.

Name of Observer (please print) Wayne A. Fleek, Fish & Wildlife Protection

Date: 8/9/83 Signature: Wayne A. Fleek

David Watsjold

ok PKW

only map observed Durand

drafted 1/84 cp

cwj

'984 revision

State of Alaska
Department of Fish and Game
Public Review Nomination for Waters
Important to Anadromous Species

☑ Addition ☐ Deletion

Name of Waterbody (if known): _____

Location:

Anadromous Waters Catalog Volume and Number _____

USGS 1:63,360 Quadrangle _____

or 1:250,000 (if 1:63,360 not available) TALKEETNA MTNS.

Species	Date(s) Observed	Stage(s) (Spawning, Rearing, Migration)
King Salmon	7/24/83	Migration & Spawning

Comments: Please provide any clarifying information in addition to identification on Anadromous Waters Catalog Public Review Maps.

All tributaries ~~of Talkeetna~~ on the South and West bank of the Talkeetna River between the confluence with Prairie Creek and a point 23 miles upstream of that confluence, on the Talkeetna River. Observed live fish and carcasses only within first ½ mile of tributaries. Streams impassable beyond that point.

Name of Observer (please print) Wayne A. Fleek, Fish & Wildlife Protection

Date: 8/9/83 Signature: Wayne A. Fleek

David Watsjold

OK PKW

*Also Vertebra & rib bones seen in lack of last 10 years (September) but species never identified before.

drafted 1/84 CP

cmg

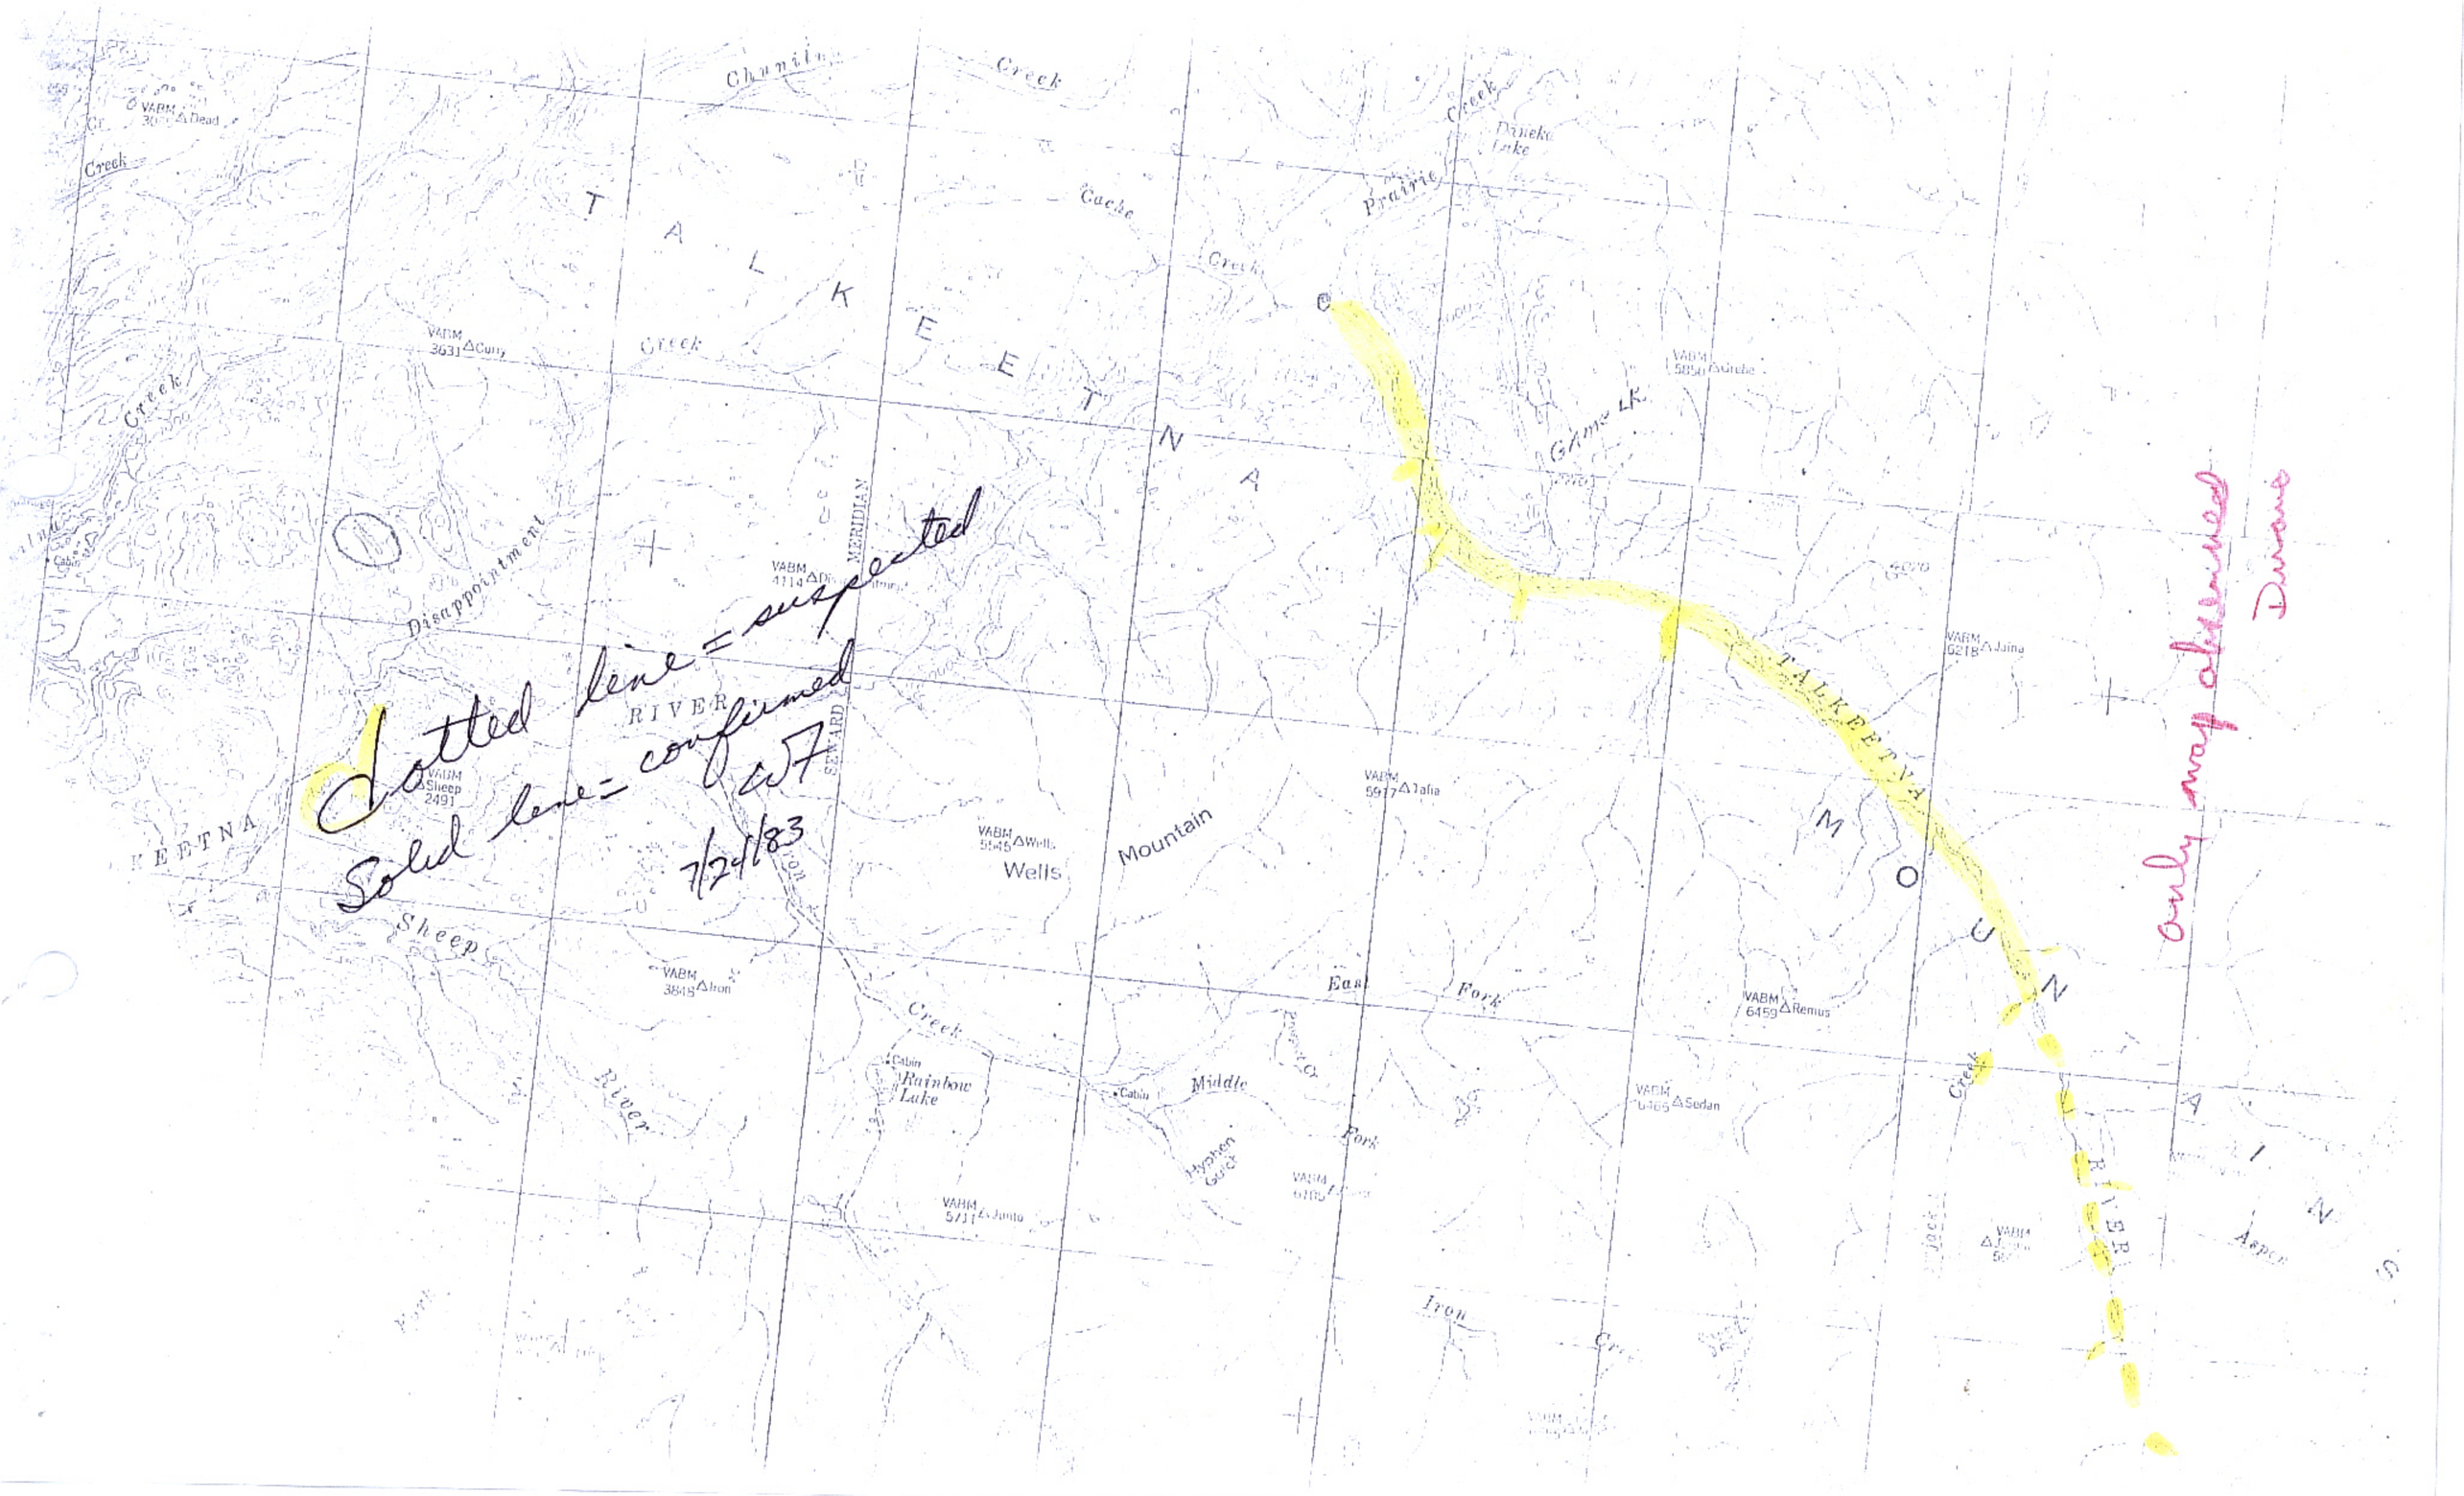
Dotted line = suspected
Solid line = confirmed
WT
7/24/83
Only map observed
Dwane
TALKEETNA
MOUNTAINS
Wells Mountain
Disappointment
RIVER
SEWARD MERIDIAN
Sheep Creek
Rainbow Lake
Middle Fork
East Fork
Iron Creek
Prairie Creek
Cache Creek
Chunilna Creek
Dineka Lake
Game Lk.
Hyphen Gulch
Aspen
VABM 3631 Curry
VABM 5850 Grebe
VABM 6218 Jaina
VABM 5917 Tafia
VABM 5545 Wells
VABM 3848 Iron
VABM 6459 Remus
VABM 6465 Sedan
VABM 5711 Junto
VABM 4114
VABM Sheep 2491
VABM 3000 Dead

TALKEETNA MOUNTAINS (B-4) QUADRANGLE

ALASKA

1:63 360 SERIES (TOPOGRAPHIC)

(TALKEETNA MTS. C-3)

149°00′ 62°30′ 698000m. E. 6931000m. N.

50′ 40′ 148°30′ 62°30′

25′ 20′

(TALKEETNA MOUNTAINS C-4)

(TALKEETNA MOUNTAINS B-5)

(TALKEETNA MOUNTAINS B-3)

(TALKEETNA MOUNTAINS A-4)

(TALKEETNA MTS. A-5)

(TALKEETNA MTS. A-3)

T A L K E E T N A M O U N T A I N S

T A L K E E T N A R I V E R

East Fork Iron Creek

Middle Fork Iron Creek

Iron Creek

Kellyrocker Creek




VABM 5705 Δ Ceeco

VABM 6555 Δ Xylic

VABM 5818 Δ Auburn

Control by USGS and USC&GS

Topography from aerial photographs by photogrammetric methods 1951 and 1958. Aerial photographs taken 1949 and 1957, field annotated 1950.
Edition of 1952 incomplete due to insufficient photo coverage
Unmapped areas completed 1958. Map not field checked

Universal Transverse Mercator projection,
1927 North American datum
1000-meter Universal Transverse Mercator grid ticks,
zone 6 , shown in blue

Unchecked elevations are shown in brown

Mapped, edited, and published by the Geological Survey

SCALE 1:63360

3000 0 3000 6000 9000 12000 15000 18000 21000 FEET

1 5 0 1 2 3 4 5 KILOMETERS

1 0 1 2 3 4 MILES

CONTOUR INTERVAL 100 FEET
DATUM IS MEAN SEA LEVEL

APPROXIMATE MEAN DECLINATION, 1950

TRUE NORTH 27° MAGNETIC NORTH

FOR SALE BY U. S. GEOLOGICAL SURVEY
FAIRBANKS, ALASKA DENVER 25, COLORADO WASHINGTON 25, D.C.
A FOLDER DESCRIBING TOPOGRAPHIC MAPS AND SYMBOLS IS AVAILABLE ON REQUEST

ALASKA

QUADRANGLE LOCATION

ROAD CLASSIFICATION

No roads or trails in this area

TALKEETNA MOUNTAINS (B-4), ALASKA
N6215-W14830/15X30

1950

6903000m. N. 418000m. E.

INTERIOR-GEOLOGICAL SURVEY, WASHINGTON, D.C.-1959
MR 0706

Solid line = Confirmed