State of Alaska
Department of Fish and Game
Public Review Nomination for Waters
Important to Anadromous Species

1984 REVISION

85-002

X Addition ____ Deletion

~~225~~ 222-50-12450

Name of Waterbody (if known): ~~see list of streams below~~

Location:

Anadromous Waters Catalog Volume and Number South Central II

USGS 1:63,360 Quadrangle Anch A-2

or 1:250,000 (if 1:63,360 not available) ____

Species	Date(s) Observed	Stage(s) (Spawning, Rearing, Migration)
Ps	7-8-81-82-83	Spawn.

Comments: Please provide any clarifying information. Also, please includ map of the area identifying the stream reach. This can be a copy of the m from the Anadromous Waters Atlas.

refer to accompanying blue-line map

Name of Observer (please print) Pete Fridgen

Date: 2-2-84 Signature: [illegible]

Carl Yanagawa 10/10/84

Address: Comm Fish Cordova

10/84 q

UNITED STATES
DEPARTMENT OF THE INTERIOR
GEOLOGICAL SURVEY

FINAL

ANCHORAGE (A-2) QUADRANGLE
ALASKA
1:63,360 SERIES (TOPOGRAPHIC)

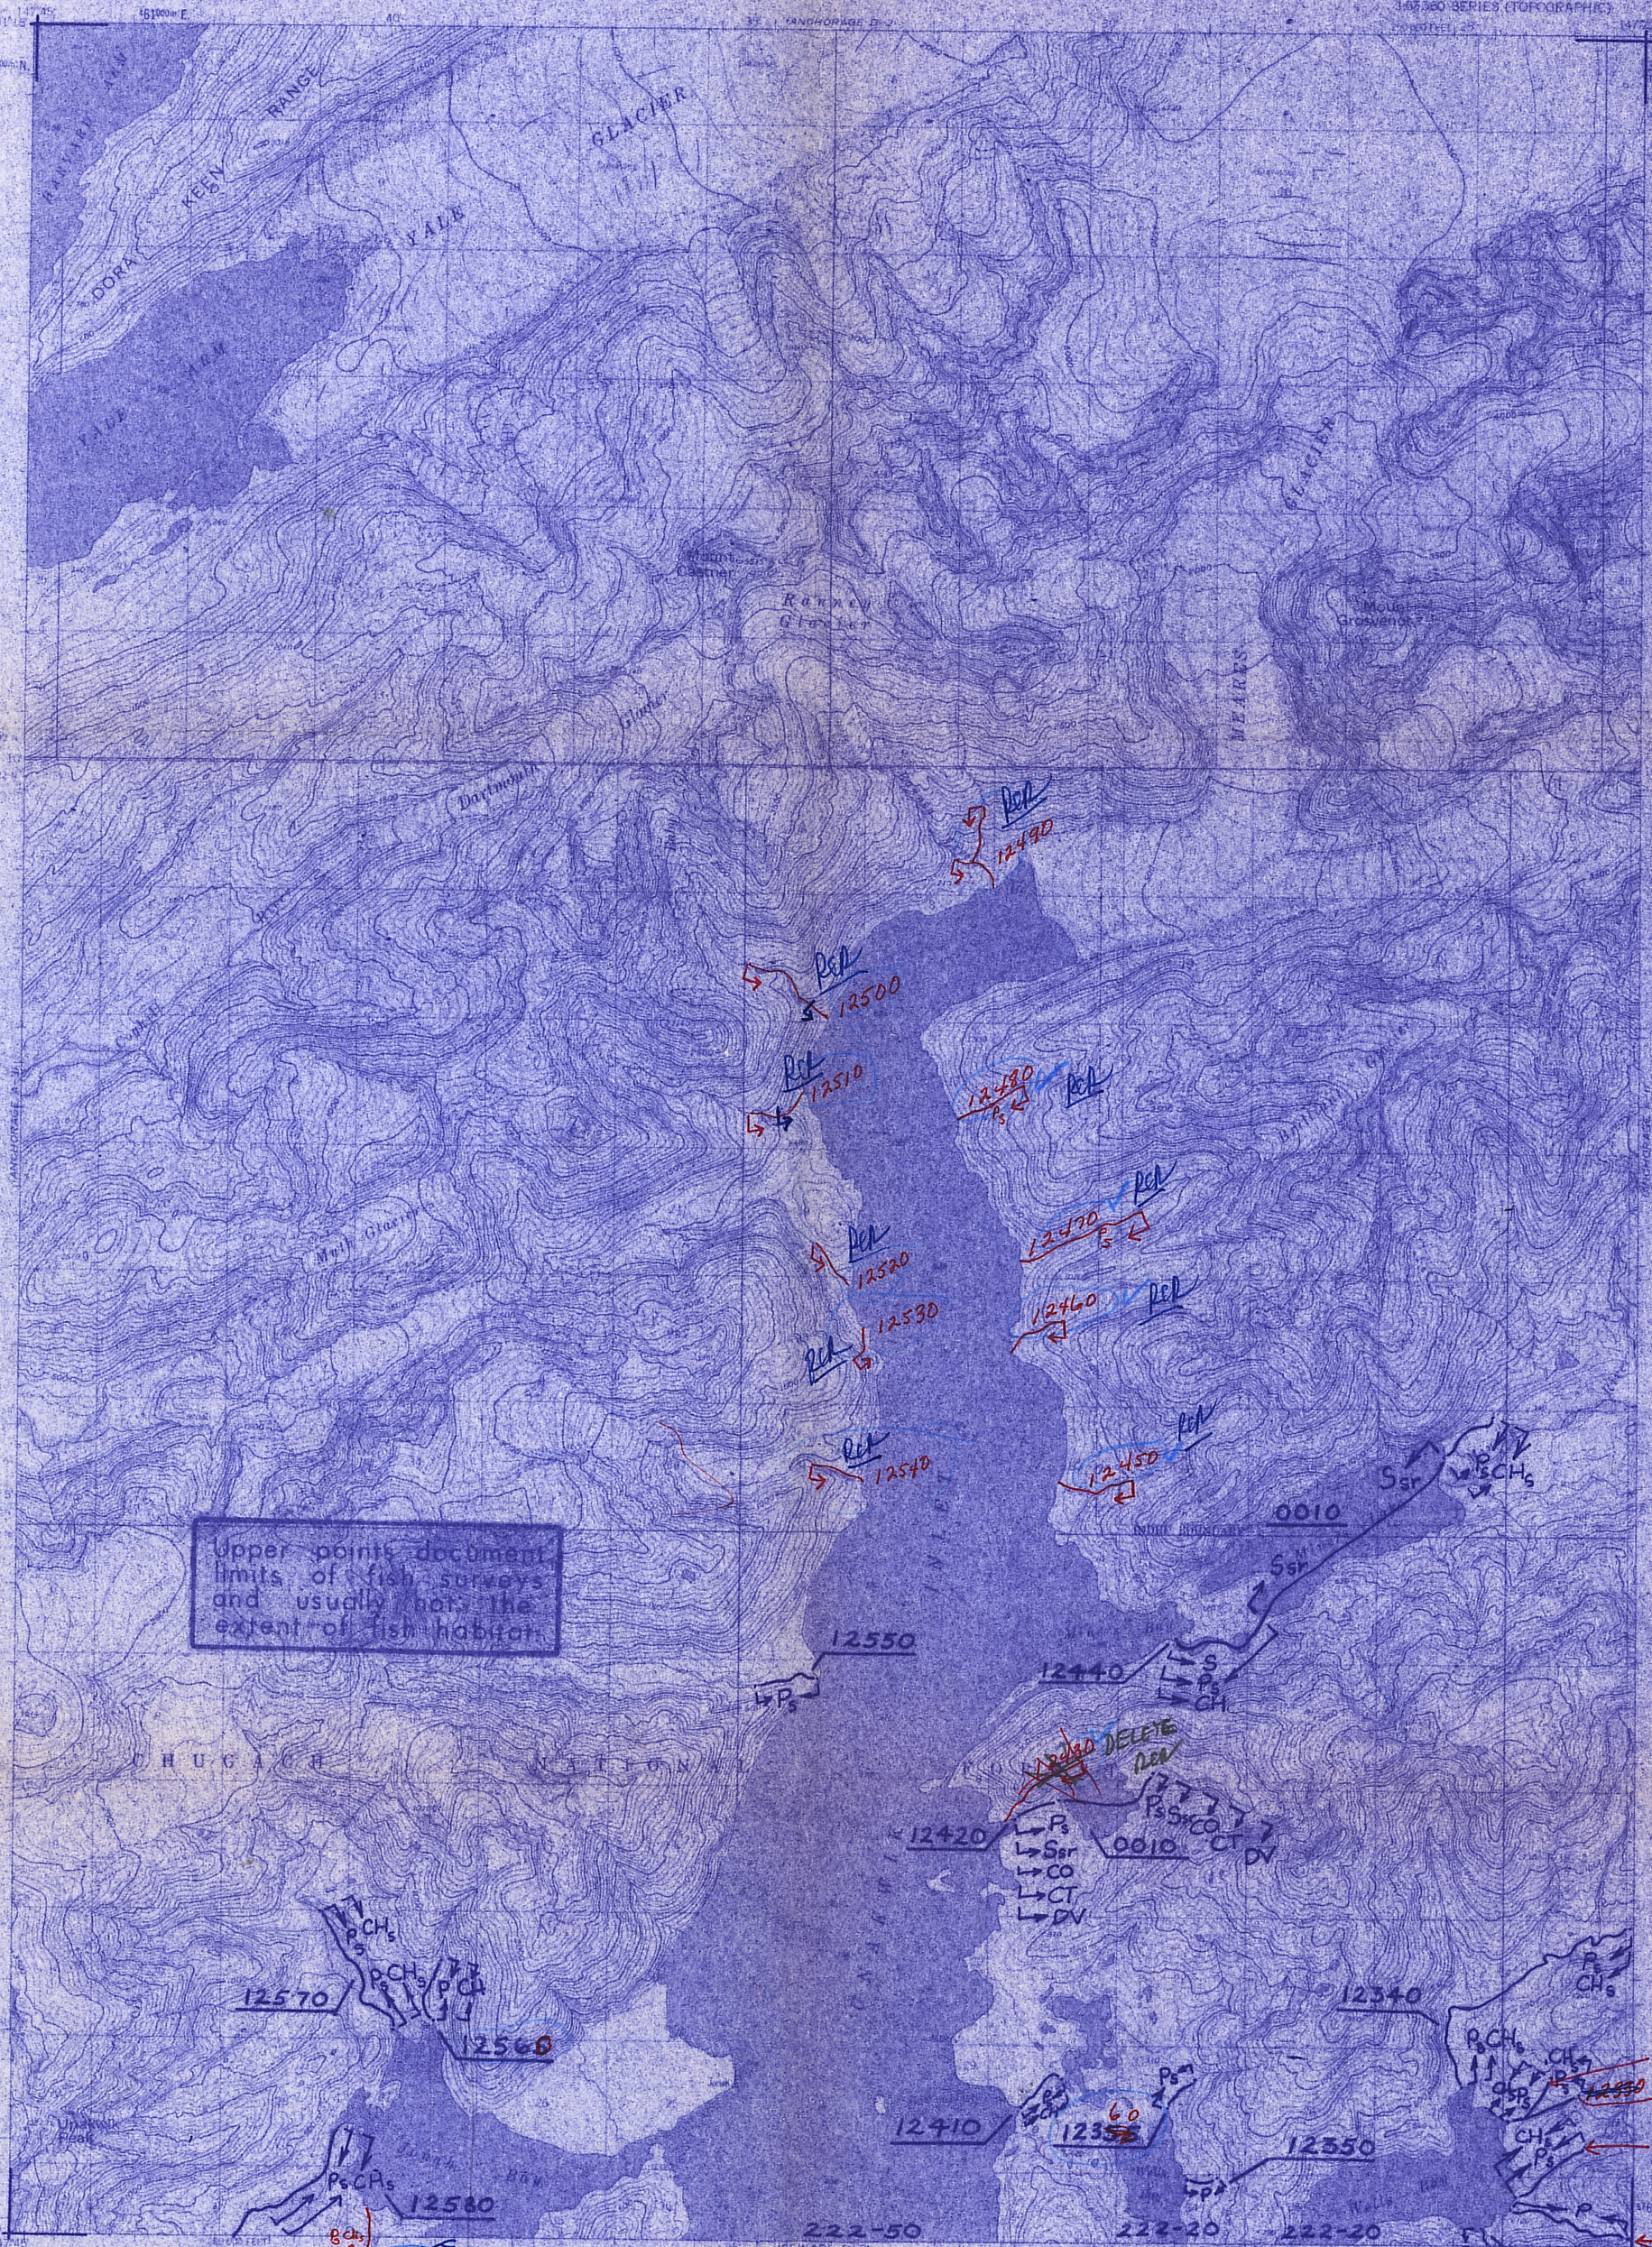

Mapped, edited, and published by the Geological Survey

Control by USGS and USC&GS

Topography by photogrammetric methods from aerial photographs taken 1950 and 1957. Field annotated 1960. Map not field checked

Selected hydrographic data compiled from USC&GS Chart 8551 (1961). This information is not intended for navigational purposes

Universal Transverse Mercator projection. 1927 North American datum
10,000-foot grid based on Alaska coordinate system, zone 3
1000-meter Universal Transverse Mercator grid ticks, zone 6, shown in blue

Land lines represent unsurveyed and unmarked locations predetermined by the Bureau of Land Management
Folio S-14 Seward Meridian

SCALE 1:63360

CONTOUR INTERVAL 100 FEET
NATIONAL GEODETIC VERTICAL DATUM OF 1929

SOUNDINGS IN FEET. DATUM IS MEAN LOWER LOW WATER
SHORELINE SHOWN REPRESENTS THE APPROXIMATE LINE OF MEAN HIGH WATER

TRUE NORTH
MAGNETIC NORTH
APPROXIMATE MEAN DECLINATION, 1960

FOR SALE BY U. S. GEOLOGICAL SURVEY
FAIRBANKS, ALASKA 99701 DENVER, COLORADO 80225 OR RESTON, VIRGINIA 22092
A FOLDER DESCRIBING TOPOGRAPHIC MAPS AND SYMBOLS IS AVAILABLE ON REQUEST

QUADRANGLE LOCATION

ROAD CLASSIFICATION
No roads or trails in this area

ANCHORAGE (A-2), ALASKA
N6100-W14722/15X22.5
1960

MAP NO.
A-2
OF
58

LEGEND

S	Sockeye Salmon
K	King Salmon
CO	Coho Salmon
P	Pink Salmon
CH	Chum Salmon
SH	Steelhead Trout
DV	Dolly Varden
AC	Arctic Char
SF	Sheefish
W	Whitefish
CT	Cutthroat Trout

Subscript
s - Known Spawning
r - Rearing
*m - Migration

*Migration upstream is assumed for stream reaches where anadromous fish occur.

COMP. DRC
DRAWN CB
REVISED DRC
APPROVED ERL
DATE 4/82
FILE NO.

N
SCALE
1" = 1 MILE
1 : 63,360

PROJ. TITLE
ANADROMOUS WATERS CATALOG
ANADROMOUS WATERS ARE LISTED PURSUANT TO AS 16.05.870 (a)

MAP TITLE
ANCHORAGE, A-2

STATE OF ALASKA
DEPARTMENT OF FISH AND GAME
habitat protection division
JUNEAU, ALASKA

BY	DATE

REVISIONS

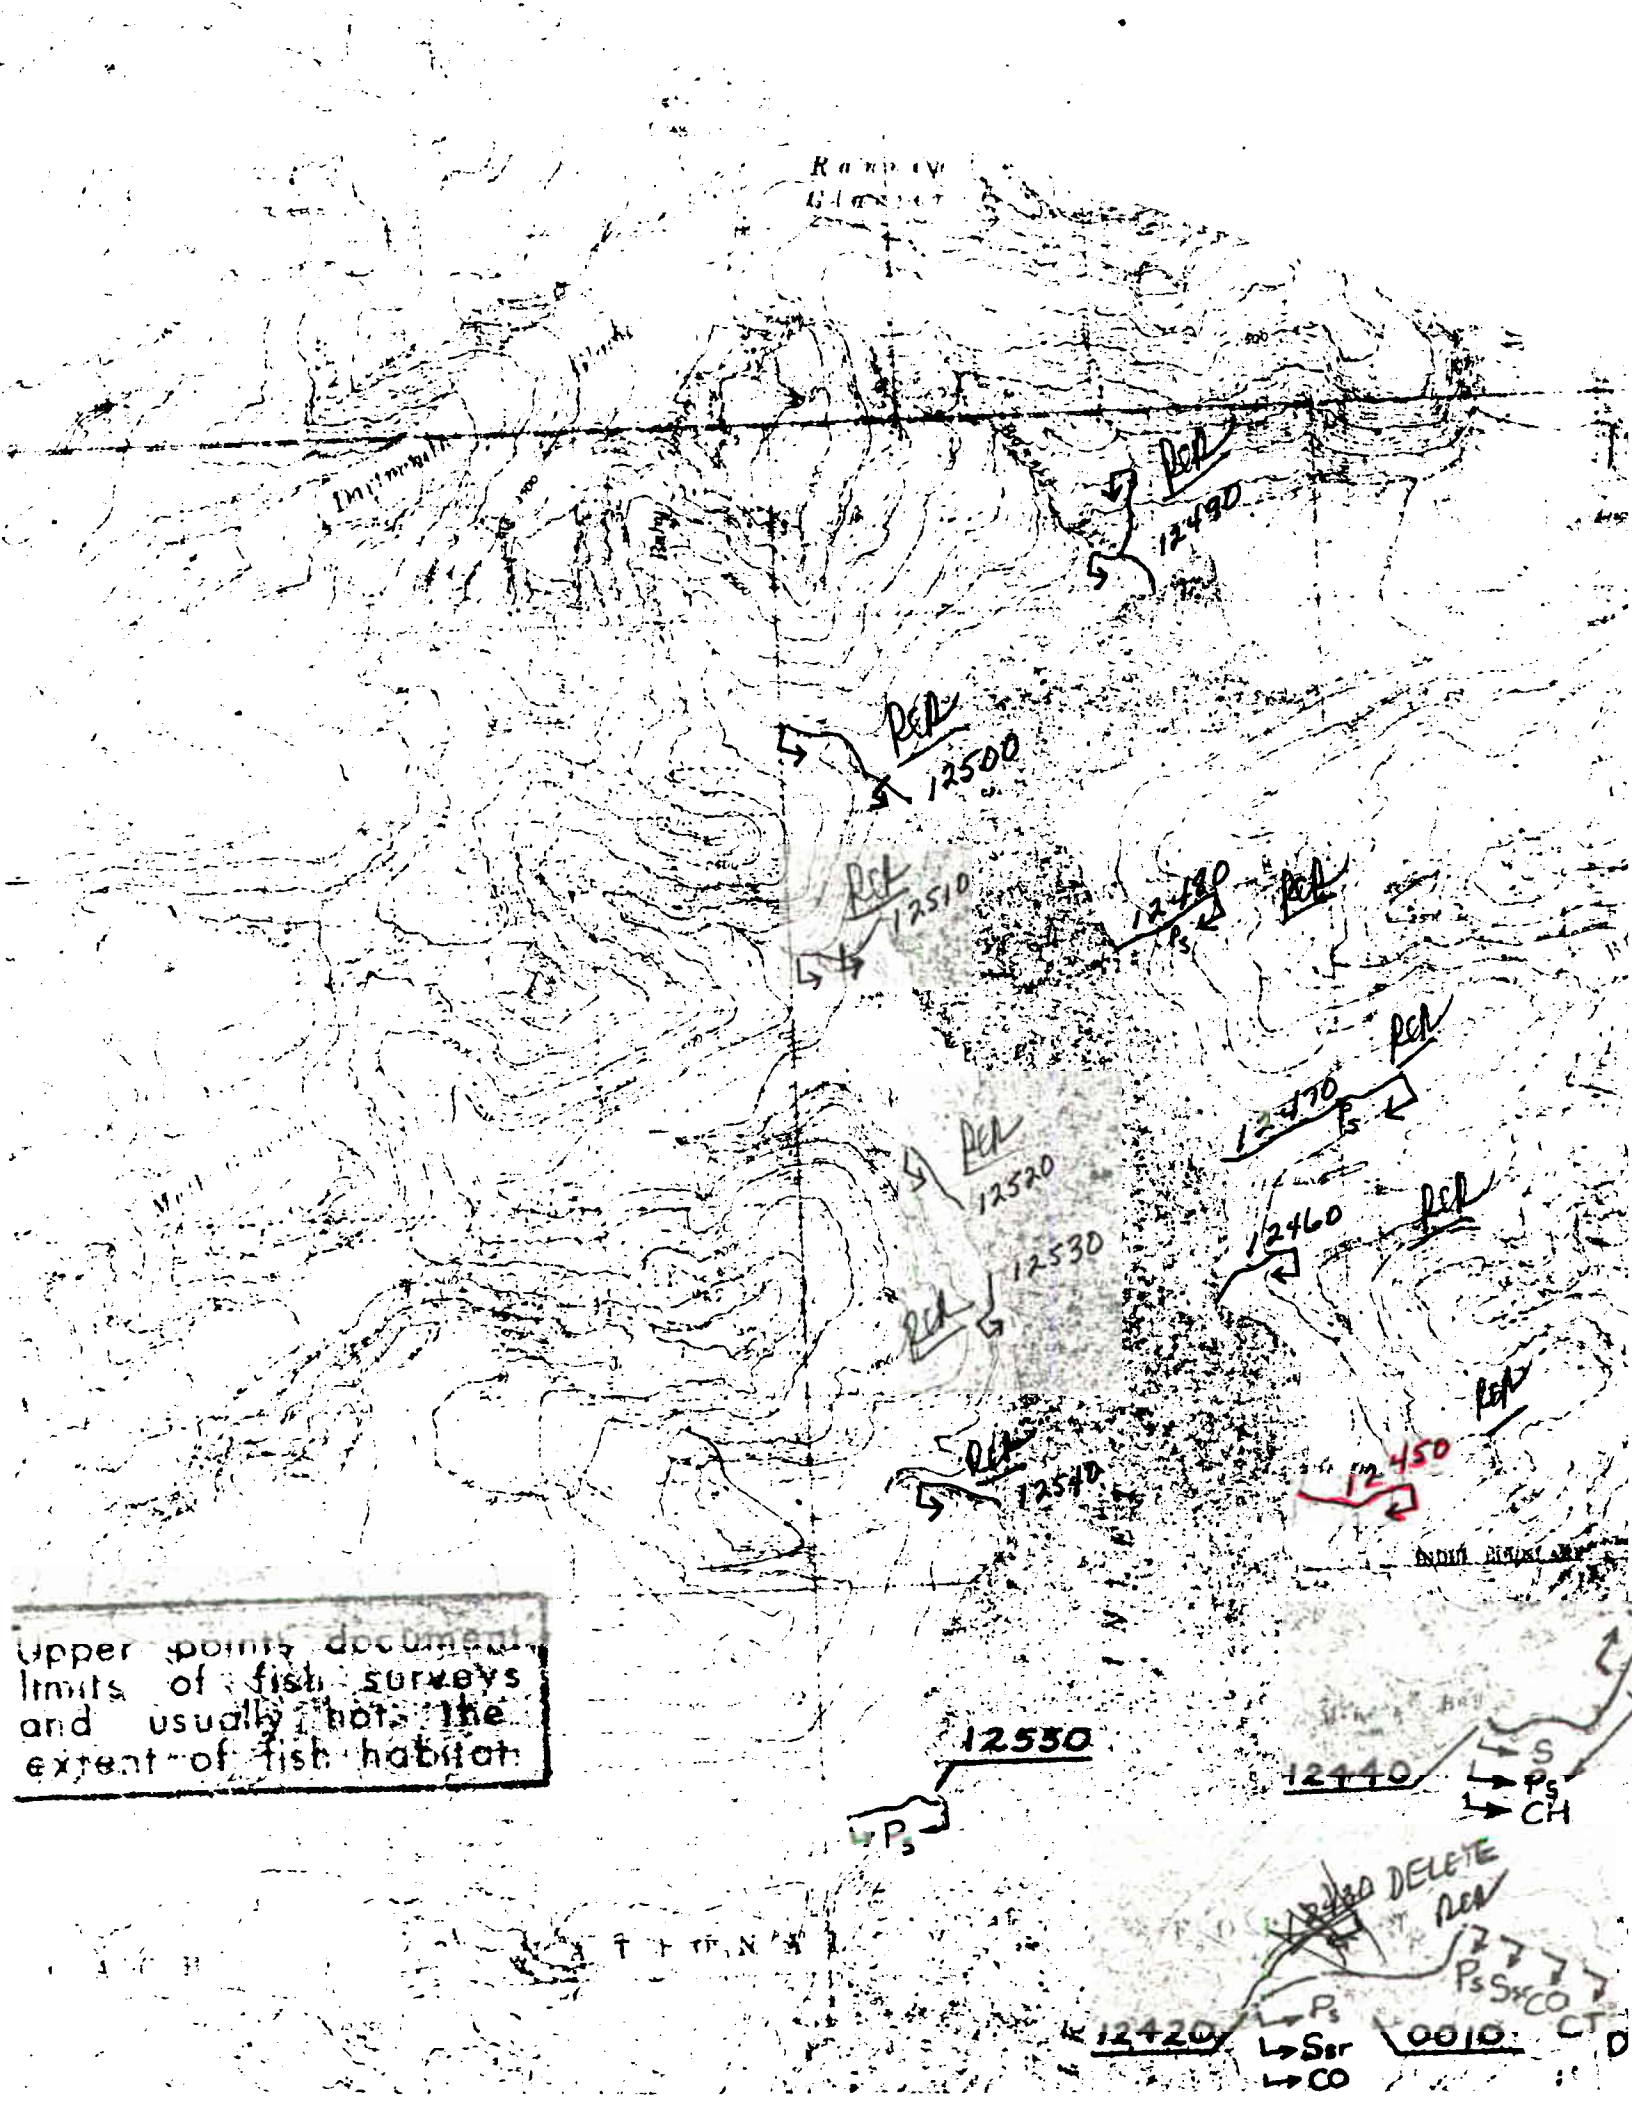

Upper points document limits of fish surveys and usually not the extent of fish habitat
12490
12500
12510
12480
12470
12520
12530
12460
12540
12450
12550
12440
12420
0010
DELETE

Upper points doc
limits of fish surveys
and usually
extent of fish habitat
12500
12440
12420
0010
DELETE