State of Alaska
Department of Fish and Game
Nomination for Waters
Important to Anadromous Fish

1985
Year of Revision
85-029

Anadromous Water Catalog Volume SC II

USGS Quad Blying Sound P-3

Name of Waterway

Anadromous Water Catalog Number of Waterway

Change to X Atlas

Catalog

Both

Addition

Deletion

Correction X

Name addition:

USGS name

Local name

ALASKA DEPT. OF FISH & GAME
OCT - 1 1984
HABITAT
REGIONAL OFFICE

For Office Use

Nomination #

Carl Yanagawa 10/10/84
Regional Supervisor Date

Drafted Date

Species	Date(s) Observed	Spawning	Rearing	Migration

Comments: Provide any clarifying information, including number of fish observed, location of fish survey data, etc.

Streams # 226-50-16700 and #226-50-16710 should have these numbers switched to fit proper sequence

Attach a copy of a map showing location of mouth and upper points of each species, specific stream reaches identified for spawning or rearing, locations of barriers, such as falls. Attach a copy of the fish survey data, if available.

Name of Observer (please print) Stewart J. Seeberg for Rich Randall

Date: 9/18/84 Signature: Stewart J. Seeberg

Address: ADF&G Habitat Div.
Anchorage

Signature of Area Biologist: Richard C. Randall

SOS 11/22/89
CP
10/84

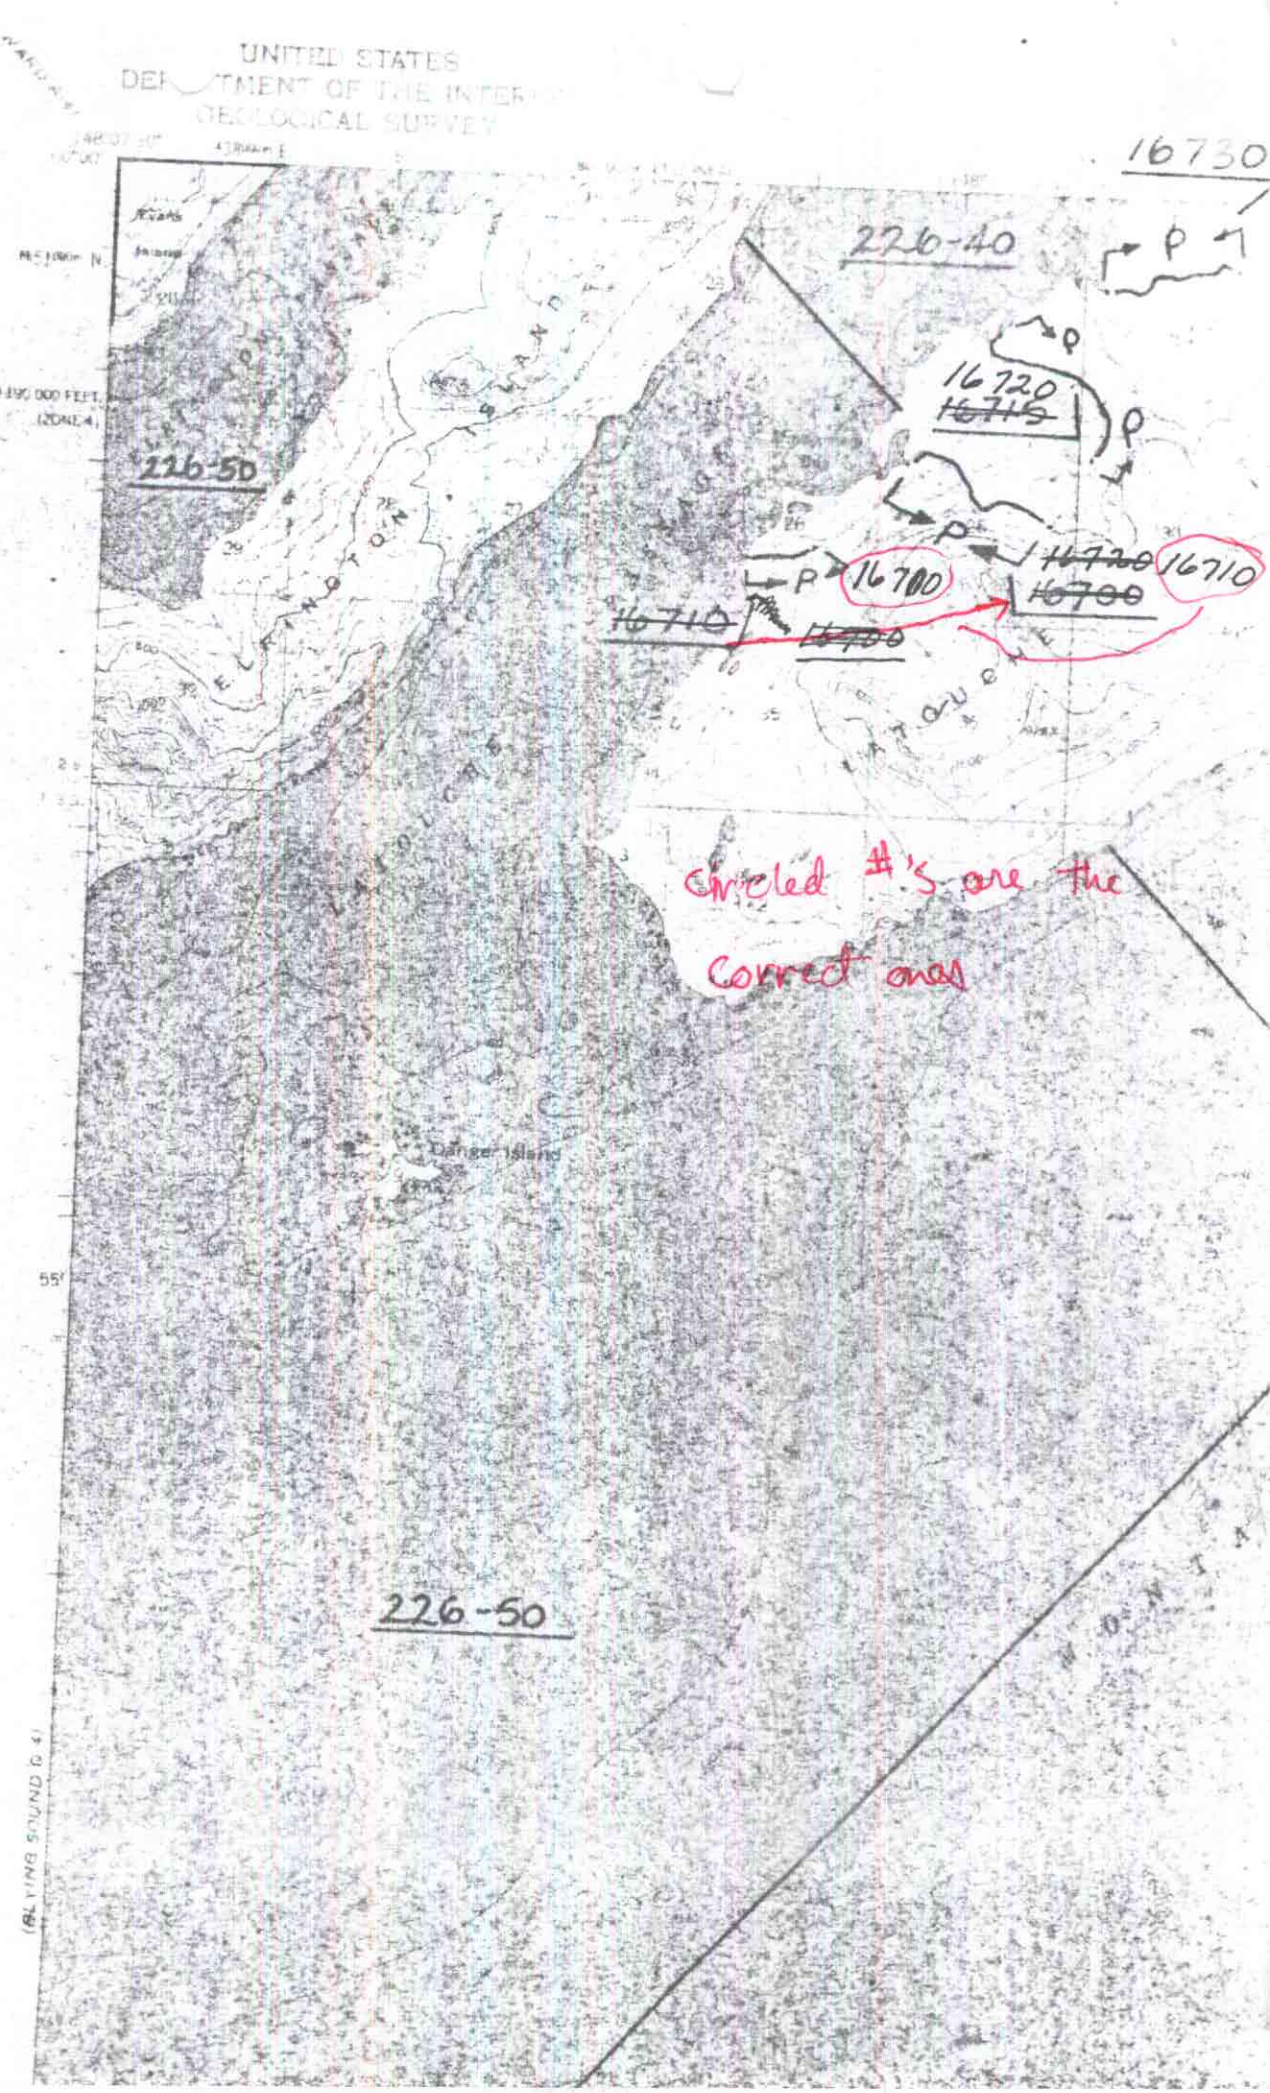
UNITED STATES
DEPARTMENT OF THE INTERIOR
GEOLOGICAL SURVEY
16730
226-40
226-50
16720
~~16715~~
16700
16710
~~16720~~
~~16700~~
~~16710~~
~~16700~~
Circled #'s are the correct ones
Danger Island
226-50

FINAL

UNITED STATES
DEPARTMENT OF THE INTERIOR
GEOLOGICAL SURVEY

BLYING SOUND (D-3) QUADRANGLE
ALASKA
1:63 360 SERIES (TOPOGRAPHIC)

Mapped, edited, and published by the Geological Survey

Control by USC&GS and USGS

Topography by photogrammetric methods from aerial photographs taken 1950. Field annotated 1953. Map not field checked.

Selected hydrographic data compiled from USC&GS Charts 8515 (1949) and 8523 (1951). This information is not intended for navigational purposes.

Universal Transverse Mercator projection; 1927 North American datum. 10,000 foot grid based on Alaska coordinate system, zones 3 and 4. 2,000-meter Universal Transverse Mercator grid ticks, zone 6, shown in blue.

Land lines represent unsurveyed and unmarked locations predetermined by the Bureau of Land Management Folio S-15, Seward Meridian.

Entire land area is within the Chugach National Forest.

TRUE NORTH
MAGNETIC NORTH
APPROXIMATE MEAN DECLINATION, 1953

SCALE 1:63 360

CONTOUR INTERVAL 100 FEET
NATIONAL GEODETIC VERTICAL DATUM OF 1929
DEPTH CURVES AND SOUNDINGS IN FEET DATUM IS MEAN LOWER LOW WATER
SHORELINE SHOWN REPRESENTS THE APPROXIMATE LINE OF MEAN HIGH WATER
THE AVERAGE RANGE OF TIDE IS APPROXIMATELY 14 FEET

FOR SALE BY U. S. GEOLOGICAL SURVEY
FAIRBANKS, ALASKA 99701, DENVER, COLORADO 80225, OR RESTON, VIRGINIA 22092
A FOLDER DESCRIBING TOPOGRAPHIC MAPS AND SYMBOLS IS AVAILABLE ON REQUEST

ROAD CLASSIFICATION
No roads or trails in this area

QUADRANGLE LOCATION

BLYING SOUND (D-3), ALASKA
N5945—W14745/15X22.5
1953

Rev. 1-12-83

RH 3/82

TM 2/82

MAP NO. D-3 OF 50

LEGEND

		Subscript
S	Sockeye Salmon	s - Known Spawning
K	King Salmon	r - Rearing
CO	Coho Salmon	*m - Migration
P	Pink Salmon	
CH	Chum Salmon	
SH	Steelhead Trout	
DV	Dolly Varden	
AC	Arctic Char	
SF	Sheefish	
W	Whitefish	
CT	Cutthroat Trout	

*Migration upstream is assumed for stream reaches where anadramous fish occur.

COMP. DRC
DRAWN
REVISED DRC
APPROVED ERL
DATE 1-82
FILE NO.

N
SCALE
1" = 1 MILE
1 : 63,360

PROJ. TITLE
ANADROMOUS WATERS CATALOG
ANADROMOUS WATERS ARE LISTED PURSUANT TO AS 16.05.870 (a)

MAP TITLE
BLYING SOUND D-3

STATE OF ALASKA
DEPARTMENT OF FISH AND GAME
habitat protection division
JUNEAU, ALASKA

BY	DATE
REVISIONS	