83-1034

State of Alaska
Department of Fish and Game
Public Review Nomination for Waters
Important to Anadromous Species

X Addition ____ Deletion

Name of Waterbody (if known): 103-40-10600 See map (2)

Location:

Anadromous Waters Catalog Volume and Number Southeast 1

USGS 1:63,360 Quadrangle Craig A-3

or 1:250,000 (if 1:63,360 not available) ____

Species	Date(s) Observed	Stage(s) (Spawning, Rearing, Migration)
Coho	81-82	m, S, R
Steelhead	81-82	m, S

Comments: Please provide any clarifying information. Also, please include a map of the area identifying the stream reach. This can be a copy of the map from the Anadromous Waters Atlas.

ptw 3/10/83

Name of Observer (please print) Don House

Date: 3/7/83 Signature: Don House

Q 3/83

Address: 415 Main St Rm 208
Ketchikan, Alaska 99901

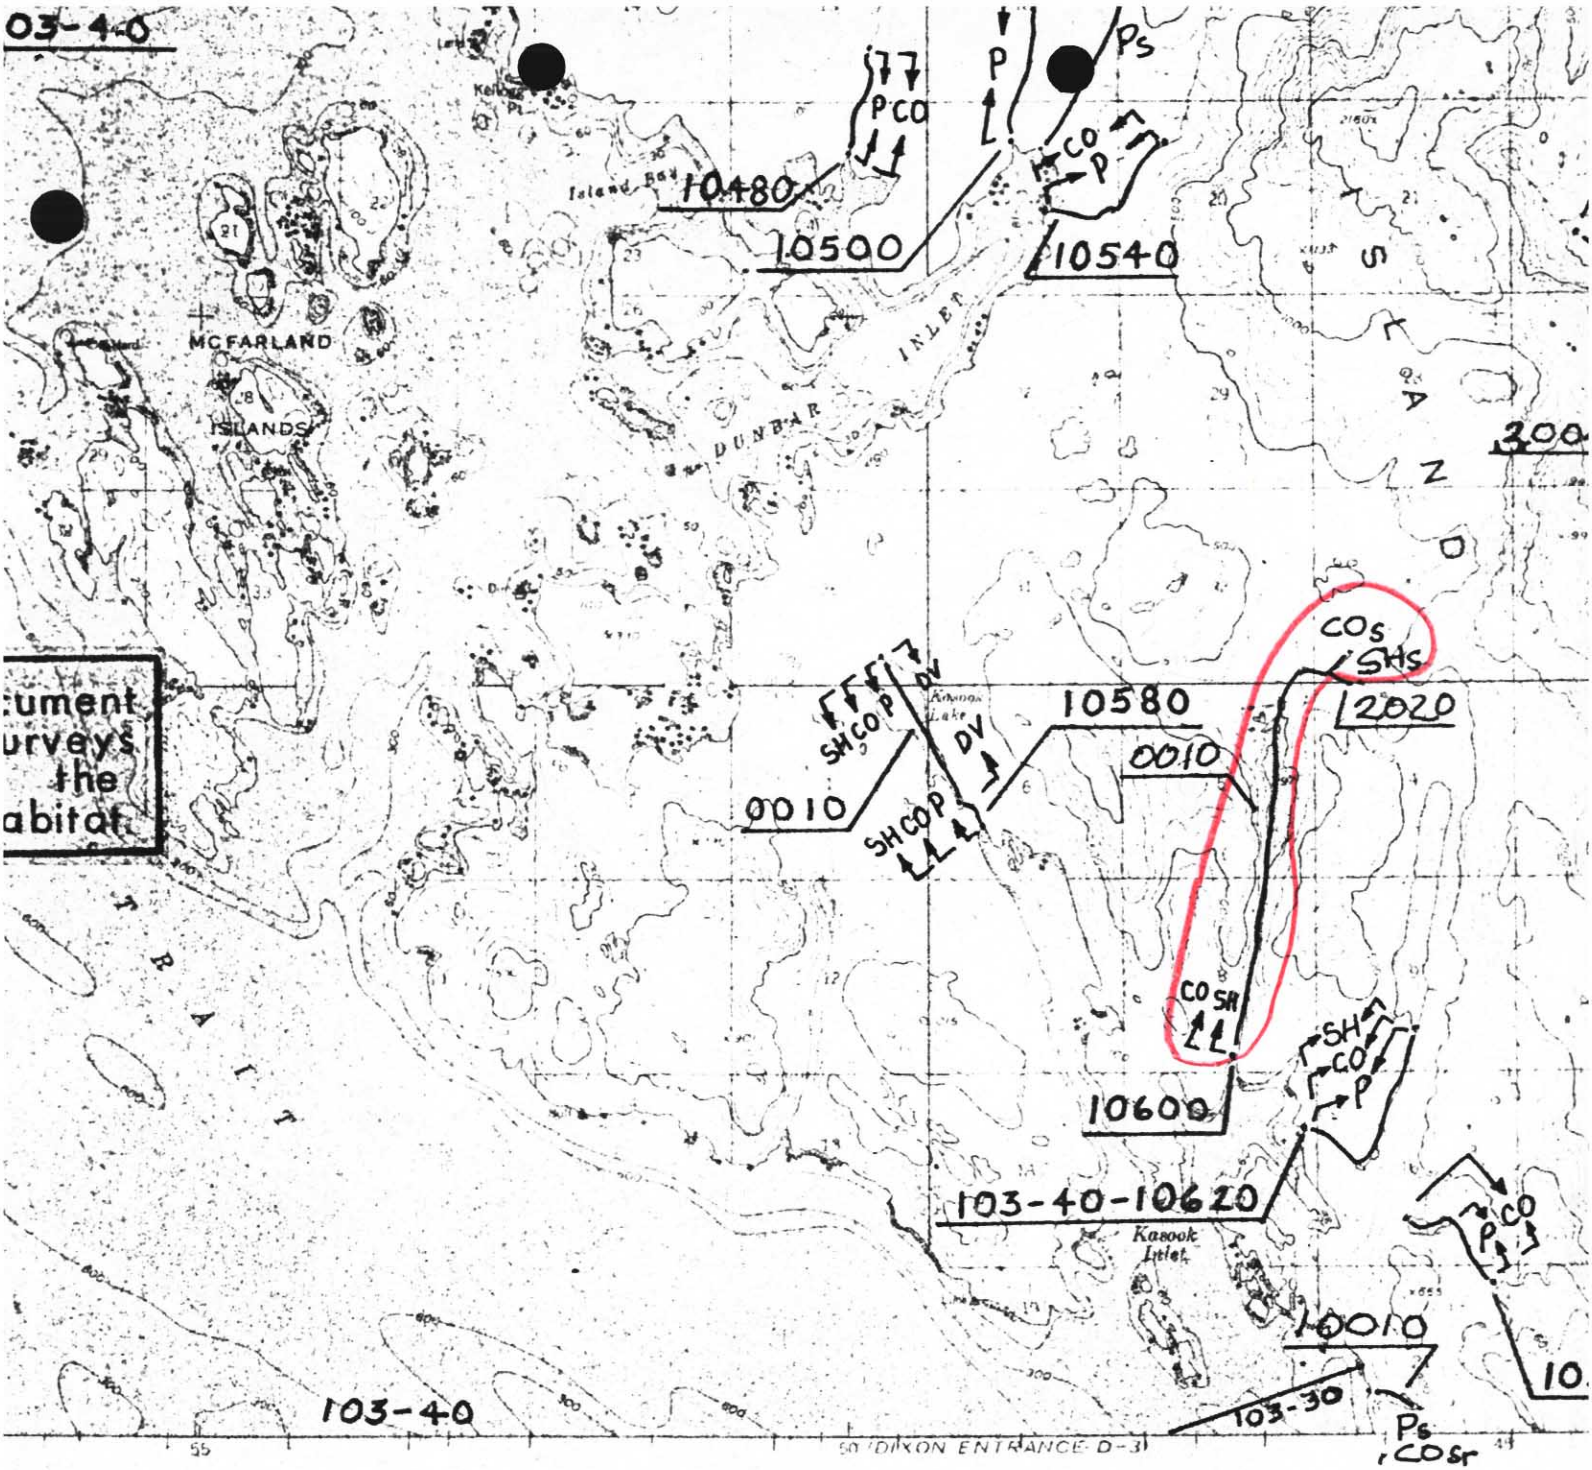

SCALE 1:63,360

CONTOUR INTERVAL 100 FEET

TRUE NORTH
MAGNETIC NORTH
APPROXIMATE MEAN DECLINATION 1951

FOR SALE BY U S GEOLOGICAL SURVEY
FAIRBANKS ALASKA 99701 DENVER, COLORADO 80225, OR RESTON, VIRGINIA 22092
A FOLDER DESCRIBING TOPOGRAPHIC MAPS AND SYMBOLS IS AVAILABLE ON REQUEST

COMP. DRC
DRAWN CB
DRC

PROJ. TITLE

ANADROMOUS STREAM CATALOG

ANADROMOUS WATERS ARE LISTED PURSUANT TO AS 16.05.870(a)

FINAL

UNITED STATES
DEPARTMENT OF THE INTERIOR
GEOLOGICAL SURVEY

CRAIG (A-3) QUADRANGLE
ALASKA
1:63360 SERIES (TOPOGRAPHIC)

133°00' 55°15' 132°40' 55°15'

528000m E.

6123000m N.

103-40 10180 6123m.N 629m.E

10390 10400 OK

10260 10240 10220 10190 10250

10410 10420 10440 10460 10480 10500 10540

10700 10690 10670 10650 10630 10600 10580 10560 10540

10150 6123m.N 648m.E 103-25

2008 2010 2005 10020

103-25-10050

2002 2004 2006 10060

2005 2007

10070 10090

103-40 103-25 103-21

0010 2020

103-40-10620

6098m.N 628m.E

103-21-10510 6098m.N 648m.E

10010

Upper points document limits of fish surveys and usually not the extent of fish habitat.

PRINCE OF WALES ISLAND

GOAT ISLAND

SUKKWAN STRAIT

TLEVAK STRAIT

DIXON ENTRANCE

Nichols Islands · Fort Islet · Corties Islands · McFARLAND ISLANDS · Dall Island · Gut Kahgulas I. · Horseshoe Island · Middle Island · Comma I. · Mushroom Island · Hydaburg · Crab Trap Cove · Signal · Panhandle · Fishhook · Deadman · Scraggy I. · Passage Island · Whisker Pt · Goat Mountain Inlet · Island Bay · Kasook Inlet · VIEW COVE · BALDY BAY · Entrance · Reef Is. · High Pt · Reef Pt · Jumbo

Topography by photogrammetric methods from aerial photographs taken 1948. Field annotated 1951. Map not field checked.

Selected hydrographic data compiled from USC&GS Charts 8147 (1957), 8148 (1962), and 8151 (1952). This information is not intended for navigational purposes.

Universal Transverse Mercator projection. 1927 North American datum. 10,000 foot grid based on Alaska coordinate system, zone 1. 1,000 meter Universal Transverse Mercator grid ticks, zone 8, shown in blue.

Land lines represent unsurveyed and unmarked locations from computations by the State of Alaska, Division of Lands. Copper River Meridian.

Entire land area is within the Tongass National Forest except Hydaburg exclusion area.

Swamps, as portrayed, indicate only the wetter areas usually of low relief, as interpreted from aerial photographs.

Lake elevations are unchecked.

APPROXIMATE MEAN DECLINATION, 1951

CONTOUR INTERVAL 100 FEET
NATIONAL GEODETIC VERTICAL DATUM OF 1929
DEPTH CURVES AND SOUNDINGS IN FEET—DATUM IS MEAN LOWER LOW WATER
SHORELINE SHOWN REPRESENTS THE APPROXIMATE LINE OF MEAN HIGH WATER
THE MEAN RANGE OF TIDE IS ABOUT 14 FEET

Compiled, edited, and published by the Geological Survey
Control by USGS and NOS/NOAA

FOR SALE BY U.S. GEOLOGICAL SURVEY
FAIRBANKS, ALASKA 99701 DENVER, COLORADO 80225, OR RESTON, VIRGINIA 22092
A FOLDER DESCRIBING TOPOGRAPHIC MAPS AND SYMBOLS IS AVAILABLE ON REQUEST

CRAIG (A-3), ALASKA
1951

mf usfs 9/16/19

DK 10/8/

MAP NO. A-3 OF 3

LEGEND

		Subscript
S	Sockeye Salmon	s - Known Spawning
K	King Salmon	r - Rearing
CO	Coho Salmon	* m - Migration
P	Pink Salmon	
CH	Chum Salmon	*Migration upstream is assumed for stream reaches where anadromous fish occur.
SH	Steelhead Trout	
DV	Dolly Varden	
AC	Arctic Char	
SF	Sheefish	
W	Whitefish	
C	Cutthroat Trout	

COMP. DRC
DRAWN CD
REVISED DRC
APPROVED ERL
DATE 4/82
FILE NO.

SCALE 1" = 1 MILE 1 : 63,360

PROJ. TITLE
ANADROMOUS STREAM CATALOG
ANADROMOUS WATERS ARE LISTED PURSUANT TO AS 16.05.870 (a)

MAP TITLE
CRAIG A-3

STATE OF ALASKA
DEPARTMENT OF FISH AND GAME
habitat protection division
JUNEAU, ALASKA

BY	DATE
PSJ	6/8/81
K Kroner	6/10/82
RD	1-17-83
REVISIONS	