State of Alaska
Department of Fish and Game
Public Review Nomination for Waters
Important to Anadromous Species

83-1110

X Addition ____ Deletion

Name of Waterbody (if known): See map (11)
103-60-10520

Location:

Anadromous Waters Catalog Volume and Number Southeast 1

USGS 1:63,360 Quadrangle Craig B-4

or 1:250,000 (if 1:63,360 not available) _____

Species	Date(s) Observed	Stage(s) (Spawning, Rearing, Migration)
Pink	81-82	m, s

Comments: Please provide any clarifying information. Also, please include a map of the area identifying the stream reach. This can be a copy of the map from the Anadromous Waters Atlas.

Name of Observer (please print) Don House

Date: 3/7/83 Signature: Don House

Address: 415 Main Street Rm 208
Ketchikan, Alaska 99901

PKW 3/10/83

Q 3/83

FINAL

CRAIG (B-4) QUADRANGLE
ALASKA
1:63360 SERIES (TOPOGRAPHIC)

133°00' (CRAIG C-3)
55°30'

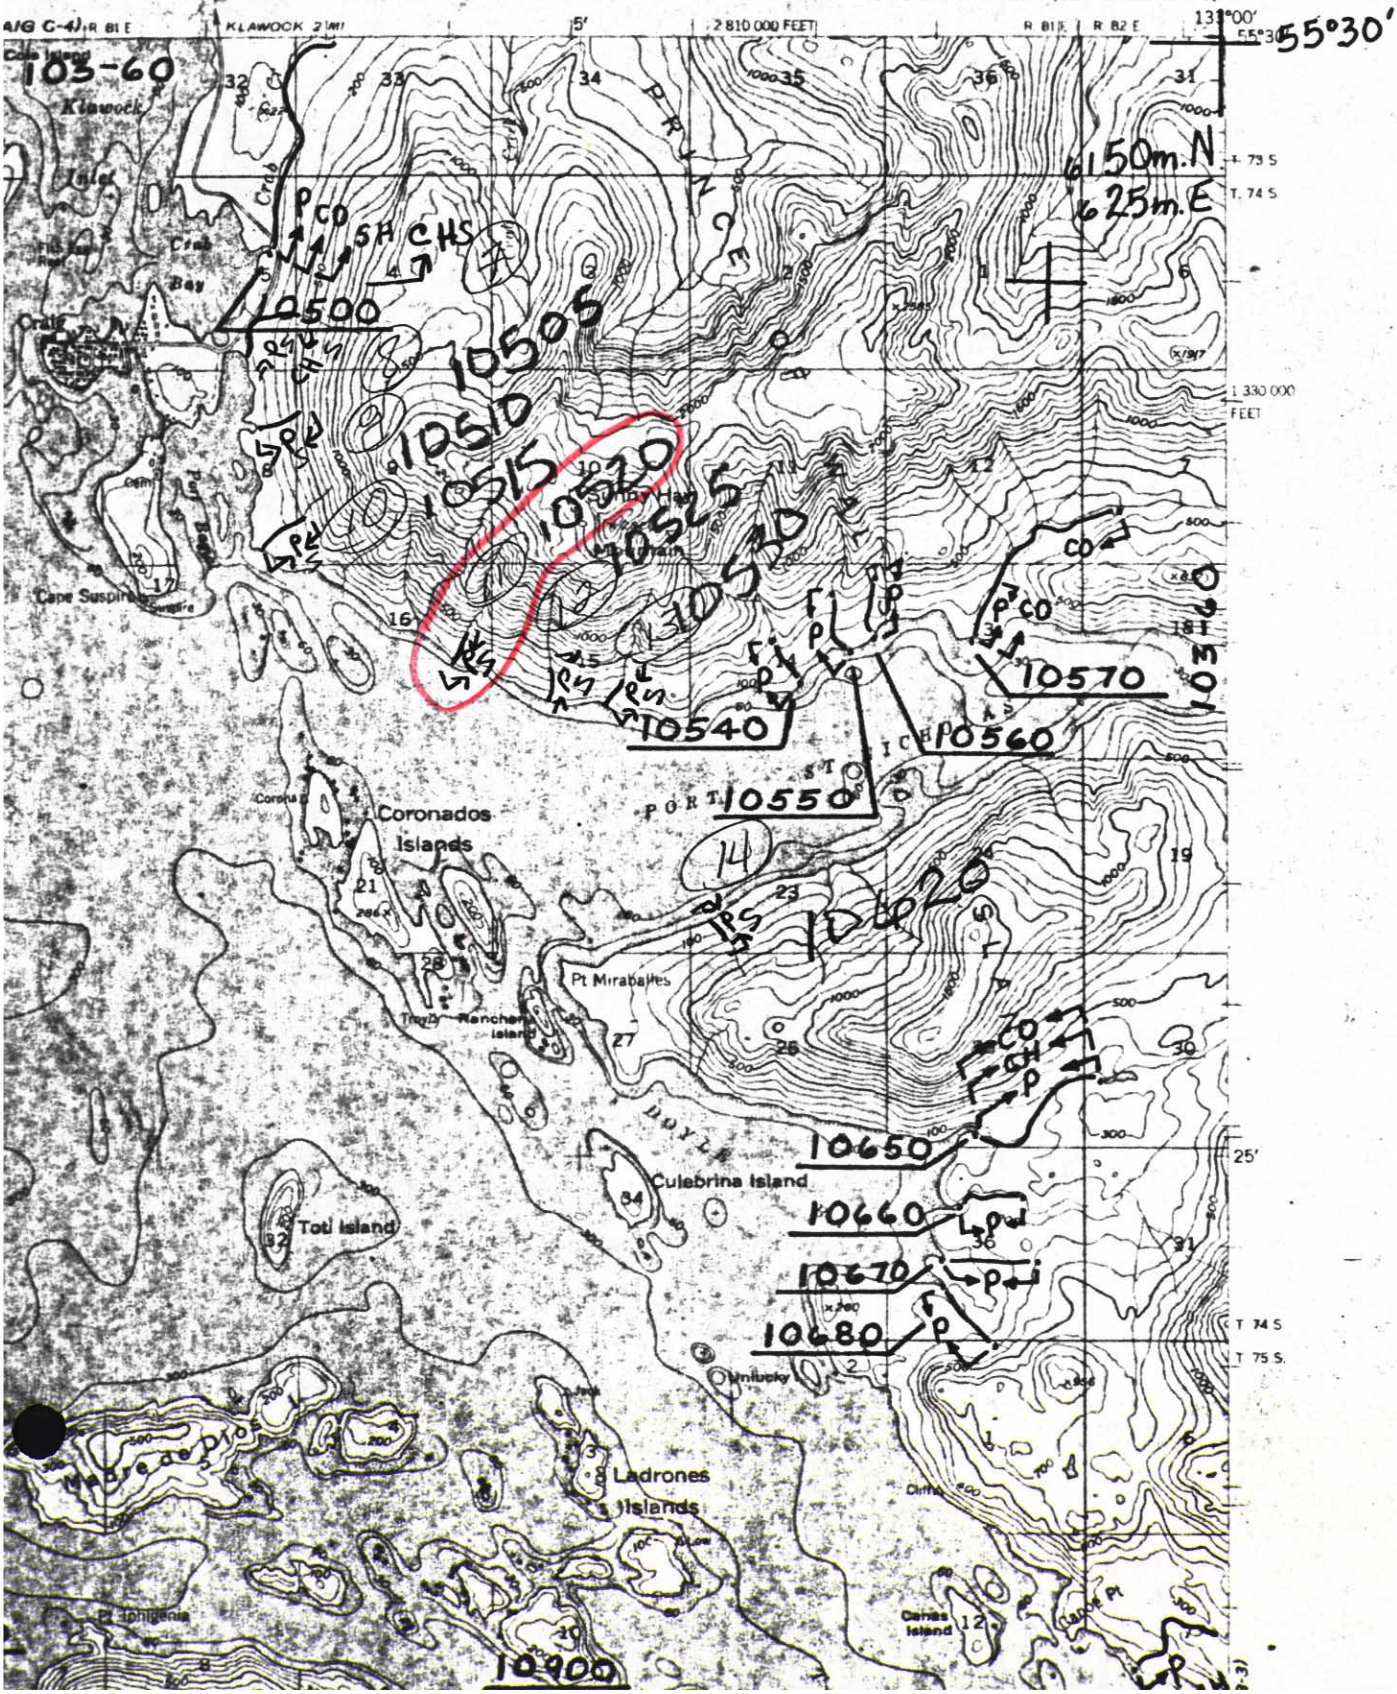

FINAL

UNITED STATES
DEPARTMENT OF THE INTERIOR
GEOLOGICAL SURVEY

CRAIG (B-4) QUADRANGLE
ALASKA
1:63360 SERIES (TOPOGRAPHIC)

Upper points document limits of fish surveys and usually not the extent of fish habitat.

Published by the Geological Survey

Control by USGS and NOS/NOAA

Topography by photogrammetric methods from aerial photographs taken 1948, field annotated 1949. Map not field checked.

Selected hydrographic data compiled from USC&GS Charts 8151 (1952), 8153 (1949) (1:20,000 scale), and 8156 (1951). This information is not intended for navigational purposes.

Universal Transverse Mercator projection, 1927 North American datum. 10,000-foot grid based on Alaska coordinate system, zone 1. 1000-meter Universal Transverse Mercator grid ticks, zone 8, shown in blue.

Land lines represent unsurveyed and unmarked locations predetermined by the State of Alaska, Division of Lands, Copper River Meridian.

Entire land area is within the Tongass National Forest with the exception of the town of Craig, exclusion area.

APPROXIMATE MEAN DECLINATION, 1949

(CRAIG A-4) 10' SCALE 1:63360

CONTOUR INTERVAL 100 FEET
NATIONAL GEODETIC VERTICAL DATUM OF 1929
DEPTH CURVES IN FEET—DATUM IS MEAN LOWER LOW WATER
SHORELINE SHOWN REPRESENTS THE APPROXIMATE LINE OF MEAN HIGH WATER
THE MEAN RANGE OF TIDE IS APPROXIMATELY 8 FEET

FOR SALE BY U. S. GEOLOGICAL SURVEY
FAIRBANKS, ALASKA 99701, DENVER, COLORADO 80225, OR RESTON, VIRGINIA 22092
A FOLDER DESCRIBING TOPOGRAPHIC MAPS AND SYMBOLS IS AVAILABLE ON REQUEST

ROAD CLASSIFICATION
Light duty ——— Unimproved dirt - - - -

QUADRANGLE LOCATION

CRAIG (B-4), ALASKA
N5515—W13300/15X20

1949
MINOR REVISIONS 1974

MAP NO. B-4 OF 3

LEGEND

S	Sockeye Salmon
K	King Salmon
CO	Coho Salmon
P	Pink Salmon
CH	Chum Salmon
SH	Steelhead Trout
DV	Dolly Varden
AC	Arctic Char
SF	Sheefish
W	Whitefish
C	Cutthroat Trout

Subscript
s - Known Spawning
r - Rearing
* m - Migration

*Migration upstream is assumed for stream reaches where anadromous fish occur.

COMP. DRC
DRAWN CD
REVISED DRC
APPROVED ERL
DATE 4/82
FILE NO.

SCALE 1" = 1 MILE 1 : 63,360

PROJ. TITLE
ANADROMOUS STREAM CATALOG
ANADROMOUS WATERS ARE LISTED PURSUANT TO AS 16.05.870 (a)

MAP TITLE
CRAIG B-4

STATE OF ALASKA
DEPARTMENT OF FISH AND GAME
habitat protection division
JUNEAU, ALASKA

BY	DATE
PSD	6/8/81
K. Francisco	6/10/81
PD	1-17-83
REVISIONS	

MP USFS 9/16/82

DK 10/8/