83-1120

State of Alaska
Department of Fish and Game
Public Review Nomination for Waters
Important to Anadromous Species

X Addition ____ Deletion

Name of Waterbody (if known): See map (5)
104-30-10497

Location:

Anadromous Waters Catalog Volume and Number Southeast 1

USGS 1:63,360 Quadrangle Craig B-5

or 1:250,000 (if 1:63,360 not available) _____

Species	Date(s) Observed	Stage(s) (Spawning, Rearing, Migration)
Pink	81-82	m, s

Comments: Please provide any clarifying information. Also, please include a map of the area identifying the stream reach. This can be a copy of the map from the Anadromous Waters Atlas.

Name of Observer (please print) Don House

Date: 3/7/83 Signature: Don House

Address: 415 Main St Rm 208
Ketchikan Alaska 99901

PKW 3/10/83

4 3/83

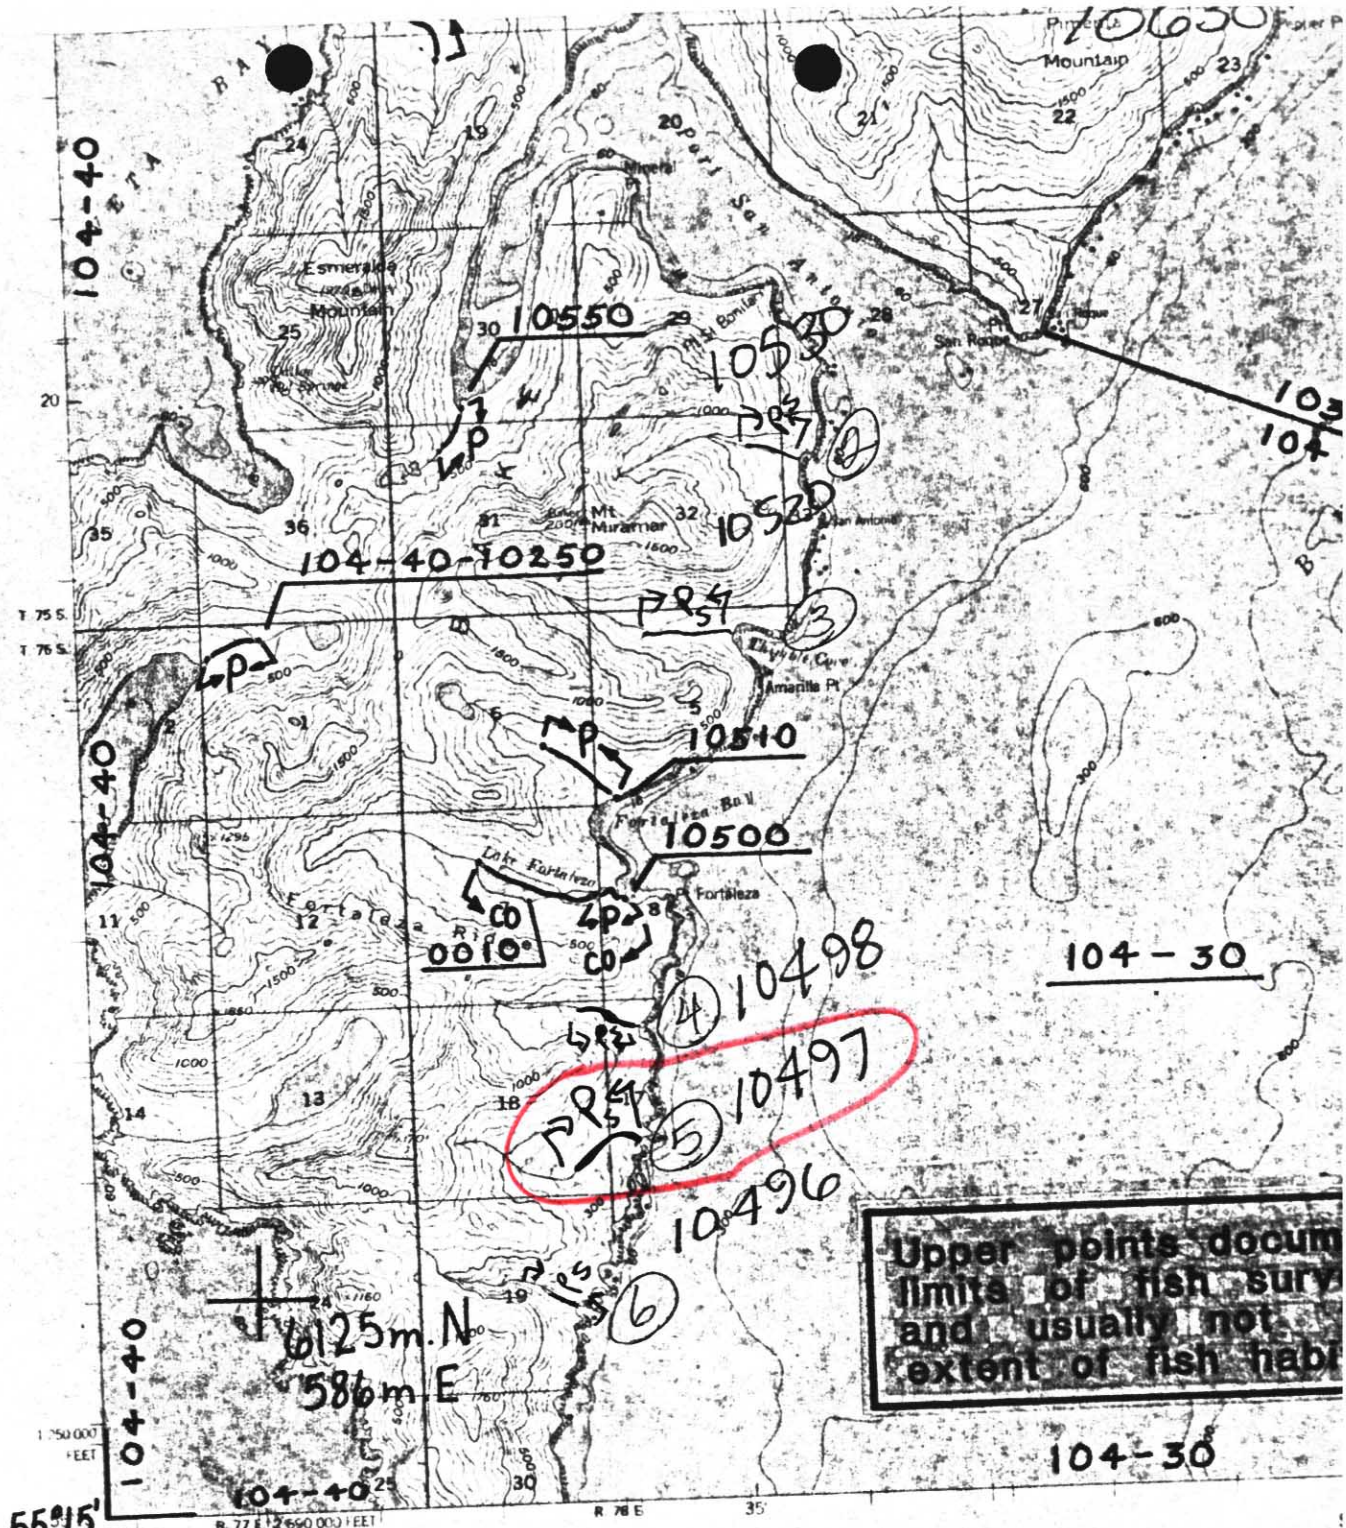

MP USFS 9/16/81

Mapped, edited, and published by the Geological Survey

Control by USC&GS

Topography by photogrammetric methods from aerial photographs taken 1948. Map not field checked

Shoreline hydrographic data compiled from USC&GS Charts [illegible] 8158 (1952). This information is not intended [illegible] nautical purposes

[illegible] Transverse Mercator projection. 1927 North American datum

[illegible] grid based on Alaska coordinate system, zone 1

[illegible] meter Universal Transverse Mercator grid ticks

[illegible] in blue

Land lines represent unsurveyed and unmarked locations predetermined by the State of Alaska, Division of Lands Copper River Meridian

Entire land area is within the Tongass National Forest

TRUE NORTH
MAGNETIC NORTH
APPROXIMATE MEAN DECLINATION, 1948

CONTO
DA
DEPTH CURVES IN FI
THE AVERAGE

FOR SALE BY
FAIRBANKS, ALASKA 99701, DENVER
A FOLDER DESCRIBING TOPOGRAPH

MAP NO. 3-5

LEGEND

S	Sockeye Salmon
K	King Salmon
CO	Coho Salmon
P	Pink Salmon

Subscript
s- Known Spawning
r- Rearing

COMP. DRC
DRAWN CB
REVISED DRC

PROJ. TITLE
ANADRO
ANADROMOUS

UNITED STATES
DEPARTMENT OF THE INTERIOR

CRAIG (B-5) QUADRANGLE
ALASKA
1:63,360 SERIES

133°40' 55°30' 133°20' 55°30'

103-70 10450 10430 10400 10380 10350 10360 10800 10810 10790 10770 10750 10670 10660 10640 10600 10570 10200 10550 10530 10520 10510 10500 10010 10498 10497 10496 10630 10610 10620 10150 10650 10830 2009 2004 2003 10090 10110 10920 10130 10900 10890 10070 10740 10720 10170 10150 2002 10100 10160 10050 10600 10570 2007 2003 10480 103-50 104-40 104-30 10250

6150m.N 586m.E

6150m.N 604m.E

6125m.N 586m.E

6125m.N 604m.E

this is not 2 streams it flows into Port San Antonio

Upper points document limits of fish surveys and usually not the extent of fish habitat.

Mapped, edited, and published by the Geological Survey

Control by USC&GS

Topography by photogrammetric methods from aerial photographs taken 1948. Map not field checked

Selected hydrographic data compiled from USC&GS Charts 8152 and 8158 (1952). This information is not intended for navigational purposes

Universal Transverse Mercator projection, 1927 North American datum
10,000-foot grid based on Alaska coordinate system, zone 1
1,000-meter Universal Transverse Mercator grid ticks, zone 8, shown in blue

Land lines represent unsurveyed and unmarked locations predetermined by the State of Alaska, Division of Lands, Copper River Meridian

Entire land area is within the Tongass National Forest

SCALE 1:63360

CONTOUR INTERVAL 100 FEET
DATUM IS MEAN SEA LEVEL
DEPTH CURVES IN FEET—DATUM IS MEAN LOWER LOW WATER
SHORELINE SHOWN REPRESENTS THE APPROXIMATE LINE OF MEAN HIGH WATER
THE AVERAGE RANGE OF TIDE IS APPROXIMATELY 13 FEET

APPROXIMATE MEAN DECLINATION, 1948

ROAD CLASSIFICATION
No roads or trails in this area

QUADRANGLE LOCATION

CRAIG (B-5), ALASKA
N5515—W13320/15X20
1948

FOR SALE BY U. S. GEOLOGICAL SURVEY
FAIRBANKS, ALASKA 99701, DENVER, COLORADO 80225, OR WASHINGTON, D. C. 20242
A FOLDER DESCRIBING TOPOGRAPHIC MAPS AND SYMBOLS IS AVAILABLE ON REQUEST

MAP USFS 9/16/81

DK 10/81

MAP NO. B-5 OF 3

LEGEND

S	Sockeye Salmon
K	King Salmon
CO	Coho Salmon
P	Pink Salmon
CH	Chum Salmon
SH	Steelhead Trout
DV	Dolly Varden
AC	Arctic Char
SF	Sheefish
W	Whitefish
C	Cutthroat Trout

Subscript
s- Known Spawning
r- Rearing
* m-Migration

*Migration upstream is assumed for stream reaches where anadromous fish occur.

COMP. DRC
DRAWN CB
REVISED DRC
APPROVED ERL
DATE 4/82
FILE NO.

SCALE 1" = 1 MILE 1 : 63,360

PROJ. TITLE
ANADROMOUS STREAM CATALOG
ANADROMOUS WATERS ARE LISTED PURSUANT TO AS 16.05.870 (a)

MAP TITLE
CRAIG B-5

STATE OF ALASKA
DEPARTMENT OF FISH AND GAME
habitat protection division
JUNEAU, ALASKA

BY	DATE
PSU	6/8/81
R. Francisco	6/16/81
RD	H-1783

REVISIONS