83-1140

State of Alaska
Department of Fish and Game
Public Review Nomination for Waters
Important to Anadromous Species

X Addition ____ Deletion

Name of Waterbody (if known): See map (5) 102-70-10530

Location:

Anadromous Waters Catalog Volume and Number Southeast 1

USGS 1:63,360 Quadrangle Craig C-2

or 1:250,000 (if 1:63,360 not available) ____

Species	Date(s) Observed	Stage(s) (Spawning, Rearing, Migration)
Pink	81-82	m, S
Coho	81-82	m, S, R

Comments: Please provide any clarifying information. Also, please include a map of the area identifying the stream reach. This can be a copy of the map from the Anadromous Waters Atlas.

Name of Observer (please print) Don House

Date: 3/7/83 Signature: Don House

Address: 415 Main St Rm 208
Ketchikan, Alaska 99901

PKW 3/10/83

CP 3/83

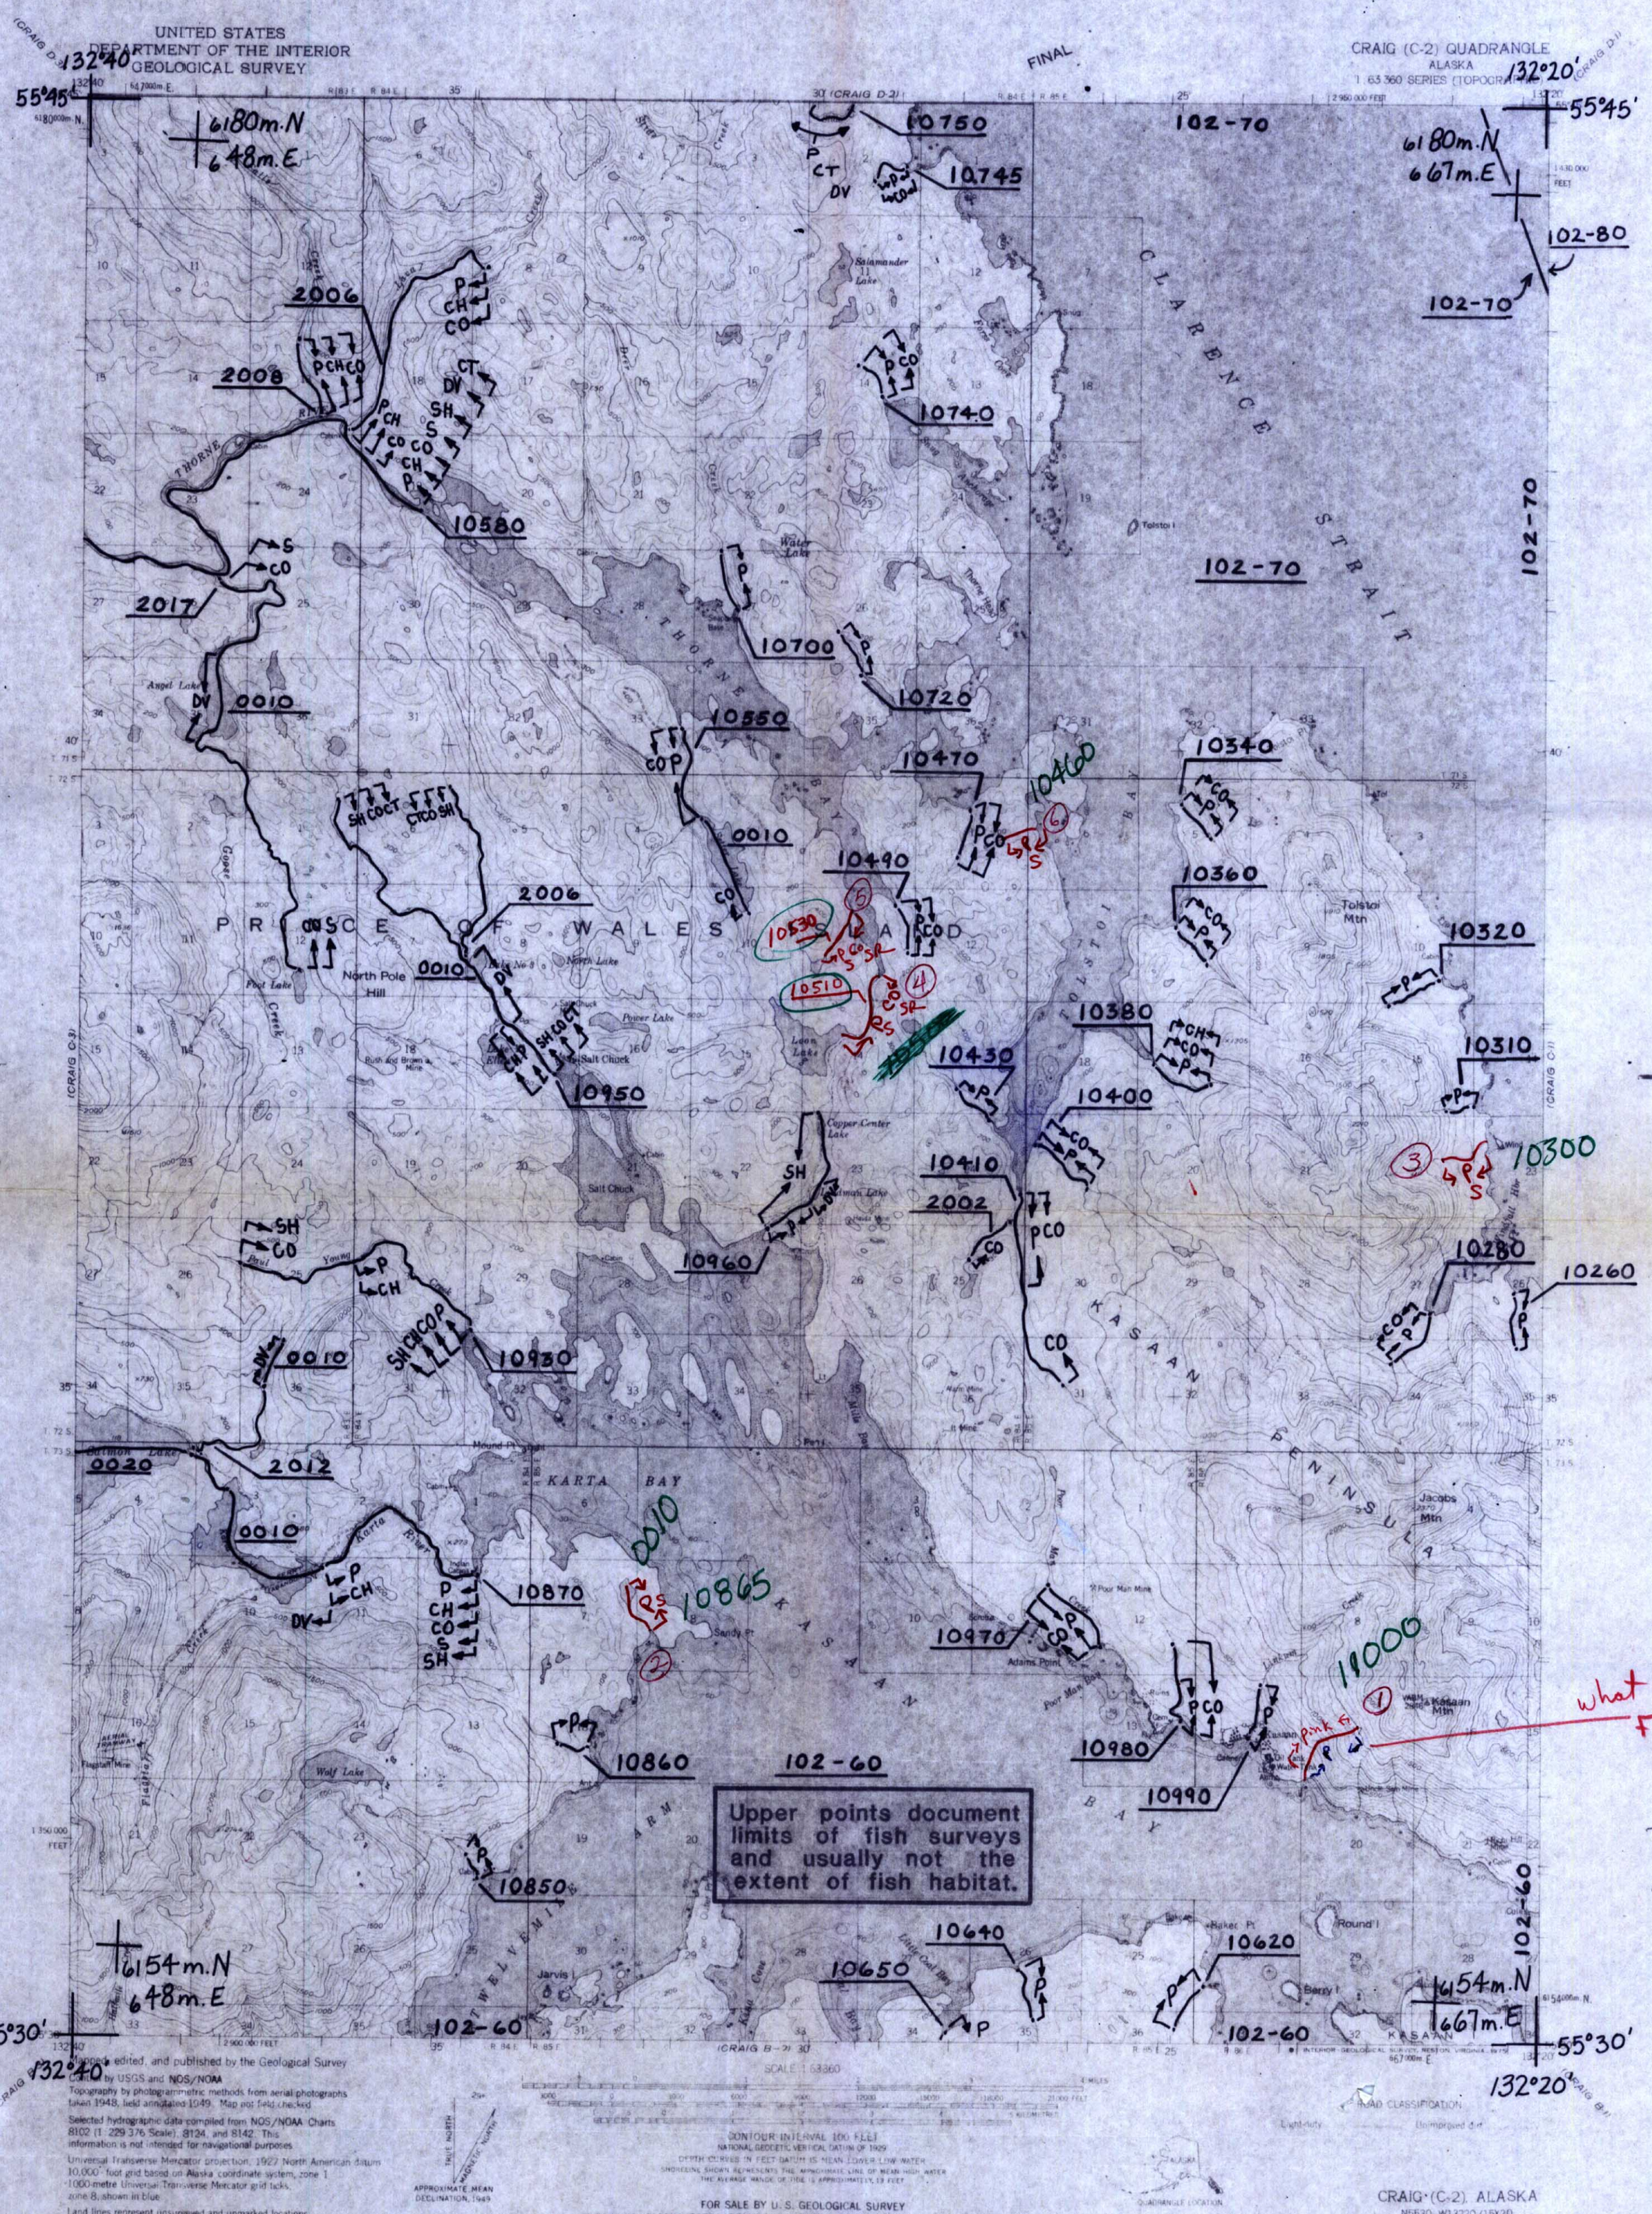
UNITED STATES
DEPARTMENT OF THE INTERIOR
GEOLOGICAL SURVEY
FINAL
CRAIG (C-2) QUADRANGLE
ALASKA
83-1136
CLARENCE STRAIT
THORNE BAY
PRINCE OF WALES ISLAND
KASAAN BAY
KASAAN PENINSULA
KARTA BAY
Upper points document limits of fish surveys and usually not the extent of fish habitat.
what kind of Fish ?
DK 10/87
MP 4585 9/16/81
Mapped, edited, and published by the Geological Survey
Control by USGS and NOS/NOAA
Topography by photogrammetric methods from aerial photographs taken 1948, field annotated 1949. Map not field checked.
Selected hydrographic data compiled from NOS/NOAA Charts 8102 (1:229 376 Scale), 8124, and 8142. This information is not intended for navigational purposes.
Universal Transverse Mercator projection, 1927 North American datum
10,000-foot grid based on Alaska coordinate system, zone 1
1000-metre Universal Transverse Mercator grid ticks, zone 8, shown in blue
Land lines represent unsurveyed and unmarked locations predetermined by the Bureau of Land Management, Copper River Meridian.
Entire land area is within the Tongass National Forest except Kasaan exclusion area.
SCALE 1:63360
CONTOUR INTERVAL 100 FEET
NATIONAL GEODETIC VERTICAL DATUM OF 1929
DEPTH CURVES IN FEET DATUM IS MEAN LOWER LOW WATER
SHORELINE SHOWN REPRESENTS THE APPROXIMATE LINE OF MEAN HIGH WATER
THE AVERAGE RANGE OF TIDE IS APPROXIMATELY 13 FEET
APPROXIMATE MEAN DECLINATION, 1949
FOR SALE BY U. S. GEOLOGICAL SURVEY
FAIRBANKS, ALASKA 99701, DENVER, COLORADO 80225, OR RESTON, VIRGINIA 22092
A FOLDER DESCRIBING TOPOGRAPHIC MAPS AND SYMBOLS IS AVAILABLE ON REQUEST
CRAIG (C-2), ALASKA
N5530-W13220/15X20
1949
MAP NO. C-2 OF 3
LEGEND
S Sockeye Salmon
K King Salmon
CO Coho Salmon
P Pink Salmon
CH Chum Salmon
SH Steelhead Trout
DV Dolly Varden
AC Arctic Char
SF Sheefish
W Whitefish
C Cutthroat Trout
Subscript
s- Known Spawning
r- Rearing
* m- Migration
*Migration upstream is assumed for stream reaches where anadromous fish occur.
COMP. DRC
DRAWN
REVISED DRC
APPROVED EAL
DATE 4/82
FILE NO.
SCALE 1" = 1 MILE 1 : 63,360
PROJ. TITLE
ANADROMOUS STREAM CATALOG
ANADROMOUS WATERS ARE LISTED PURSUANT TO AS 16.05.870 (a)
MAP TITLE
CRAIG, C-2
STATE OF ALASKA
DEPARTMENT OF FISH AND GAME
habitat protection division
JUNEAU, ALASKA
BY DATE
REVISIONS