83-1231

State of Alaska
Department of Fish and Game
Public Review Nomination for Waters
Important to Anadromous Species

[X] Addition [ ] Deletion

Name of Waterbody (if known): Gastineau Channel

Location: Vanderbilt Creek 111-40-12

Anadromous Waters Catalog Volume and Number _____

USGS 1:63,360 Quadrangle Juneau B-2

or 1:250,000 (if 1:63,360 not available) _____

Species	Date(s) Observed	Stage(s) (Spawning, Rearing, Migration)
Coho	8/11/78	Spawning

Comments: Please provide any clarifying information in addition to identification on Anadromous Waters Catalog Public Review Maps.

First Creek north of Vanderbilt Hill, runs north and south

Name of Observer (please print) Ron Smith Fred, Juneau

Date: 5/27/82 Signature: _____

Already done

Durand 2-28-83

RECEIVED
JUN 01 1982
RESOURCE ASSESSMENT
BRANCH, HABITAT

UNITED STATES
DEPARTMENT OF THE INTERIOR
GEOLOGICAL SURVEY

JUNEAU (B-2) QUADRANGLE
ALASKA
1:63 360 SERIES (TOPOGRAPHIC)

83-1234

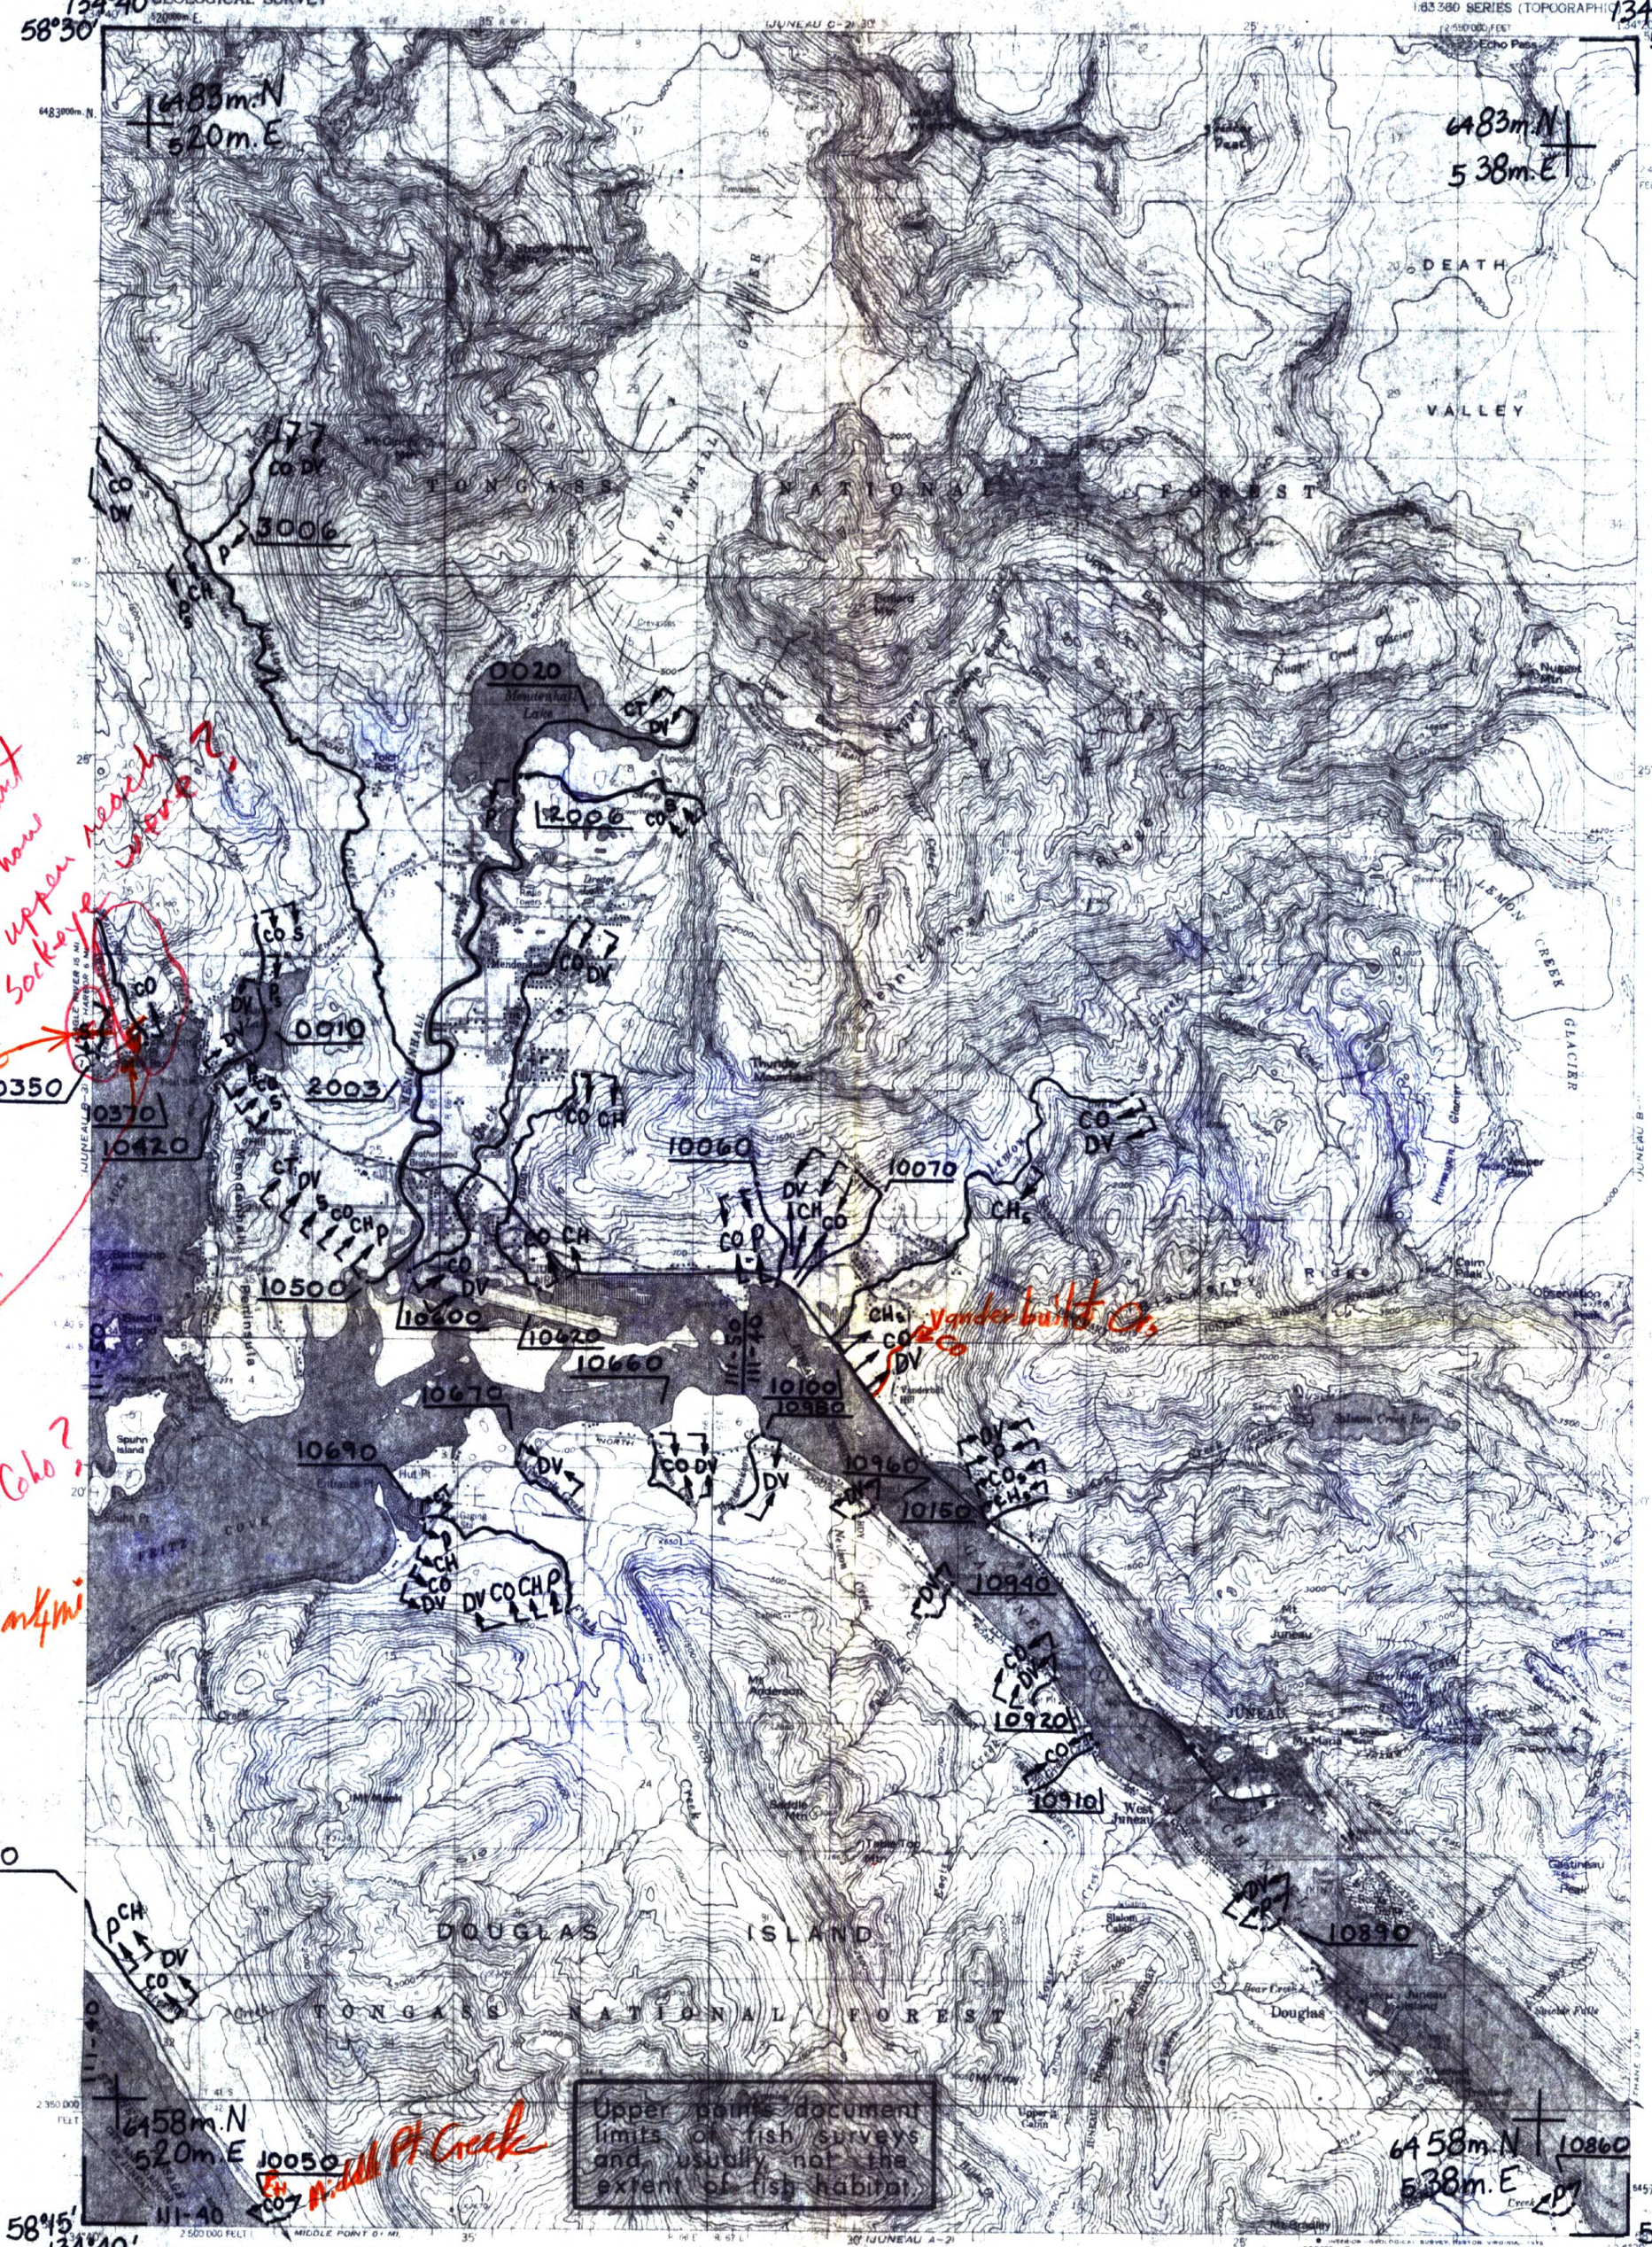

Mapped, edited, and published by the Geological Survey

Control by USGS and USC&GS

Topography by photogrammetric methods from aerial photographs taken 1948. Culture revised 1962. Map field checked 1962

Selected hydrographic data compiled from USC&GS Chart 8235 (1962). This information is not intended for navigational purposes

Universal Transverse Mercator projection, 1927 North American datum
10,000-foot grid based on Alaska coordinate system, zone 1
1000-meter Universal Transverse Mercator grid ticks, zone 8, shown in blue

Land lines represent unsurveyed and unmarked locations predetermined by the State of Alaska, Division of Lands Folio CR-12 Copper River Meridian

Red tint indicates areas in which only landmark buildings are shown

Revisions shown in purple compiled from aerial photographs taken 1974. This information not field checked

Purple tint indicates extension of urban areas

SCALE 1:63 360

CONTOUR INTERVAL 100 FEET
NATIONAL GEODETIC VERTICAL DATUM OF 1929
DEPTH CURVES IN FEET—DATUM IS MEAN LOWER LOW WATER
SHORELINE SHOWN REPRESENTS THE APPROXIMATE LINE OF MEAN HIGH WATER
THE MEAN RANGE OF TIDE IS APPROXIMATELY 14 FEET

TRUE NORTH
MAGNETIC NORTH
APPROXIMATE MEAN DECLINATION, 1962

ROAD CLASSIFICATION
Medium duty — Light duty
Unimproved dirt
State Route

QUADRANGLE LOCATION

FOR SALE BY U. S. GEOLOGICAL SURVEY
FAIRBANKS, ALASKA 99701 DENVER, COLORADO 80225 OR RESTON, VIRGINIA 22092
A FOLDER DESCRIBING TOPOGRAPHIC MAPS AND SYMBOLS IS AVAILABLE ON REQUEST

JUNEAU (B-2), ALASKA
N5815—W13420/15X20
1962
MINOR REVISIONS 1966
PHOTOREVISED 1974

MAP NO. B-2 OF 11

LEGEND

S	Sockeye Salmon
K	King Salmon
CO	Coho Salmon
P	Pink Salmon
CH	Chum Salmon
SH	Steelhead Trout
DV	Dolly Varden
AC	Arctic Char
SF	Sheefish
W	Whitefish
C	Cutthroat Trout

Subscript
s - Known Spawning
r - Rearing
* m - Migration

*Migration upstream is assumed for stream reaches where anadromous fish occur.

COMP. DRC
DRAWN CB
REVISED DRC
APPROVED ERL
DATE 4-82
FILE NO.

SCALE
1" = 1 MILE
1 : 63,360

PROJ. TITLE
ANADROMOUS STREAM CATALOG
ANADROMOUS WATERS ARE LISTED PURSUANT TO AS 16.05.870 (a)

MAP TITLE
JUNEAU, B-2

STATE OF ALASKA
DEPARTMENT OF FISH AND GAME
habitat protection division
JUNEAU, ALASKA

BY	DATE
[illegible]	4/26/81
REVISIONS	

JK 10/81

RC 6/81