83-629

State of Alaska
Department of Fish and Game
Public Review Nomination for Waters
Important to Anadromous Species

[X] Addition [ ] Deletion

Name of Waterbody (if known): Schoenbar Creek & Tributaries
(runs into Ketchikan creek 101-47-25)

Location:

Anadromous Waters Catalog Volume and Number _____

USGS 1:63,360 Quadrangle Ketchikan B-5

or 1:250,000 (if 1:63,360 not available) _____

Species	Date(s) Observed	Stage(s) (Spawning, Rearing, Migration)
Coho	12/20/82	Spawning, rearing.

Comments: Please provide any clarifying information in addition to identification on Anadromous Waters Catalog Public Review Maps.

rearing coho observed in Schoenbar Creek & Tributaries

Name of Observer (please print) Don House

Date: 2/22/83 Signature: Don House

ADF&G 415 main St. Rm 208
Ketchikan, Alask
99901

3/83

Durand 2-25-83

FINAL

83-624

UNITED STATES
DEPARTMENT OF THE INTERIOR
GEOLOGICAL SURVEY

KETCHIKAN (B-5) QUADRANGLE
ALASKA
1:63,360 SERIES (TOPOGRAPHIC)

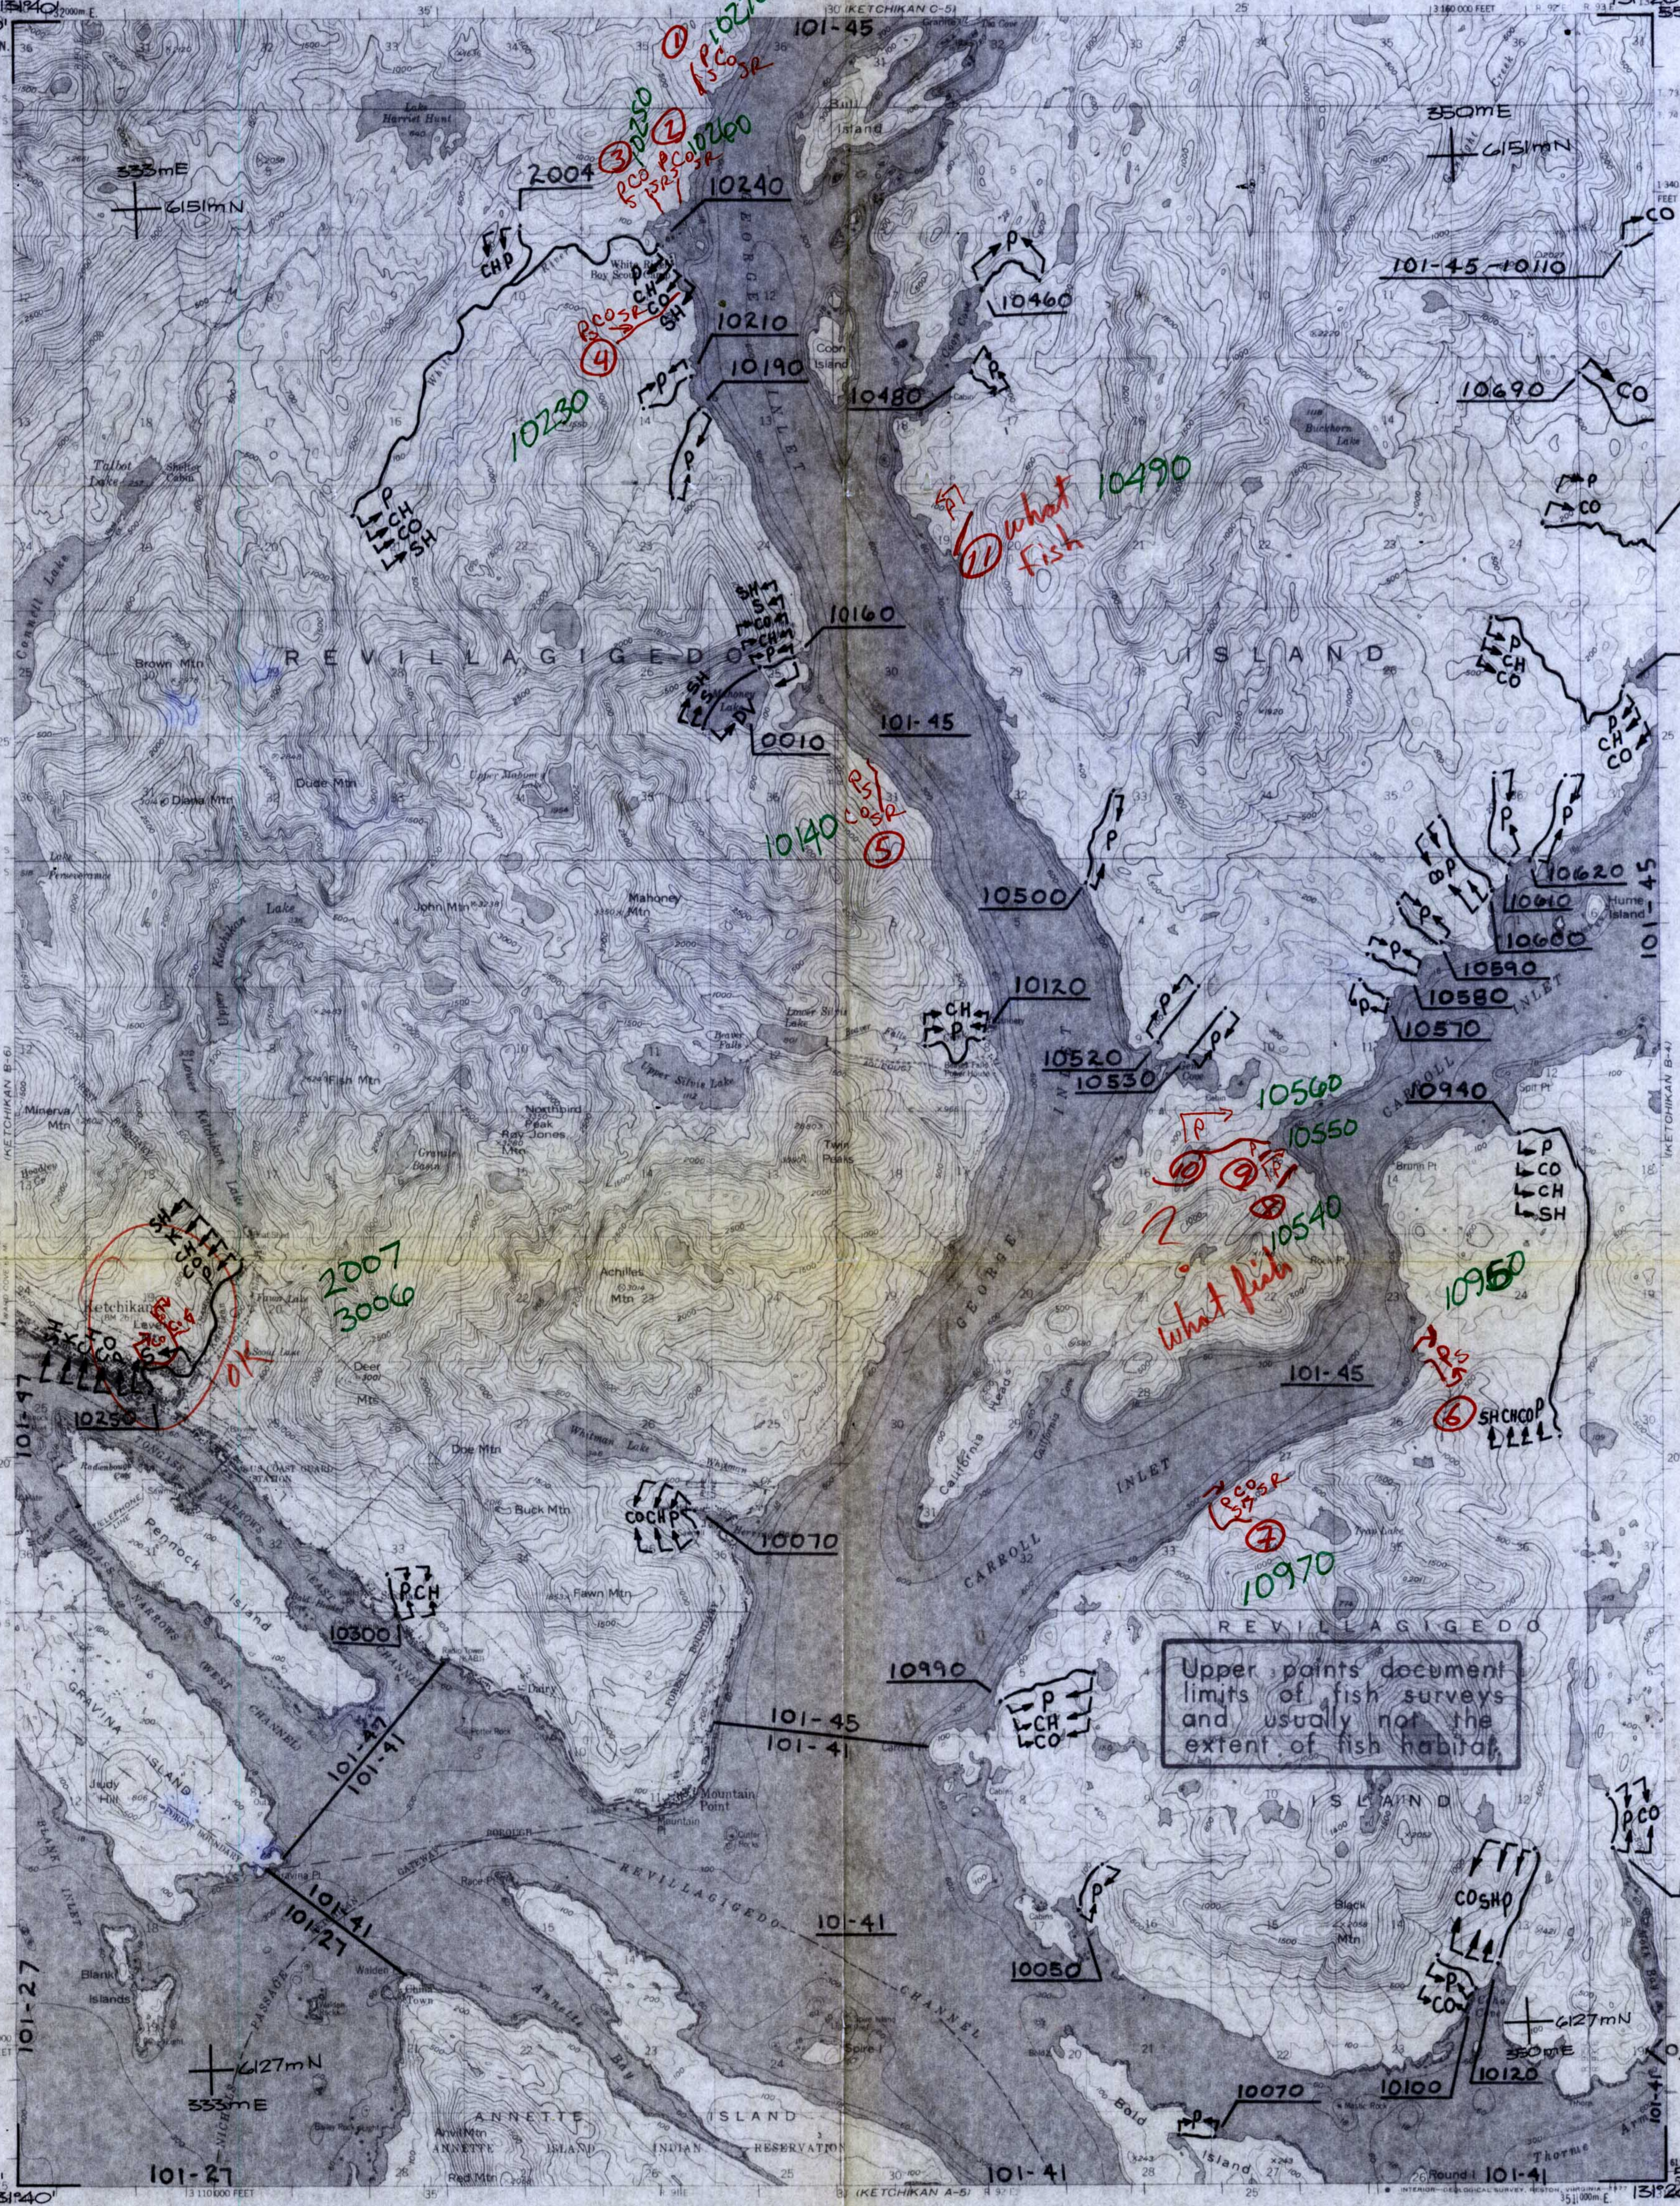

MP USFS 9/16/81

DK 10/81

Mapped, edited, and published by the Geological Survey

Control by USGS and USC&GS

Topography by photogrammetric methods from aerial photographs taken 1948, field annotated 1955. Map not field checked

Selected hydrographic data compiled from USC&GS Charts 8075, 8094, 8095, 8102 (1:229,376 scale), T-2061, and H-2111. This information is not intended for navigational purposes

Universal Transverse Mercator projection, 1927 North American datum 10,000-foot grid based on Alaska coordinate system, zone 9 1000-meter Universal Transverse Mercator grid ticks, zone 1, shown in blue

Land lines represent unsurveyed and unmarked locations predetermined by the State of Alaska, Division of Lands Copper River Meridian

Entire land area is within the Tongass National Forest except Ketchikan exclusion area and Annette Island Indian Reservation

APPROXIMATE MEAN DECLINATION, 1955

SCALE 1:63 360

CONTOUR INTERVAL 100 FEET
NATIONAL GEODETIC VERTICAL DATUM OF 1929
DEPTH CURVES IN FEET—DATUM IS MEAN LOWER LOW WATER
SHORELINE SHOWN REPRESENTS THE APPROXIMATE LINE OF MEAN HIGH WATER
THE AVERAGE RANGE OF TIDE IS APPROXIMATELY 13 FEET

FOR SALE BY U.S. GEOLOGICAL SURVEY
FAIRBANKS, ALASKA 99701, DENVER, COLORADO 80225, OR RESTON, VIRGINIA 22092
A FOLDER DESCRIBING TOPOGRAPHIC MAPS AND SYMBOLS IS AVAILABLE ON REQUEST

ROAD CLASSIFICATION
Medium-duty — Light-duty
Unimproved dirt

QUADRANGLE LOCATION

KETCHIKAN (B-5), ALASKA
N5515—W13120/15X20

1955
MINOR REVISIONS 1970

MAP NO. B-5 OF 4

LEGEND

Code	Species
S	Sockeye Salmon
K	King Salmon
CO	Coho Salmon
P	Pink Salmon
CH	Chum Salmon
SH	Steelhead Trout
DV	Dolly Varden
AC	Arctic Char
SF	Sheefish
W	Whitefish
C	Cutthroat Trout

Subscript
s - Known Spawning
r - Rearing
* m - Migration

* Migration upstream is assumed for stream reaches where anadromous fish occur.

COMP. DRC
DRAWN CB
REVISED DRC
APPROVED ERL
DATE 4-82
FILE NO.

SCALE
1" = 1 MILE
1 : 63,360

PROJ. TITLE
ANADROMOUS STREAM CATALOG
ANADROMOUS WATERS ARE LISTED PURSUANT TO AS 16.05.870 (a)

MAP TITLE
KETCHIKAN B-5

STATE OF ALASKA
DEPARTMENT OF FISH AND GAME
habitat protection division
JUNEAU, ALASKA

BY	DATE
PSD	6/4/81
K. Francisco	6/10/81
PD	1-12-83
A#	2/22/83

REVISIONS