83-641

State of Alaska
Department of Fish and Game
Public Review Nomination for Waters
Important to Anadromous Species

X Addition ____ Deletion

Correction

Name of Waterbody (if known): Carroll Inlet

Location:

Anadromous Waters Catalog Volume and Number District 1 - Vol. 3.

USGS 1:63,360 Quadrangle Ketchikan C-4 4

or 1:250,000 (if 1:63,360 not available) _____

Stream 101-45-086

Species	Date(s) Observed	Stage(s) (Spawning, Rearing, Migration)
Pink Salmon	1973	Dead Adults

Comments: Please provide any clarifying information. Also, please include a map of the area identifying the stream reach. This can be a copy of the map from the Anadromous Waters Atlas.

Apparent omission from current maps based on map comparisons. Spawning areas limited to upper ITZ. 1973 ADFG survey indicates barrier falls to all fish at stream mouth.

Don Lomalen Habitat Biologist

Name of Observer (please print) P. Michael Pease - Fisheries Biologist

Date: 12/21/83 Signature: P. Michael Pease

Address: U.S.D.A. Forest Service
Ketchikan AK

drafted 2/84 cp

Cmy 2/1/84

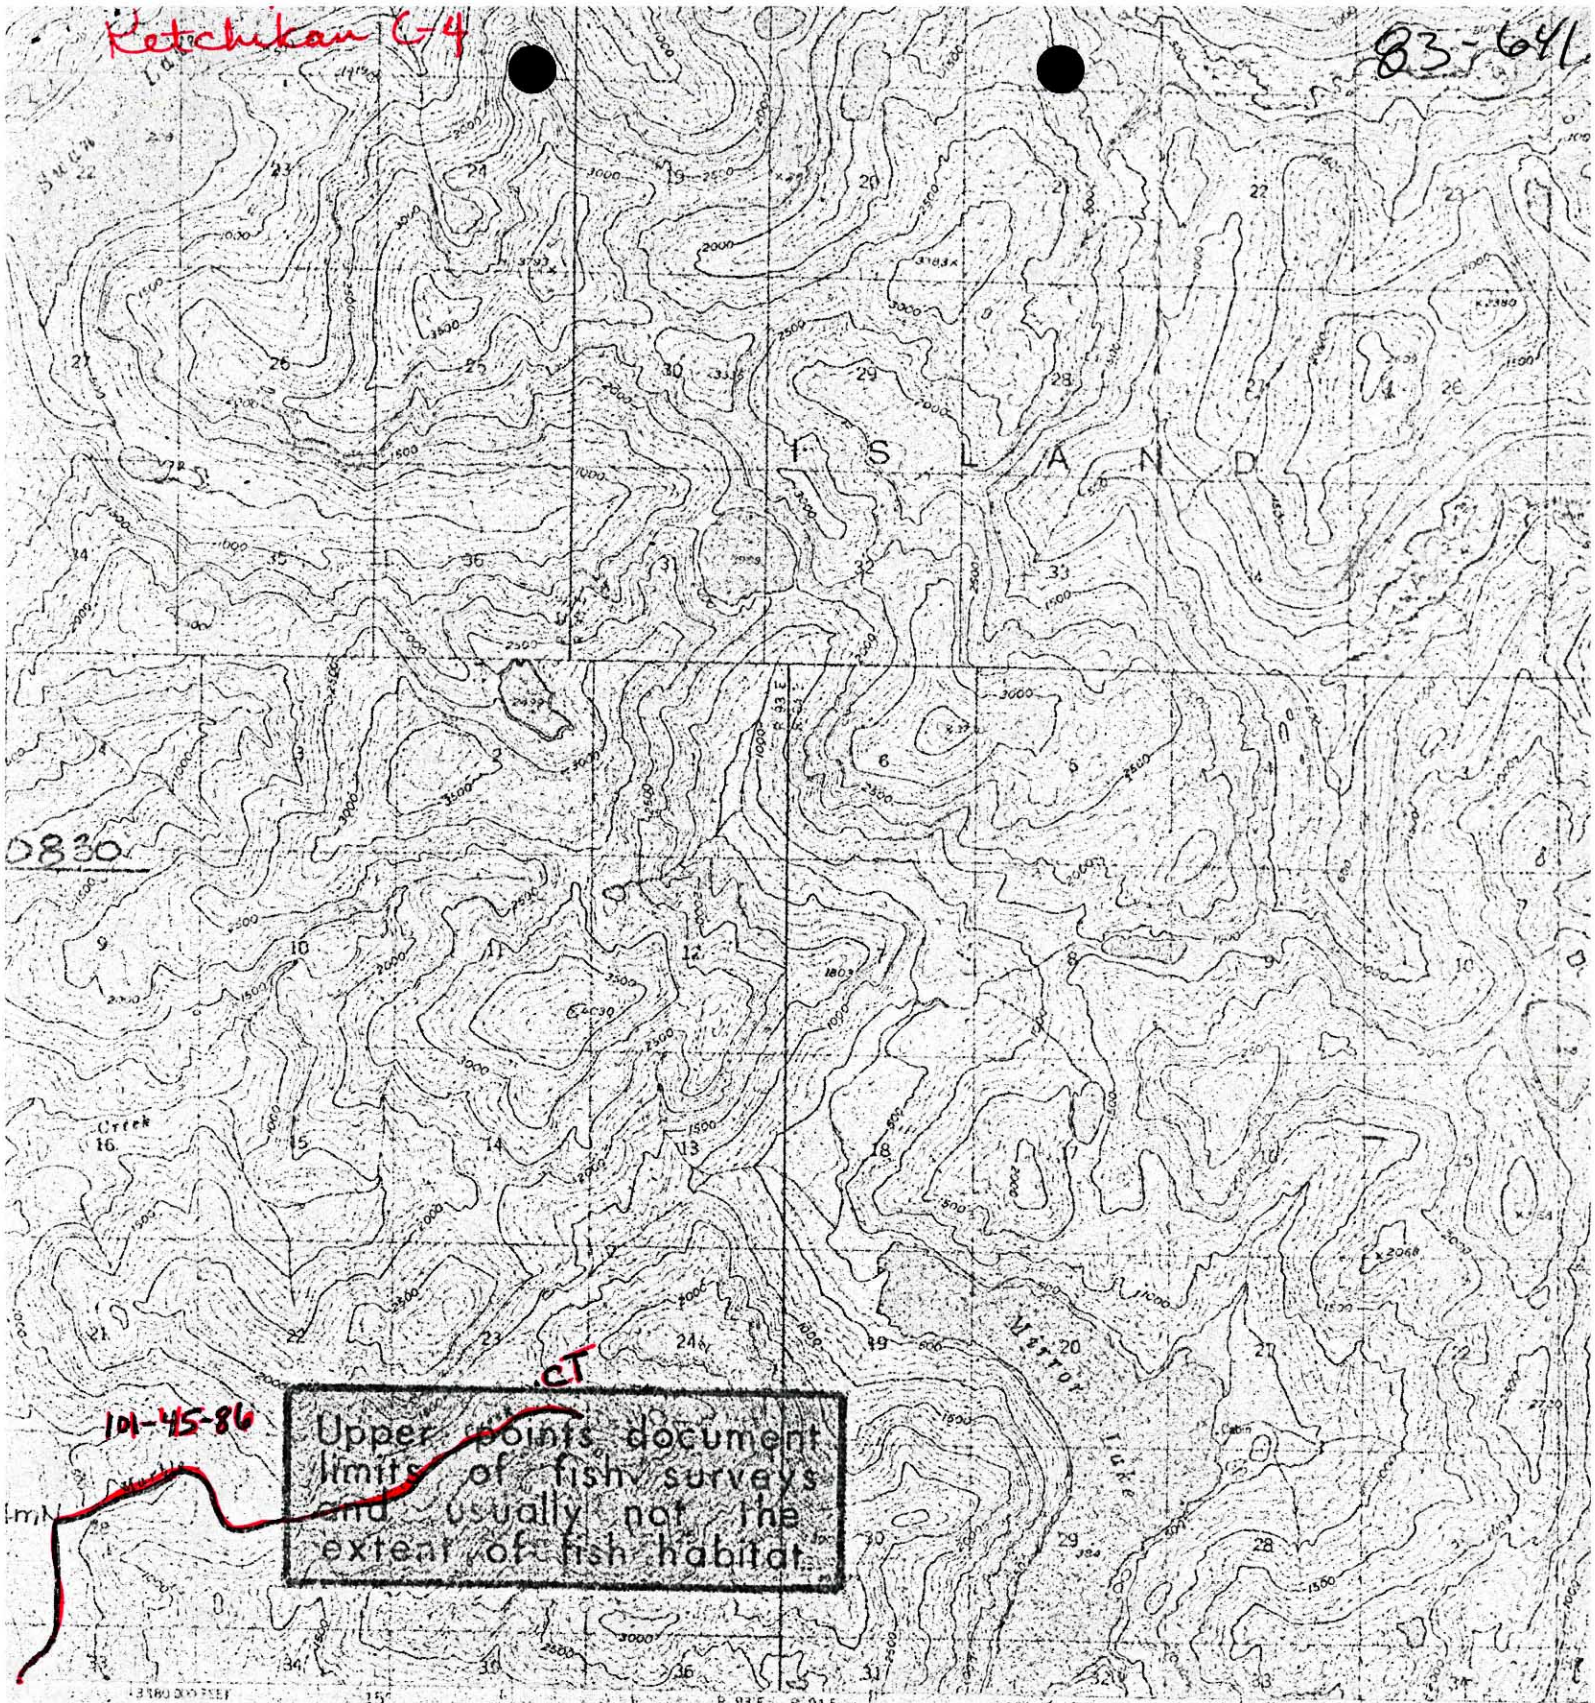

y the Geological Survey

fords from aerial photographs
ap not field checked

from USC&GS Charts 8078
cale) and hydrographic surveys
ded for navigational purposes

tion, 1927 North American datum
ordinate system, zone 1
ratic grid ticks.

unmarked locations
, Division of Lands

TRUE NORTH
MAGNETIC NORTH
APPROXIMATE MEAN DECLINATION, 1955

10' (KETCHIKAN B-4)

SCALE 1:63360

CONTOUR INTERVAL 100 FEET.
NATIONAL GEODETIC VERTICAL DATUM OF 1929
DEPTH CURVES AND SOUNDINGS IN FEET-DATUM IS MEAN LOWER LOW WATER
SHORELINE SHOWN REPRESENTS THE APPROXIMATE LINE OF MEAN HIGH WATER
THE AVERAGE RANGE OF TIDE IS APPROXIMATELY 13 FEET

FOR SALE BY U. S. GEOLOGICAL SURVEY
FAIRBANKS, ALASKA 99701, DENVER, COLORADO 80225, OR RESTON, VIRGINIA 22092
A FOLDER DESCRIBING TOPOGRAPHIC MAPS AND SYMBOLS IS AVAILABLE ON REQUEST