83-657

State of Alaska
Department of Fish and Game
Public Review Nomination for Waters
Important to Anadromous Species

X Addition ____ Deletion

Name of Waterbody (if known): See map (3)

Location:

Anadromous Waters Catalog Volume and Number Southeast 1

USGS 1:63,360 Quadrangle Ketchikan C-6

or 1:250,000 (if 1:63,360 not available) ____

Species	Date(s) Observed	Stage(s) (Spawning, Rearing, Migration)
Pink	81-82	m, s

Comments: Please provide any clarifying information. Also, please include a map of the area identifying the stream reach. This can be a copy of the map from the Anadromous Waters Atlas.

PKW 3/10/83

Name of Observer (please print) Don House

Date: 3/7/83 Signature: Don House

Address: 415 Main St Rm 208
Ketchikan Alaska 99901

<p 3/83

83-658

UNITED STATES
DEPARTMENT OF THE INTERIOR
GEOLOGICAL SURVEY

KETCHIKAN (C-6) QUADRANGLE
ALASKA
1:63 360 SERIES (TOPOGRAPHIC)

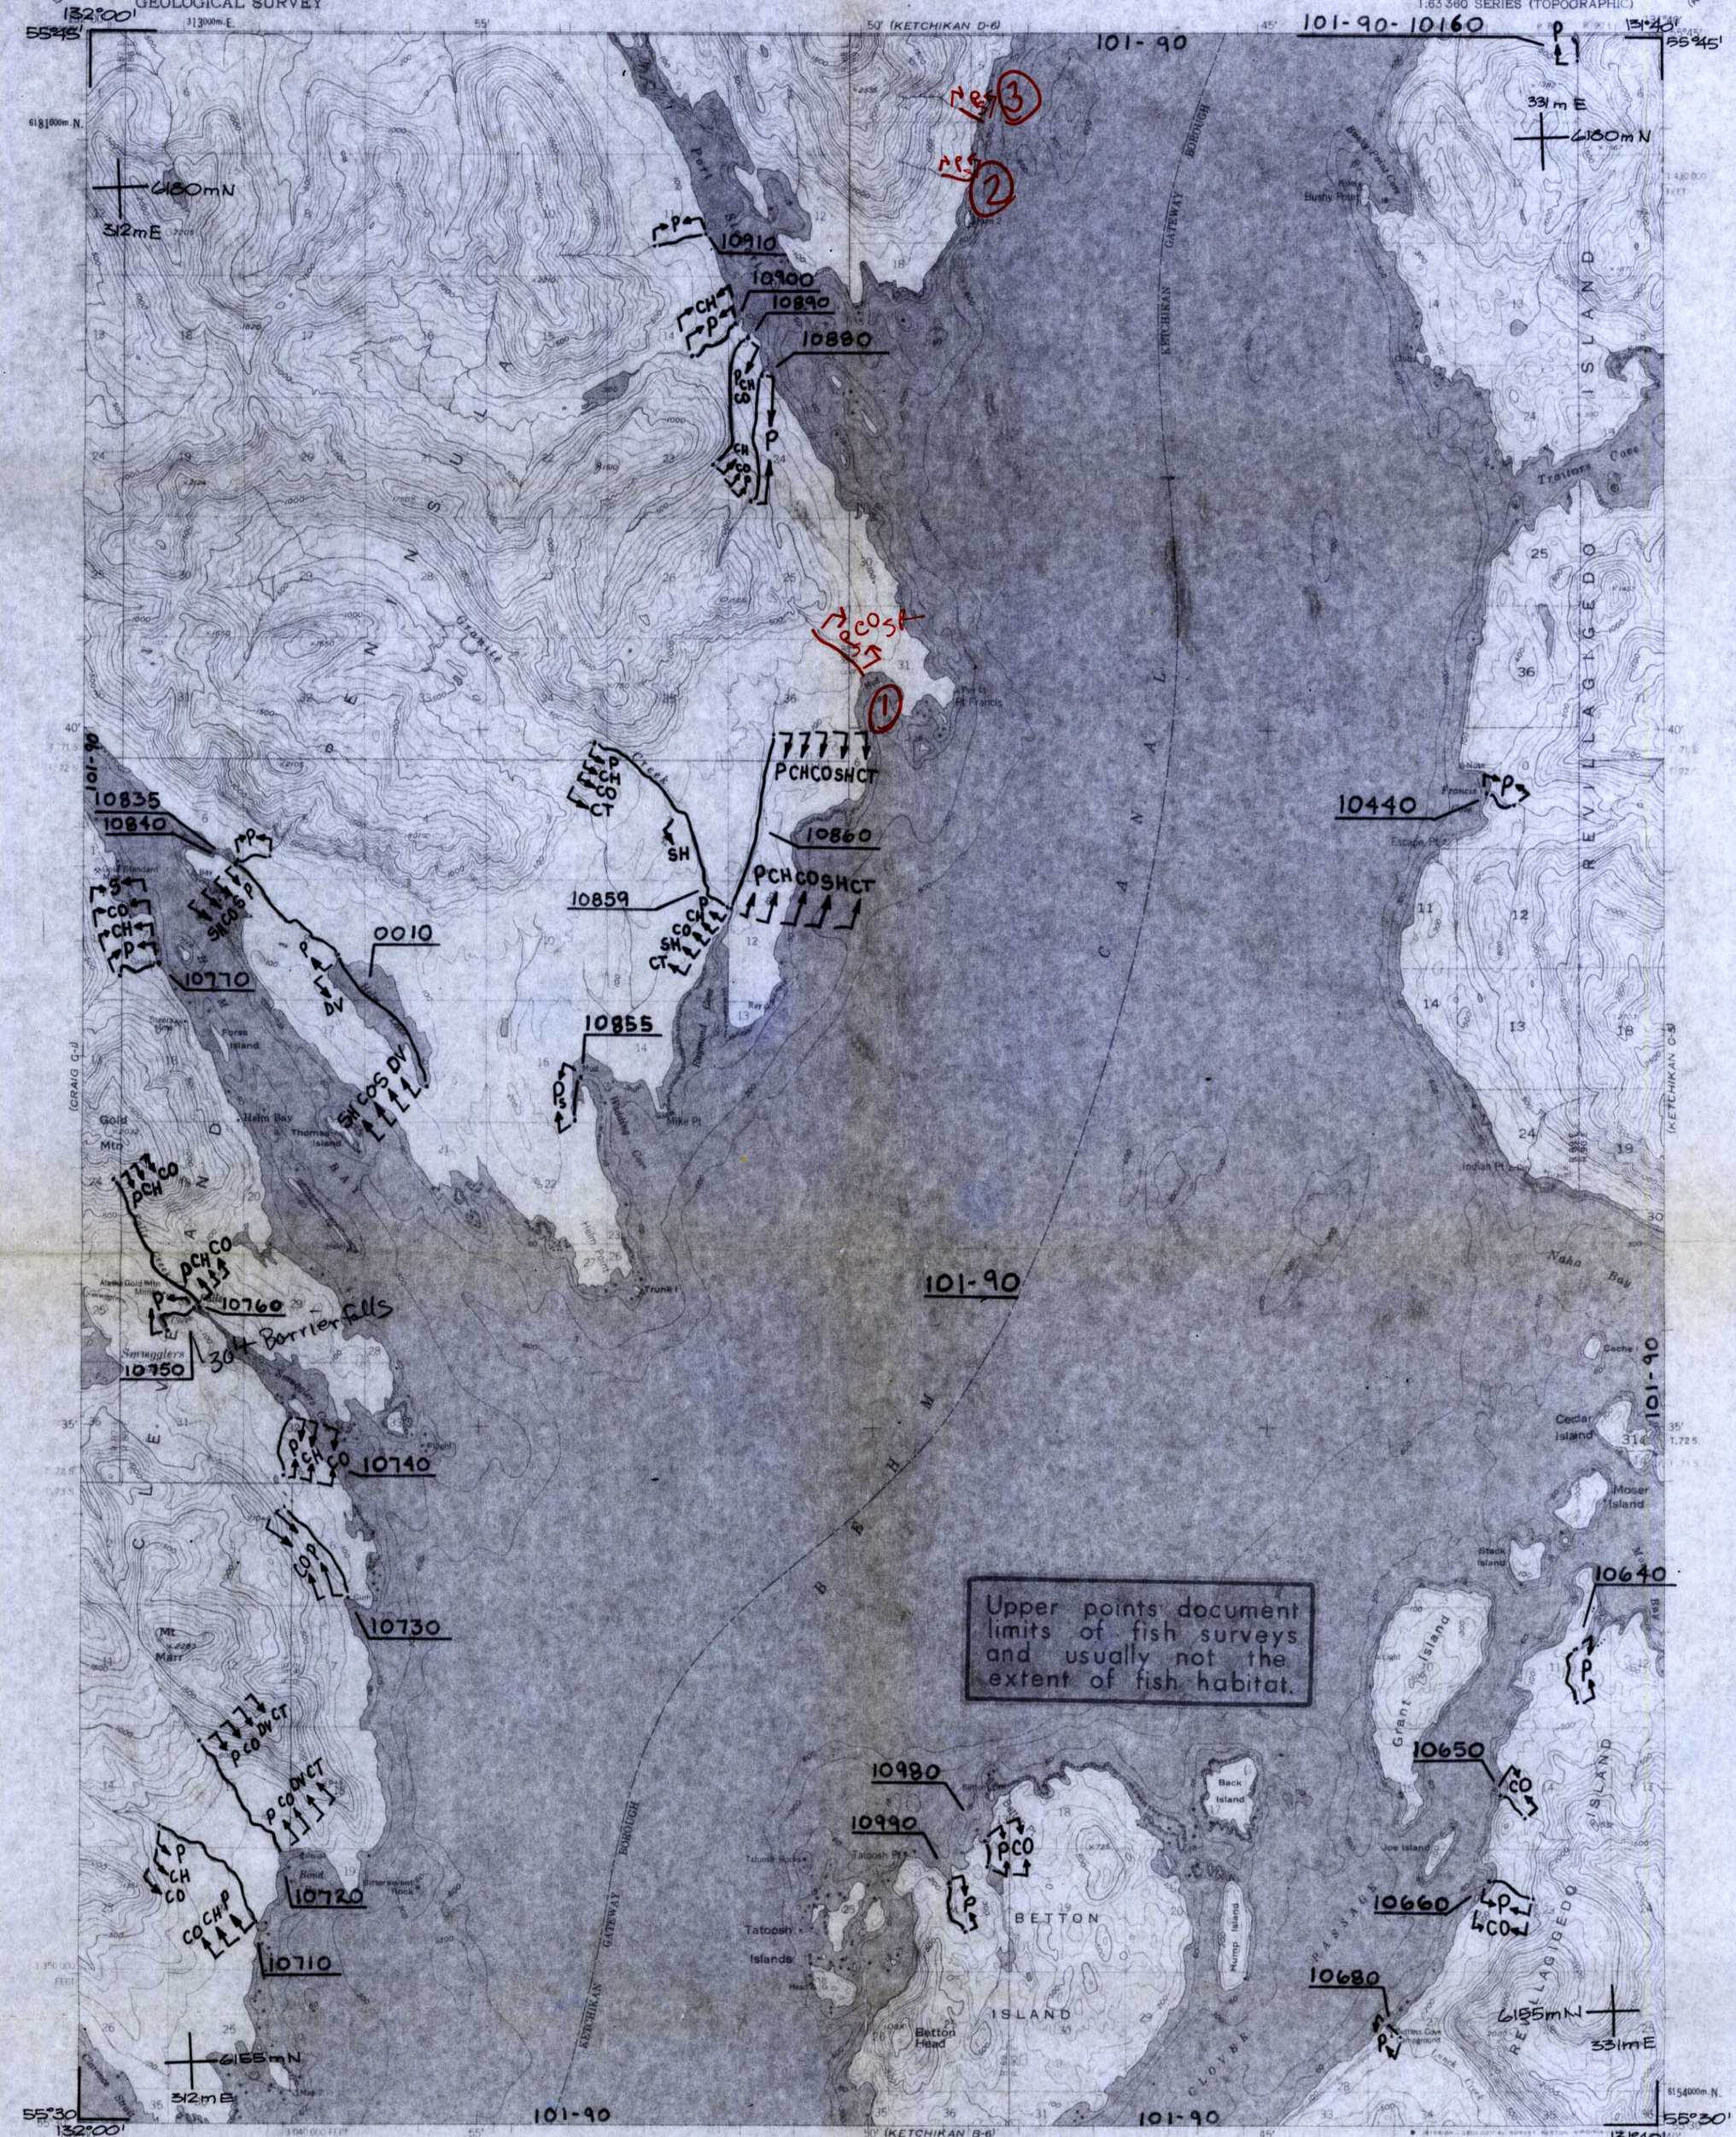

Mapped, edited, and published by the Geological Survey

Control by USGS and USC&GS

Topography by photogrammetric methods from aerial photographs taken 1948. field annotated 1949. Map not field checked

Selected hydrographic data compiled from USC&GS Charts 8079 (1956), 8102 (1961) (1 229,376 scale), and 8124 (1961)
This information is not intended for navigational purposes

Universal Transverse Mercator projection, 1927 North American datum
10,000-foot grid based on Alaska coordinate system, zone 1
1000-meter Universal Transverse Mercator grid ticks, zone 9, shown in blue

Land lines printed in gray represent unsurveyed and unmarked locations predetermined by the State of Alaska, Division of Lands. Copper River Meridian

Entire land area is within the Tongass National Forest

To place on the predicted North American Datum 1983 move the projection lines 38 meters north and 105 meters east

TRUE NORTH
MAGNETIC NORTH
APPROXIMATE MEAN DECLINATION, 1949

SCALE 1:63360

CONTOUR INTERVAL 100 FEET
NATIONAL GEODETIC VERTICAL DATUM OF 1929
DEPTH CURVES IN FEET-DATUM IS MEAN LOWER LOW WATER
SHORELINE SHOWN REPRESENTS THE APPROXIMATE LINE OF MEAN HIGH WATER
THE AVERAGE RANGE OF TIDE IS APPROXIMATELY 13 FEET

FOR SALE BY U.S. GEOLOGICAL SURVEY
FAIRBANKS, ALASKA 99701, DENVER, COLORADO 80225, OR RESTON, VIRGINIA 22092
A FOLDER DESCRIBING TOPOGRAPHIC MAPS AND SYMBOLS IS AVAILABLE ON REQUEST

ROAD CLASSIFICATION
Light-duty

QUADRANGLE LOCATION

KETCHIKAN (C-6), ALASKA
N5530-W13140/15X20
1949

BR 9/81

MP USFS 9/16/81

DK 10/81

MAP NO. C-6 OF 4

LEGEND

S	Sockeye Salmon
K	King Salmon
CO	Coho Salmon
P	Pink Salmon
CH	Chum Salmon
SH	Steelhead Trout
DV	Dolly Varden
AC	Arctic Char
SF	Sheefish
W	Whitefish
C	Cutthroat Trout

Subscript
s - Known Spawning
r - Rearing
* m - Migration

* Migration upstream is assumed for stream reaches where anadromous fish occur.

COMP. DRC
DRAWN
REVISED DRC
APPROVED ERL
DATE 4-82
FILE NO.

SCALE
1" = 1 MILE
1 : 63,360

PROJ. TITLE
ANADROMOUS STREAM CATALOG
ANADROMOUS WATERS ARE LISTED PURSUANT TO AS 16.05.870 (a)

MAP TITLE
KETCHIKAN C-6

STATE OF ALASKA
DEPARTMENT OF FISH AND GAME
habitat protection division
JUNEAU, ALASKA

BY	DATE
RSD	6/8/81
N. Evanicsko	6/10/81
PD	11-83
REVISIONS	