State of Alaska
Department of Fish and Game
Public Review Nomination for Waters
Important to Anadromous Species

83-794

[X] Addition [ ] Deletion

Name of Waterbody (if known): _____

Location:

Anadromous Waters Catalog Volume and Number 101-11-2

USGS 1:63,360 Quadrangle Prince Rupert D-2

or 1:250,000 (if 1:63,360 not available) _____

| Species | Date(s) Observed | Stage(s) (Spawning, Rearing, Migration) |
|---|---|---|
| Pink | | spawning |
| | | |
| | | |
| | | |

Comments: Please provide any clarifying information in addition to identification on Anadromous Waters Catalog Public Review Maps.

T 80 S R 98 E section 33

Name of Observer (please print) PHILIP DOHERTY

Date: 1-18-83 Signature: Philip Doherty

Drafted 3/15/83

Durand 2-24-83

F. Crone

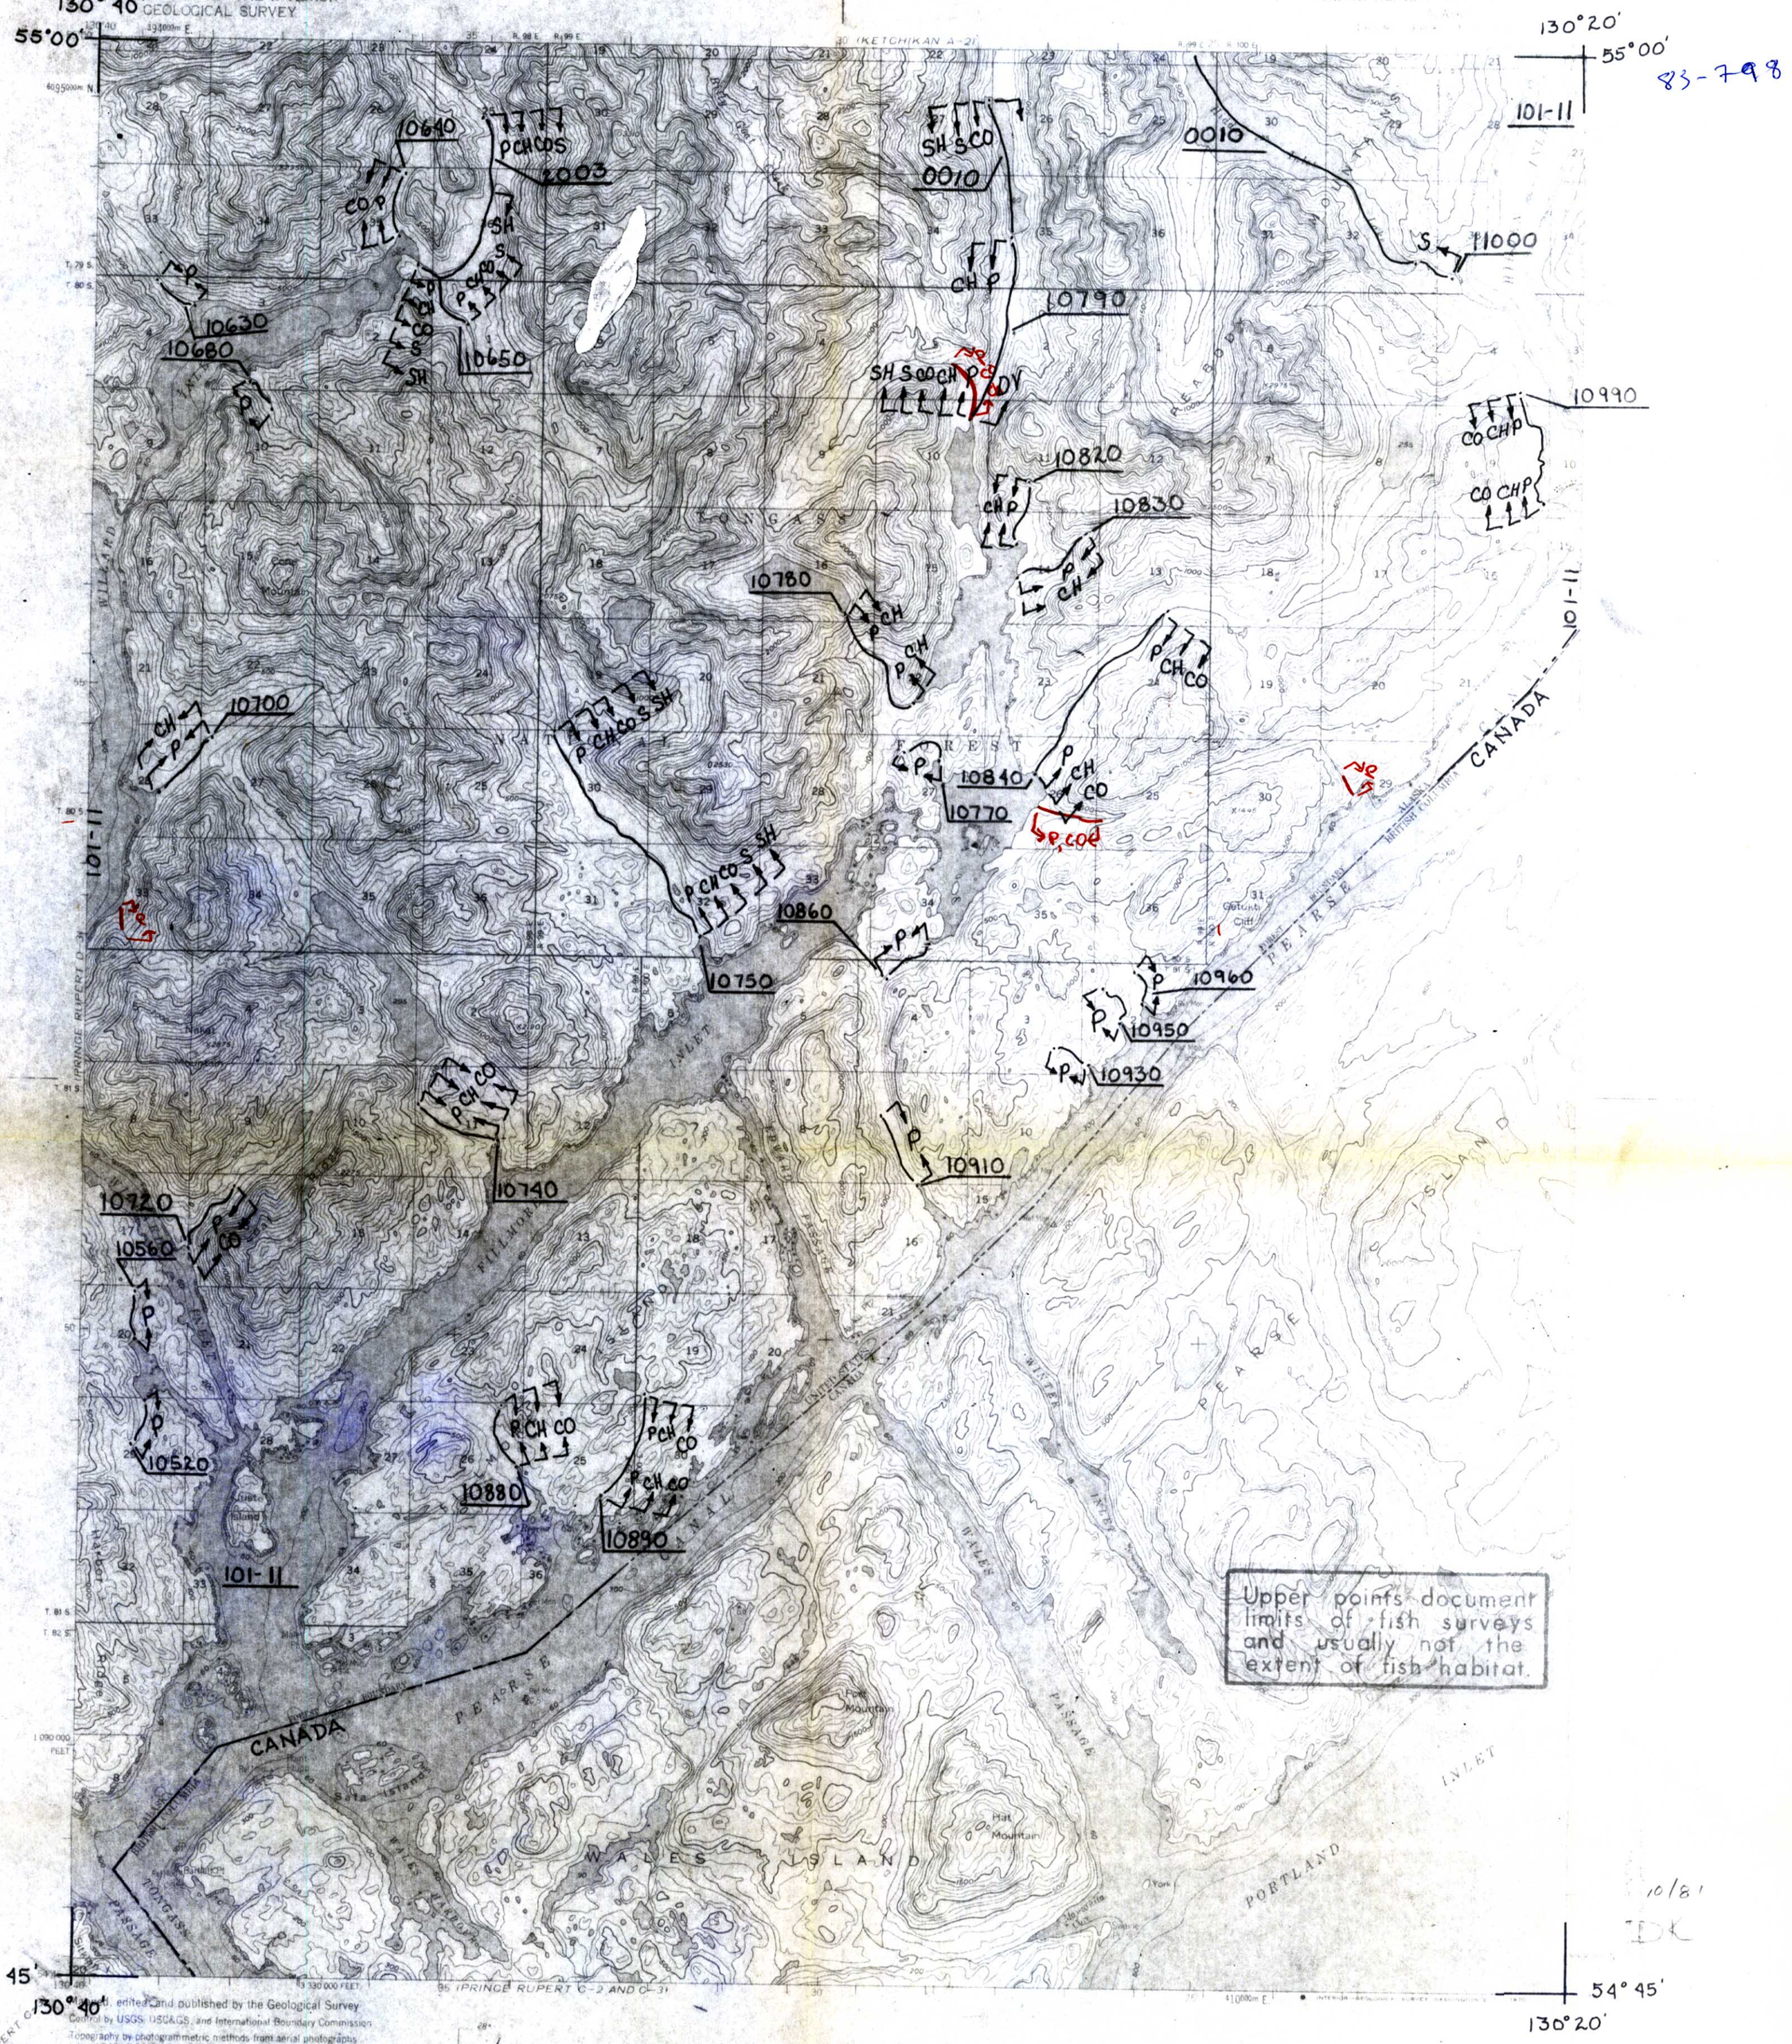


| MAP NO. |
|---|
| D-2 |
| OF |
| 1 |

**LEGEND**

| | |
|---|---|
| S | Sockeye Salmon |
| K | King Salmon |
| CO | Coho Salmon |
| P | Pink Salmon |
| CH | Chum Salmon |
| SH | Steelhead Trout |
| DV | Dolly Varden |
| AC | Arctic Char |
| SF | Sheefish |
| W | Whitefish |
| CT | Cutthroat Trout |

Subscript
s - Known Spawning
r - Rearing
*m - Migration

*Migration upstream is assumed for stream reaches where anadramous fish occur.

| | |
|---|---|
| COMP. | DRC |
| DRAWN | CB |
| REVISED | DRC |
| APPROVED | ERL |
| DATE | 4-82 |
| FILE NO. | |

N

SCALE
1" = 1 MILE
1 : 63,360

PROJ. TITLE
**ANADROMOUS WATERS CATALOG**
ANADROMOUS WATERS ARE LISTED PURSUANT TO AS 16.05.870 (a)

MAP TITLE
**PRINCE RUPERT D-2**

STATE OF ALASKA
DEPARTMENT OF FISH AND GAME
habitat protection division
JUNEAU, ALASKA

| BY | DATE |
|---|---|
| RSD | 6/4/81 |
| K Francis | 11/1/81 |
| PD | 1-17-83 |
| | |
| | |
| | |
| REVISIONS | |