83-821

State of Alaska
Department of Fish and Game
Public Review Nomination for Waters
Important to Anadromous Species

☑ Addition ☐ Deletion

Name of Waterbody (if known): POIDT WHITE CREEK

Location:

Anadromous Waters Catalog Volume and Number SOUTHEAST REGION

USGS 1:63,360 Quadrangle SITKA A-1

or 1:250,000 (if 1:63,360 not available) 109-42-10010

Species	Date(s) Observed	Stage(s) (Spawning, Rearing, Migration)
COHO	2/22/83	REARING

Comments: Please provide any clarifying information in addition to identification on Anadromous Waters Catalog Public Review Maps.

TRIBUTARIES TO POIDT WHITE CREEK 109-42-10010
SUPPORT REARING COHO SALMON

See map for SUMDUM A6, tributaries continue.

Name of Observer (please print) DONALD G. KELLY

Date: 2/25/83 Signature: Donald G. Kelly

PKW 2/3/83

drafting done CB

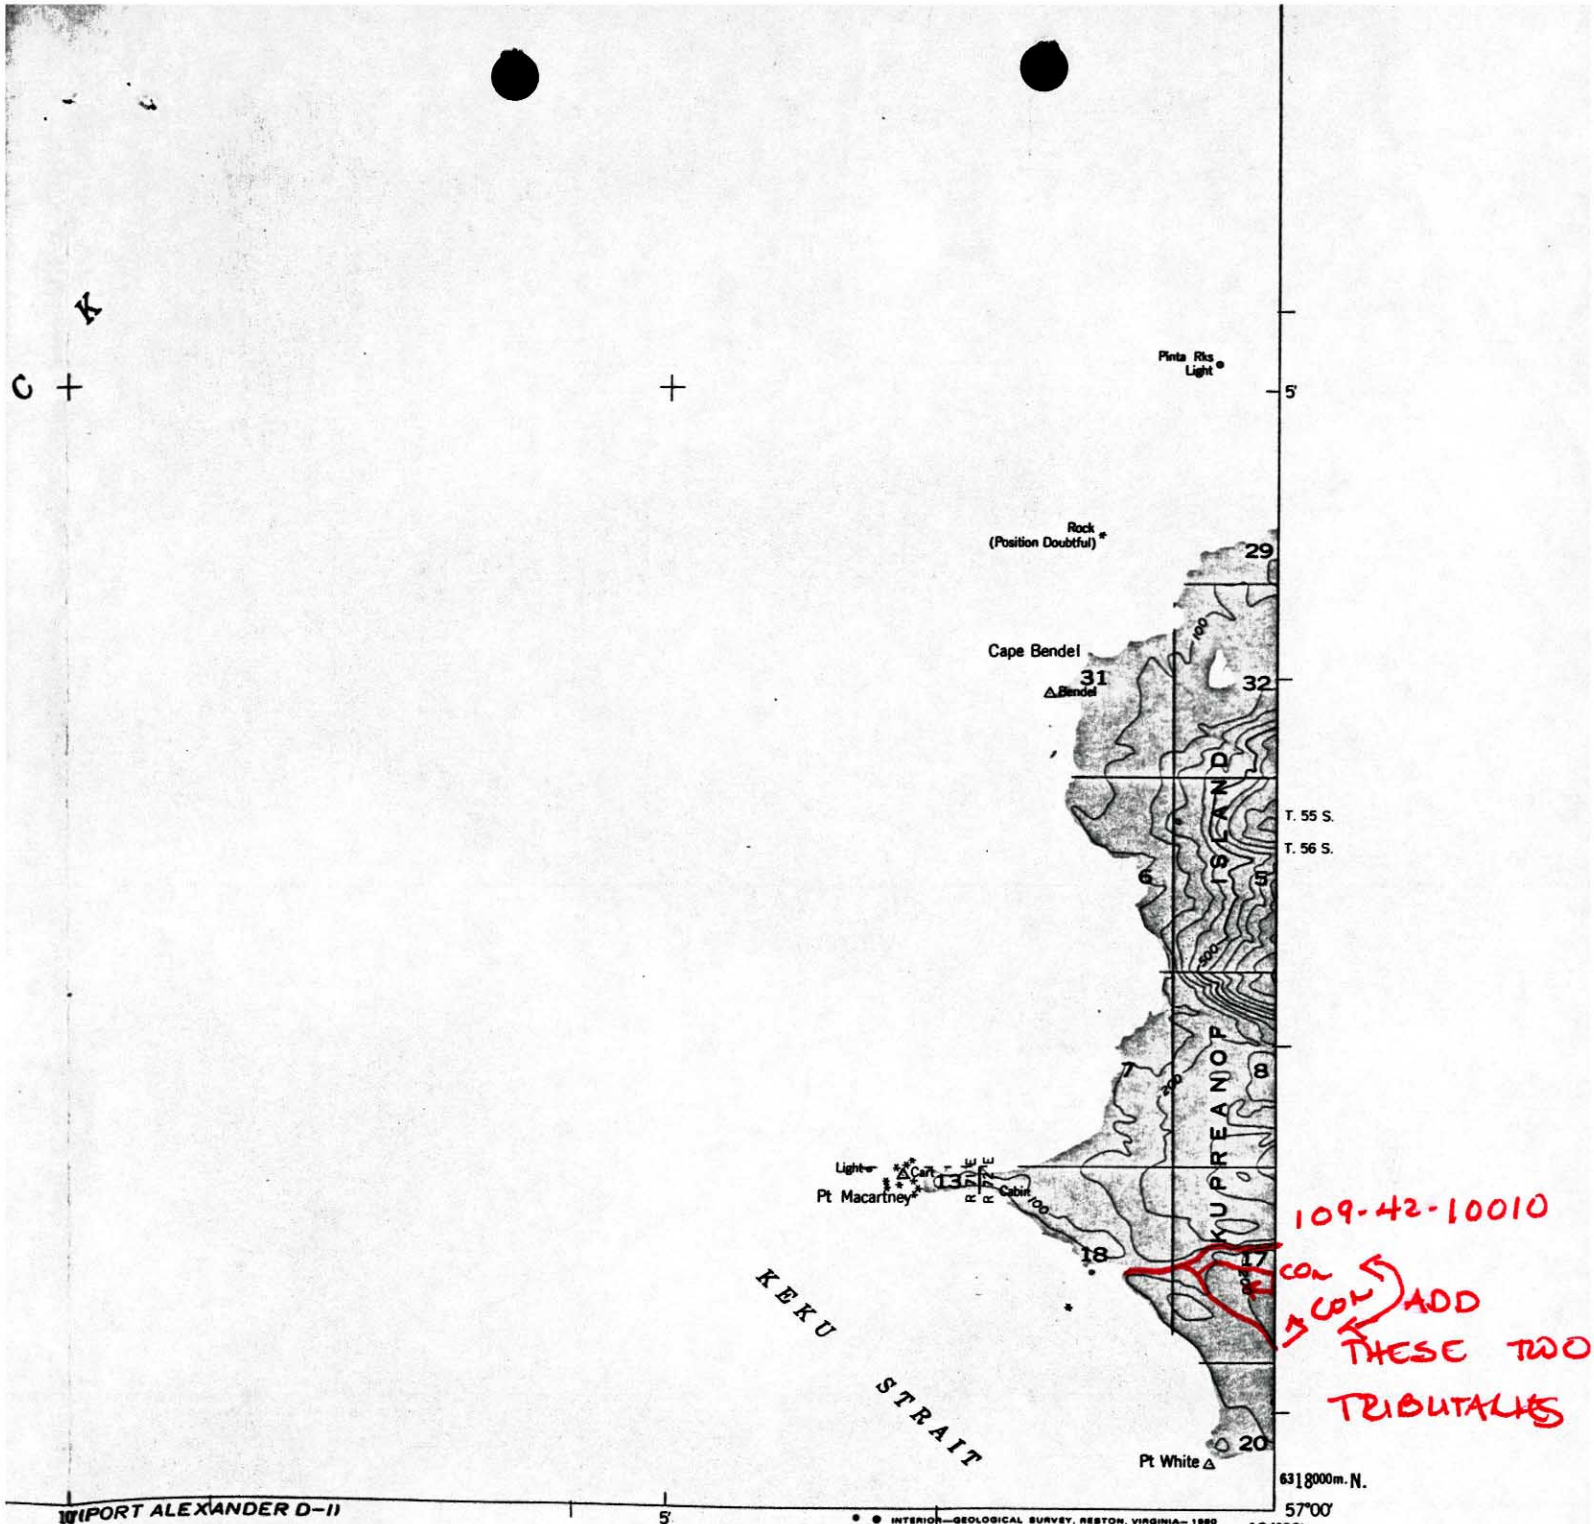

UR INTERVAL 100 FEET
ETIC VERTICAL DATUM OF 1929
ET-DATUM IS MEAN LOWER LOW WATER
ENTS THE APPROXIMATE LINE OF MEAN HIGH WATER
GE OF TIDE IS APPROXIMATELY 12 FEET

U. S. GEOLOGICAL SURVEY
. COLORADO 80225. OR RESTON, VIRGINIA 22092
C MAPS AND SYMBOLS IS AVAILABLE ON REQUEST

FINAL

UNITED STATES
DEPARTMENT OF THE INTERIOR
GEOLOGICAL SURVEY

SUMDUM (A-6) QUADRANGLE
ALASKA
1:63 360 SERIES (TOPOGRAPHIC)

83-966

6345m.N
561m.E

6345m.N
580m.E

110-21

110-31

110-17

F R E D E R I C K S O U N D

110-16

110-17

110-17

110-16

Turnabout I

Upper points document limits of fish surveys and usually not the extent of fish habitat.

110-16

10020 CO P PCO 10010

10140 P 10130 CO CHP PCH CO 2003 CO P 10120

10050 CO

Mountain

K U P R E A N O F I S L A N D

50'-60' BARRIER FALLS DELETE THIS PORTION OF STREAM

DELETE

110-17-10080

109-42-10010 DV CO

2004

6319m.N
561m.E

DV CO (TRIBUTARY TO 109-42-10010)

109-42-10010 20

DELETE
30'-50'
BARRIER
FALLS AT
TIDEWATER

6319m.N
580m.E

57°00'
134°00'
133°40'

(SITKA B-1) (SUMDUM B-6) (SUMDUM B-5) (FORT ALEXANDER D-1) (PETERSBURG D-6) (PETERSBURG D-5)

Compiled, edited, and published by the Geological Survey

Control by USGS and USC&GS

Topography by photogrammetric methods from aerial photographs taken 1948. Map not field checked

Selected hydrographic data compiled from USC&GS Chart 8201 (1:217 828 scale) 1956. This information is not intended for navigational purposes

Universal Transverse Mercator projection. 1927 North American datum 10,000-foot grid based on Alaska coordinate system, zone 1 1000-meter Universal Transverse Mercator grid ticks, zone 8, shown in blue

Land lines represent unsurveyed and unmarked locations predetermined by the State of Alaska, Division of Lands, Folio CR-14 Copper River Meridian

Swamps, as portrayed, indicate only the wetter areas usually of low relief, as interpreted from aerial photographs

Entire land area is within the Tongass National Forest

National forest boundaries represent proclamation lines and do not necessarily imply Federal jurisdiction

SCALE 1:63360

APPROXIMATE MEAN DECLINATION, 1948

CONTOUR INTERVAL 100 FEET
NATIONAL GEODETIC VERTICAL DATUM OF 1929
DEPTH CURVES IN FEET--DATUM IS MEAN LOWER LOW WATER
SHORELINE SHOWN REPRESENTS THE APPROXIMATE LINE OF MEAN HIGH WATER
THE AVERAGE RANGE OF TIDE IS APPROXIMATELY 12 FEET

FOR SALE BY U. S. GEOLOGICAL SURVEY
FAIRBANKS, ALASKA 99701, DENVER, COLORADO 80225, OR RESTON, VIRGINIA 22092
A FOLDER DESCRIBING TOPOGRAPHIC MAPS AND SYMBOLS IS AVAILABLE ON REQUEST

ROAD CLASSIFICATION
No roads or trails in this area

QUADRANGLE LOCATION

SUMDUM (A-6), ALASKA
N5700 - W13340/15X20
1948

10/81

JK
SS
GC
DES

MAP NO. A-6 OF 9

LEGEND

		Subscript
S	Sockeye Salmon	s- Known Spawning
K	King Salmon	r- Rearing
CO	Coho Salmon	* m-Migration
P	Pink Salmon	
CH	Chum Salmon	
SH	Steelhead Trout	
DV	Dolly Varden	
AC	Arctic Char	
SF	Sheefish	
W	Whitefish	
C	Cutthroat Trout	

*Migration upstream is assumed for stream reaches where anadromous fish occur.

COMP.	DRC
DRAWN	CB
REVISED	DRC
APPROVED	ERL
DATE	4/82
FILE NO.	

SCALE
1" = 1 MILE
1 : 63,360

PROJ. TITLE
ANADROMOUS STREAM CATALOG
ANADROMOUS WATERS ARE LISTED PURSUANT TO AS 16.05.870(a)

MAP TITLE
SUMDUM, A-6

STATE OF ALASKA
DEPARTMENT OF FISH AND GAME
habitat protection division
JUNEAU, ALASKA

BY	DATE
REVISIONS	