State of Alaska
Department of Fish and Game
Public Review Nomination for Waters
Important to Anadromous Species

83-857

[X] Addition [ ] Deletion

Name of Waterbody (if known): MYRMAID CREEK

Location: SOUTHEAST REGION 1
115-32-10300-2004

Anadromous Waters Catalog Volume and Number _____

USGS 1:63,360 Quadrangle SKAGWAY A2

or 1:250,000 (if 1:63,360 not available) _____

Species	Date(s) Observed	Stage(s) (Spawning, Rearing, Migration)
Co D.V.	11/81	R

Comments: Please provide any clarifying information in addition to identification on Anadromous Waters Catalog Public Review Maps.

Name of Observer (please print) RS

Date: 3/1/83 Signature: Ray Stasha

PKW 3/83

cp 3/83

Please Return to
Box 431
Haines, AK. 99827

83-846

FINAL

UNITED STATES
DEPARTMENT OF THE INTERIOR
GEOLOGICAL SURVEY

SKAGWAY (A-2) QUADRANGLE
ALASKA
1:63 360 SERIES (TOPOGRAPHIC)

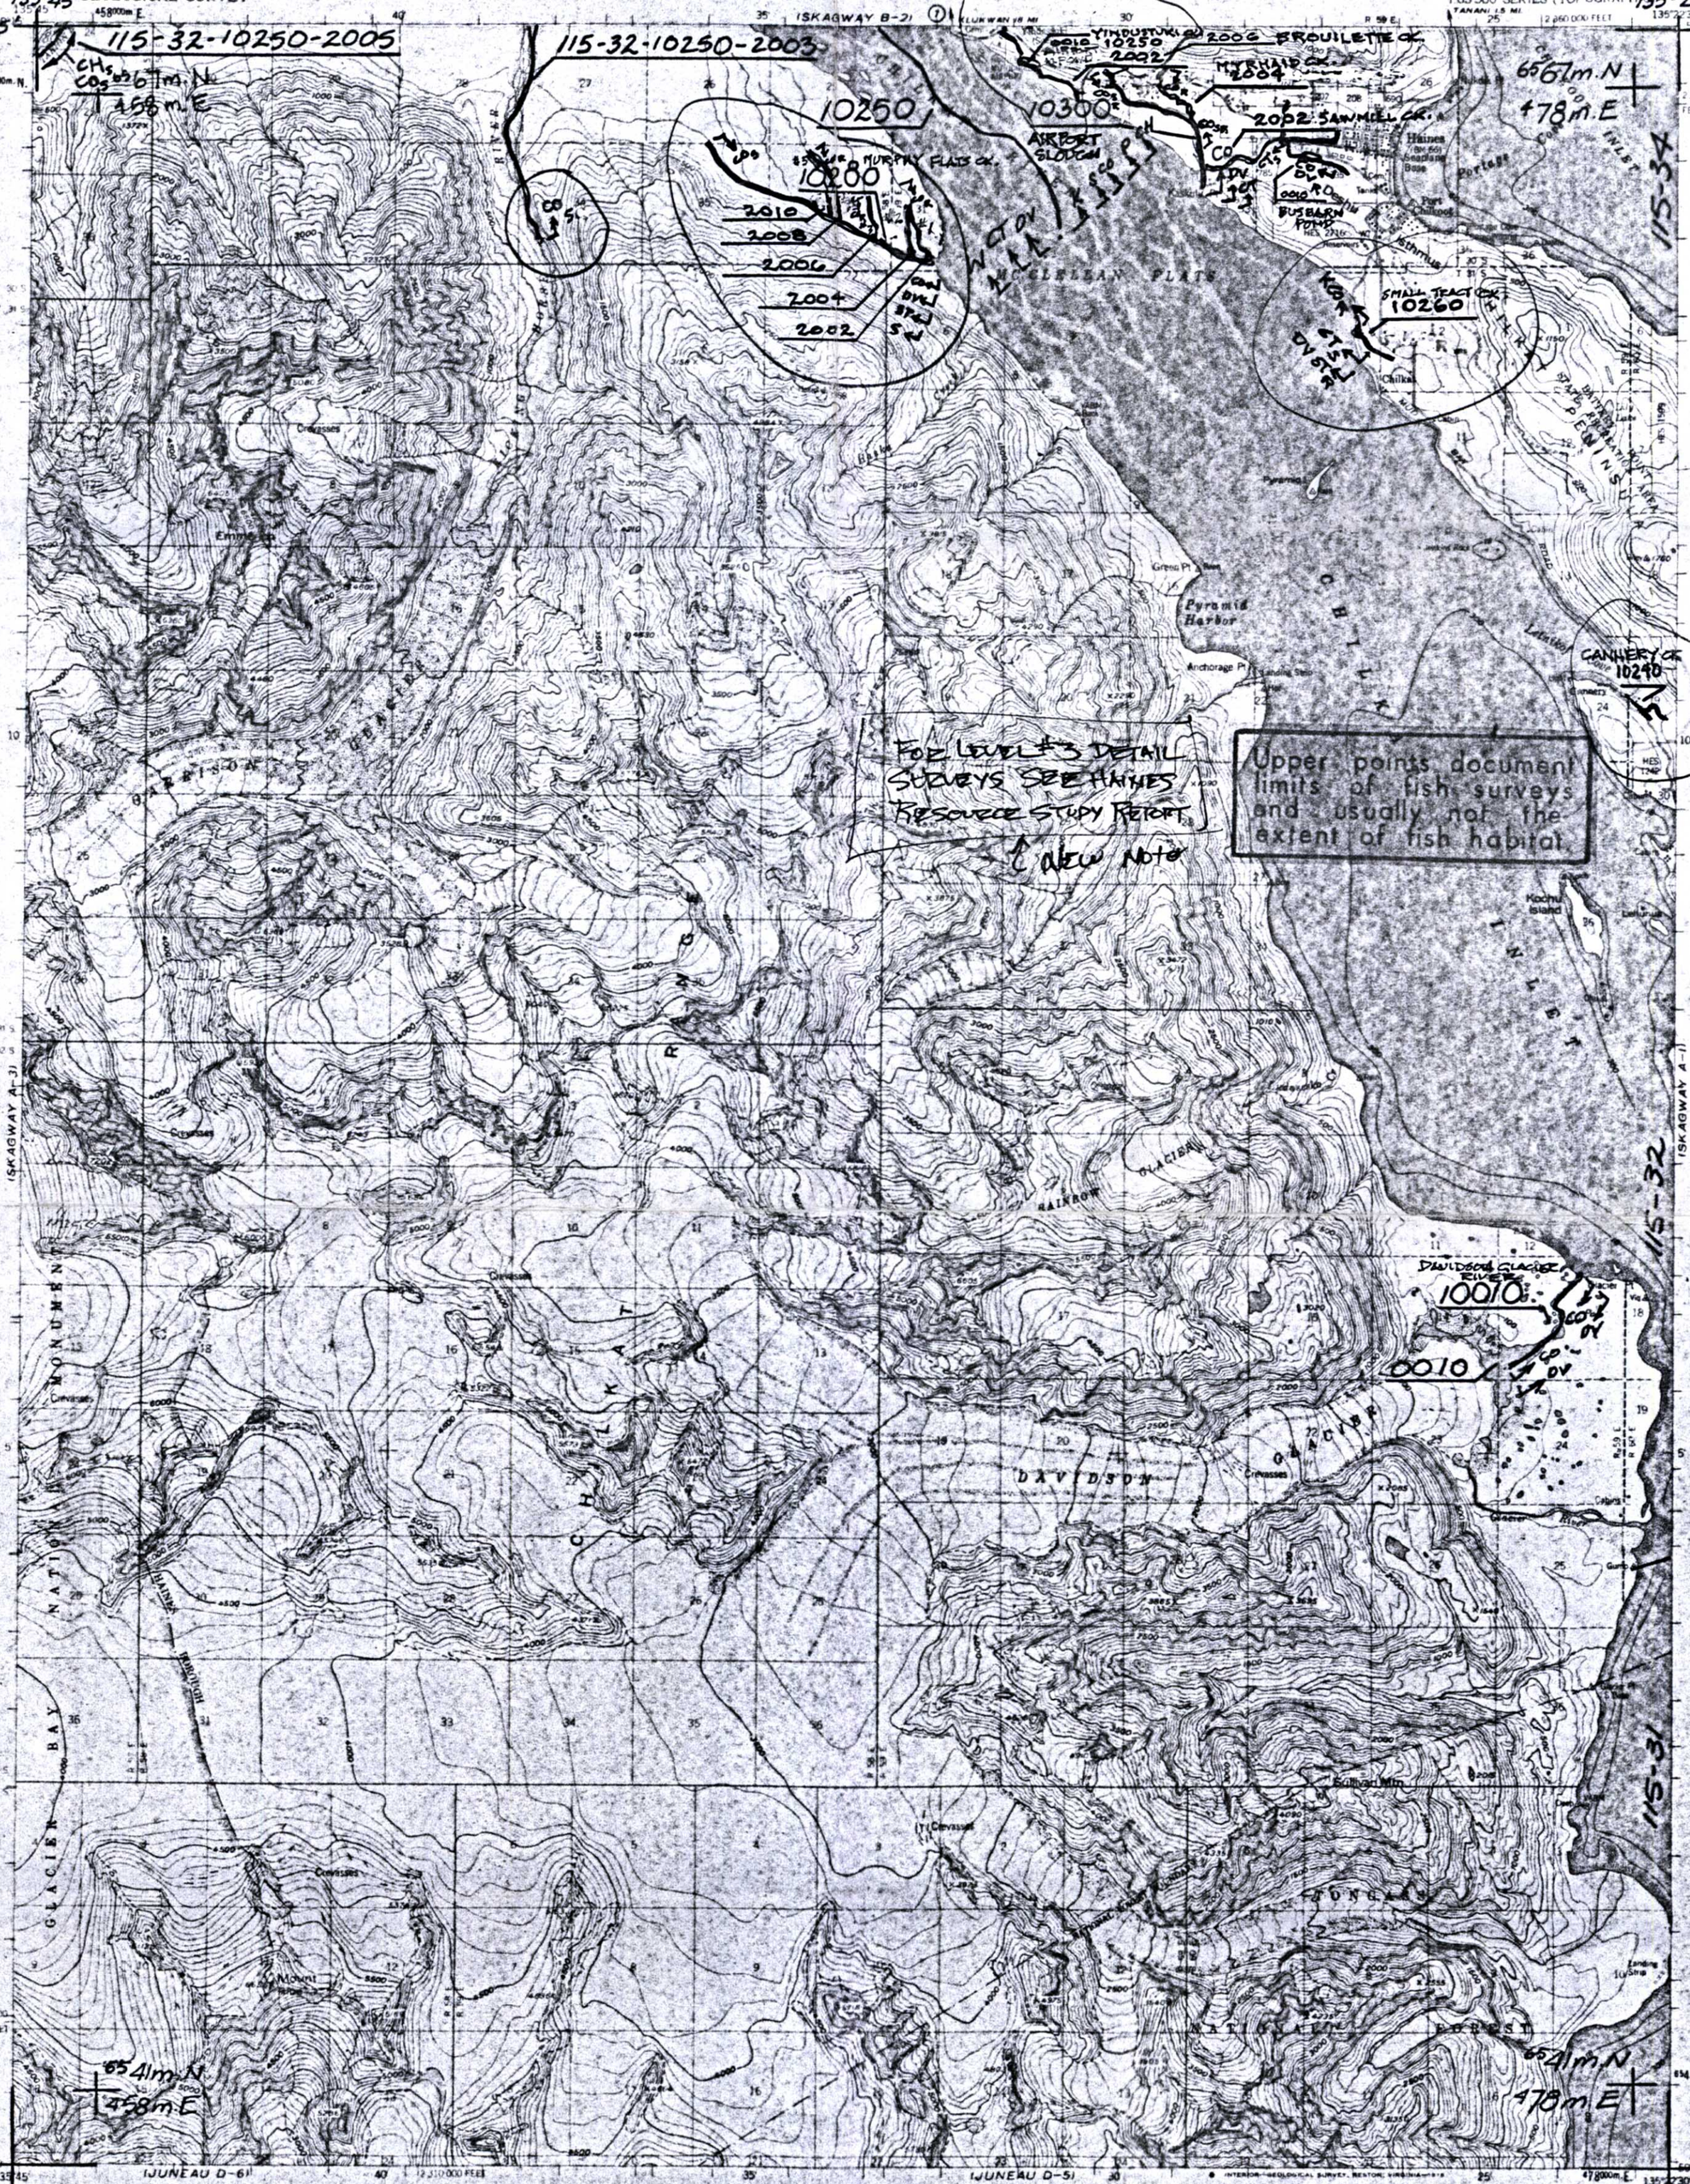

Mapped, edited, and published by the Geological Survey
Control by USGS and USC&GS
Topography by photogrammetric methods from aerial photographs taken 1948. Field annotated 1954. Map not field checked
Selected hydrographic data compiled from USC&GS Chart 8303 (1954). This information is not intended for navigational purposes
Universal Transverse Mercator projection, 1927 North American datum
10,000-foot grid based on Alaska coordinate system, zone 1
1000-meter Universal Transverse Mercator grid ticks, zone 8, shown in blue
Gray land lines represent unsurveyed and unmarked locations predetermined by the State of Alaska, Division of Lands
Copper River Meridian

TRUE NORTH
MAGNETIC NORTH
APPROXIMATE MEAN DECLINATION, 1954

SCALE 1:63 360

CONTOUR INTERVAL 100 FEET
NATIONAL GEODETIC VERTICAL DATUM OF 1929
DEPTH CURVES IN FEET-DATUM IS MEAN LOWER LOW WATER
SHORELINE SHOWN REPRESENTS THE APPROXIMATE LINE OF MEAN HIGH WATER
THE MEAN RANGE OF TIDE IS APPROXIMATELY 13 FEET

FOR SALE BY U.S. GEOLOGICAL SURVEY
FAIRBANKS, ALASKA 99701 DENVER, COLORADO 80225 OR RESTON, VIRGINIA 22092
A FOLDER DESCRIBING TOPOGRAPHIC MAPS AND SYMBOLS IS AVAILABLE ON REQUEST

ROAD CLASSIFICATION
Medium-duty — Light-duty
Unimproved dirt
State Route

QUADRANGLE LOCATION

SKAGWAY (A-2), ALASKA
N5900—W13522.5/15X22.5
1954
LIMITED REVISIONS 1977

MAP NO.
A-2
OF
14

LEGEND

S	Sockeye Salmon
K	King Salmon
CO	Coho Salmon
P	Pink Salmon
CH	Chum Salmon
SH	Steelhead Trout
DV	Dolly Varden
AC	Arctic Char
SF	Sheefish
W	Whitefish
C	Cutthroat Trout

Subscript
s - Known Spawning
r - Rearing
* m - Migration

* Migration upstream is assumed for stream reaches where anadromous fish occur.

COMP. DRS
DRAWN CB
REVISED DRS
APPROVED ERL
DATE 4/82
FILE NO.

SCALE
1" = 1 MILE
1 : 63,360

PROJ. TITLE
ANADROMOUS STREAM CATALOG
ANADROMOUS WATERS ARE LISTED PURSUANT TO AS 16.05.870 (a)

MAP TITLE
SKAGWAY, A-2

STATE OF ALASKA
DEPARTMENT OF FISH AND GAME
habitat protection division
JUNEAU, ALASKA

BY	DATE
Mercott	6/16/81
REVISIONS	

JE
10/81