83-963

State of Alaska
Department of Fish and Game
Public Review Nomination for Waters
Important to Anadromous Species

☐ Addition ☑ Deletion

Name of Waterbody (if known): POINT WHITE CREEK (NORTH FORK)

Location:

Anadromous Waters Catalog Volume and Number SOUTHEAST REGION

USGS 1:63,360 Quadrangle SUMDUM A-6

or 1:250,000 (if 1:63,360 not available) _____

Species	Date(s) Observed	Stage(s) (Spawning, Rearing, Migration)

Comments: Please provide any clarifying information in addition to identification on Anadromous Waters Catalog Public Review Maps.

A 50'-60' BARRIER FALLS, LOCATED IN SECTION 17 T 56S, R 72E IS A BARRIER TO UPSTREAM MOVEMENT OF ANADROMOUS FISH. DELETE THIS PORTION OF THE NORTH FORK OF PT. WHITE CK.

PKW 3/3/83 Stream # ~~[illegible]~~ ~~[illegible]~~ 109-42-10010 CB

Name of Observer (please print) DONALD G. KELLY

Date: 2/25/83 Signature: Donald G. Kelly

drafting done CB

UNITED STATES
DEPARTMENT OF THE INTERIOR
GEOLOGICAL SURVEY

FINAL

SUMDUM (A-6) QUADRANGLE
ALASKA
1:63 360 SERIES (TOPOGRAPHIC)

134°00' 57°15' 133°40' 57°15'

83-966

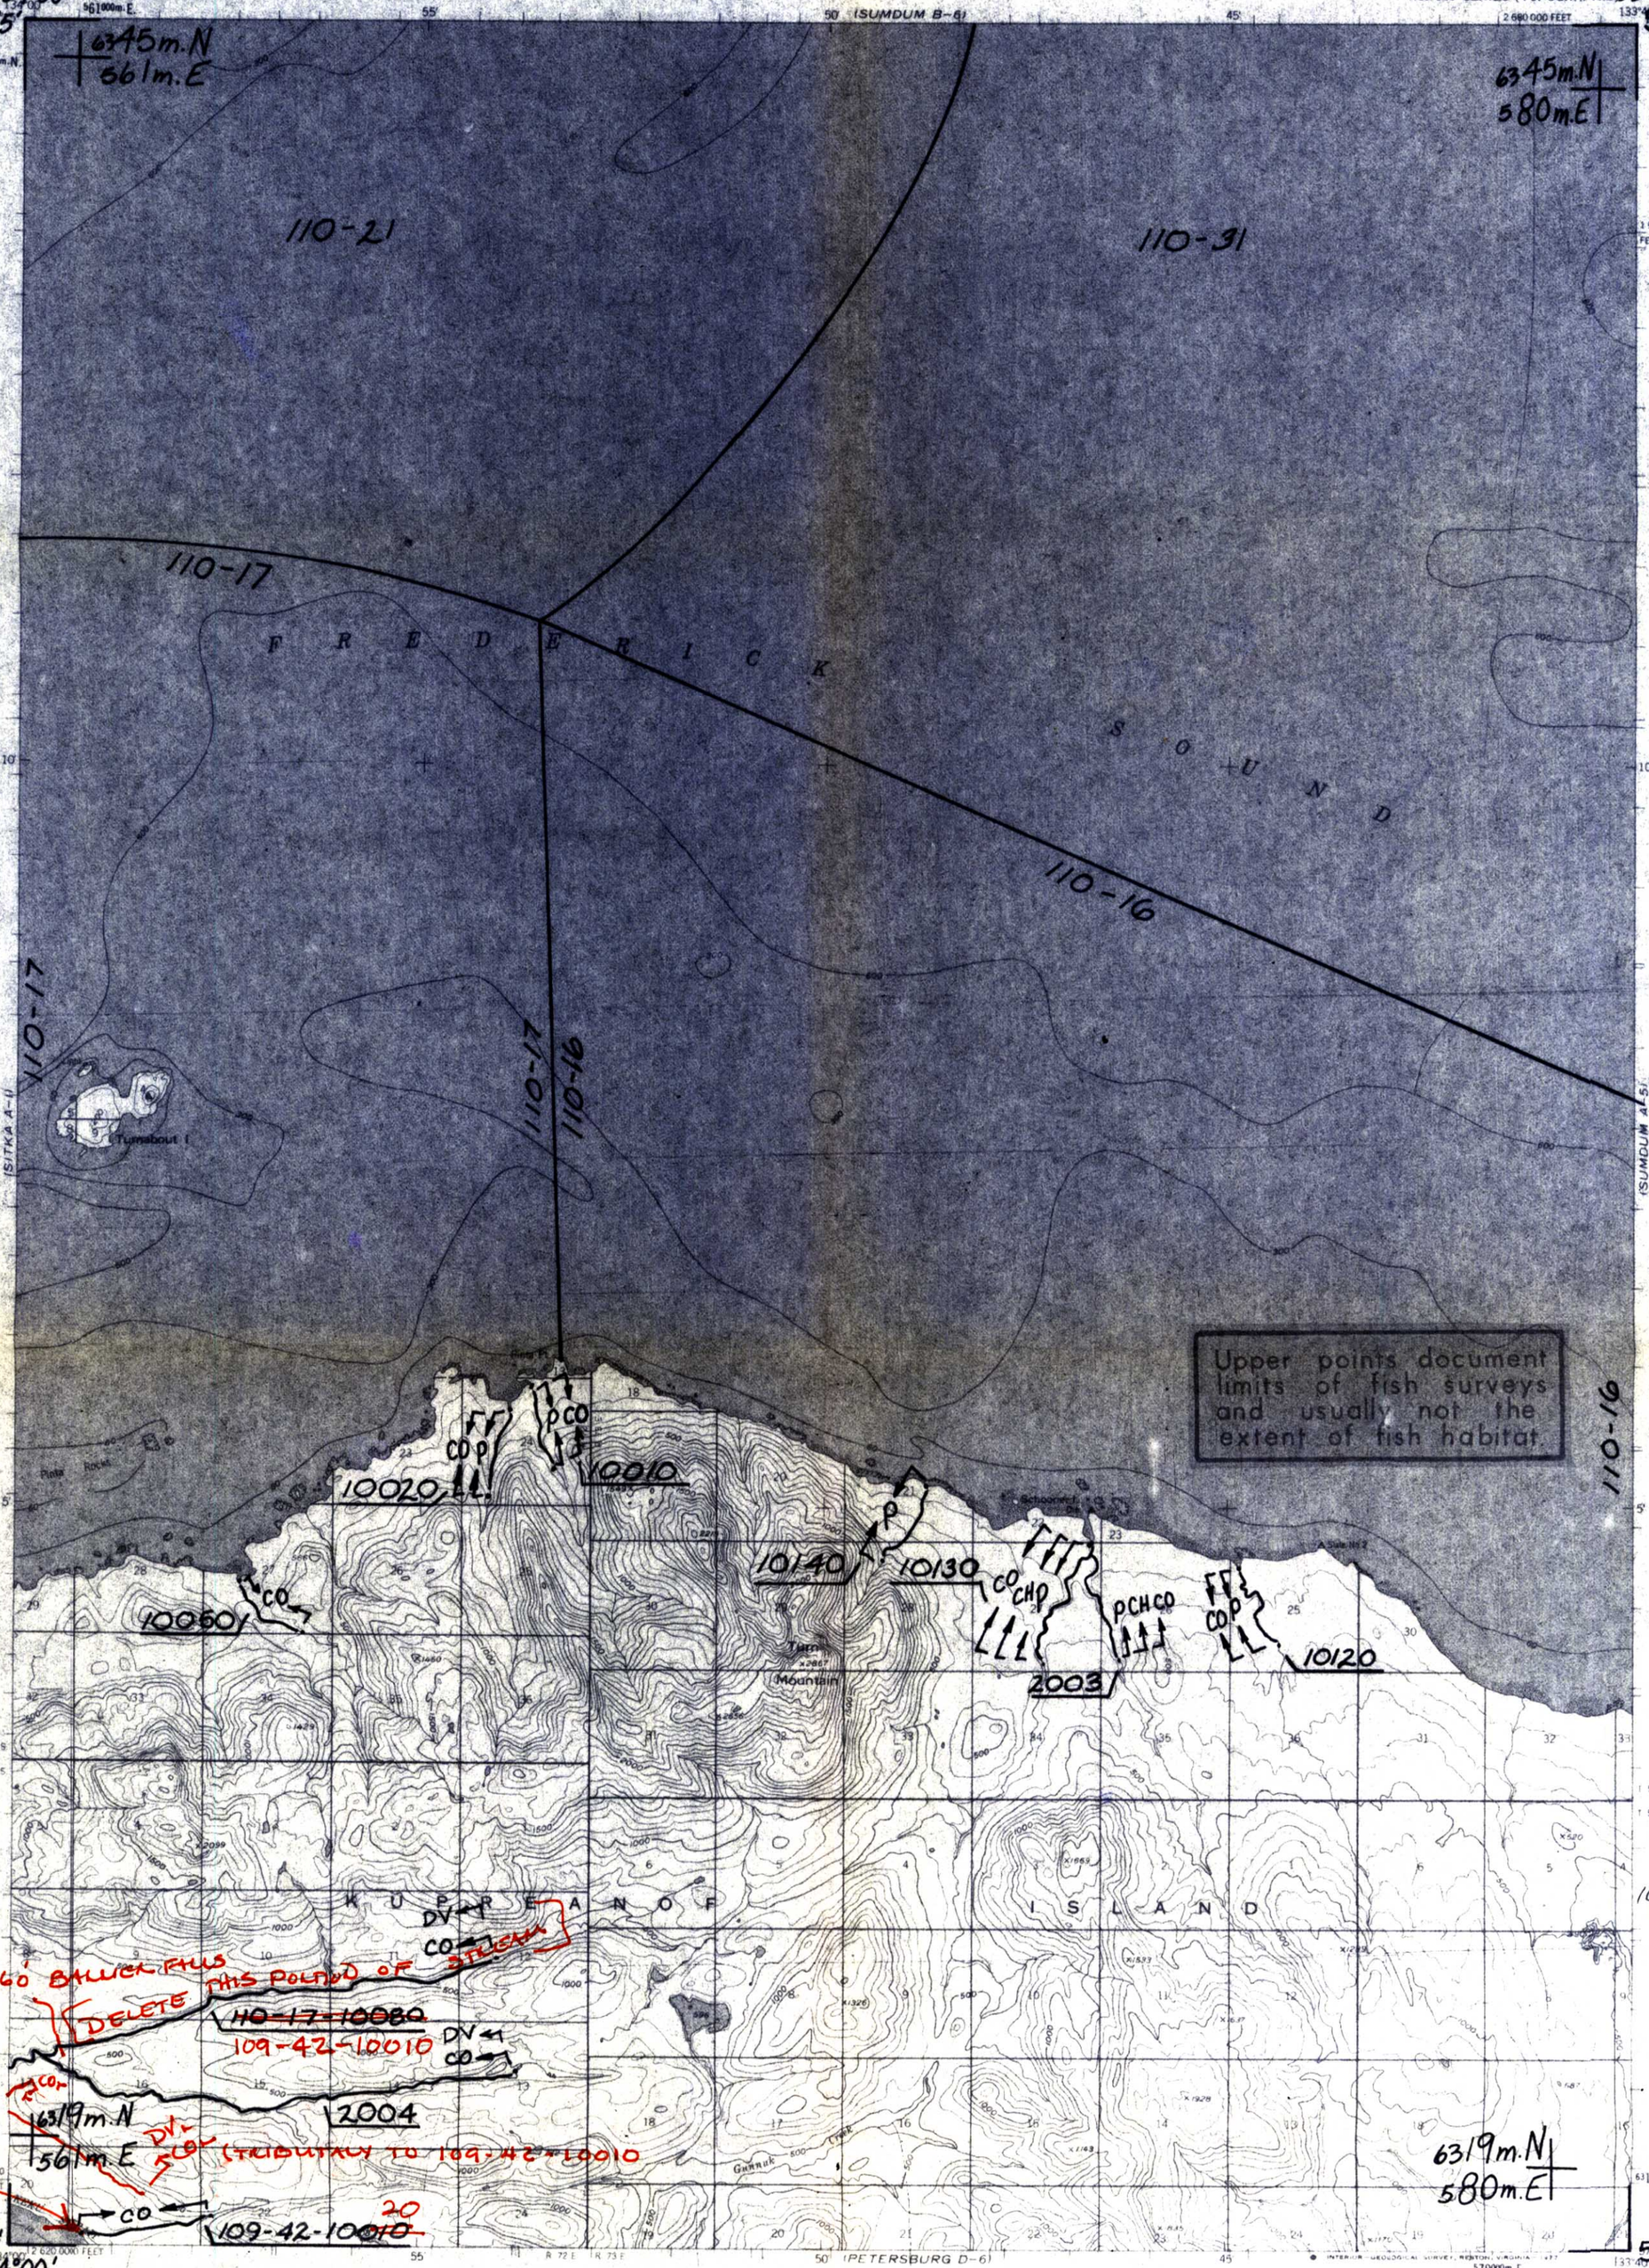

Ja
DK
SS
GC
DES
10/81

Map compiled, edited, and published by the Geological Survey

Control by USGS and USC&GS

Topography by photogrammetric methods from aerial photographs taken 1948. Map not field checked

Selected hydrographic data compiled from USC&GS Chart 8201 (1:217 828 scale) 1956. This information is not intended for navigational purposes

Universal Transverse Mercator projection. 1927 North American datum 10,000-foot grid based on Alaska coordinate system, zone 1 1000-meter Universal Transverse Mercator grid ticks, zone 8, shown in blue

Land lines represent unsurveyed and unmarked locations predetermined by the State of Alaska, Division of Lands, Folio CR-14, Copper River Meridian

Swamps, as portrayed, indicate only the wetter areas usually of low relief, as interpreted from aerial photographs

Entire land area is within the Tongass National Forest

National forest boundaries represent proclamation lines and do not necessarily imply Federal jurisdiction

29½°
TRUE NORTH
MAGNETIC NORTH
APPROXIMATE MEAN DECLINATION, 1948

SCALE 1:63360

CONTOUR INTERVAL 100 FEET
NATIONAL GEODETIC VERTICAL DATUM OF 1929
DEPTH CURVES IN FEET–DATUM IS MEAN LOWER LOW WATER
SHORELINE SHOWN REPRESENTS THE APPROXIMATE LINE OF MEAN HIGH WATER
THE AVERAGE RANGE OF TIDE IS APPROXIMATELY 12 FEET

FOR SALE BY U. S. GEOLOGICAL SURVEY
FAIRBANKS, ALASKA 99701, DENVER, COLORADO 80225, OR RESTON, VIRGINIA 22092
A FOLDER DESCRIBING TOPOGRAPHIC MAPS AND SYMBOLS IS AVAILABLE ON REQUEST

ROAD CLASSIFICATION
No roads or trails in this area

QUADRANGLE LOCATION

SUMDUM (A-6), ALASKA
(N5700—W3340/15X20)
1948

MAP NO. A-6 OF 9

LEGEND

S	Sockeye Salmon
K	King Salmon
CO	Coho Salmon
P	Pink Salmon
CH	Chum Salmon
SH	Steelhead Trout
DV	Dolly Varden
AC	Arctic Char
SF	Sheefish
W	Whitefish
C	Cutthroat Trout

Subscript
s - Known Spawning
r - Rearing
* m - Migration

* Migration upstream is assumed for stream reaches where anadromous fish occur.

COMP. DRC
DRAWN CB
REVISED DRC
APPROVED ERL
DATE 4/82
FILE NO.

SCALE
1" = 1 MILE
1 : 63,360

PROJ. TITLE
ANADROMOUS STREAM CATALOG
ANADROMOUS WATERS ARE LISTED PURSUANT TO AS 16.05.870(a)

MAP TITLE
SUMDUM, A-6

STATE OF ALASKA
DEPARTMENT OF FISH AND GAME
habitat protection division
JUNEAU, ALASKA

BY	DATE
REVISIONS	