State of Alaska
Department of Fish and Game
Public Review Nomination for Waters
Important to Anadromous Species

83-979

☒ Addition ☐ Deletion

Name of Waterbody (if known): _____

Location:

Anadromous Waters Catalog Volume and Number _____

USGS 1:63,360 Quadrangle Craig A-1

or 1:250,000 (if 1:63,360 not available) _____

Species	Date(s) Observed	Stage(s) (Spawning, Rearing, Migration)
Pink		spawning

Comments: Please provide any clarifying information in addition to identification on Anadromous Waters Catalog Public Review Maps.

9 streams Craig A-1 w/ pink

① T78S R88E section 11 102-30-10390

② T78S R89E section 16 102-20-10010

③ T 78S R88E section 23 102-30-10800

④ T 78S R88E section 15 102-30-10816

Name of Observer (please print) PHILIP DOHERTY

Date: 1-18-83 Signature: Philip Doherty

⑤ T 78S R88E section 8 102-30-10850

⑥ T 78S R88E section 9 102-30-10840

⑦ T 77S R 88E section 16 102-40-10280

⑧ T 77S R 88E section 31 102-40-10250

3/83

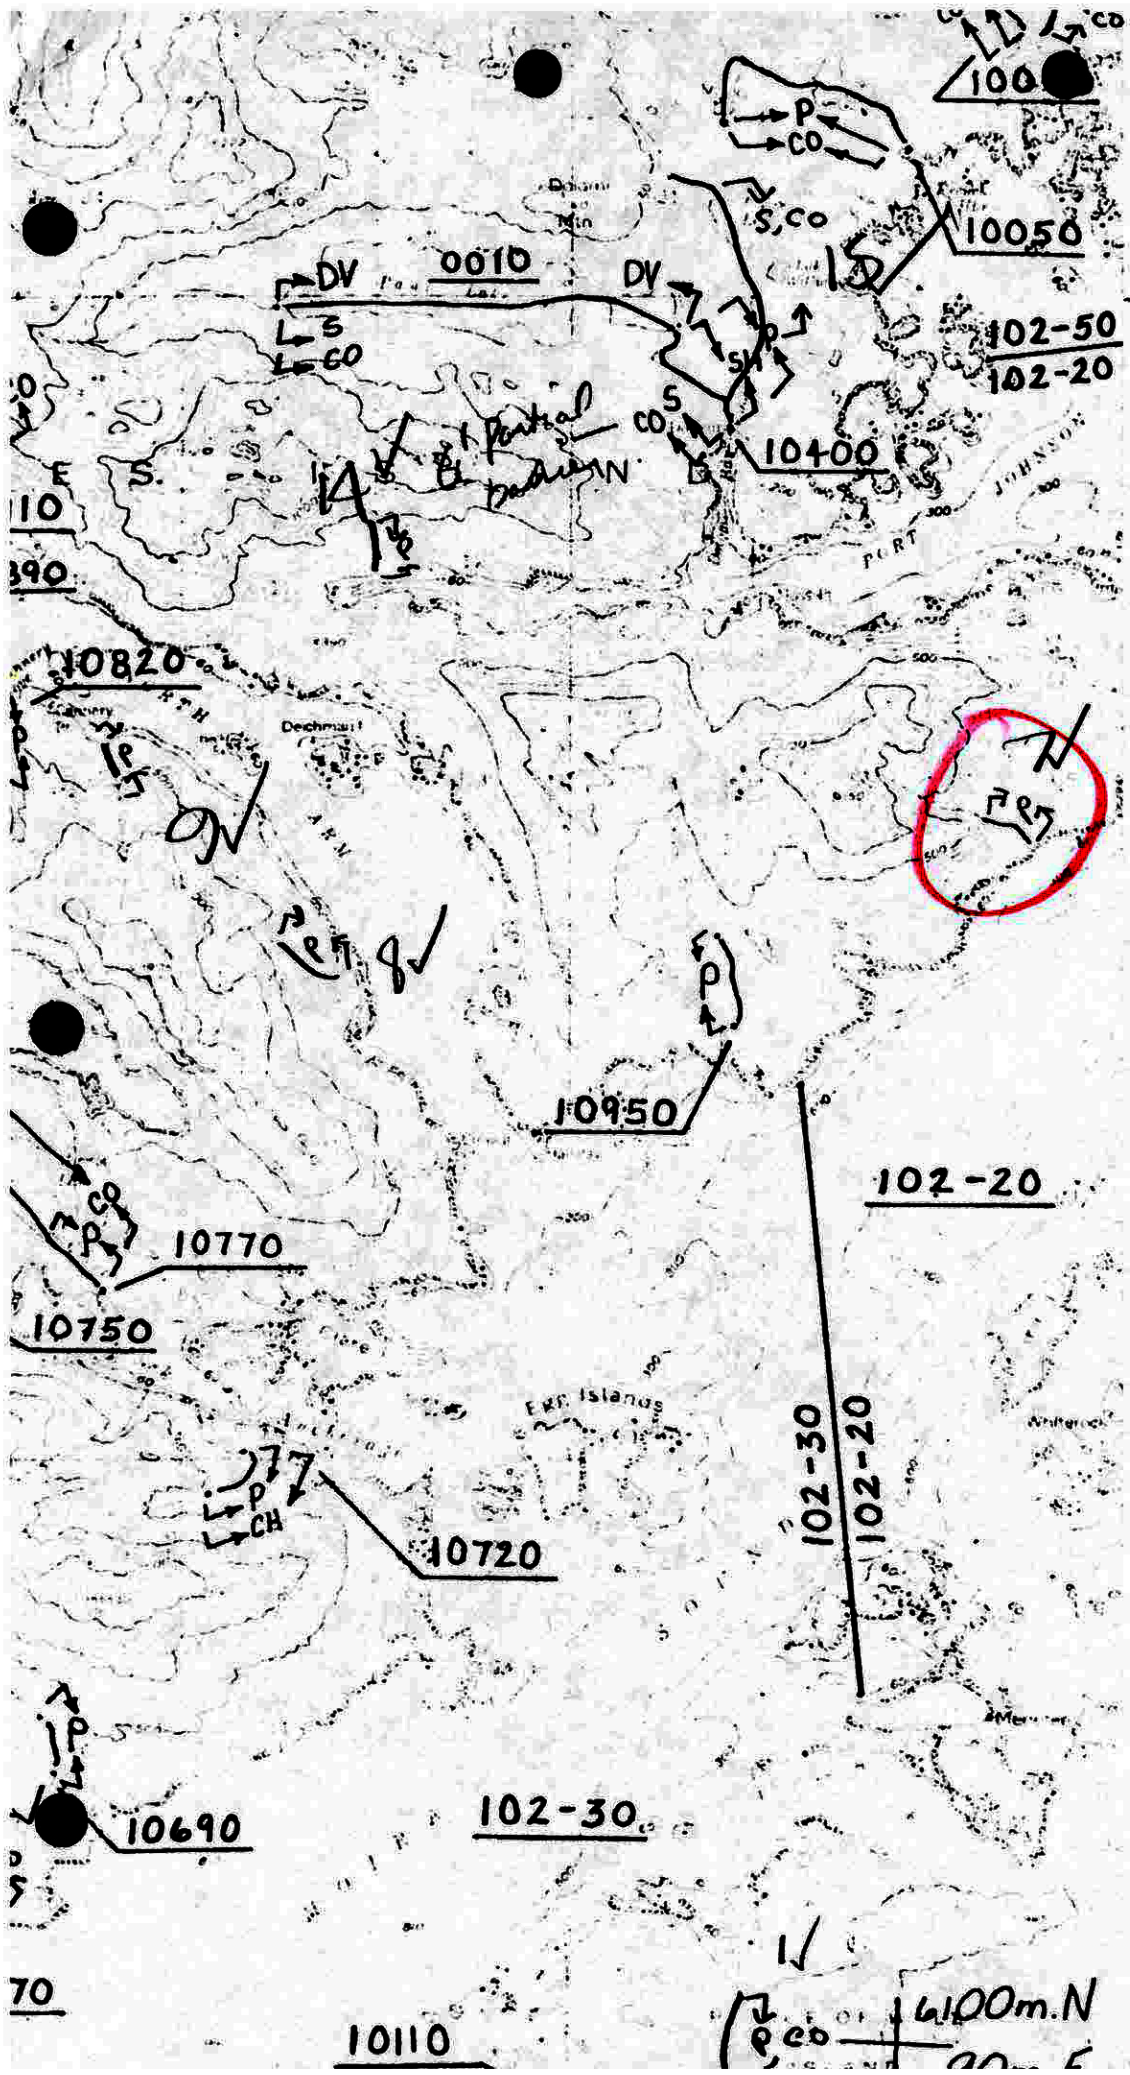

100
P
CO
S,CO
10050
15
DV
0010
DV
S
CO
102-50
102-20
SH
S
CO
10400
14
1 partial
PORT
JOHNSON
10820
Deichman
9
8
P
10950
102-20
CO
P
10770
10750
Egg Islands
102-30
102-20
P
CH
10720
P
10690
102-30
70
10110
6100m.N

DK

10/81

UNITED STATES
DEPARTMENT OF THE INTERIOR
GEOLOGICAL SURVEY

CRAIG (A-1) QUADRANGLE
ALASKA
1:63,360 SERIES (TOPOGRAPHIC)

FINAL

83-994

Could not find a nom. form
Durand 4-10-84

Upper points document limits of fish surveys and usually not the extent of fish habitat.

Published and published by the Geological Survey

Control by USGS and USC&GS

Topography by photogrammetric methods from aerial photographs taken 1948. Map not field checked

Selected hydrographic data compiled from USC&GS Charts 8074 (1:10,000 scale), 8076, and 8102 (1:229,976 scale). This information is not intended for navigational purposes

Universal Transverse Mercator projection, 1927 North American 10,000-foot grid based on Alaska coordinate system, zone 1. 1000 meter Universal Transverse Mercator grid ticks, zone 8, shown in blue

Land lines represent unsurveyed and unmarked locations predetermined by the State of Alaska, Division of Lands Folios CR-16 and CR-17, Copper River Meridian and from computations for the Copper River Meridian

Entire land area is within the Tongass National Forest

Lake elevations are unchecked

APPROXIMATE MEAN DECLINATION, 1948

SCALE 1:63,360

CONTOUR INTERVAL 100 FEET
NATIONAL GEODETIC VERTICAL DATUM OF 1929
DEPTH CURVES AND SOUNDINGS IN FEET. DATUM IS MEAN LOWER LOW WATER
SHORELINE SHOWN REPRESENTS THE APPROXIMATE LINE OF MEAN HIGH WATER
THE AVERAGE RANGE OF TIDE IS APPROXIMATELY 12 FEET

FOR SALE BY U.S. GEOLOGICAL SURVEY
FAIRBANKS, ALASKA 99701, DENVER, COLORADO 80225, OR RESTON, VIRGINIA 22092
A FOLDER DESCRIBING TOPOGRAPHIC MAPS AND SYMBOLS IS AVAILABLE ON REQUEST

ROAD CLASSIFICATION
Trail

QUADRANGLE LOCATION

CRAIG (A-1), ALASKA
N5500—W13200/15X20
1948

MAP NO. A-1 OF 3

LEGEND

S	Sockeye Salmon
K	King Salmon
CO	Coho Salmon
P	Pink Salmon
CH	Chum Salmon
SH	Steelhead Trout
DV	Dolly Varden
AC	Arctic Char
SF	Sheefish
W	Whitefish
C	Cutthroat Trout

Subscript
s - Known Spawning
r - Rearing
* m - Migration

*Migration upstream is assumed for stream reaches where anadromous fish occur.

COMP. DRC
DRAWN CB
REVISED DRC
APPROVED ERL
DATE 4/82
FILE NO.

SCALE 1" = 1 MILE 1 : 63,360

PROJ. TITLE
ANADROMOUS STREAM CATALOG
ANADROMOUS WATERS ARE LISTED PURSUANT TO AS 16.05.870 (a)

MAP TITLE
CRAIG A-1

STATE OF ALASKA
DEPARTMENT OF FISH AND GAME
habitat protection division
JUNEAU, ALASKA

BY	DATE
PSD	6/3/21
K. Francis	6/10/21
R. Bidrae	9/16/21
RD	H7-83
REVISIONS	

DK 10/81

MP USGS 9/16/21