Department of Fish and Game
Public Review Nomination for Waters
Important to Anadromous Species

84-302

X Addition ____ Deletion

Name of Waterbody (if known): _____

Location:

Anadromous Waters Catalog Volume and Number S.E. Alaska 101-90-96

USGS 1:63,360 Quadrangle Ketchikan D-6

or 1:250,000 (if 1:63,360 not available) _____

Species	Date(s) Observed	Stage(s) (Spawning, Rearing, Migration)
Steelhead	7/28/84	rearing, spawning available
Cutthroat	7/28/84	rearing, spawning available

Comments: Please provide any clarifying information. Also, please include a map of the area identifying the stream reach. This can be a copy of the map from the Anadromous Waters Atlas.

Rearing steelhead trapped: Plenty of spawning area and rearing habitat available. Rearing cutthroat trapped.

Add Stream # 101-90-10960-2002 2010

STS 10/30/84

Drafted Jew 10/84

Name of Observer (please print) Jim Caviello

Date: 9/7/84 Signature: Donald G. Kelly Area Habitat Bio

Address: PO Box 667 Petersburg 99833

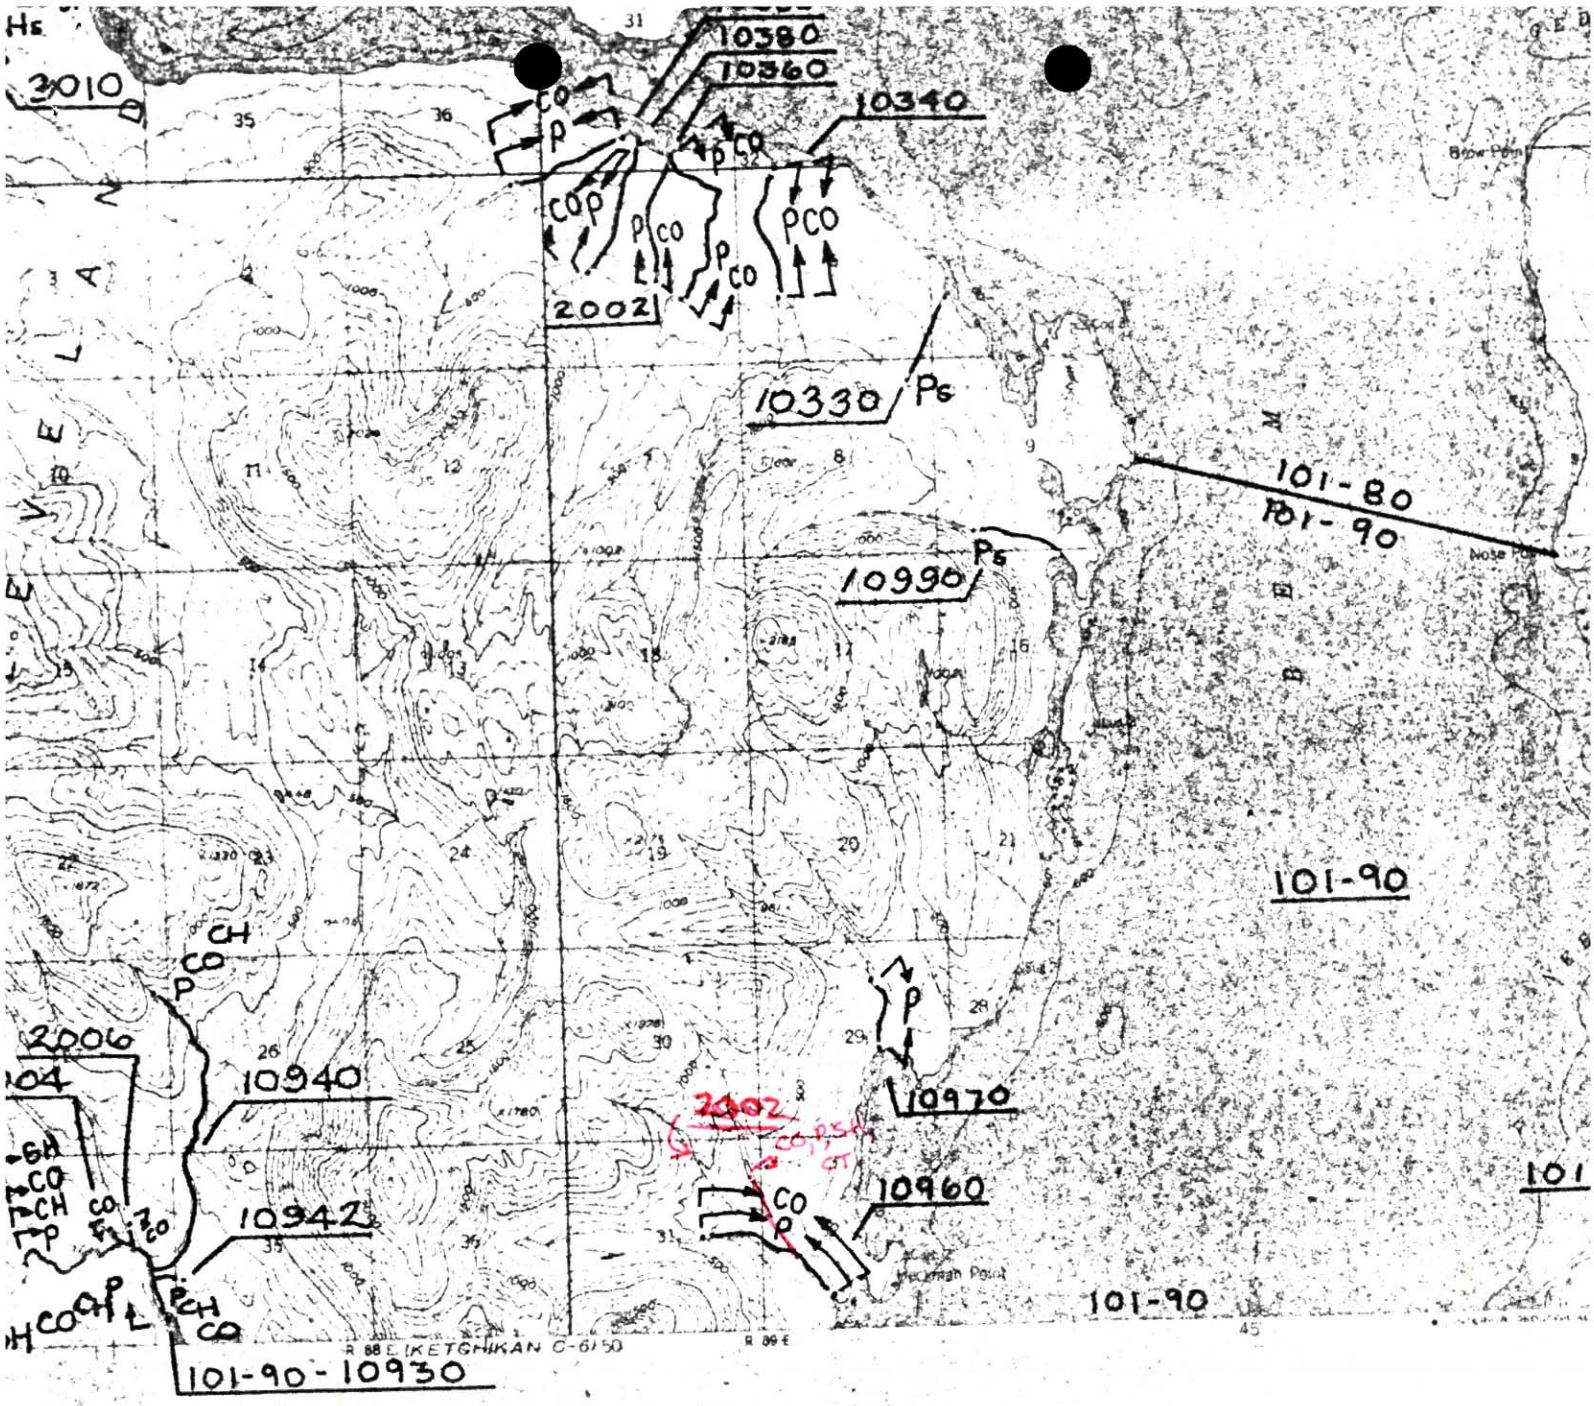

CONTOUR INTERVAL 100 FEET

DATUM IS MEAN SEA LEVEL

DEPTH CURVES IN FEET. DATUM IS MEAN LOWER LOW WATER

SHORE LINE SHOWN REPRESENTS THE APPROXIMATE LINE OF MEAN HIGH WATER

THE AVERAGE RANGE OF TIDE IS APPROXIMATELY [illegible] FEET

FOR SALE BY U. S. GEOLOGICAL SURVEY

FAIRBANKS, ALASKA DENVER 25, COLORADO WASHINGTON 25, D. C.

A CATALOG DESCRIBING TOPOGRAPHIC MAPS AND SYMBOLS IS AVAILABLE ON REQUEST

QUADRANGLE LOCATION

KET

SCALE 1:63,360

PROJ. TITLE

ANADROMOUS STREAM CATALOG

ANADROMOUS WATERS ARE LISTED PURSUANT TO AS 16.05.870 (a)

MAP TITLE

KETCHIKAN D-6

SCALE

STATE OF

DEPARTMENT OF

N 1

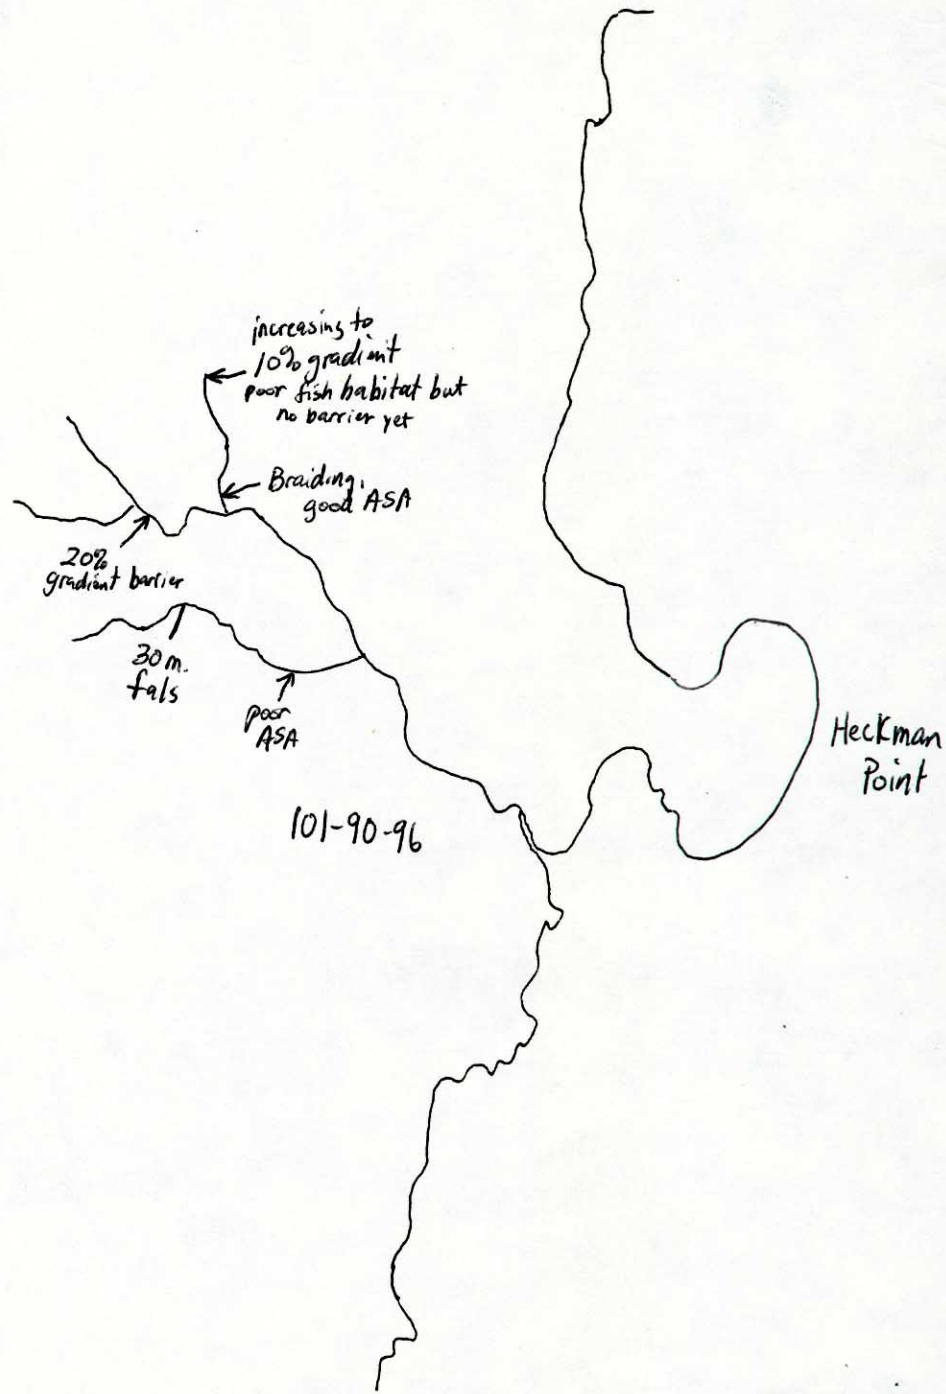
increasing to 10% gradient poor fish habitat but no barrier yet
Braiding, good ASA
20% gradient barrier
30 m. fals
poor ASA
101-90-96
Heckman Point

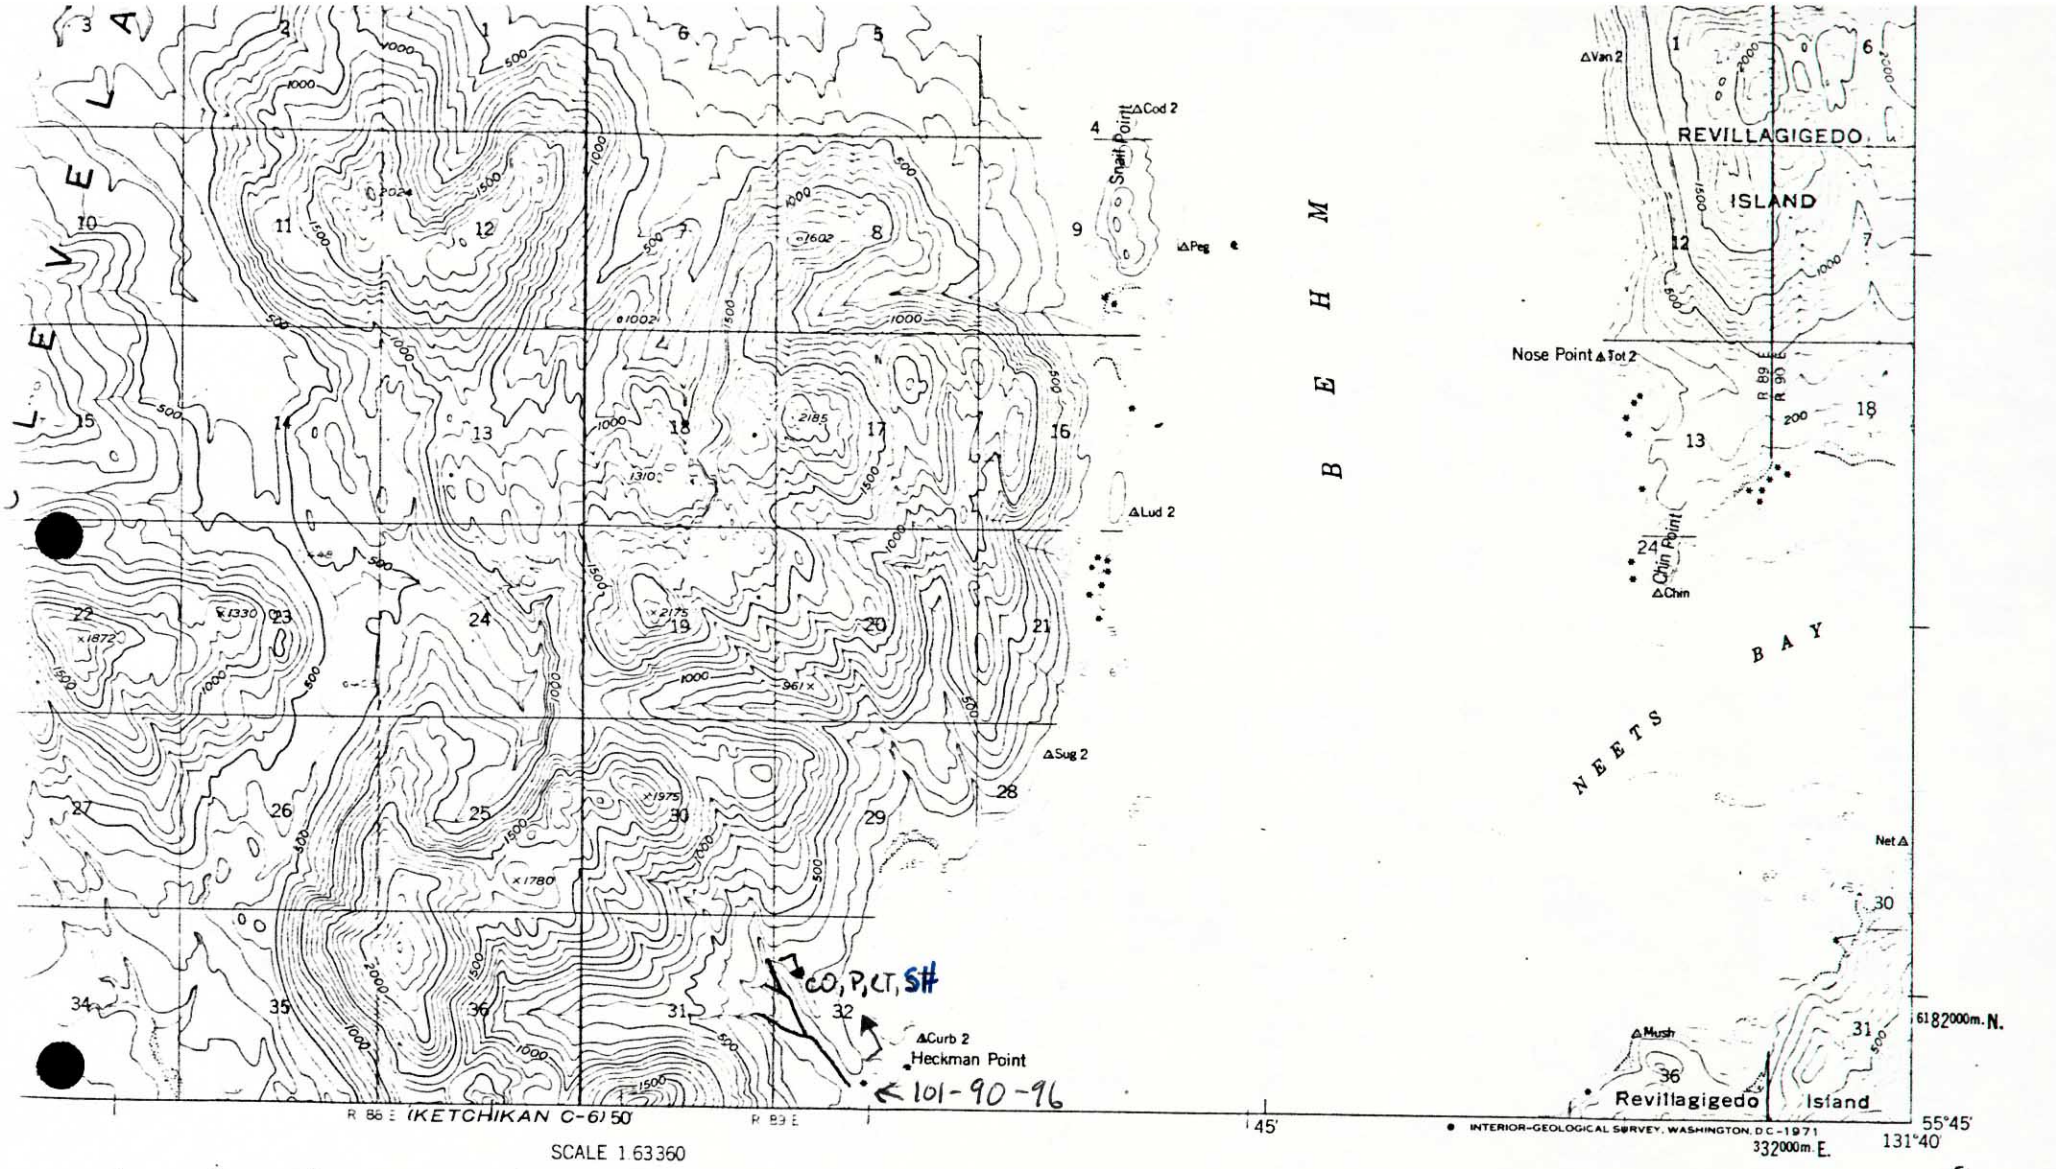

FOR SALE BY U. S. GEOLOGICAL SURVEY
FAIRBANKS, ALASKA 99701, DENVER, COLORADO 80225 OR WASHINGTON, D. C. 20242
A FOLDER DESCRIBING TOPOGRAPHIC MAPS AND SYMBOLS IS AVAILABLE ON REQUEST

KETCHIKAN (D-6), ALASKA

N5545—W13140/15X20

1952

MINOR REVISIONS 1963