State of Alaska
Department of Fish and Game
Public Review Nomination for Waters
Important to Anadromous Species

84-328

ALASKA DEPT. OF FISH & GAME
OCT 15 1984
HABITAT REGIONAL OFFICE

✓ Addition ____ Deletion

Name of Waterbody (if known): West Exchange Cove #3

Location:

Anadromous Waters Catalog Volume and Number S.E.Ak.

USGS 1:63,360 Quadrangle Petersburg A-4

or 1:250,000 (if 1:63,360 not available) _____

Species	Date(s) Observed	Stage(s) (Spawning, Rearing, Migration)
Coho fry	6-27-83	rearing

Comments: Please provide any clarifying information. Also, please include a map of the area identifying the stream reach. This can be a copy of the map from the Anadromous Waters Atlas.

Coho fry were found 200 m up from the intertidal zone. Lat. 56° 11'15", Long 133°04'55"
Creek # 3 on attached photocopy
add stream # 106-30-10850-2006

SJS 10/30/84
Drafted Jew 10/84

Name of Observer (please print) RANDOLPH. P. ERICKSEN

Date: 12/16/83 Signature: Donald G. Kelly

Address: Area Habitat Bri

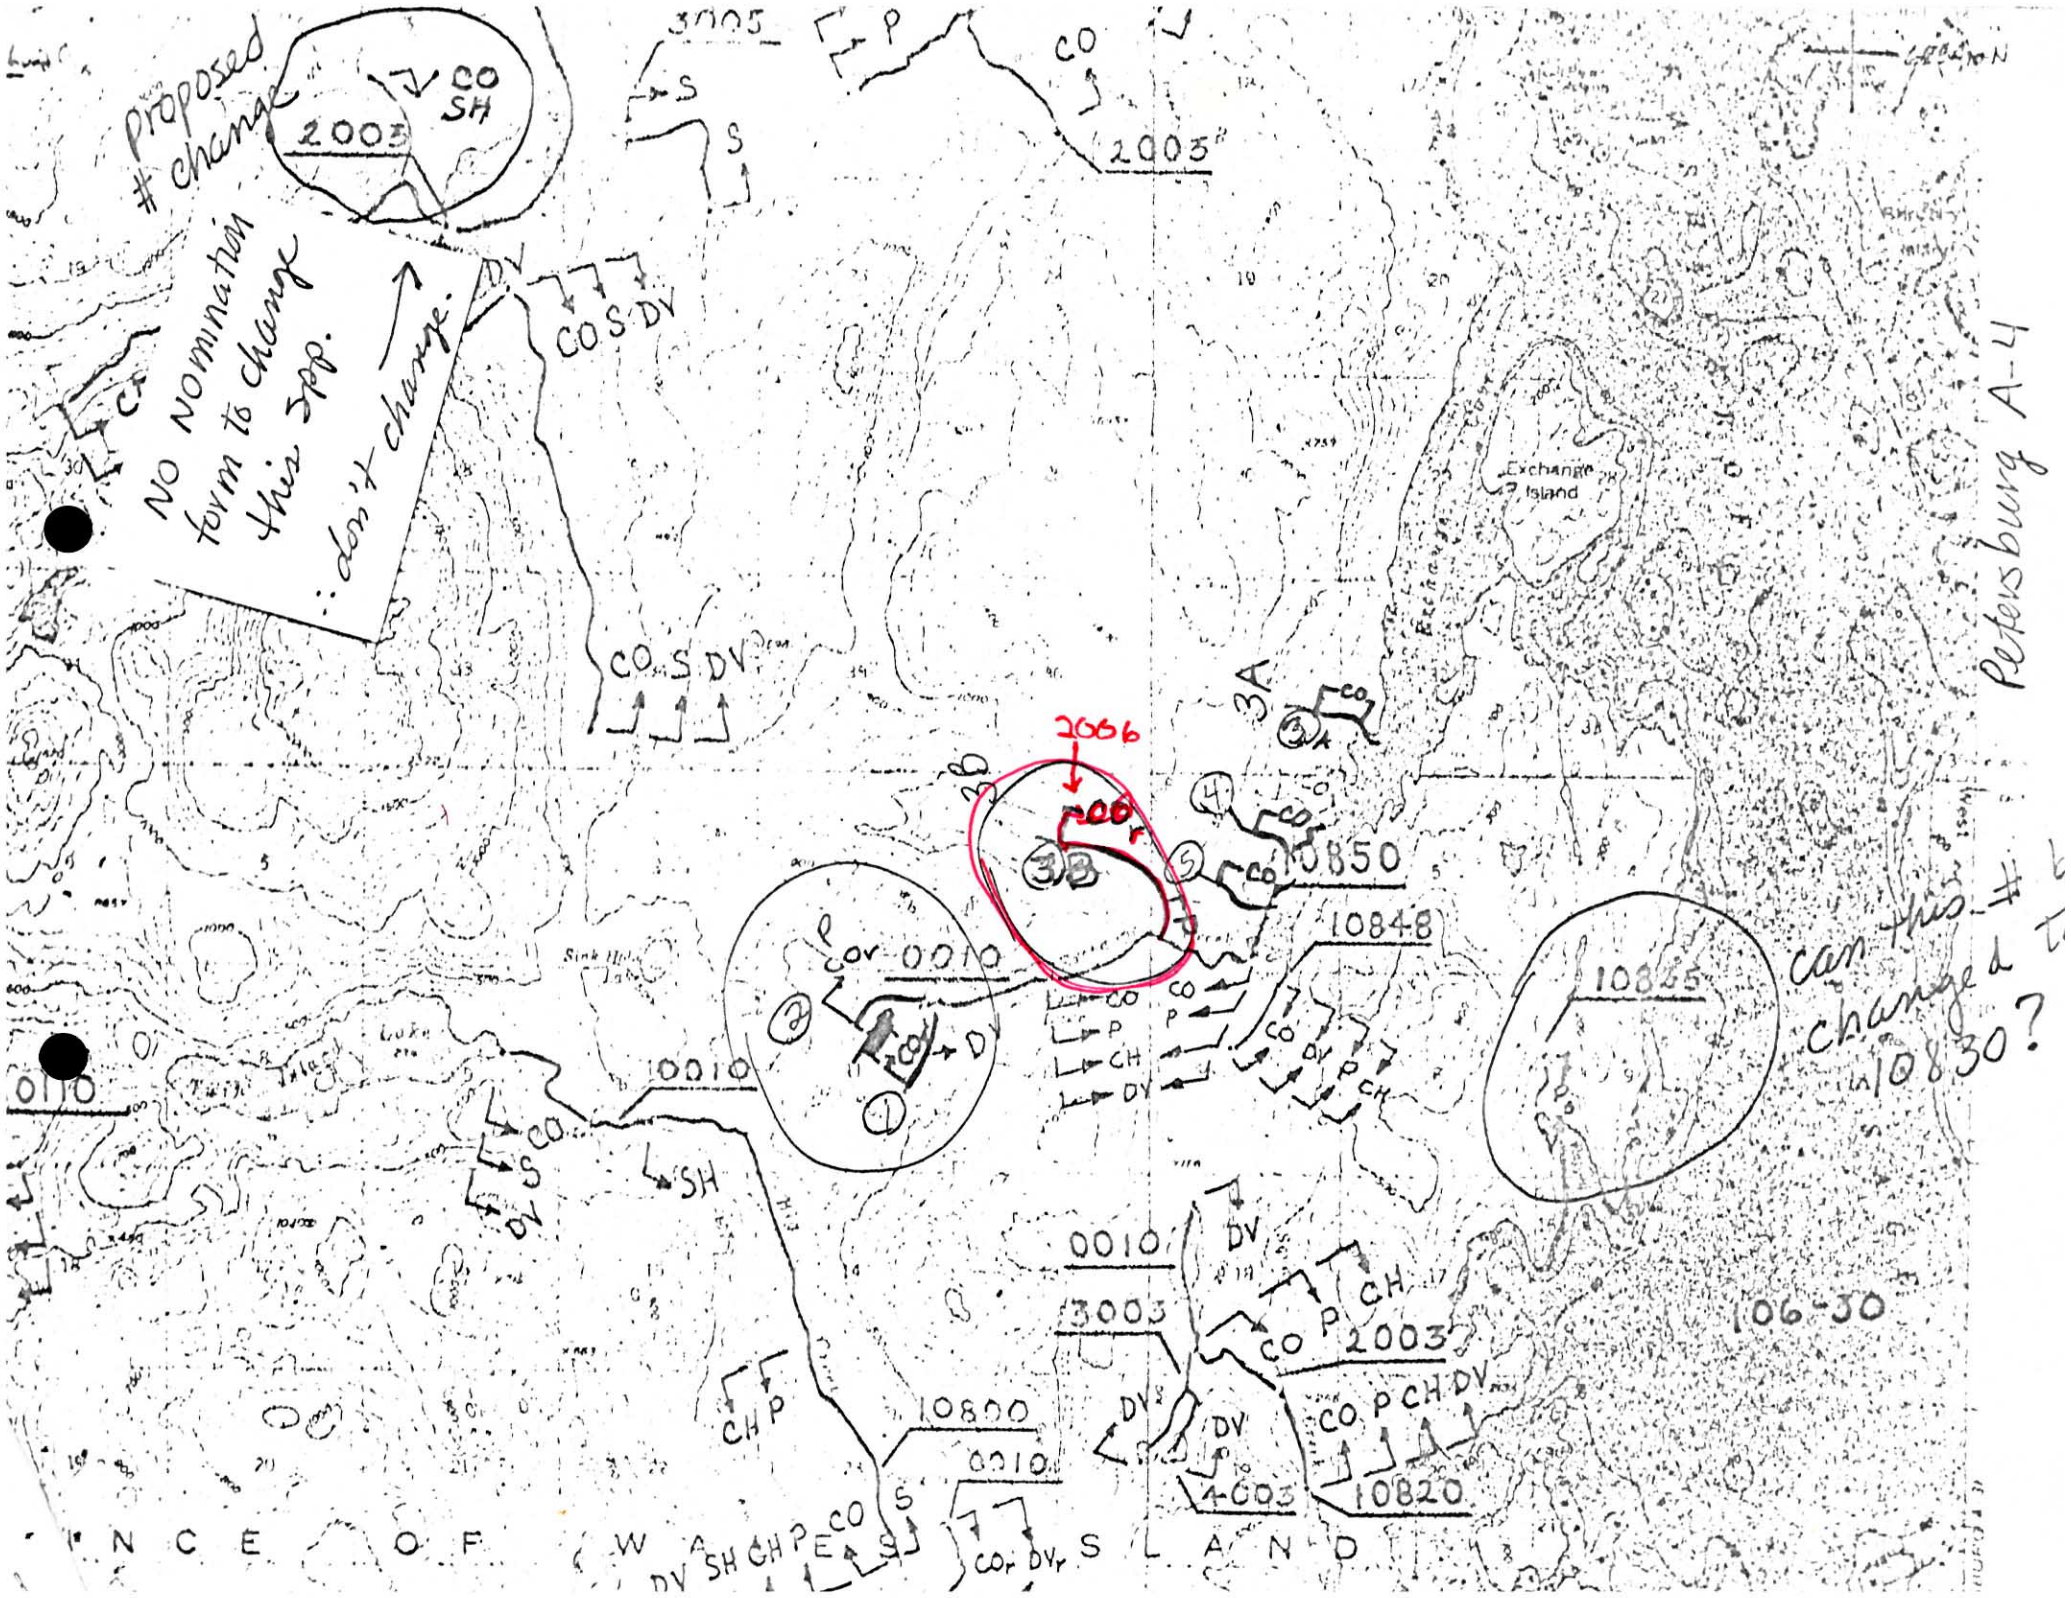
proposed # change
2003
CO SH
NO Nomination form to change this spp.
∴ don't change.
3005
P
CO
2003
S
S
DV
CO S DV
CO S DV
Exchange Island
3A
3B
2006
CO
10850
10848
10845
can this # be changed to 10830?
0010
CO
P
CH
DV
10010
0110
CO
S
DV
SH
0010
DV
3003
CO P CH
2003
CO P CH DV
10820
4003
DV
DV
10800
0010
CH P
CO S
DV SH CH P
CO DV
N C E O F W A L E S I S L A N D
106-30
Petersburg A-4

84-336

proposed # change

No nomination form to change this spp. → don't change.

can this # be changed to 10830?

No nomination forms for ①, ② and ③. don't make change.

No nomination forms for these streams. don't make change.

Upper points are limits of fish and usually not the extent of fish habitat

PRINCE OF WALES ISLAND

Mapped, edited, and published by the Geological Survey

Control by USC&GS

Topography by photogrammetric methods from aerial photographs taken 1948, field annotated 1949. Map not field checked

Selected hydrographic data compiled from USC&GS Charts 8160 (1952), 8171 (1949), 8172 (1951), and 8201 (1951). (1:217,828 scale). This information is not intended for navigational purposes

Universal Transverse Mercator projection, 1927 North American datum 10,000-foot grid based on Alaska coordinate system, zone 1 1000 meter Universal Transverse Mercator grid ticks, zone 8, shown in blue

Land lines represent unsurveyed and unmarked locations predetermined by the State of Alaska, Division of Lands Copper River Meridian

Swamps, as portrayed, indicate only the wetter areas usually of low relief, as interpreted from aerial photographs

Entire land area is within the Tongass National Forest

There may be private inholdings within the boundaries of the National or State reservations shown on this map

Lake elevations are unchecked

SCALE 1:63,360

CONTOUR INTERVAL 100 FEET
NATIONAL GEODETIC VERTICAL DATUM OF 1929
DEPTH CURVES IN FEET DATUM IS MEAN LOWER LOW WATER
SHORELINE SHOWN REPRESENTS THE APPROXIMATE LINE OF MEAN HIGH WATER THE AVERAGE RANGE OF TIDE IS APPROXIMATELY 17 FEET

FOR SALE BY U. S. GEOLOGICAL SURVEY
FAIRBANKS, ALASKA 99701, DENVER, COLORADO 80225, OR RESTON, VIRGINIA 22092
A FOLDER DESCRIBING TOPOGRAPHIC MAPS AND SYMBOLS IS AVAILABLE ON REQUEST

APPROXIMATE MEAN DECLINATION, 1949

ROAD CLASSIFICATION
No roads or trails in this area

QUADRANGLE LOCATION

PETERSBURG (A-4), ALASKA
N5600—W13300/15X20
1949
MINOR REVISIONS 1977

MAP NO. A-4 OF 6

LEGEND

		Subscript
S	Sockeye Salmon	s - Known Spawning
K	King Salmon	r - Rearing
CO	Coho Salmon	m - Migration
P	Pink Salmon	
CH	Chum Salmon	
SH	Steelhead Trout	
DV	Dolly Varden	
AC	Arctic Char	
SF	Sheefish	
W	Whitefish	
€	Cutthroat Trout	

*Migration upstream is assumed for stream reaches where anadromous fish occur.

COMP.	DRC
DRAWN	CB
REVISED	DRC
APPROVED	ERL
DATE	4-82
FILE NO.	

SCALE 1" = 1 MILE 1 : 63,360

PROJ. TITLE
ANADROMOUS STREAM CATALOG
ANADROMOUS WATERS ARE LISTED PURSUANT TO AS 16.05.870 (a)

MAP TITLE
PETERSBURG A-4

STATE OF ALASKA
DEPARTMENT OF FISH AND GAME
habitat protection division
JUNEAU, ALASKA

BY	DATE
BB	3/1/83
REVISIONS	

MAP WSFS 9/16/81

DK 10/81

KF 5/29/81