State of Alaska
Department of Fish and Game
Public Review Nomination for Waters
Important to Anadromous Species

84-329

✓ Addition ____ Deletion

Name of Waterbody (if known): None

I can't tell from sketch which stream this is. Please designate on attached photocopy. Also - how do you know DV are anadromous?

...talog Volume and Number S.E. Al.

...ngle Petersburg A-4 6

...:63,360 not available)

...s) Observed		Stage(s) (Spawning, Rearing, Migration)
~~DV~~	~~6-26-83~~	~~rearing, possible~~
Coho	"	Coho rearing

Comments: Please provide any clarifying information. Also, please include a map of the area identifying the stream reach. This can be a copy of the map from the Anadromous Waters Atlas.

a steep rearing stream located in Exchange Cove Stream #3A on attached photocopy. (1:63,360 scale map) Dolly Varden fry observed by stream survey crew; no barriers to migration of anadromous salmonids were observed. Survey crew concluded fry were offspring of anadromous adults.

Name of Observer (please print) Gerry Merrigan

Date: 12/16/83 Signature: Donald J. Kelly

Address: Area Habitat Bio. Petersburg

was already 106-30-10859 ...

cmy 7/30/84

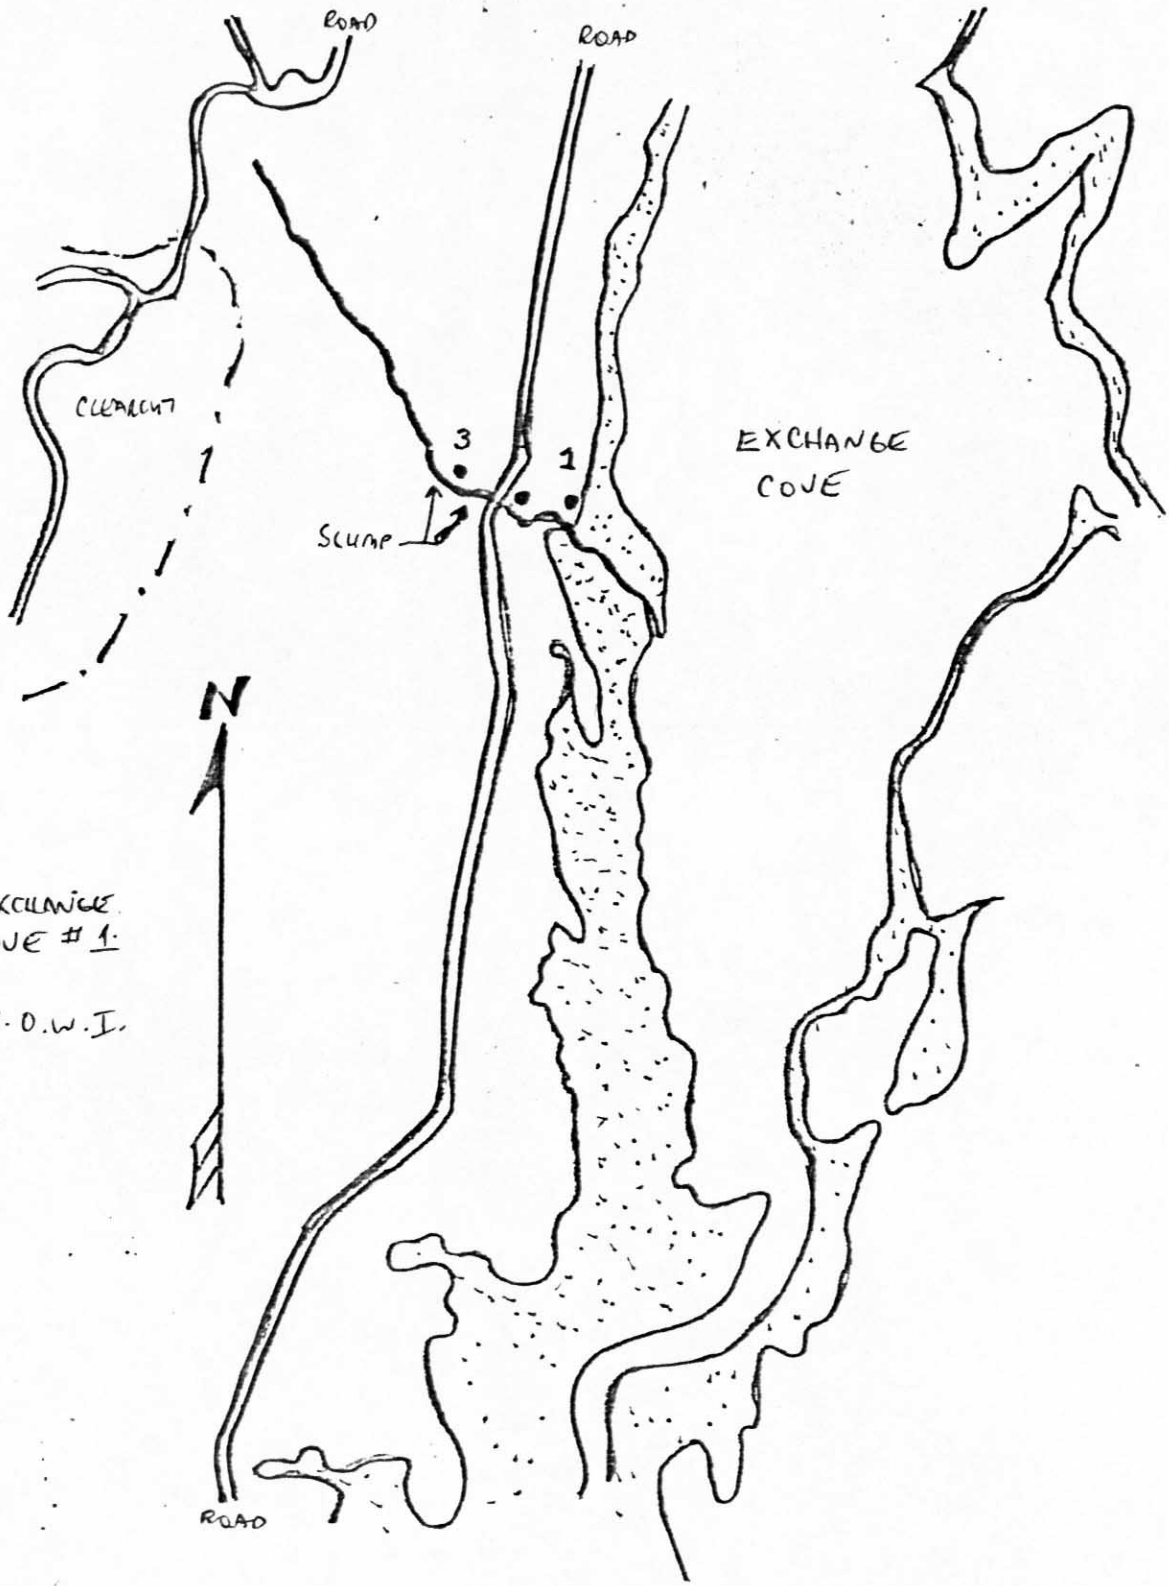

W. EXCHANGE
COVE #1.

N.P.O.W.I.

proposed # change
2003
CO SH
No Nomination form to change this spp.
∴ don't change.
CO S DV
CO S DV
CO
2003
3A
3B
CO
10850
10848
10835
can this # be changed to 10830?
0010
0010
0010
3003
2003
10800
0010
4003
10820
106-30
Exchange Island
Petersburg A-4
INCE OF WALES ISLAND

84-336

proposed # change

No nomination form to change this spp. ∴ don't change.

can this # be changed to 10830?

No nomination forms for ①, ② and ③. don't make change.

No nomination forms for these streams. don't make change.

Upper points limits of fish and usually not the extent of fish habitat

106-41-10300-2001
106-41-10300-0001
106-41-10300-2010
106-30
106-30-10660-2010-3006-0020
105-42
103-90

PRINCE OF WALES ISLAND

HORNE ISLAND

Exchange Island

Mabel Island

Tenakee Island

El Capitan Peak

Sink Hole Lake

Camp Harbor

Anchorage

50-70 foot tidal waterfalls

MP USFS 9/16/81

DK 10/81

KF 5/29/81

Mapped, edited, and published by the Geological Survey

Control by USC&GS

Topography by photogrammetric methods from aerial photographs taken 1948, field annotated 1949. Map not field checked

Selected hydrographic data compiled from USC&GS Charts 8160 (1952), 8171 (1949), 8172 (1951), and 8201 (1951), (1:217,828 scale). This information is not intended for navigational purposes

Universal Transverse Mercator projection. 1927 North American datum 10,000-foot grid based on Alaska coordinate system, zone 1 1000-meter Universal Transverse Mercator grid ticks, zone 8, shown in blue

Land lines represent unsurveyed and unmarked locations predetermined by the State of Alaska, Division of Lands Copper River Meridian

Swamps, as portrayed, indicate only the wetter areas usually of low relief, as interpreted from aerial photographs

Entire land area is within the Tongass National Forest

There may be private inholdings within the boundaries of the National or State reservations shown on this map

Lake elevations are unchecked

SCALE 1:63,360

CONTOUR INTERVAL 100 FEET
NATIONAL GEODETIC VERTICAL DATUM OF 1929
DEPTH CURVES IN FEET DATUM IS MEAN LOWER LOW WATER
SHORELINE SHOWN REPRESENTS THE APPROXIMATE LINE OF MEAN HIGH WATER
THE AVERAGE RANGE OF TIDE IS APPROXIMATELY 17 FEET

TRUE NORTH
MAGNETIC NORTH
APPROXIMATE MEAN DECLINATION, 1949

FOR SALE BY U. S. GEOLOGICAL SURVEY
FAIRBANKS, ALASKA 99701, DENVER, COLORADO 80225, OR RESTON, VIRGINIA 22092
A FOLDER DESCRIBING TOPOGRAPHIC MAPS AND SYMBOLS IS AVAILABLE ON REQUEST

QUADRANGLE LOCATION

ROAD CLASSIFICATION
No roads or trails in this area

PETERSBURG (A-4), ALASKA
N5600—W13300/15X20
1949
MINOR REVISIONS 1973

MAP NO. A-4 OF 6

LEGEND

S	Sockeye Salmon
K	King Salmon
Co	Coho Salmon
P	Pink Salmon
CH	Chum Salmon
SH	Steelhead Trout
DV	Dolly Varden
AC	Arctic Char
SF	Sheefish
W	Whitefish
C	Cutthroat Trout

Subscript
s - Known Spawning
r - Rearing
* m - Migration

*Migration upstream is assumed for stream reaches where anadromous fish occur.

COMP. DRC
DRAWN CB
REVISED DRC
APPROVED ERL
DATE 4-82
FILE NO.

N
SCALE 1" = 1 MILE 1 : 63,360

PROJ. TITLE
ANADROMOUS STREAM CATALOG
ANADROMOUS WATERS ARE LISTED PURSUANT TO AS 16.05.870 (a)

MAP TITLE
PETERSBURG A-4

STATE OF ALASKA
DEPARTMENT OF FISH AND GAME
habitat protection division
JUNEAU, ALASKA

BY	DATE
BB	3/1/83
REVISIONS	