State of Alaska
Department of Fish and Game
Public Review Nomination for Waters
Important to Anadromous Species

84-365

✓ Addition ____ Deletion

Name of Waterbody (if known): CALIFORNIA BAY #5 106-41

Location:

Anadromous Waters Catalog Volume and Number S.E. AK.

USGS 1:63,360 Quadrangle PETERSBURG B-4

or 1:250,000 (if 1:63,360 not available) ____

Species	Date(s) Observed	Stage(s) (Spawning, Rearing, Migration)
Coho fry	5/19/83	rearing

Comments: Please provide any clarifying information. Also, please include a map of the area identifying the stream reach. This can be a copy of the map from the Anadromous Waters Atlas.

This is a small rearing system with no spawning available.

see 5 on blue line

Drafted Jew 1/84

Name of Observer (please print) GERRY MERRIGAN

Date: 12/16/83 Signature: Donald G. Kelly

Address: Area Habitat Bin

R. Reed
Cmy
1/16/84

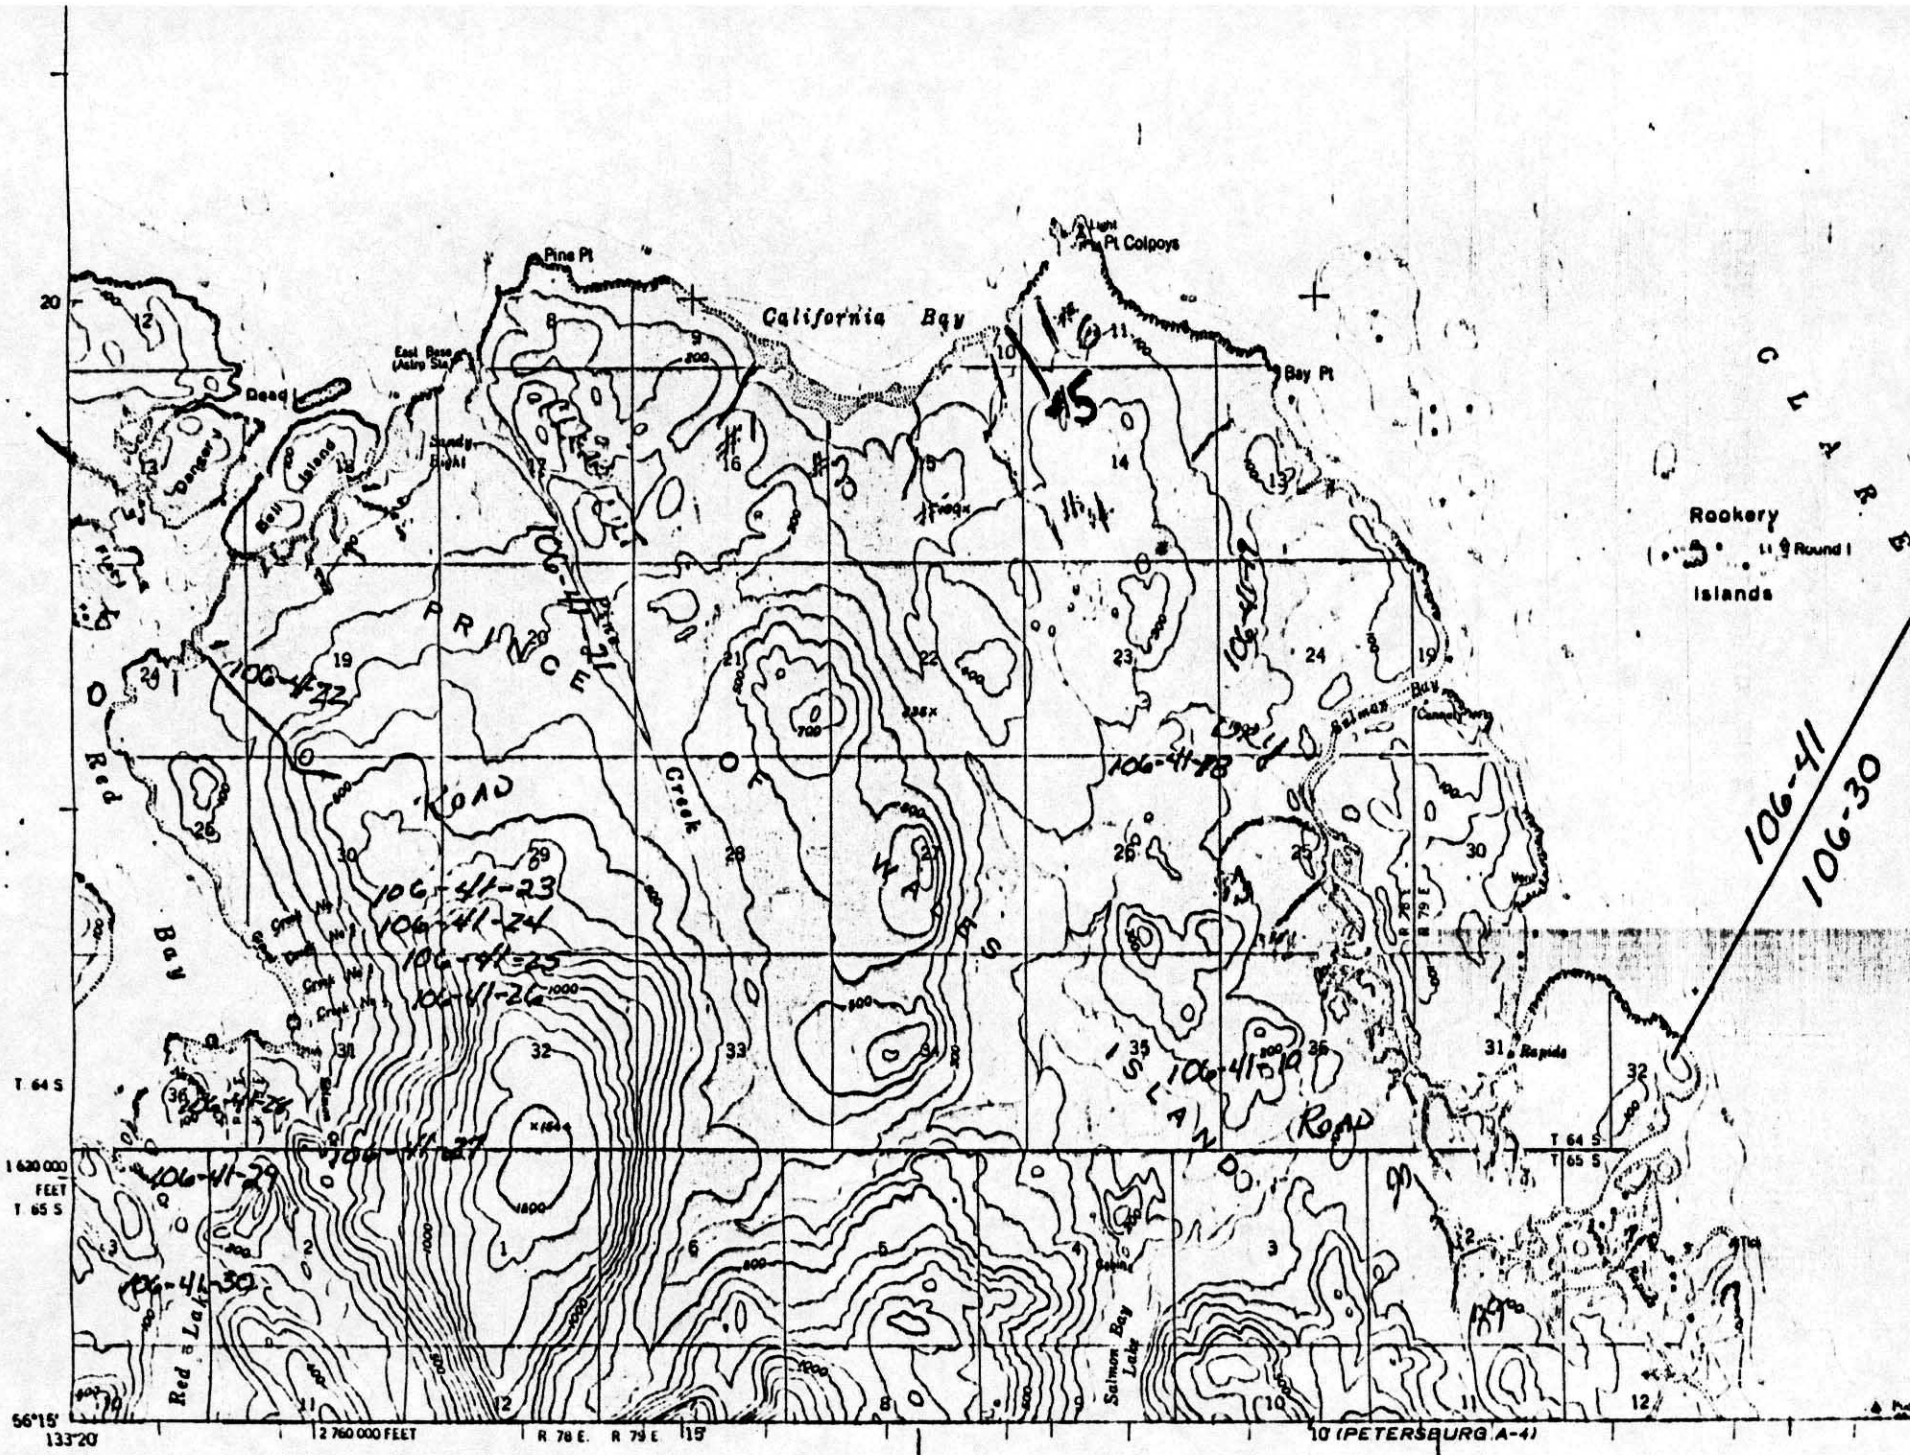

Mapped, edited, and published by the Geological Survey

Control by USC&GS

Topography by photogrammetric methods from aerial photographs taken 1948, field annotated 1949. Map not field checked

Selected hydrographic data compiled from USC & GS Charts

SCALE 1:63 360

NORTH

4 MILES

21000 FEET

5 KILOMETERS

84-377

Upper points document limits of fish surveys and usually not the extent of fish habitat.

Mapped, edited, and published by the Geological Survey

Control by USC&GS

Topography by photogrammetric methods from aerial photographs taken 1948. Field annotated 1949. Map not field checked

Selected hydrographic data compiled from USC&GS Charts 8160 (1952), 8168 (1952), and 8201 (1951), (1:217,828 scale)

This information is not intended for navigational purposes

Universal Transverse Mercator projection, 1927 North American datum

10,000-foot grid based on Alaska coordinate system, zone 1

1000-meter Universal Transverse Mercator grid ticks, zone 8, shown in blue

Land lines represent unsurveyed and unmarked locations determined by the State of Alaska, Division of Lands

Copper River Meridian

Entire land area is within the Tongass National Forest

APPROXIMATE MEAN DECLINATION, 1949

CONTOUR INTERVAL 100 FEET

DOTTED LINES REPRESENT SUBNORMAL CONTOURS

DATUM IS MEAN SEA LEVEL

DEPTH CURVES IN FEET. DATUM IS MEAN LOWER LOW WATER

SHORELINE SHOWN REPRESENTS THE APPROXIMATE LINE OF MEAN HIGH WATER

THE AVERAGE RANGE OF TIDE IS APPROXIMATELY [illegible] FEET

FOR SALE BY U.S. GEOLOGICAL SURVEY

FAIRBANKS, ALASKA · DENVER 25, COLORADO · WASHINGTON 25, D. C.

A FOLDER DESCRIBING TOPOGRAPHIC MAPS AND SYMBOLS IS AVAILABLE ON REQUEST

ROAD CLASSIFICATION

No roads or trails in this area

QUADRANGLE LOCATION

PETERSBURG (B-4), ALASKA

N5615—W13300/15X20

1949

SCALE 1:63,360

SPECIAL PRINTING

Contours and additional symbols omitted

MAP NO. B-4 OF 6

LEGEND

S	Sockeye Salmon
K	King Salmon
CO	Coho Salmon
P	Pink Salmon
CH	Chum Salmon
SH	Steelhead Trout
DV	Dolly Varden
AC	Arctic Char
SF	Sheefish
W	Whitefish
C	Cutthroat Trout

Subscript

s - Known Spawning

r - Rearing

* in Migration

* Migration upstream is assumed for stream reaches where anadromous fish occur

COMP. DRC

DRAWN CB

REVISED DRC

APPROVED ERL

DATE 4-82

FILE NO.

SCALE 1" = 1 MILE 1 : 63,360

PROJ. TITLE

ANADROMOUS STREAM CATALOG

ANADROMOUS WATERS ARE LISTED PURSUANT TO AS 16.05.870 (a)

MAP TITLE

PETERSBURG B-4

STATE OF ALASKA

DEPARTMENT OF FISH AND GAME

habitat protection division

JUNEAU, ALASKA

BY	DATE
BB	3/1/83

REVISIONS

PAS

JE

DAF 10/81

GC

PT

MP 11/5/5

9/10/88