84-373

State of Alaska
Department of Fish and Game
Public Review Nomination for Waters
Important to Anadromous Species

____ Addition ✓ Deletion

Name of Waterbody (if known): Geek Creek (Red Lake system)

Location: T. 64S, R. 78E, Sec. 2

Anadromous Waters Catalog Volume and Number 106-41-10300-2001

USGS 1:63,360 Quadrangle Petersburg B-4

or 1:250,000 (if 1:63,360 not available) _____

Species	Date(s) Observed	Stage(s) (Spawning, Rearing, Migration)

Comments: Please provide any clarifying information. Also, please include a map of the area identifying the stream reach. This can be a copy of the map from the Anadromous Waters Atlas.

End of anadromous habitat. Personal observations. Habitat assessment / stream traverse, J. Gruber, R. Stewart 11/82

refer to map

Ron Lomelin, Habitat Biologist, Ketchikan

Name of Observer (please print) Bob Metzger

Date: 12/19/83 Signature: Robert Metzger

Address: USFS, Thorne Bay District
Ketchikan

Drafted Rew 2/84

CMY 2/6/84

UNITED STATES
DEPARTMENT OF THE INTERIOR
GEOLOGICAL SURVEY

FINAL

PETERSBURG (B-4) QUADRANGLE
ALASKA
1:63,360 SERIES (TOPOGRAPHIC)

84-~~406~~ 378

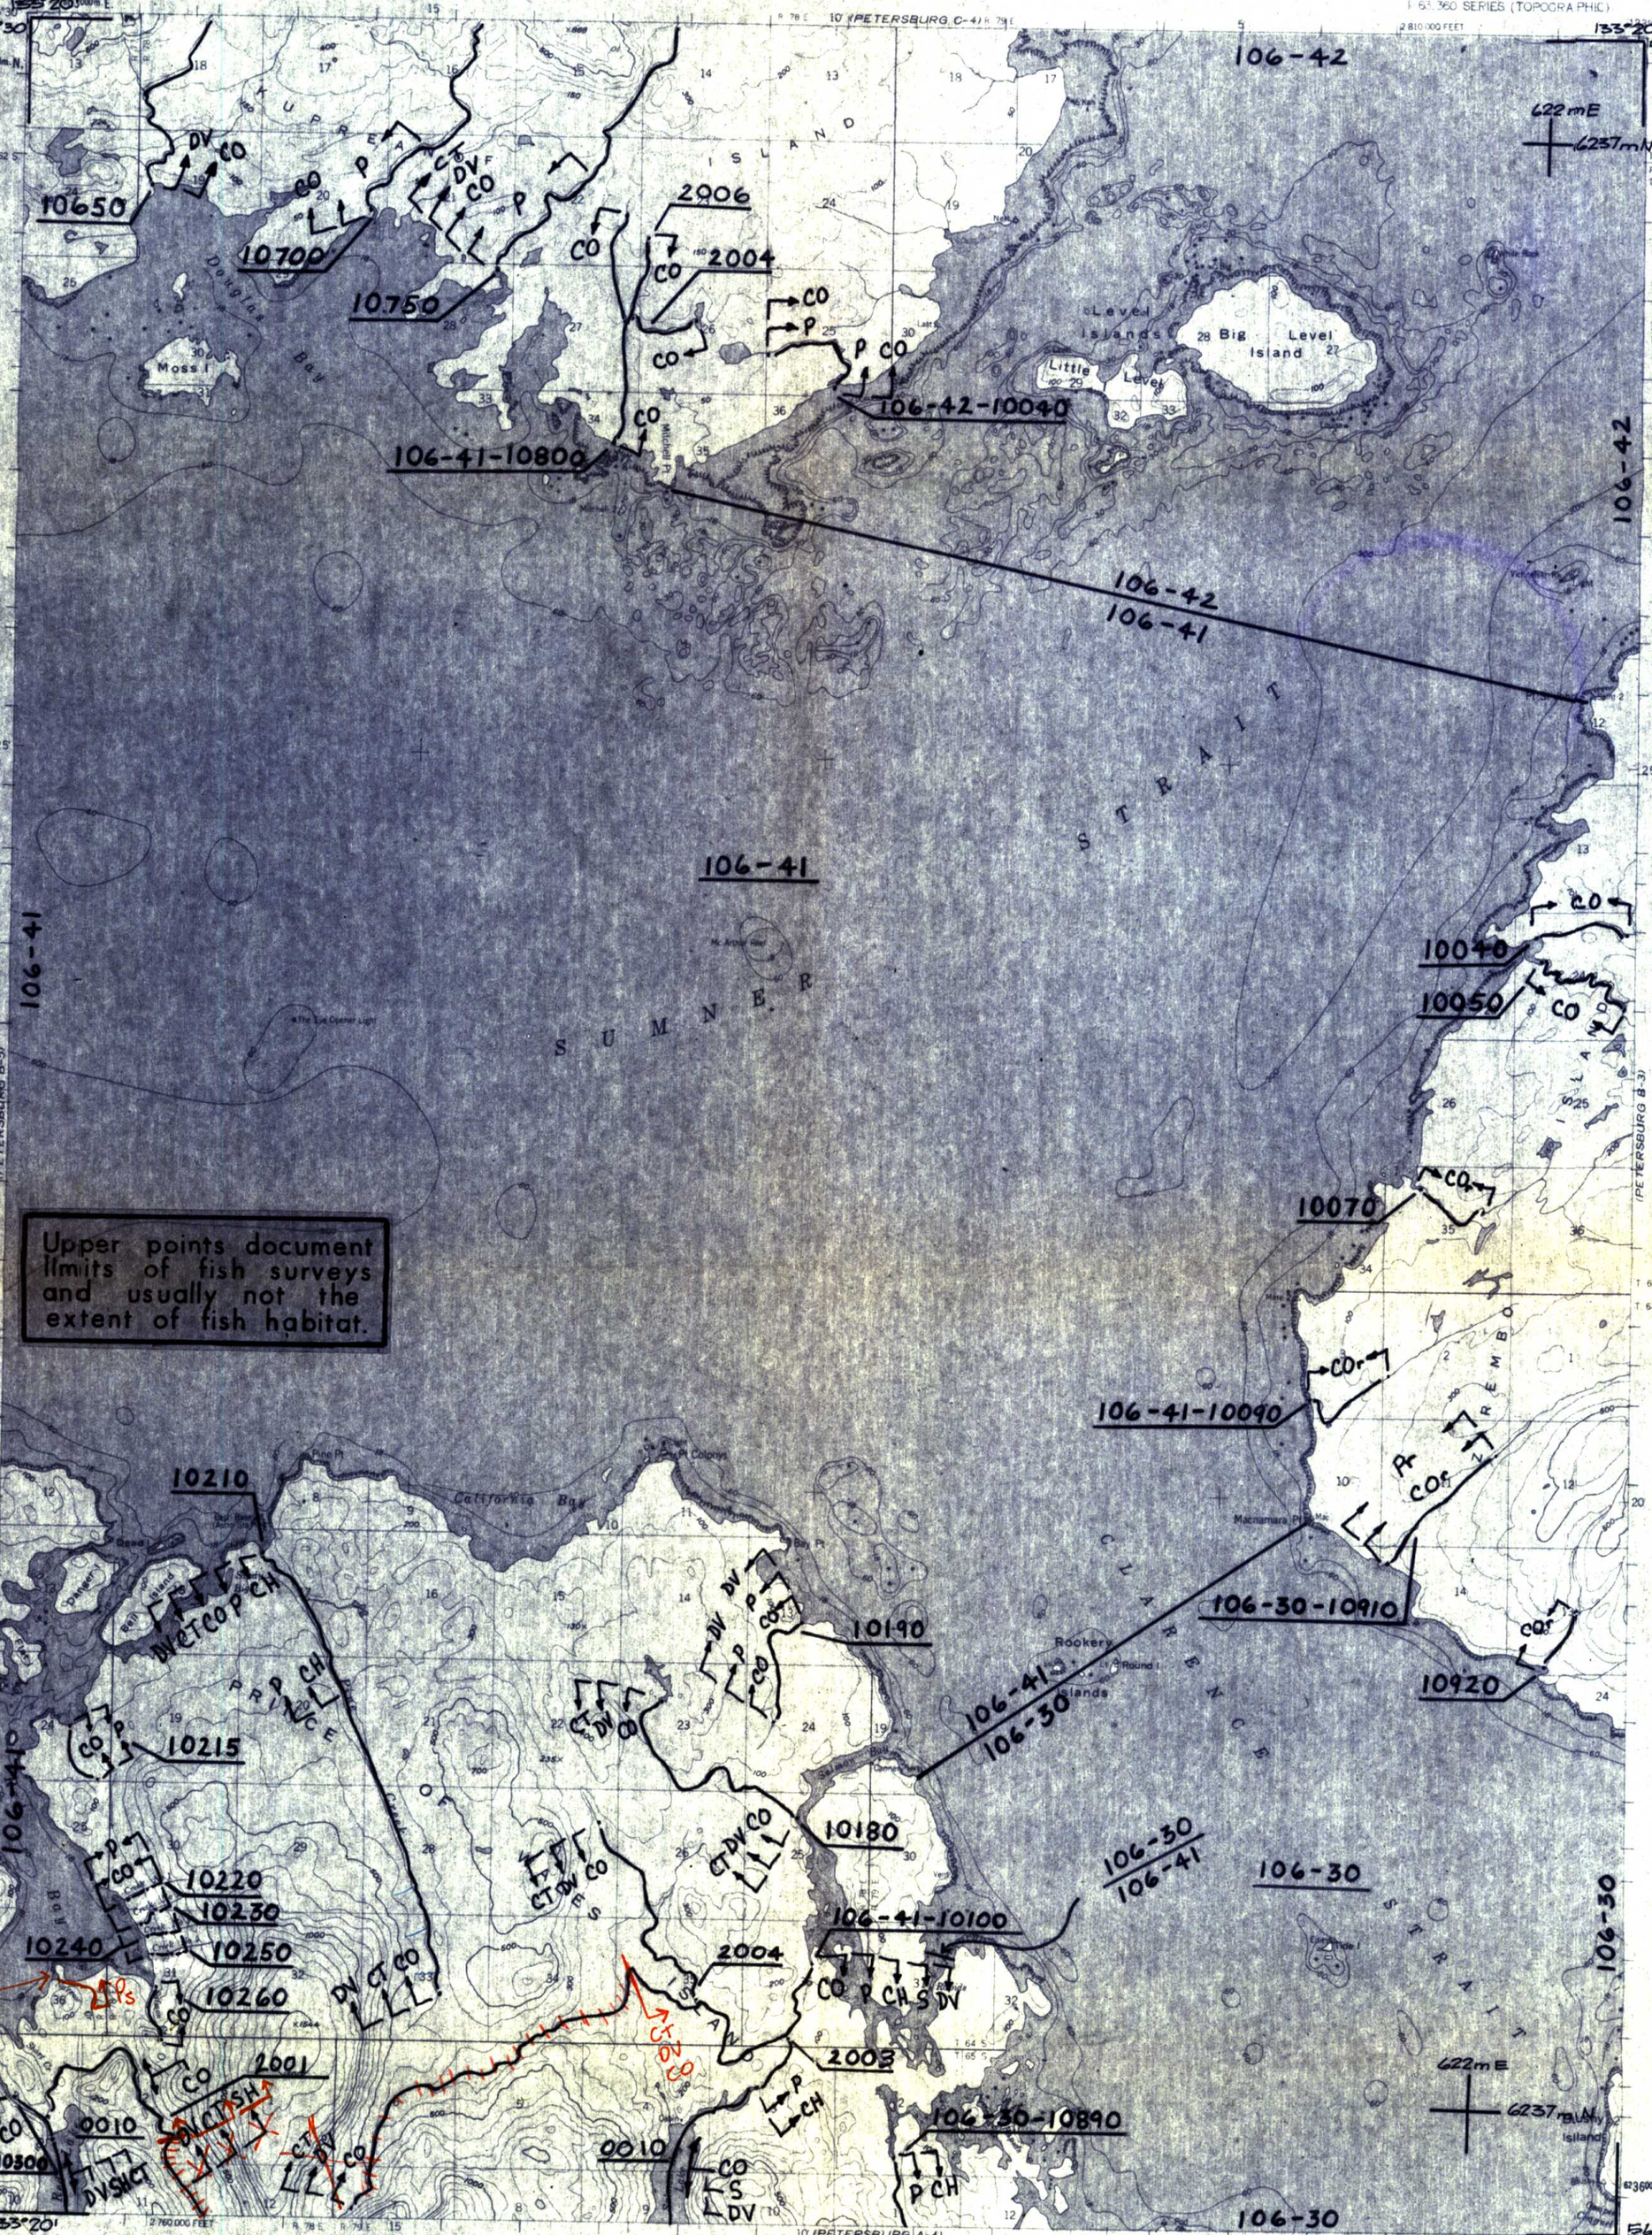

Mapped, edited, and published by the Geological Survey

Control by USC&GS

Topography by photogrammetric methods from aerial photographs taken 1948, field annotated 1949. Map not field checked

Selected hydrographic data compiled from USC&GS Charts 8160 (1952), 8168 (1952), and 8201 (1951), (1:217,828 scale). This information is not intended for navigational purposes

Universal Transverse Mercator projection, 1927 North American datum
10,000 foot grid based on Alaska coordinate system, zone 1
1000-meter Universal Transverse Mercator grid ticks, zone 8, shown in blue

Land lines represent unsurveyed and unmarked locations predetermined by the State of Alaska, Division of Lands
Copper River Meridian

Entire land area is within the Tongass National Forest

TRUE NORTH
MAGNETIC NORTH
APPROXIMATE MEAN DECLINATION, 1949

CONTOUR INTERVAL 100 FEET
DOTTED LINES REPRESENT 50 FOOT CONTOURS
DATUM IS MEAN SEA LEVEL
DEPTH CURVES IN FEET, DATUM IS MEAN LOWER LOW WATER
SHORELINE SHOWN REPRESENTS THE APPROXIMATE LINE OF MEAN HIGH WATER
THE AVERAGE RANGE OF TIDE IS APPROXIMATELY 12 FEET

FOR SALE BY U. S. GEOLOGICAL SURVEY
FAIRBANKS, ALASKA DENVER 25, COLORADO WASHINGTON 25, D. C.
A FOLDER DESCRIBING TOPOGRAPHIC MAPS AND SYMBOLS IS AVAILABLE ON REQUEST

ROAD CLASSIFICATION
No roads or trails in this area

QUADRANGLE LOCATION

PETERSBURG (B-4), ALASKA
N5615—W13300/15X20
1949
MINOR REVISIONS 1964

SCALE 1:63,360

MAP NO. B-4 OF 10

LEGEND

S	Sockeye Salmon
K	King Salmon
CO	Coho Salmon
P	Pink Salmon
CH	Chum Salmon
SH	Steelhead Trout
DV	Dolly Varden
AC	Arctic Char
SF	Sheefish
W	Whitefish
C	Cutthroat Trout

Subscript
s - Known Spawning
r - Rearing
* m - Migration

*Migration upstream is assumed for stream reaches where anadromous fish occur.

COMP.	DRC
DRAWN	CB
REVISED	DRC
APPROVED	ERL
DATE	4-82
FILE NO.	

SCALE
1" = 1 MILE
1 : 63,360

PROJ. TITLE
ANADROMOUS STREAM CATALOG
ANADROMOUS WATERS ARE LISTED PURSUANT TO AS 16.05.870 (a)

MAP TITLE
PETERSBURG B-4

STATE OF ALASKA
DEPARTMENT OF FISH AND GAME
habitat protection division
JUNEAU, ALASKA

BY	DATE
BB	3/1/83
REVIS	

PAS
JE 10/81
DEF
GC

MP USFS 9/16/82