State of Alaska
Department of Fish and Game
Public Review Nomination for Waters
Important to Anadromous Species

~~83-969~~
84-516

[X] Addition [ ] Deletion

Name of Waterbody (if known): 8 Unnamed Stream - Salt Chuck Hobart Bay

Location:

Anadromous Waters Catalog Volume and Number Southeast Alaska

USGS 1:63,360 Quadrangle Juneau B-4, B-5

or 1:250,000 (if 1:63,360 not available) _____

Species	Date(s) Observed	Stage(s) (Spawning, Rearing, Migration)
P	11/10/83	Spawning, Migration
	9/83	

Comments: Please provide any clarifying information in addition to identification on Anadromous Waters Catalog Public Review Maps.

Drafted 1/84

Add stream to catalog - pink salmon enter + spawn in this system

See ② on blueline maps

Name of Observer (please print) Donald Kelly

Date: 11/30/83 Signature: Donald G. Kelly

Address: P.O. Box 647
Petersburg, Ak. 99833

cmy 1/16/84

R. Reed

Compiled, edited, and published by the Geological Survey

Control by USGS and USC&GS

Topography by photogrammetric methods from aerial photographs taken 1948. Map not field checked

Selected hydrographic data compiled from USC&GS survey H-1996 (1889) and chart 8201 (1:217,828 scale, 1954). This information is not intended for navigational purposes

Universal Transverse Mercator projection, 1927 North American datum. 10,000-foot grid based on Alaska coordinate system, zone 1. 1000-meter Universal Transverse Mercator grid ticks, zone 8, shown in blue

Land lines represent unsurveyed and unmarked locations predetermined by the State of Alaska, Division of Lands, Folio CR-14, Copper River Meridian

Entire land area is within the Tongass National Forest

There may be private inholdings within the boundaries of the National or State reservations shown on this map

Lake elevations are unchecked

TRUE NORTH
MAGNETIC NORTH
30°
APPROXIMATE MEAN DECLINATION, 1948

SCALE 1:63360

CONTOUR INTERVAL 100 FEET
NATIONAL GEODETIC VERTICAL DATUM OF 1929
DEPTH CURVES IN FEET-DATUM IS MEAN LOWER LOW WATER
SHORELINE SHOWN REPRESENTS THE APPROXIMATE LINE OF MEAN HIGH WATER
THE AVERAGE RANGE OF TIDE IS APPROXIMATELY 13 FEET

FOR SALE BY U. S. GEOLOGICAL SURVEY
FAIRBANKS, ALASKA 99701, DENVER, COLORADO 80225, OR RESTON, VIRGINIA 22092
A FOLDER DESCRIBING TOPOGRAPHIC MAPS AND SYMBOLS IS AVAILABLE ON REQUEST

ROAD CLASSIFICATION
No roads or trails in this area

ALASKA
QUADRANGLE LOCATION

SUMDUM (B-4), ALASKA
N5715—W13900/15X20
1948
MINOR REVISIONS 1974

MAP NO. B-4 OF 9.

LEGEND

S	Sockeye Salmon
K	King Salmon
CO	Coho Salmon
P	Pink Salmon
CH	Chum Salmon
SH	Steelhead Trout
DV	Dolly Varden
AC	Arctic Char
SF	Sheefish
W	Whitefish
C	Cutthroat Trout

Subscript
s - Known Spawning
r - Rearing
* m - Migration

*Migration upstream is assumed for stream reaches where anadromous fish occur.

COMP. DRC
DRAWN CB
REVISED DRC
APPROVED ERL
DATE 4/82
FILE NO.

SCALE 1" = 1 MILE 1 : 63,360

PROJ. TITLE
ANADROMOUS STREAM CATALOG
ANADROMOUS WATERS ARE LISTED PURSUANT TO AS 16.05.870 (a)

MAP TITLE
SUMDUM, B-4

STATE OF ALASKA
DEPARTMENT OF FISH AND GAME
habitat protection division
JUNEAU, ALASKA

BY	DATE
BB	3/83
REVISIONS	

UNITED STATES
DEPARTMENT OF THE INTERIOR
GEOLOGICAL SURVEY

FINAL

SUMDUM (B-5) QUADRANGLE
ALASKA
1:63 360 SERIES (TOPOGRAPHIC)

84-520

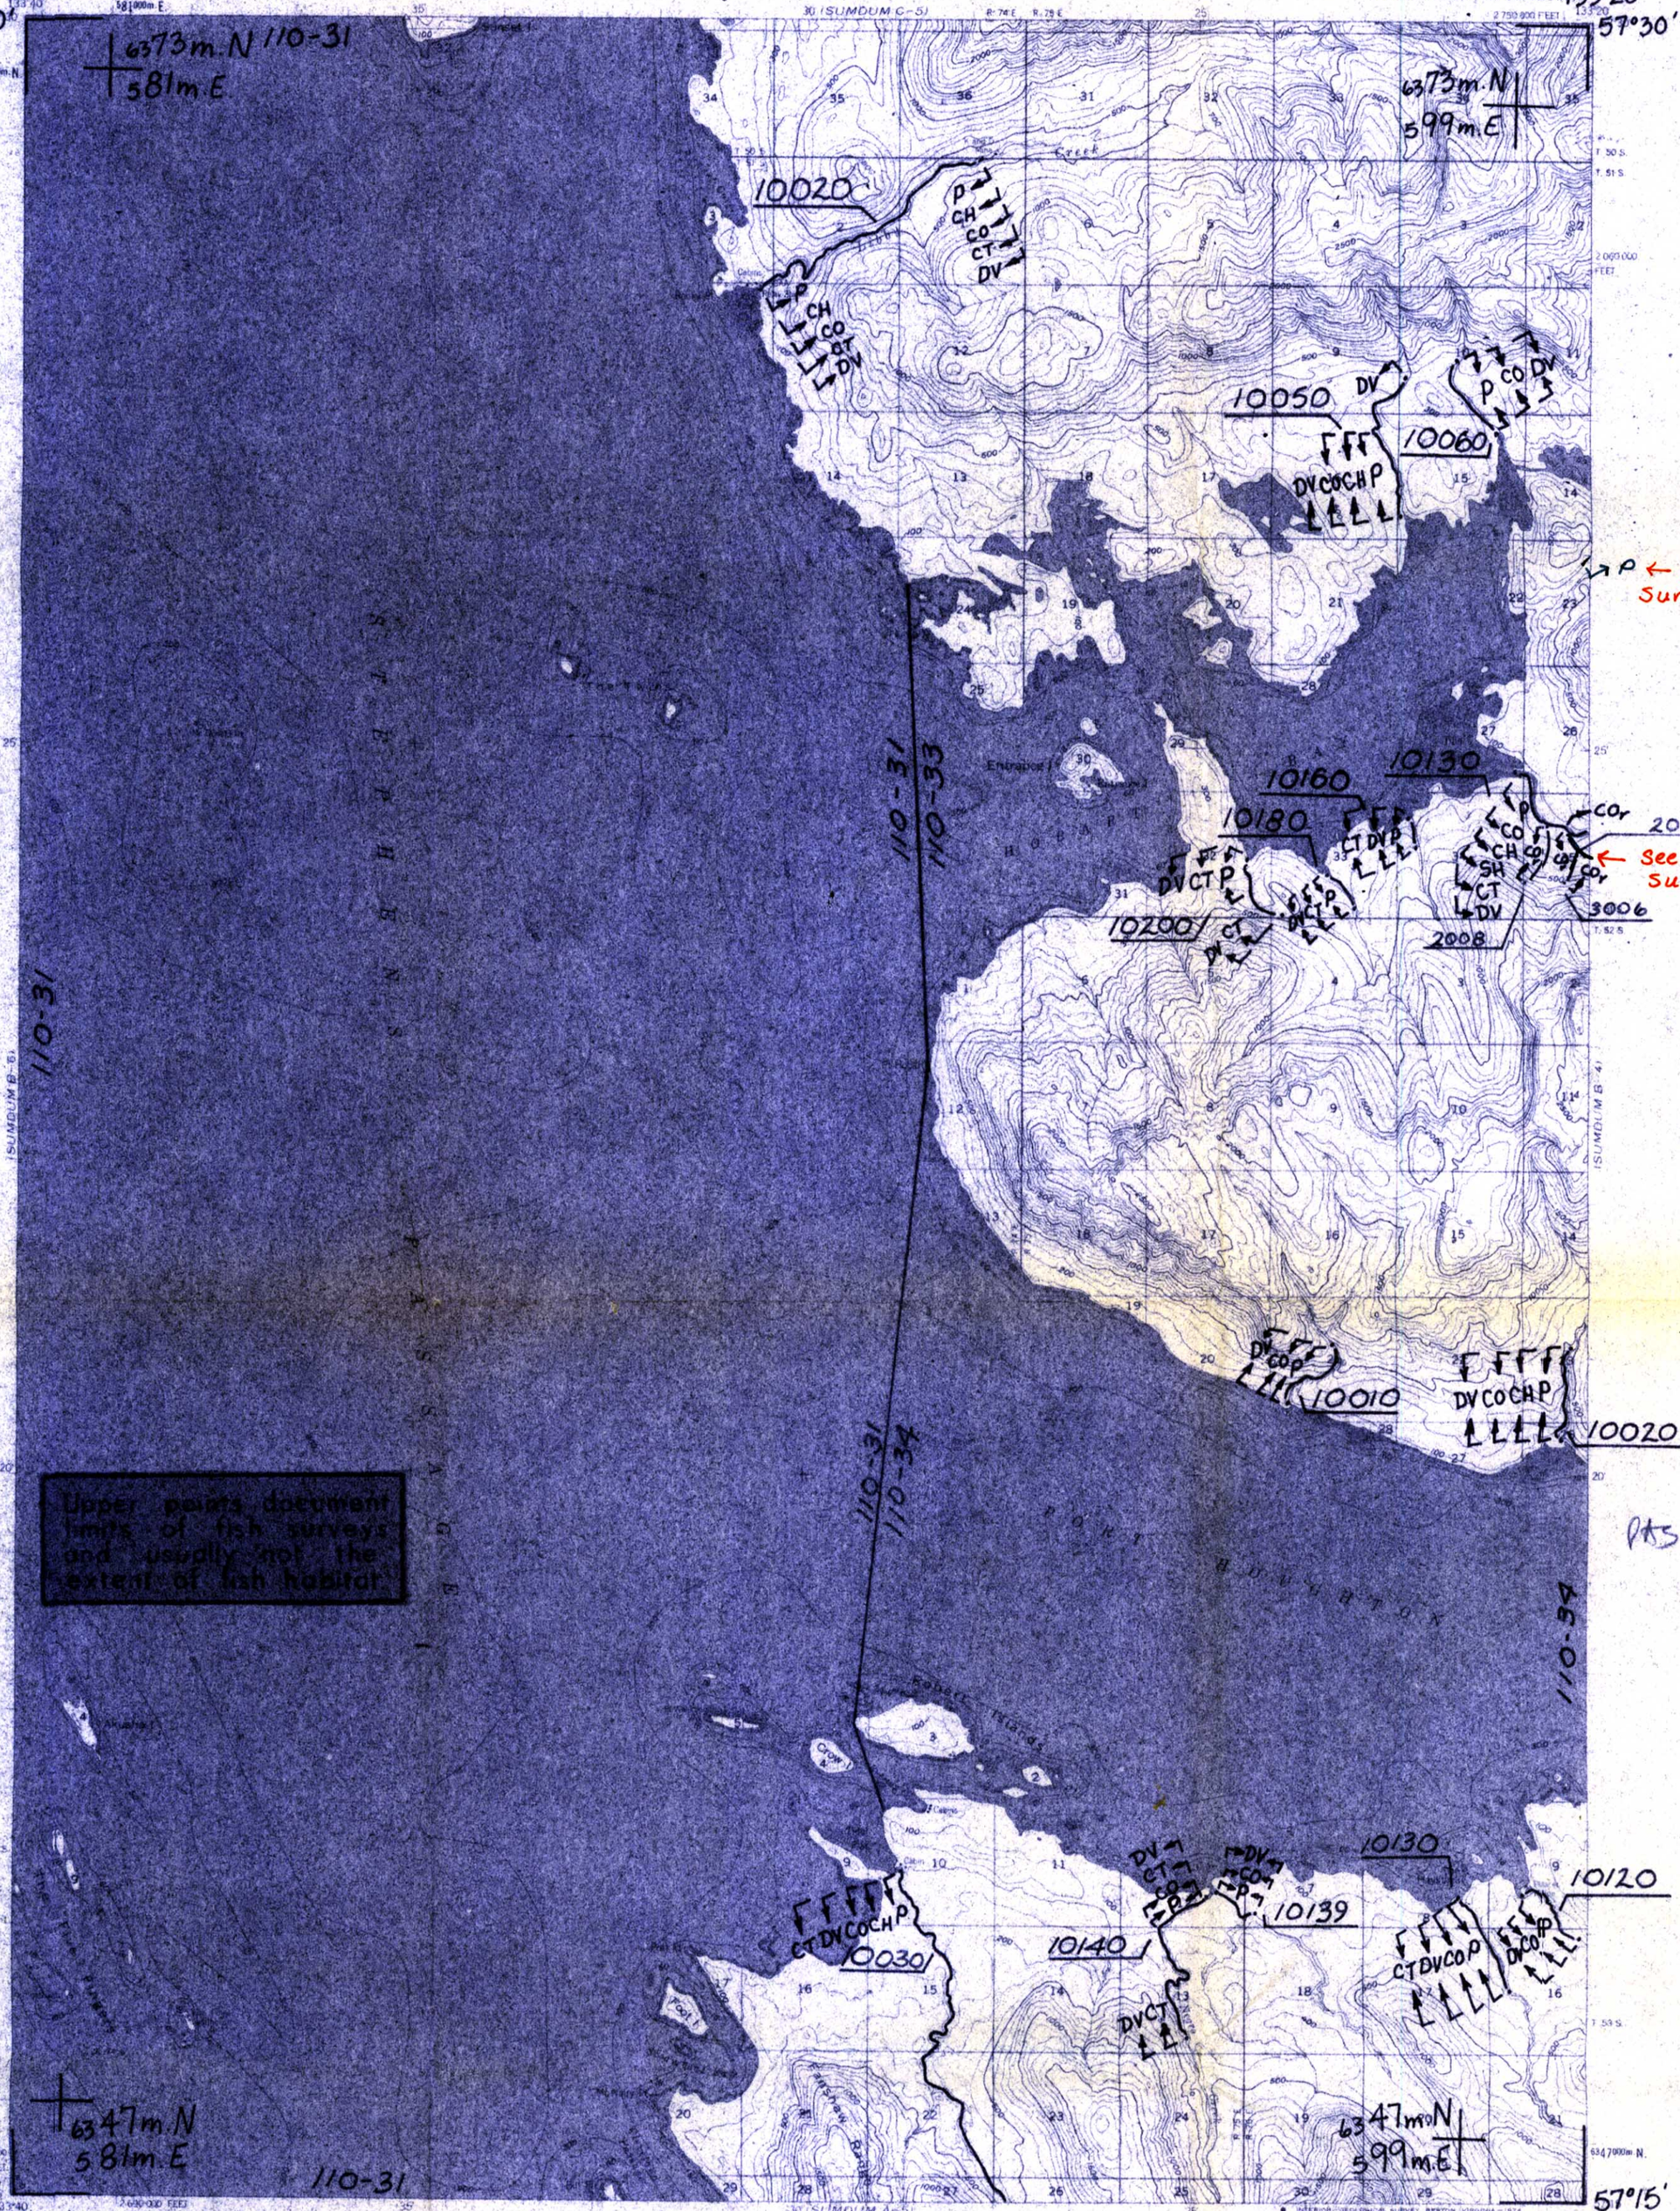

← See ② on Sumoum B-4

← See ③ on Sumoum B-4

PAS 10/81

DDK 10/13/

Edited, and published by the Geological Survey
Control by USGS and USC&GS
Topography by photogrammetric methods from aerial photographs taken 1948, field annotated 1951. Map not field checked
Selected hydrographic data compiled from USC&GS Charts 8201 (1:217,828 scale), 8216, and 8218. This information is not intended for navigational purposes
Universal Transverse Mercator projection, 1927 North American datum
10,000-foot grid based on Alaska coordinate system, zone 1
1000-meter Universal Transverse Mercator grid ticks, zone 8, shown in blue
Land lines represent unsurveyed and unmarked locations predetermined by the State of Alaska, Division of Lands. Copper River Meridian
Entire quadrangle is within the Tongass National Forest

SCALE 1:63 360

CONTOUR INTERVAL 100 FEET
DATUM IS MEAN SEA LEVEL
DEPTH CURVES IN FEET. DATUM IS MEAN LOWER LOW WATER
SHORELINE SHOWN REPRESENTS THE APPROXIMATE LINE OF MEAN HIGH WATER
THE AVERAGE RANGE OF TIDE IS APPROXIMATELY 13 FEET

APPROXIMATE MEAN DECLINATION, 1951

FOR SALE BY U. S. GEOLOGICAL SURVEY
FAIRBANKS, ALASKA 99701, DENVER, COLORADO 80225, OR RESTON, VIRGINIA 22092
A FOLDER DESCRIBING TOPOGRAPHIC MAPS AND SYMBOLS IS AVAILABLE ON REQUEST

ROAD CLASSIFICATION
Trails

QUADRANGLE LOCATION

SUMDUM (B-5), ALASKA
N5715—W13320/15X20
1951

MAP NO. B-5 OF 9

LEGEND

S	Sockeye Salmon
K	King Salmon
CO	Coho Salmon
P	Pink Salmon
CH	Chum Salmon
SH	Steelhead Trout
DV	Dolly Varden
AC	Arctic Char
SF	Sheefish
W	Whitefish
C	Cutthroat Trout

Subscript
s - Known Spawning
r - Rearing
* m - Migration

* Migration upstream is assumed for stream reaches where anadromous fish occur

COMP.	DRC
DRAWN	CB
REVISED	DRC
APPROVED	ERL
DATE	4/82
FILE NO.	

N

SCALE
1" = 1 MILE
1 : 63,360

PROJ. TITLE
ANADROMOUS STREAM CATALOG
ANADROMOUS WATERS ARE LISTED PURSUANT TO AS 16.05.870 (a)

MAP TITLE
SUMDUM, B-5

STATE OF ALASKA
DEPARTMENT OF FISH AND GAME
habitat protection division
JUNEAU, ALASKA

BY	DATE
BB	3/83
REVISIONS	