State of Alaska
Department of Fish and Game
Public Review Nomination for Waters
Important to Anadromous Species

84-601

X Addition ____ Deletion

Name of Waterbody (if known): Rock creek, 102-60-10370

Location:

Anadromous Waters Catalog Volume and Number ____

USGS 1:63,360 Quadrangle Craig B-2 3

or 1:250,000 (if 1:63,360 not available) ____

| Species | Date(s) Observed | Stage(s) (Spawning, Rearing, Migration) |
|---|---|---|
| | | |
| | | |
| | | |
| | | |

Comments: Please provide any clarifying information. Also, please include a map of the area identifying the stream reach. This can be a copy of the map from the Anadromous Waters Atlas.

25' falls 1.3 miles upstream, on main stem. From USFS level 4 habitat survey by Boyce, Mickowski + Marr. Further information available from Craig Ranger Dist.

for information, note falls on map

Don Lomalin Habitat Biologist

Name of Observer (please print) Gene Stagner

Date: 11/23/83 Signature: Gene Stagner

looks right to me cl 2/84

Address: CRAIG RANGER DISTRICT
~~POUCH 500~~
CRAIG, ALASKA 99921

R Reed
cmy
2/1/84

UNITED STATES
DEPARTMENT OF THE INTERIOR
GEOLOGICAL SURVEY

CRAIG (B-2) QUADRANGLE
ALASKA
1:63,360 SERIES (TOPOGRAPHIC)

83-1074

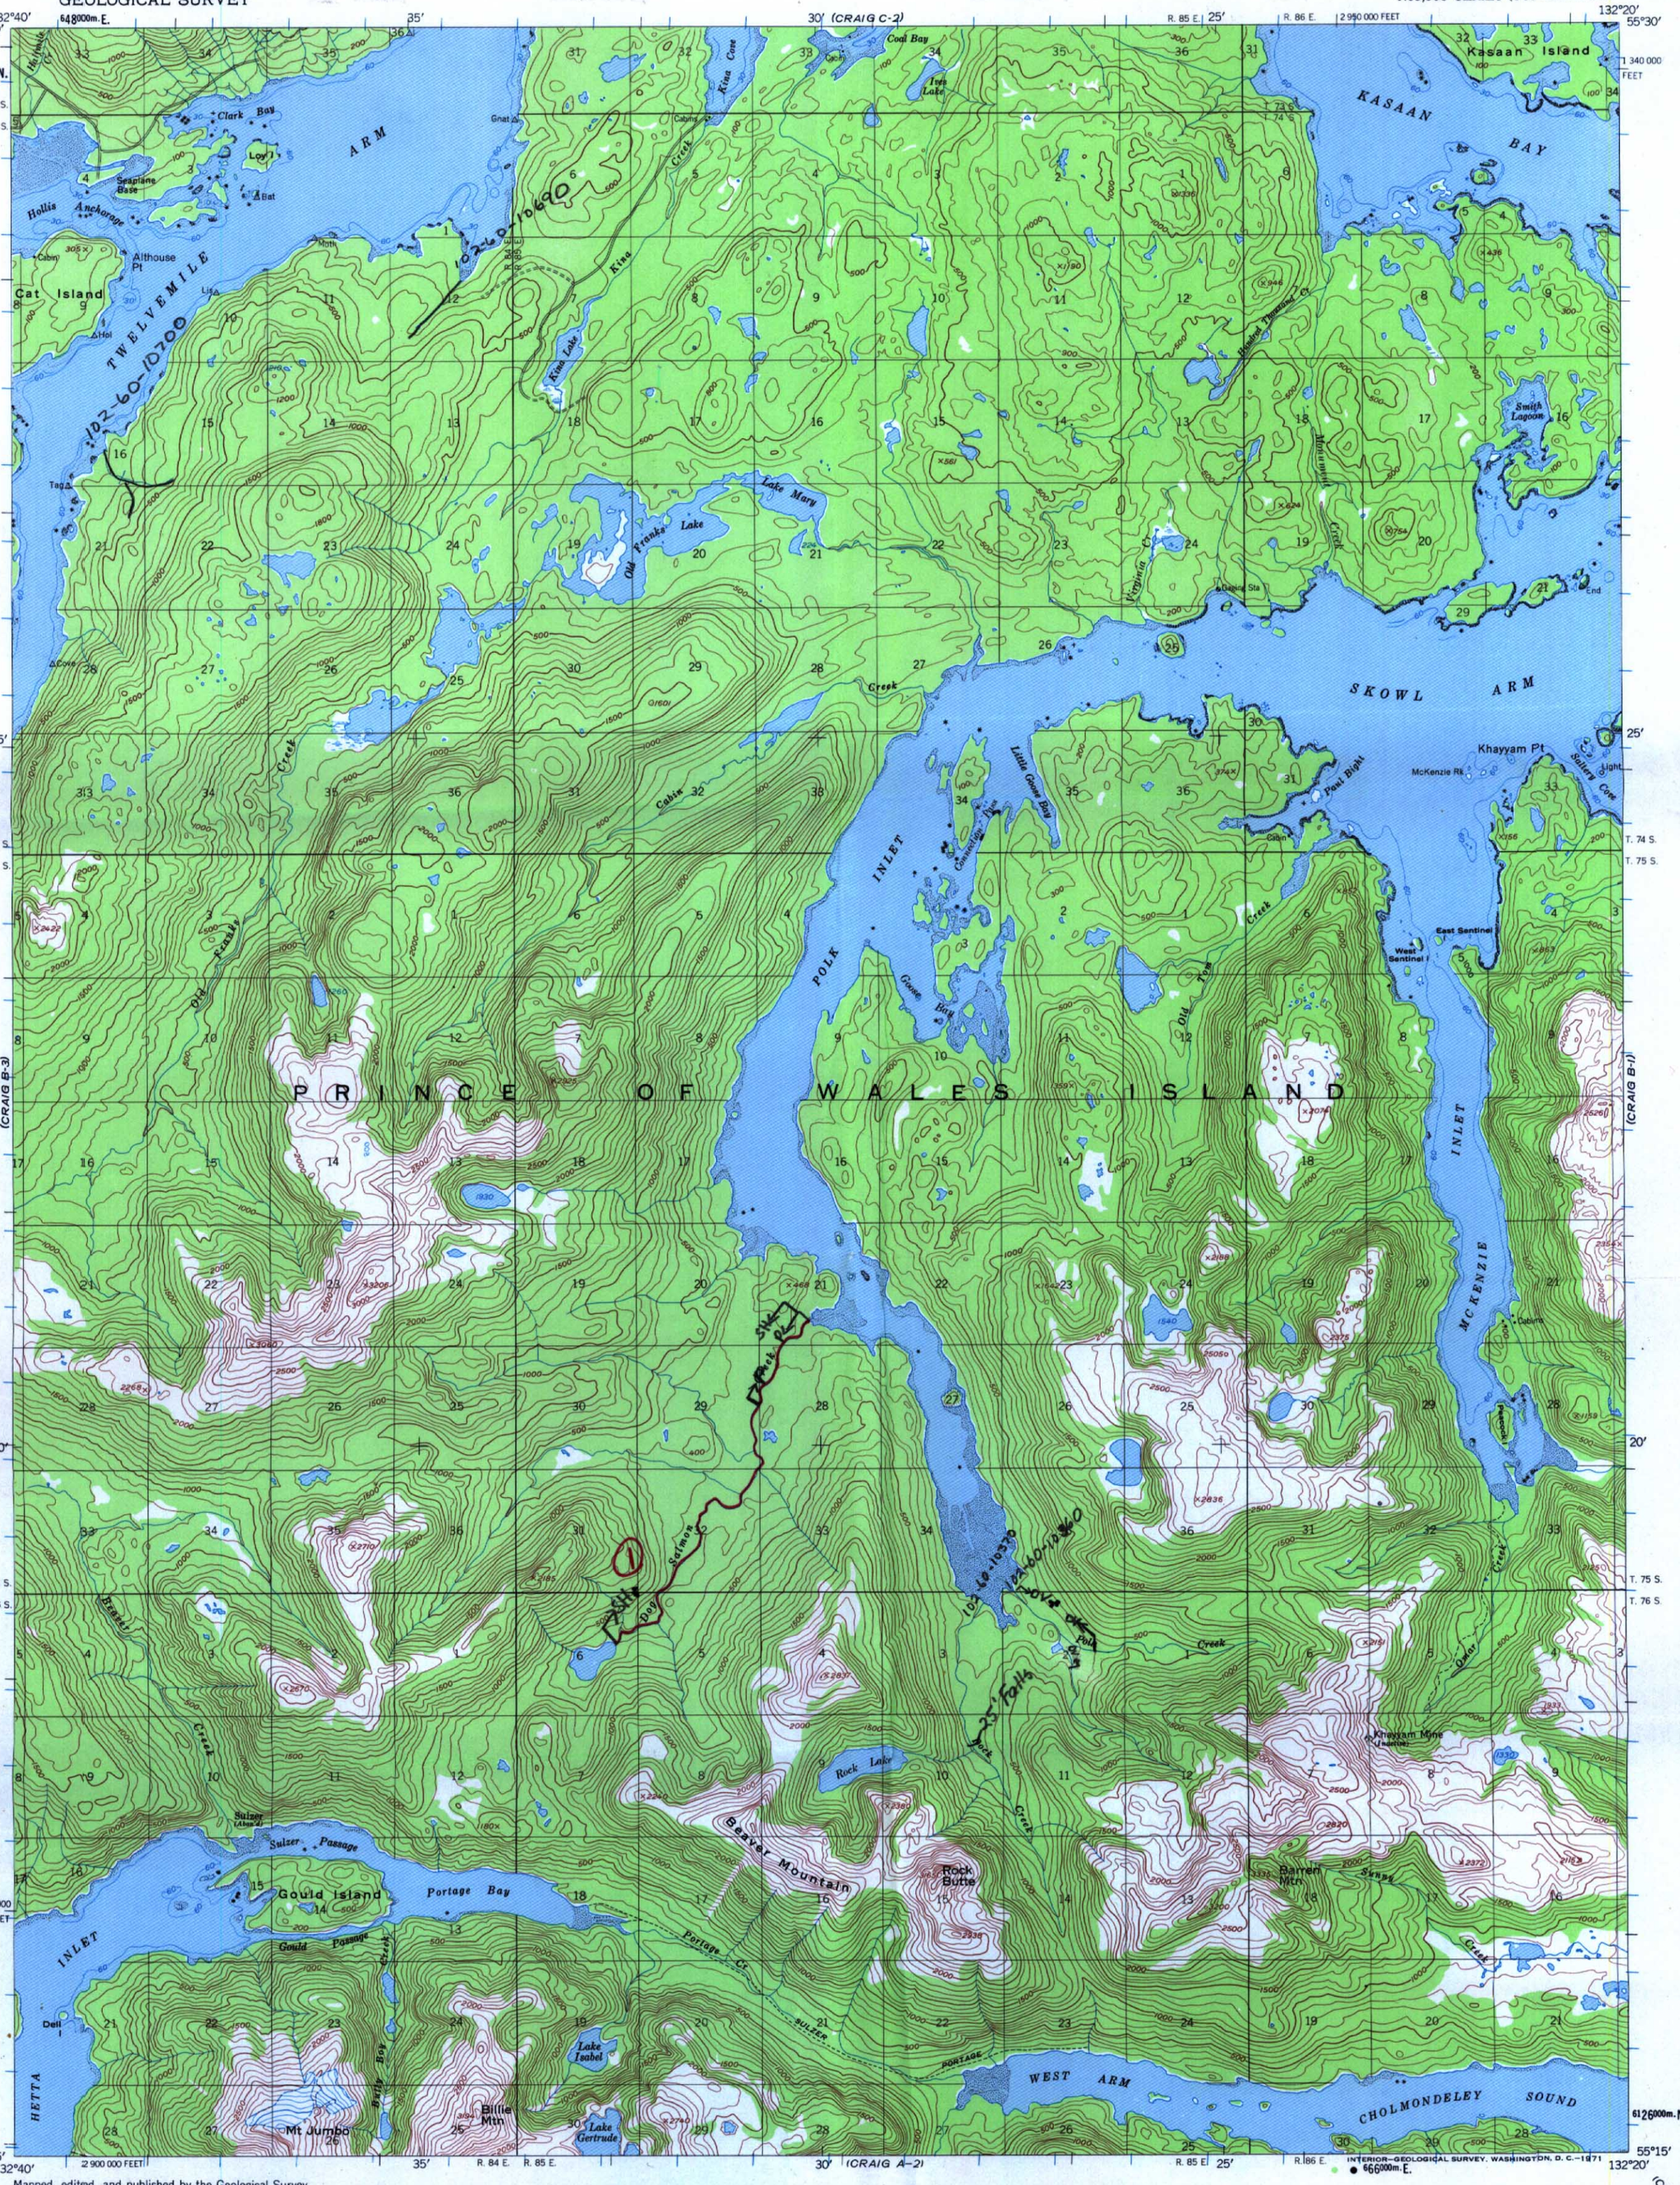


Mapped, edited, and published by the Geological Survey

Control by USGS and USC&GS

Topography by photogrammetric methods from aerial photographs taken 1948, field annotated 1949. Map not field checked

Selected hydrographic data compiled from USC&GS Charts 8142 (1962), and 8147 (1957). This information is not intended for navigationall purposes

Universal Transverse Mercator projection, 1927 North American datum
10,000-foot grid based on Alaska coordinate system, zone 1
1000-meter Universal Transverse Mercator grid ticks, zone 8, shown in blue

Land lines represent unsurveyed and unmarked locations predetermined by the State of Alaska, Division of Lands
Copper River Meridian

Swamps, as portrayed, indicate only the wetter areas, usually of low relief, as interpreted from aerial photographs

Entire land area is within the Tongass National Forest

TRUE NORTH
MAGNETIC NORTH
28½°
APPROXIMATE MEAN DECLINATION, 1949

SCALE 1:63 360

1 ½ 0 1 2 3 4 MILES
3000 0 3000 6000 9000 12000 15000 18000 21000 FEET
1 .5 0 1 2 3 4 5 KILOMETERS

CONTOUR INTERVAL 100 FEET
DATUM IS MEAN SEA LEVEL
DEPTH CURVES IN FEET—DATUM IS MEAN LOWER LOW WATER
SHORELINE SHOWN REPRESENTS THE APPROXIMATE LINE OF MEAN HIGH WATER
THE AVERAGE RANGE OF TIDE IS APPROXIMATELY 13 FEET

FOR SALE BY U. S. GEOLOGICAL SURVEY
FAIRBANKS, ALASKA, 99701, DENVER, COLORADO 80225 OR WASHINGTON, D. C. 20242
A FOLDER DESCRIBING TOPOGRAPHIC MAPS AND SYMBOLS IS AVAILABLE ON REQUEST

ALASKA
QUADRANGLE LOCATION

ROAD CLASSIFICATION
Light-duty ——— Unimproved dirt - - - - -

CRAIG (B-2), ALASKA
N5515-W13220/15X20

1949
MINOR REVISIONS 1963

83-1074

UNITED STATES
DEPARTMENT OF THE INTERIOR
GEOLOGICAL SURVEY

FINAL

CRAIG (B-2) QUADRANGLE
ALASKA
1:63,360 SERIES (TOPOGRAPHIC)

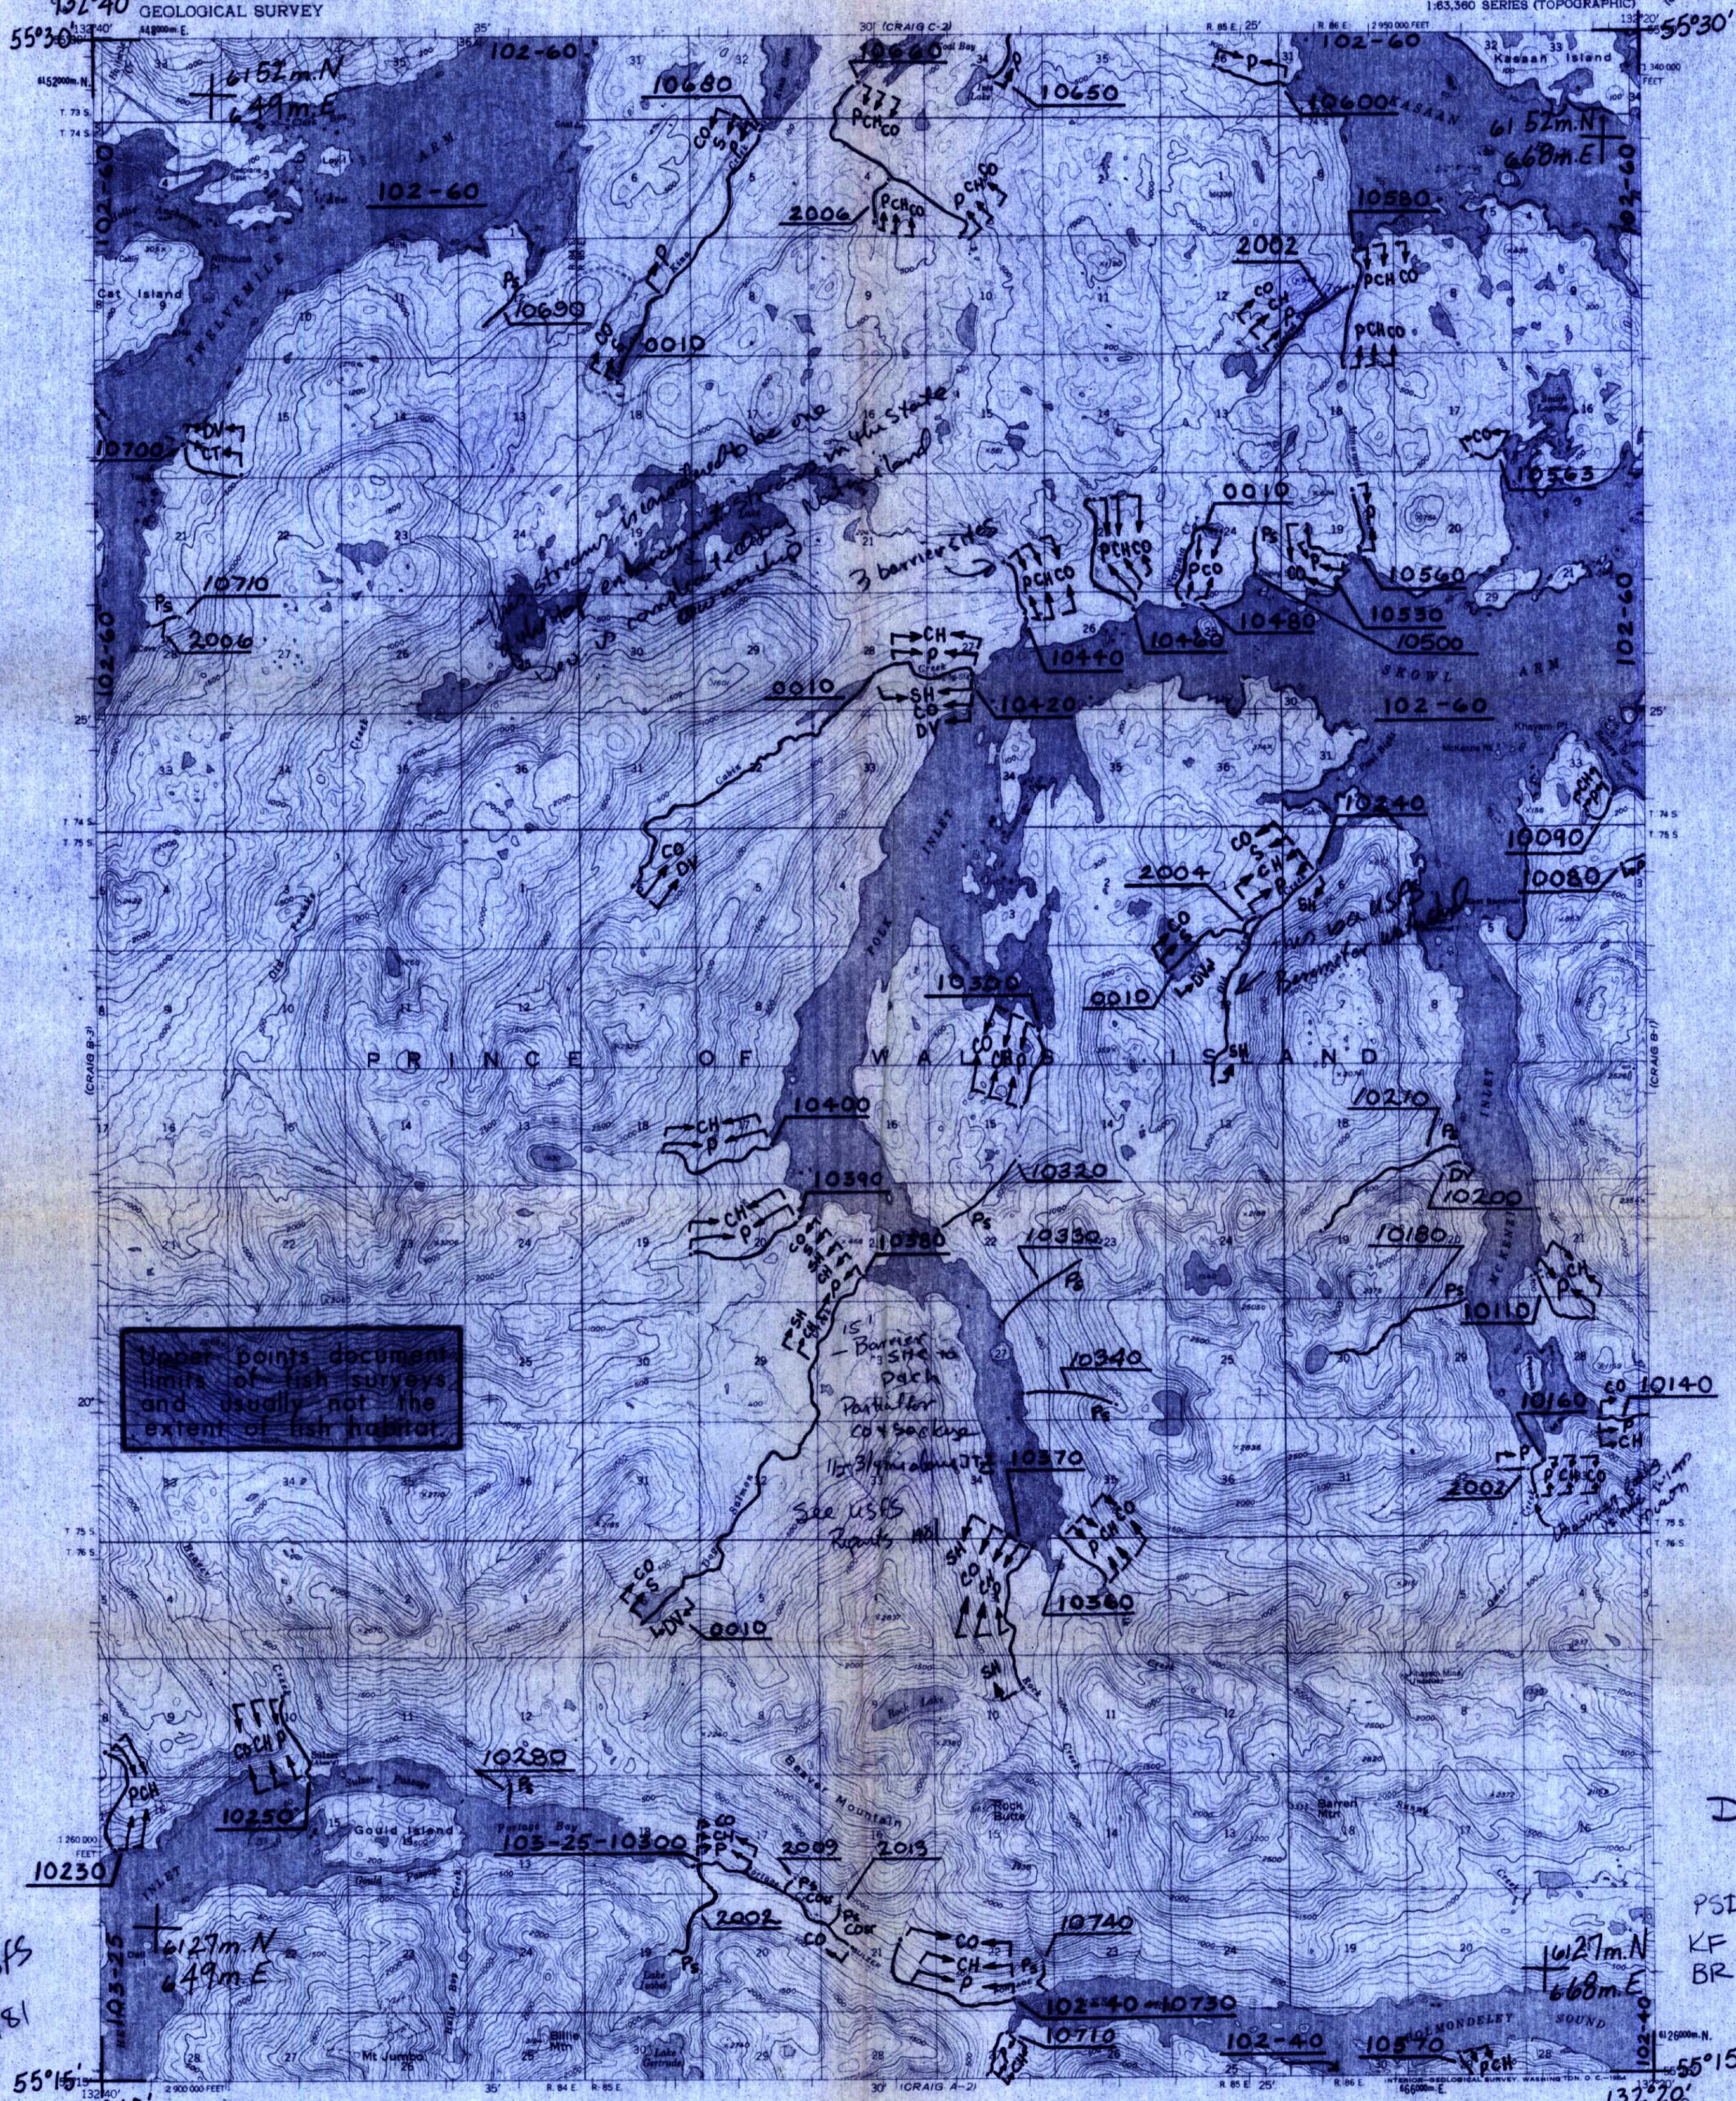


Compiled, edited, and published by the Geological Survey
Control by USGS and USC&GS

Topography by photogrammetric methods from aerial photographs taken 1948, field annotated 1949. Map not field checked

Selected hydrographic data compiled from USC&GS Charts 8142 (1962), and 8147 (1957). This information is not intended for navigational purposes

Universal Transverse Mercator projection. 1927 North American datum
10,000-foot grid based on Alaska coordinate system, zone 1
1000-meter Universal Transverse Mercator grid ticks, zone 8, shown in blue

Land lines represent unsurveyed and unmarked locations predetermined by the State of Alaska, Division of Lands
Copper River Meridian

Swamps, as portrayed, indicate only the wetter areas, usually of low relief, as interpreted from aerial photographs

Entire land area is within the Tongass National Forest

TRUE NORTH
MAGNETIC NORTH
APPROXIMATE MEAN DECLINATION, 1949

CONTOUR INTERVAL 100 FEET
DATUM IS MEAN SEA LEVEL
DEPTH CURVES IN FEET—DATUM IS MEAN LOWER LOW WATER
SHORELINE SHOWN REPRESENTS THE APPROXIMATE LINE OF MEAN HIGH WATER
THE AVERAGE RANGE OF TIDE IS APPROXIMATELY 13 FEET

FOR SALE BY U. S. GEOLOGICAL SURVEY
FAIRBANKS, ALASKA DENVER 25, COLORADO WASHINGTON 25, D. C.
A FOLDER DESCRIBING TOPOGRAPHIC MAPS AND SYMBOLS IS AVAILABLE ON REQUEST

QUADRANGLE LOCATION

ROAD CLASSIFICATION
Light-duty ——— Unimproved dirt - - - -

CRAIG (B-2), ALASKA
N5515-W13220/15x20
1949
MINOR REVISIONS 1963

MAP NO. B-2 OF 3

**LEGEND**

| | |
|---|---|
| S | Sockeye Salmon |
| K | King Salmon |
| CO | Coho Salmon |
| P | Pink Salmon |
| CH | Chum Salmon |
| SH | Steelhead Trout |
| DV | Dolly Varden |
| AC | Arctic Char |
| SF | Sheefish |
| W | Whitefish |
| C | Cutthroat Trout |

Subscript
s - Known Spawning
r - Rearing
*m - Migration

*Migration upstream is assumed for stream reaches where anadromous fish occur.

COMP. DRC
DRAWN CB
REVISED DRC
APPROVED
DATE
FILE NO.

SCALE
1" = 1 MILE
1 : 63,360

PROJ. TITLE
ANADROMOUS STREAM CATALOG
ANADROMOUS WATERS ARE LISTED PURSUANT TO AS 16.05.870 (a)

MAP TITLE
CRAIG B-2

STATE OF ALASKA
DEPARTMENT OF FISH AND GAME
habitat protection division
JUNEAU, ALASKA

| BY | DATE |
|---|---|
| BB | 3/83 |
| | |
| | |
| | |
| | |
| | |
| | |
| REVISIONS | |