Department of Fish and Game
Public Review Nomination for Waters
Important to Anadromous Species

84-669

X Addition ____ Deletion

Name of Waterbody (if known): Vixen Inlet #5

Location:

Anadromous Waters Catalog Volume and Number S.E. AK

USGS 1:63,360 Quadrangle Craig D-1

or 1:250,000 (if 1:63,360 not available) ____

Species	Date(s) Observed	Stage(s) (Spawning, Rearing, Migration)
Coho	6/19/84	rearing

Comments: Please provide any clarifying information. Also, please include a map of the area identifying the stream reach. This can be a copy of the map from the Anadromous Waters Atlas.

Vixen Inlet #5 contains a small amount of ASA for the first 200 meters. Rearing coho were also observed in this stretch. The fisheries habitat declines in quality beyond here but is still accessible. The flow was estimated at 10 cfs at a high water stage. The end of the survey is indicated on the map, not the limits to possibe coho passage. add Stream # 107-10-10210

Name of Observer (please print) Craig Blems

Date: 9/17/84 Signature: Donald G. Kelly AREA HABITAT BIO 10/30/84

Drafted Dew 10/84

Address: P.O. Box 667 Petersburg 99833 9/21/84

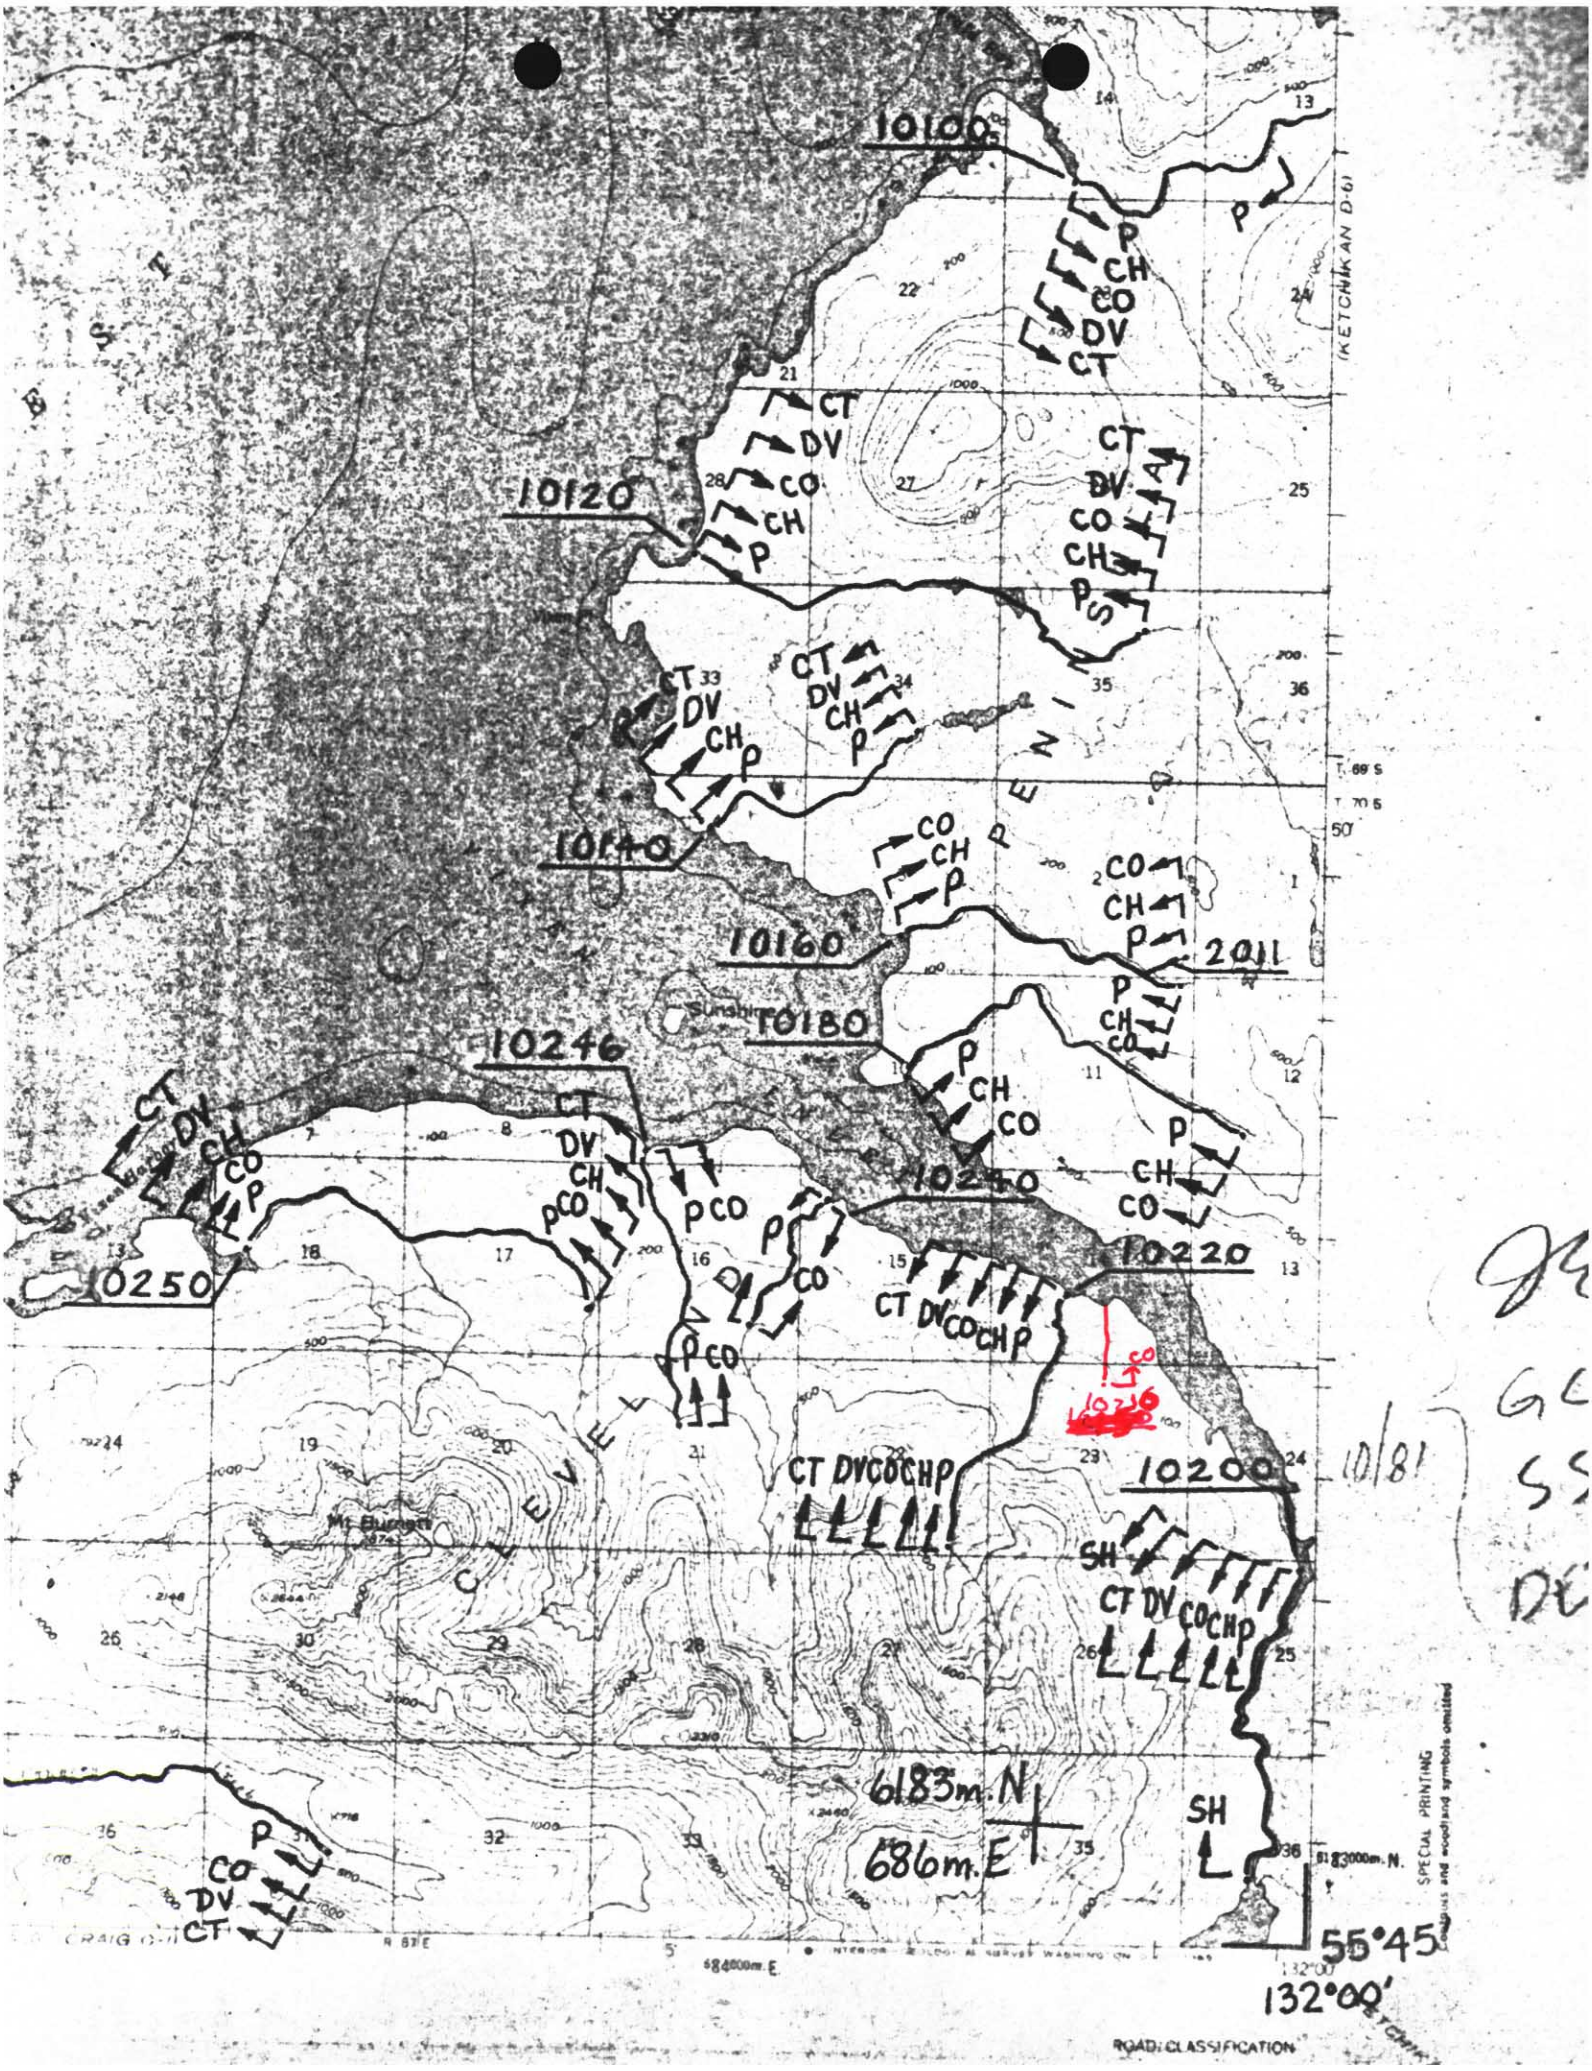
10100
10120
10140
10160
10180
10200
10220
10240
10246
10250
2011
CT DV CO CH P
CT DV CO CH P SH
CT DV CO CH P SH
CT DV CO CH P
CT DV CO CH P
CT DV CO CH P

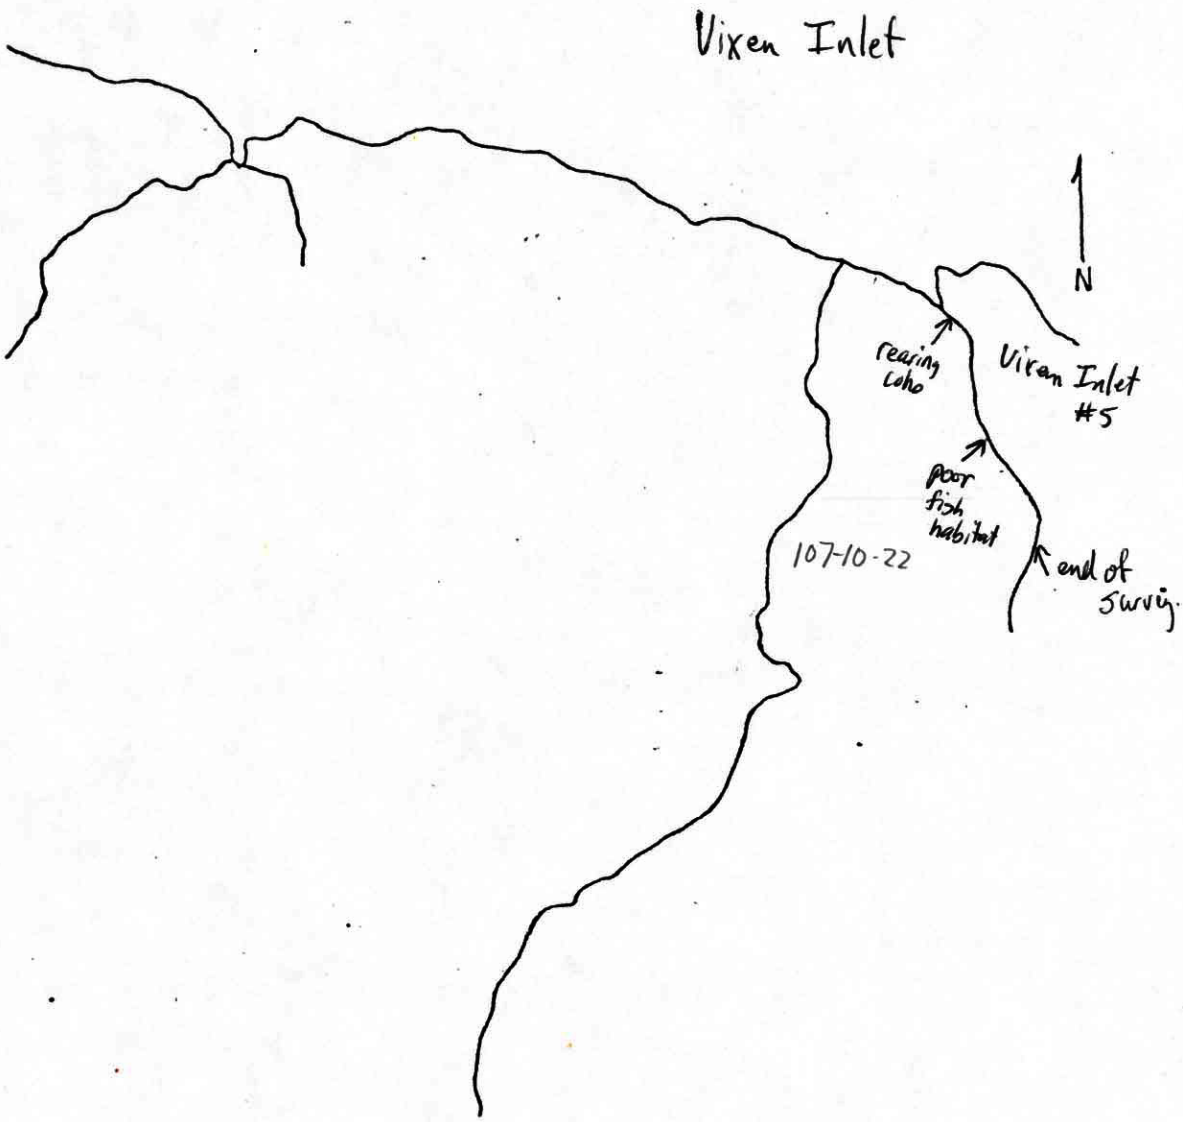
Vixen Inlet
N
rearing coho
Vixen Inlet #5
poor fish habitat
107-10-22
end of survey

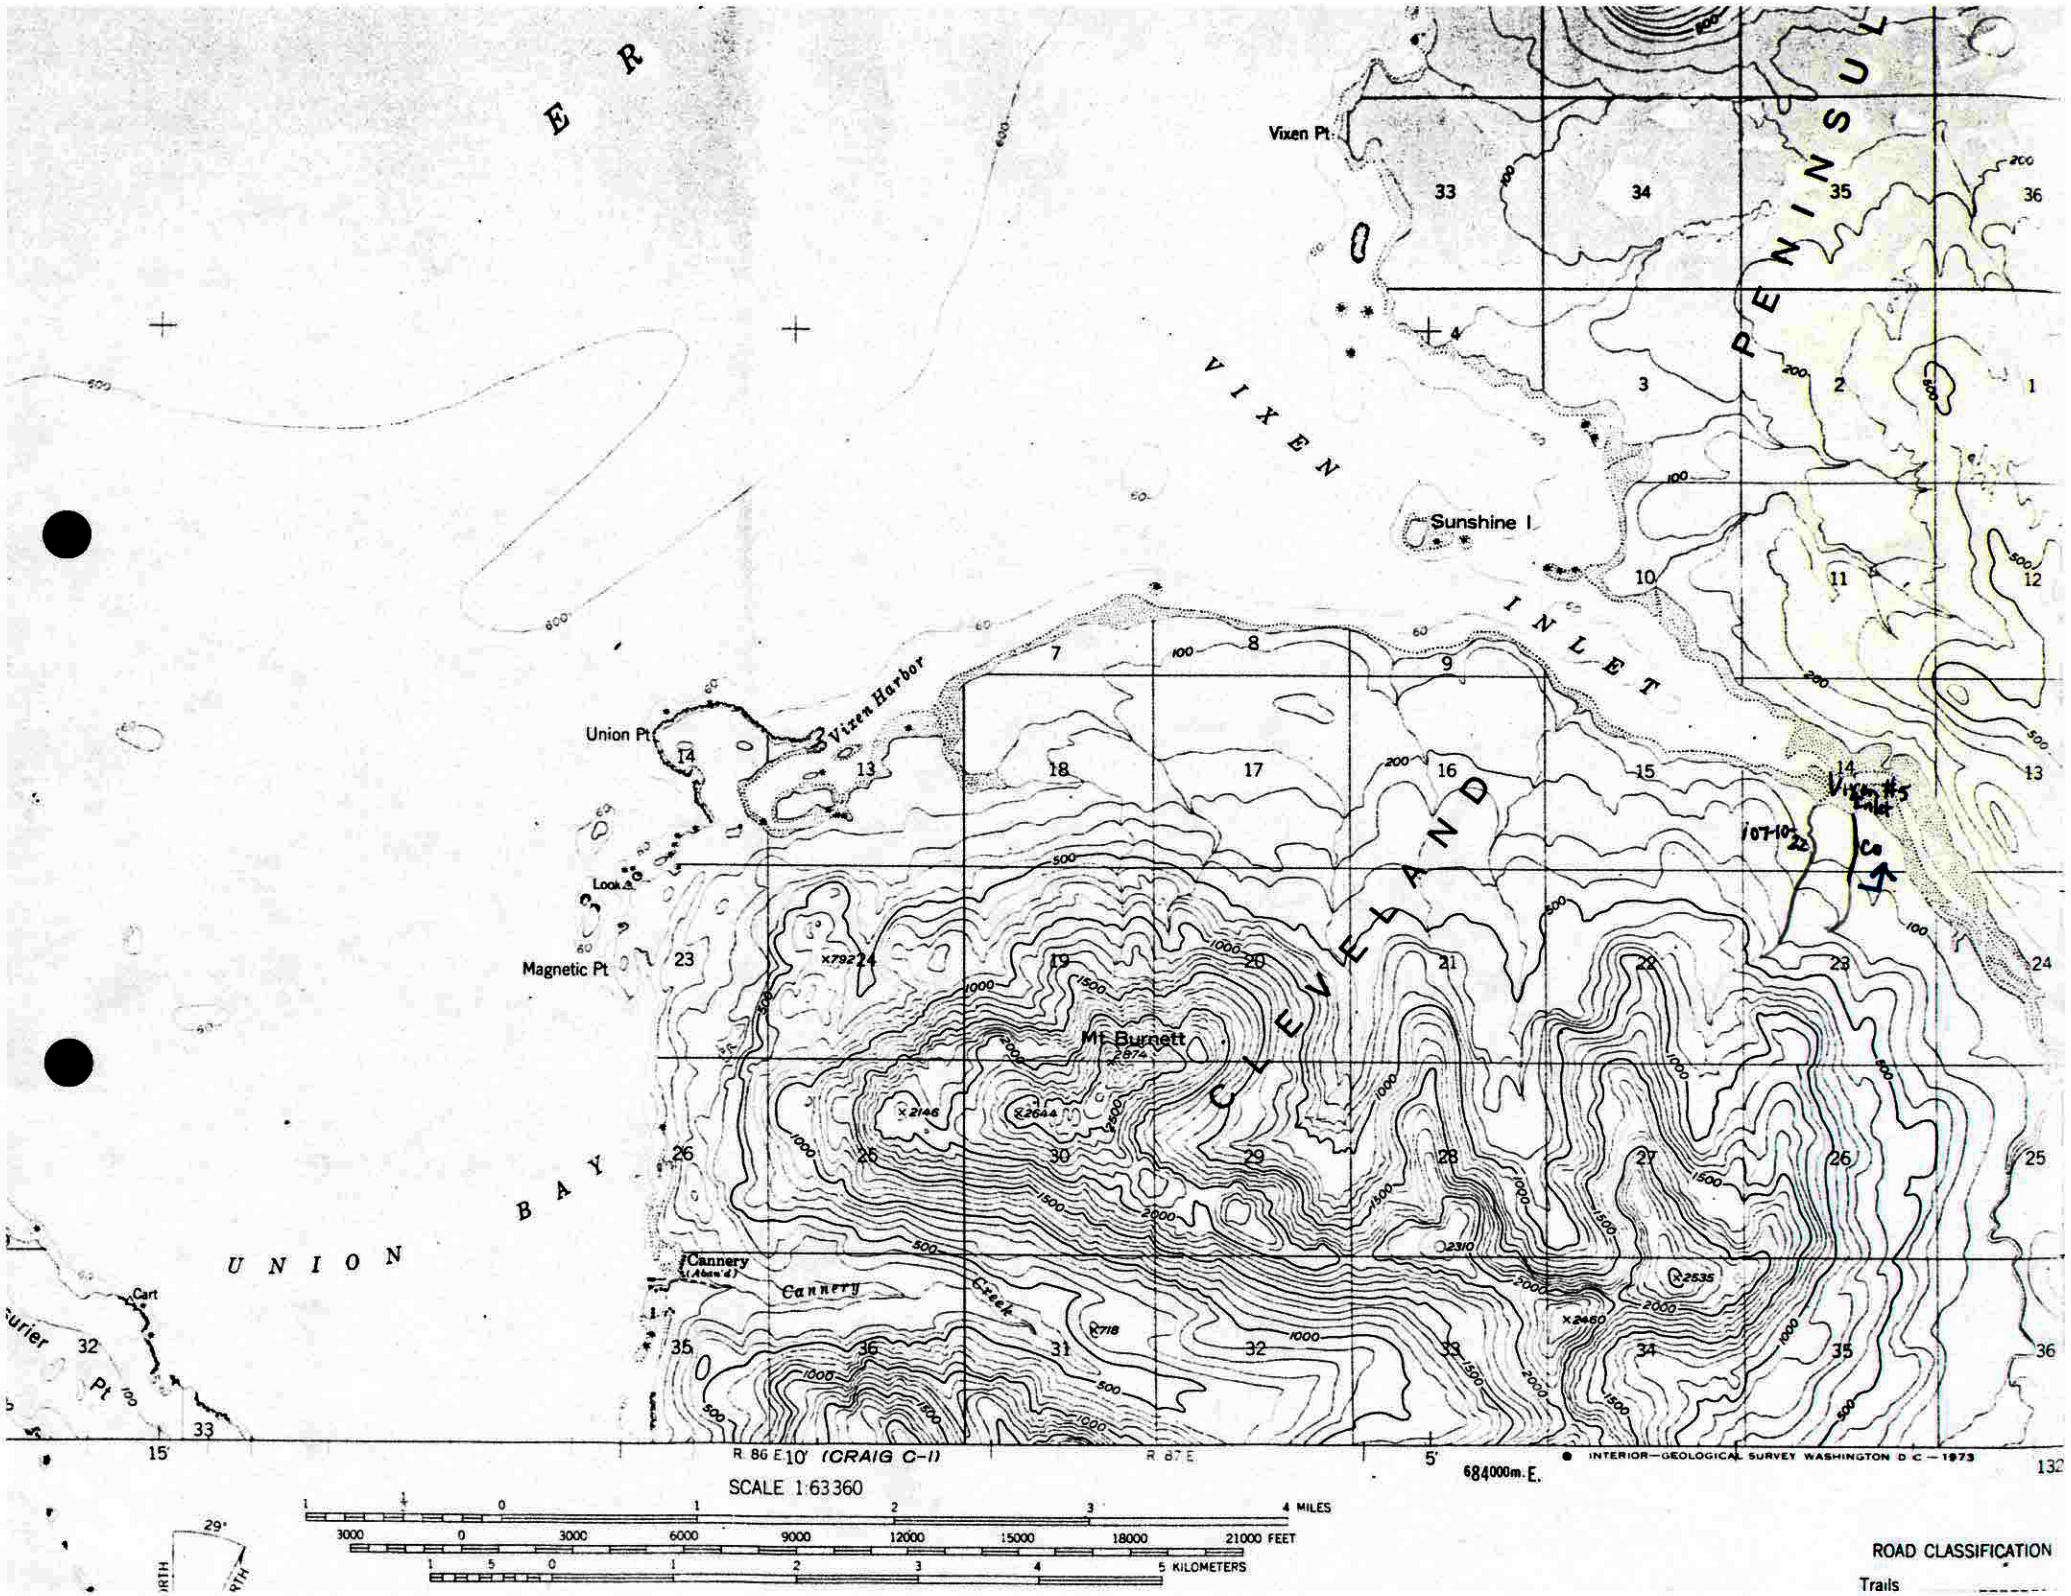
Vixen Pt
Sunshine I
Union Pt
Vixen Harbor
Look
Magnetic Pt
Mt Burnett
2874
Cannery
(Aban'd)
Cannery Creek
Cart
Pt
UNION BAY
VIXEN INLET
CLEVELAND PENINSULA
Vixen #5
107-10-22
Ca
R. 86 E.
10' (CRAIG C-1)
R. 87 E.
5'
684000m.E.
SCALE 1:63360
4 MILES
21000 FEET
5 KILOMETERS
ROAD CLASSIFICATION
Trails