84-713

State of Alaska
Department of Fish and Game
Public Review Nomination for Waters
Important to Anadromous Species

✓ Addition ____ Deletion

Name of Waterbody (if known): Carlson Creek 111-32-10130

Location:

Anadromous Waters Catalog Volume and Number Southeast

USGS 1:63,360 Quadrangle JUNEAU B-1 11

or 1:250,000 (if 1:63,360 not available) ____

Species	Date(s) Observed	Stage(s) (Spawning, Rearing, Migration)
Pink	July 1958	Spawning
Chum	July 1958	Spawning

Drafted lew 1/84

Comments: Please provide any clarifying information. Also, please include a map of the area identifying the stream reach. This can be a copy of the map from the Anadromous Waters Atlas.

Sunny Cove, 7 mi north of Cooper Pt.

Name of Observer (please print) Jim Parker (Westward files)

Date: 12/22/83 Signature: Jim Parker Joseph J. Mueri

Address: comm fish
Juneau

R. Reed cmy 1/16/84

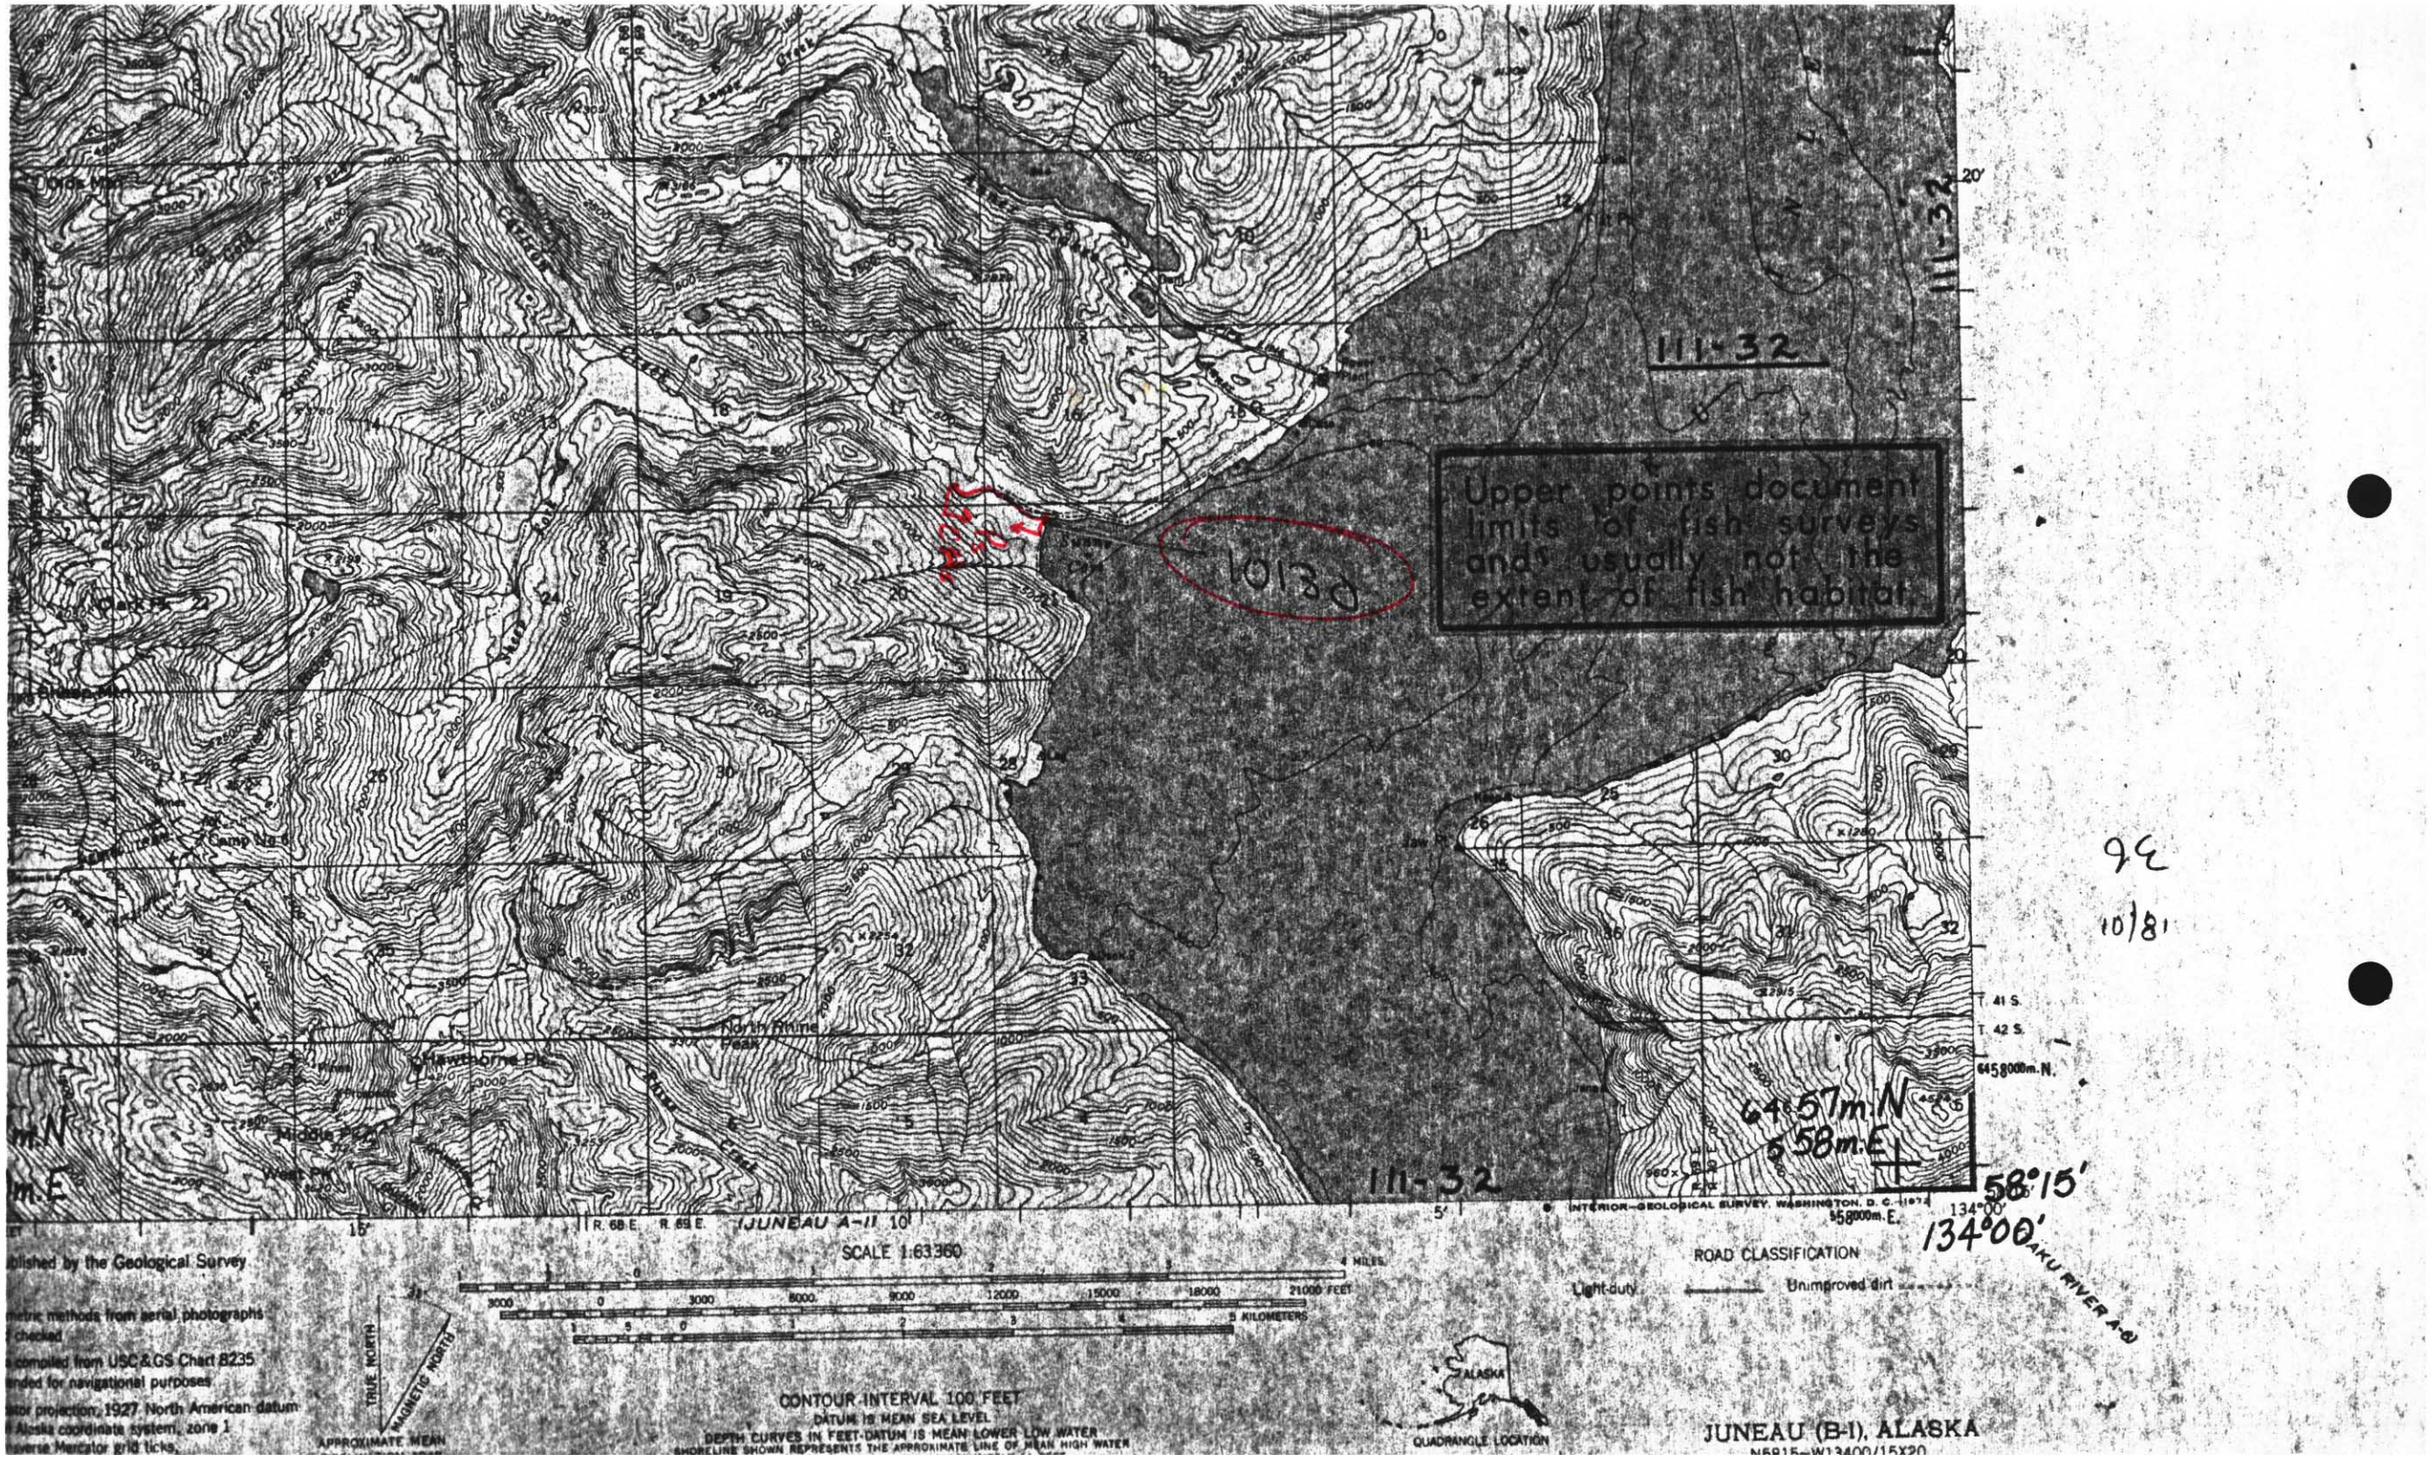
111-32
Upper points document limits of fish surveys and usually not the extent of fish habitat
10130
64.57m N
5.58m E
111-32
111-32
T. 41 S.
T. 42 S.
6458000m. N.
558000m. E.
58°15'
134°00'
North Pinnacle Peak
Hawthorne Pk.
Middle Peak
West Pk.
Camp 08-6
Clark Pk.
R. 68 E.
R. 69 E.
JUNEAU A-II
SCALE 1:63360
CONTOUR INTERVAL 100 FEET
DATUM IS MEAN SEA LEVEL
DEPTH CURVES IN FEET-DATUM IS MEAN LOWER LOW WATER
SHORELINE SHOWN REPRESENTS THE APPROXIMATE LINE OF MEAN HIGH WATER
ROAD CLASSIFICATION
Light-duty
Unimproved dirt
INTERIOR—GEOLOGICAL SURVEY, WASHINGTON, D. C.
ALASKA
QUADRANGLE LOCATION
JUNEAU (B-I), ALASKA
N5815—W13400/15X30
AAKU RIVER A-II

9C
10/81