State of Alaska
Department of Fish and Game
Public Review Nomination for Waters
Important to Anadromous Species

84-720

✓ Addition ____ Deletion

Name of Waterbody (if known): Gold Creek 111-40-10200

Location:

Anadromous Waters Catalog Volume and Number Southeast

USGS 1:63,360 Quadrangle JUNEAU B-2 11

or 1:250,000 (if 1:63,360 not available) ____

Species	Date(s) Observed	Stage(s) (Spawning, Rearing, Migration)
Pinks	8/18/83	migration

Drafted Kew 1/84

Comments: Please provide any clarifying information. Also, please include a map of the area identifying the stream reach. This can be a copy of the map from the Anadromous Waters Atlas.

Immediately east of the Juneau/Douglas Bridge on the north shore

Name of Observer (please print) Kew Imamura

Date: 12/21/83 Signature: K Kenneth K Imamura

Address: Box 1221
Juneau, AK 99802

R. Reed
cmy
1/16/84

State of Alaska
Department of Fish and Game
Public Review Nomination for Waters
Important to Anadromous Species

✓ Addition ____ Deletion

Name of Waterbody (if known): 111-40-10900 Kowee Crk

Location:

Anadromous Waters Catalog Volume and Number Southeast

USGS 1:63,360 Quadrangle Juneau B-2

or 1:250,000 (if 1:63,360 not available) ____

Species	Date(s) Observed	Stage(s) (Spawning, Rearing, Migration)
Pinks	8/17/83	Spawning
Chums	8/17/83	Spawning

Comments: Please provide any clarifying information. Also, please include a map of the area identifying the stream reach. This can be a copy of the map from the Anadromous Waters Atlas.

Immediately west of Juneau Douglas Bridge on south shore

Drafted Jew 1/84

Name of Observer (please print) Sandra Kane (temporary)

Date: 12/21/83 Signature: Joseph J. Munn

Address:

R. Reed
cmy
1/16/84

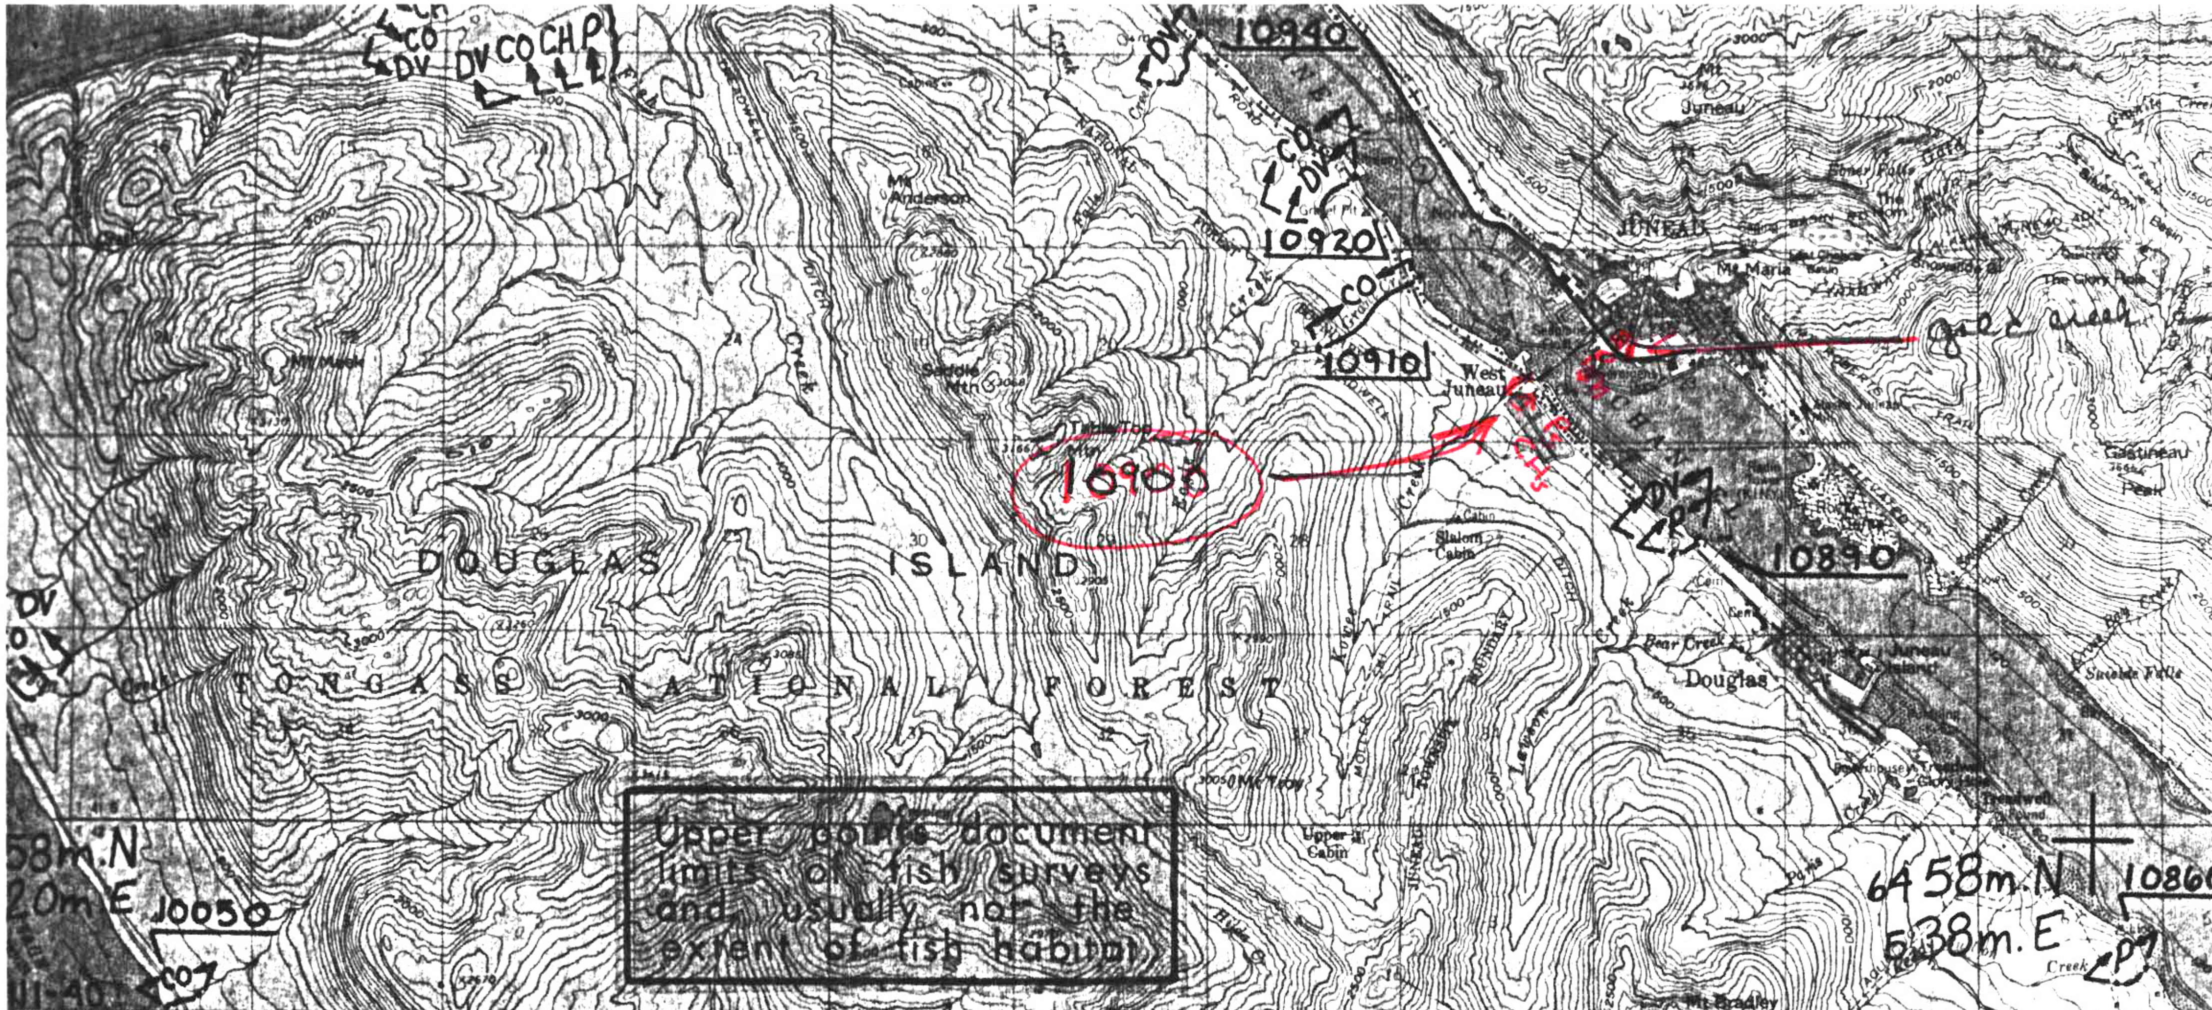

Ok 10/

RW

6/81

2 500 000 FEET   MIDDLE POINT 0.1 MI.   35'   R. 68 E.   R. 67 E.   30' (JUNEAU A-2)   25'   535000m. E.   INTERIOR—GEOLOGICAL SURVEY, RESTON, VIRGINIA—1974   R. 67 E.   R. 68 E.   134°20'   6457000m. N.

...ed, and published by the Geological Survey
...S and USC&GS
...photogrammetric methods from aerial photographs
...ulture revised 1962. Map field checked 1962
...graphic data compiled from USC&GS
...962). This information is not intended
... purposes
...erse Mercator projection. 1927 North American datum
... based on Alaska coordinate system, zone 1
...versal Transverse Mercator grid ticks,
... blue
...ment unsurveyed and unmarked locations
... the State of Alaska, Division of Lands
...er River Meridian
...s areas in which only landmark buildings are shown
...n purple compiled from aerial photographs taken 1974.
... not field checked.
...otes extension of urban areas

TRUE NORTH   MAGNETIC NORTH   29½°

APPROXIMATE MEAN DECLINATION, 1962

SCALE 1:63 360

1 0 1 2 3 4 MILES

3000 0 3000 6000 9000 12000 15000 18000 21000 FEET

1 .5 0 1 2 3 4 5 KILOMETERS

CONTOUR INTERVAL 100 FEET
NATIONAL GEODETIC VERTICAL DATUM OF 1929
DEPTH CURVES IN FEET—DATUM IS MEAN LOWER LOW WATER
SHORELINE SHOWN REPRESENTS THE APPROXIMATE LINE OF MEAN HIGH WATER
THE MEAN RANGE OF TIDE IS APPROXIMATELY 14 FEET

FOR SALE BY U. S. GEOLOGICAL SURVEY
FAIRBANKS, ALASKA 99701, DENVER, COLORADO 80225, OR RESTON, VIRGINIA 22092
A FOLDER DESCRIBING TOPOGRAPHIC MAPS AND SYMBOLS IS AVAILABLE ON REQUEST

ALASKA

QUADRANGLE LOCATION

ROAD CLASSIFICATION

Medium-duty   Light-duty
Unimproved dirt
State Route

JUNEAU (B-2), ALASKA
N5815—W13420/15X20

1962
MINOR REVISIONS 1966
PHOTOREVISED 1974

COMP. DRC	PROJ. TITLE ANADROMOUS STREAM CATALOG	BY	DA