State of Alaska
Department of Fish and Game
Public Review Nomination for Waters
Important to Anadromous Species

1984 REVISION

84-735

X Addition ____ Deletion

Name of Waterbody (if known): Extend Peterson Creek and Add Tributaries to Peterson Creek, at end of North Douglas Road

Location:

Anadromous Waters Catalog Volume and Number 111-50-10750 Southeast

USGS 1:63,360 Quadrangle Juneau B-2 11

or 1:250,000 (if 1:63,360 not available) _____

Species	Date(s) Observed	Stage(s) (Spawning, Rearing, Migration)
Coho	1983	rearing, spawning

Comments: Please provide any clarifying information. Also, please include a map of the area identifying the stream reach. This can be a copy of the map from the Anadromous Waters Atlas.

ALASKA DEPT. OF FISH & GAME
JAN 4 1984
HABITAT REGIONAL OFFICE

Name of Observer (please print) Mike Bethers

Date: 12/29/83 Signature: Mike Bethers

Address: 230 S. Franklin
Juneau AK 99801

drafted 1/84
P

R Reed
cmy
1/16/84

Add tributaries to this stream

-50-10750

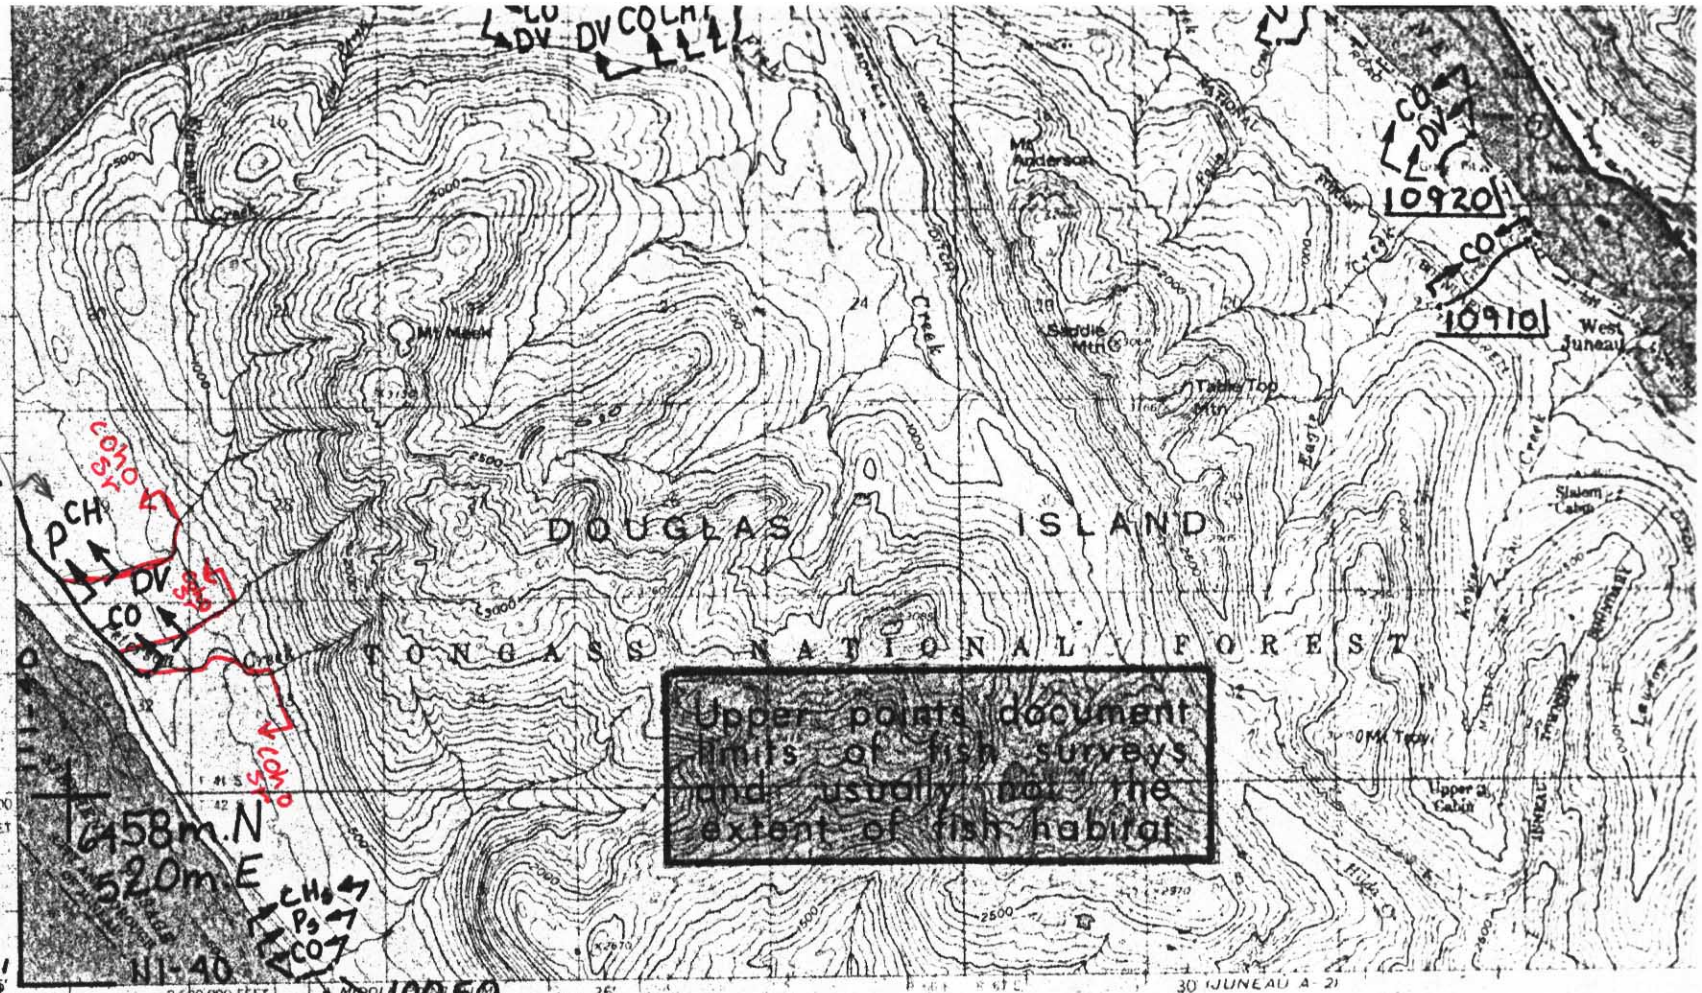

Compiled, edited, and published by the Geological Survey

Control by USGS and USC&GS

Topography by photogrammetric methods from aerial photographs taken 1948. Culture revised 1962. Map field checked 1962

Selected hydrographic data compiled from USC&GS Chart 8235 (1962). This information is not intended for navigational purposes

Universal Transverse Mercator projection, 1927 North American datum 10,000 foot grid based on Alaska coordinate system, zone 1 1000-meter Universal Transverse Mercator grid ticks, zone 8, shown in blue

Land lines represent unsurveyed and unmarked locations predetermined by the State of Alaska, Division of Lands Folio CR-12 Copper River Meridian

Red tint indicates areas in which only landmark buildings are shown

Revisions shown in purple compiled from aerial photographs taken 1974. This information not field checked

Purple tint indicates extension of urban areas

TRUE NORTH
MAGNETIC NORTH
29½°
APPROXIMATE MEAN DECLINATION, 1962

SCALE 1:63 360

CONTOUR INTERVAL 100 FEET
NATIONAL GEODETIC VERTICAL DATUM OF 1929
DEPTH CURVES IN FEET—DATUM IS MEAN LOWER LOW WATER
SHORELINE SHOWN REPRESENTS THE APPROXIMATE LINE OF MEAN HIGH WATER
THE MEAN RANGE OF TIDE IS APPROXIMATELY 24 FEET

Juneau B-2

FOR SALE BY U. S. GEOLOGICAL SURVEY
FAIRBANKS, ALASKA 99701 DENVER, COLORADO 80225 OR RESTON, VIRGINIA 22092
A FOLDER DESCRIBING TOPOGRAPHIC MAPS AND SYMBOLS IS AVAILABLE ON REQUEST

LEGEND
S Sockeye Salmon
K King Salmon
CO Coho Salmon
Subscript
s - Known Spawning

COMP. DRC
DRAWN CB

PROJ. TITLE
ANADROMOUS STREAM CATALOG