State of Alaska
Department of Fish and Game
Nomination for Waters
Important to Anadromous Species

85
Year of Revision
85-314

Approved

Name of Waterway Nelson Creek + tributary

AWC# of Waterway NEW 115-34-10230-2011

AWC Volume & Number REGION I

USGS Quad Skagway B-1 ~~+C-1~~ (14)

Addition ✗ Correction
Deletion Change

Change to Atlas
Catalog
✗ Both

Richard Reed 8/29/85
Regional Supervisor Date

OK STB 10/24/85

TB 10-15-85
Drafted

ALASKA DEPT. OF FISH & GAME
SEP - 3 1985
HABITAT
REGIONAL OFFICE

Species	Date(s) Observed	Spawning	Rearing	Migration
Dolly varden	6-29-85		✓	
Coho Salmon	6-29-85		✓	

Comments: Provide any clarifying information, including number of fish observed, location of fish survey data, etc.

4 traps set for 15 mins captured 28 coho and 2 Dolly varden this creek meanders through the flats of the Taiya River, but is a separate system. Only Dolly varden were trapped ~~just above the co~~ on Nelson Creek above the confluence with the mainstem (tributary).

Attach a copy of a map showing location of mouth and upper points of each species, specific stream reaches identified for spawning or rearing, locations of barriers, such as falls. Attach a copy of the fish survey data, if available.

Name of Observer (please print) Randolph Ericksen

Date: 7/1/85 Signature: Randolph P. Ericksen

Address: Box 431 (ADF+G Sport Fish)
Haines, Ak 99827

HABITAT
RECEIVED
JUL 3 1985
REGION I
JUNEAU

UNITED STATES
DEPARTMENT OF THE INTERIOR
GEOLOGICAL SURVEY

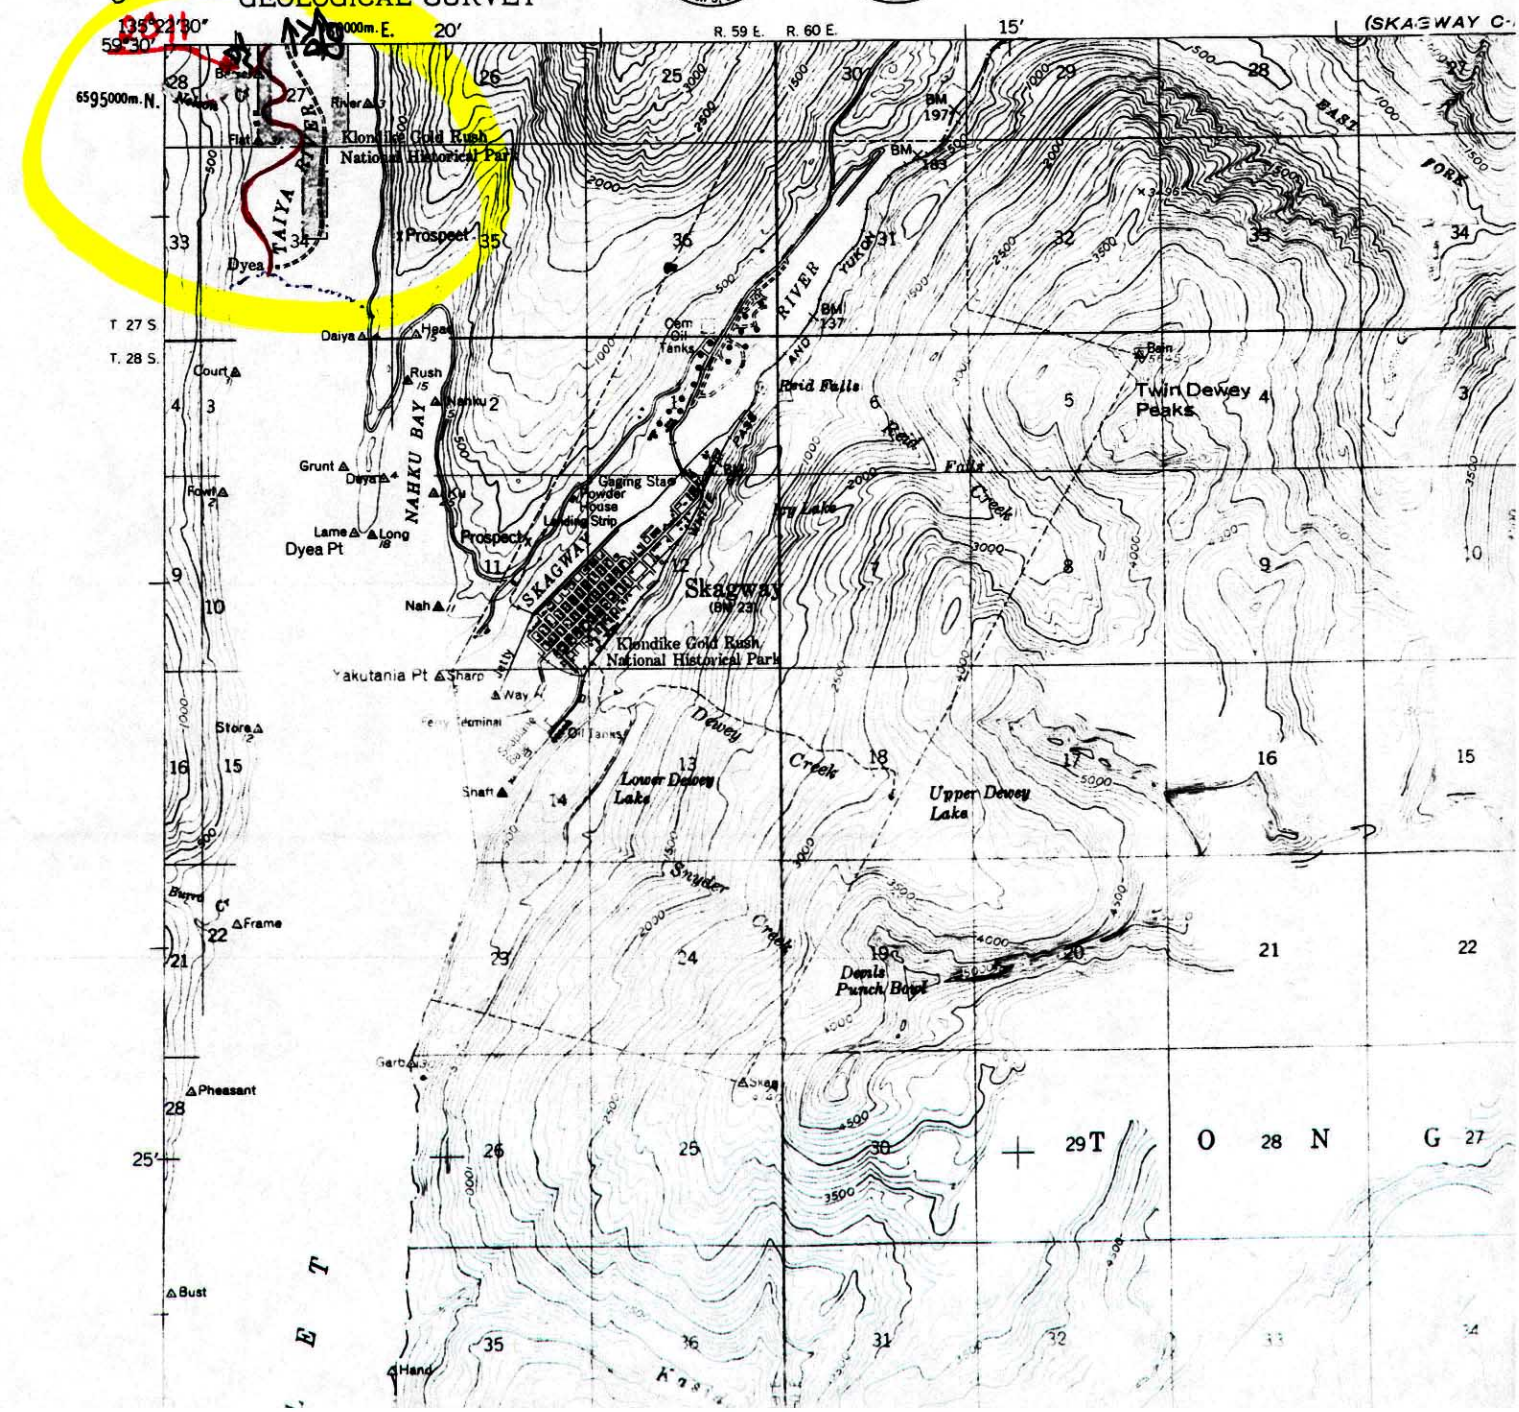

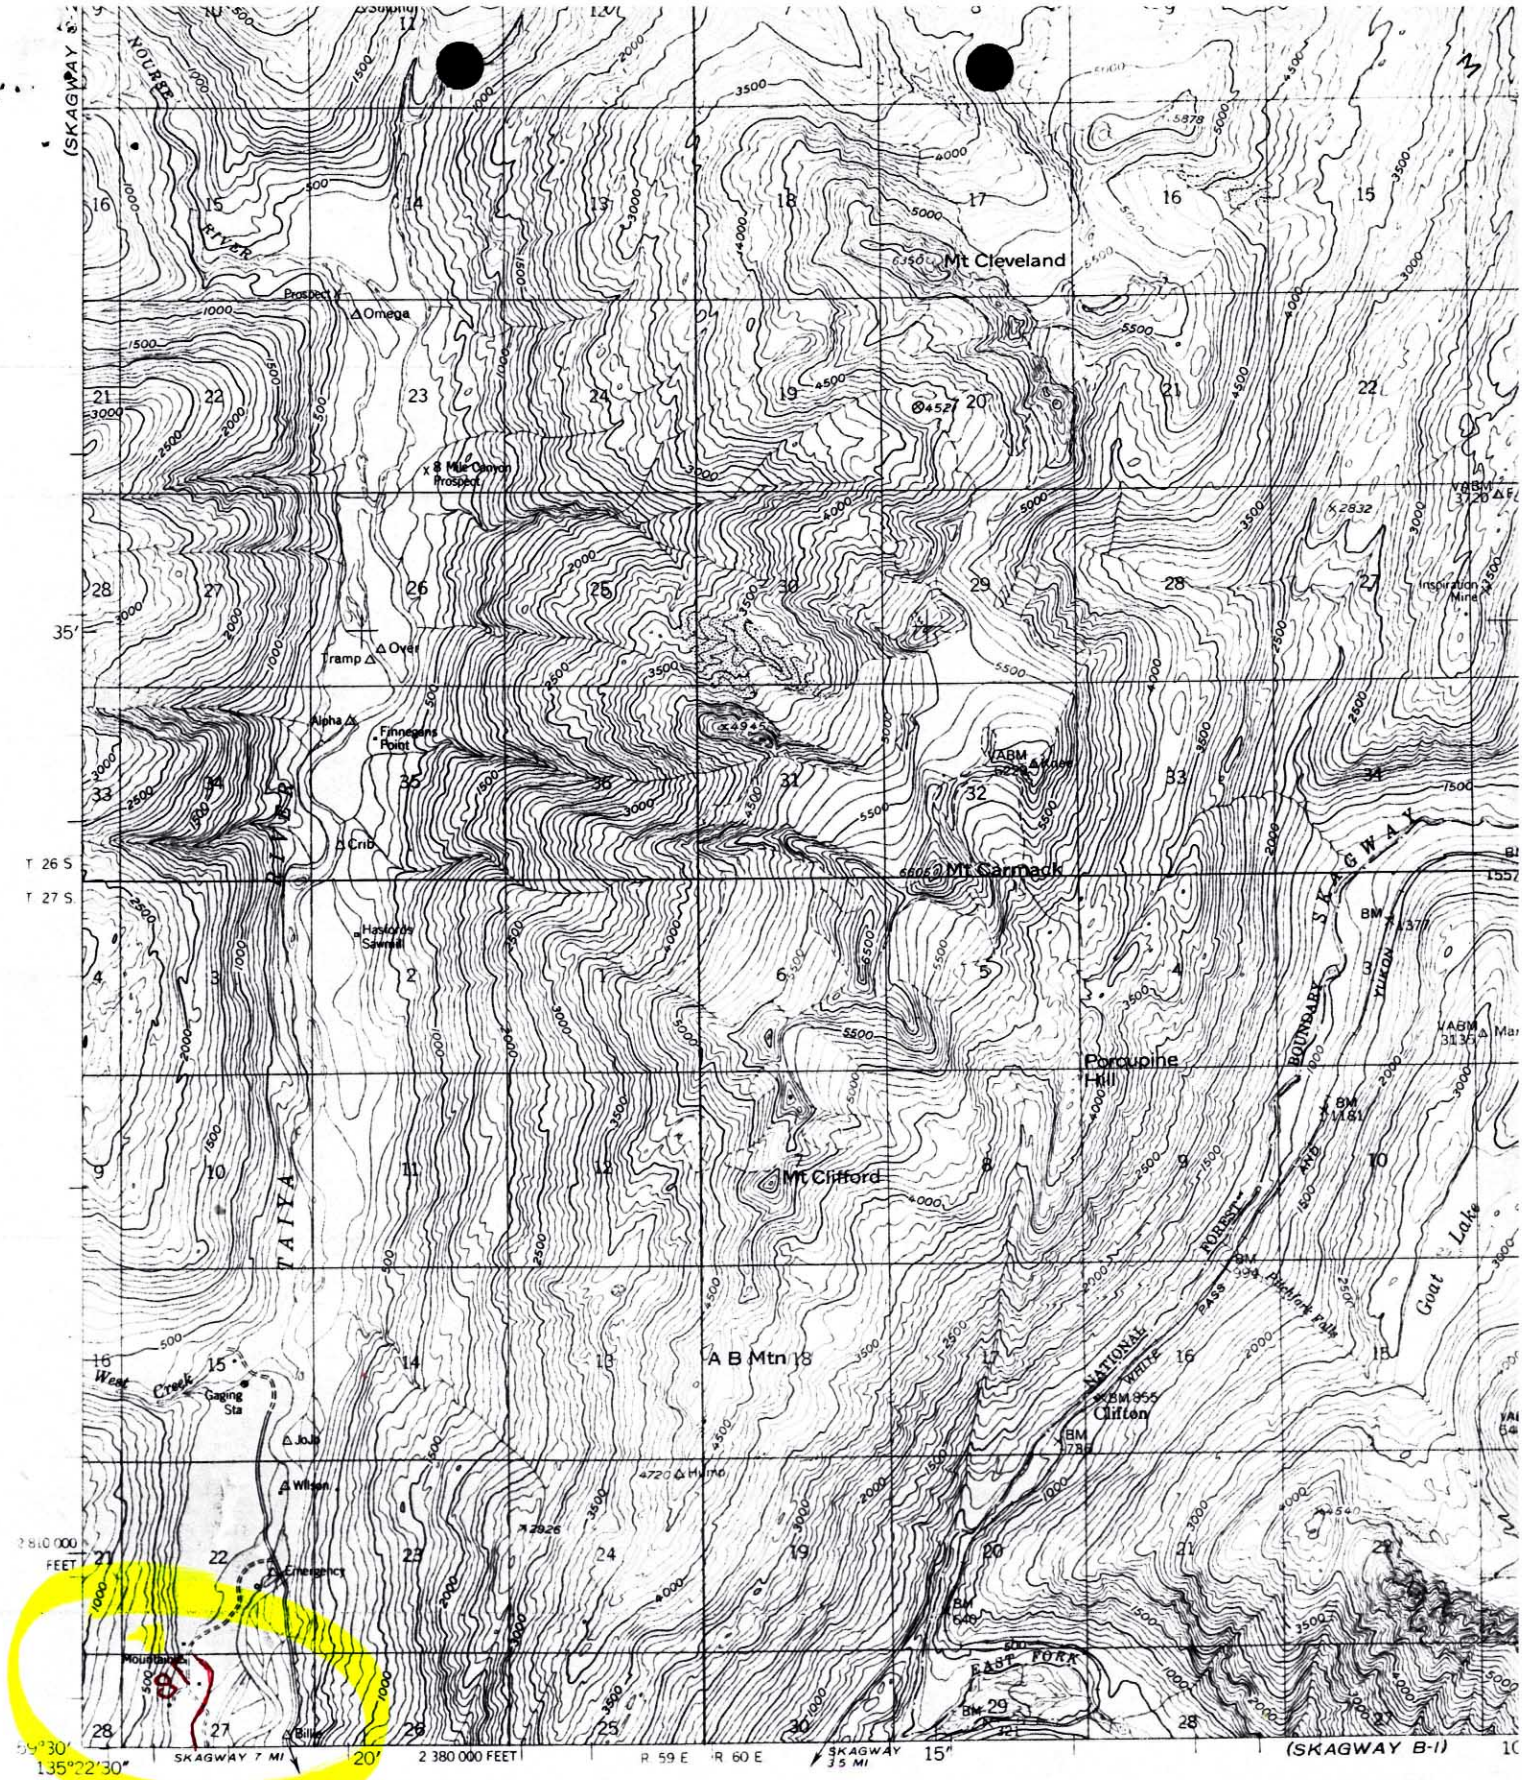

Mapped, edited, and published by the Geological Survey

Control by USC&GS and IBC

Topography by photogrammetric methods from aerial photographs taken 1948. Map not field checked

Universal Transverse Mercator projection, 1927 North American datum
10,000-foot grid based on Alaska coordinate system, zone 1
1000-meter Universal Transverse Mercator grid ticks, zone 8, shown in blue

Land lines represent unsurveyed and unmarked locations predetermined by the Bureau of Land Management
Folio CR-11, Copper River Meridian

TRUE NORTH
MAGNETIC NORTH
31½°
APPROXIMATE MEAN DECLINATION, 1948

SCALE 1:63 360

CONTOUR INTERVAL 100 FEET
DATUM IS MEAN SEA LEVEL

FOR SALE BY U. S. GEOLOGICAL SURVEY
FAIRBANKS, ALASKA 99701, DENVER, COLORADO